


MARK	DATE	REVISIONS
A	05/10/2021	REVISIONS TO ADDRESS CITY PLAN REVIEW COMMENTS
B	06/01/2021	REVISIONS TO ADDRESS CITY FIRE REVIEW COMMENTS

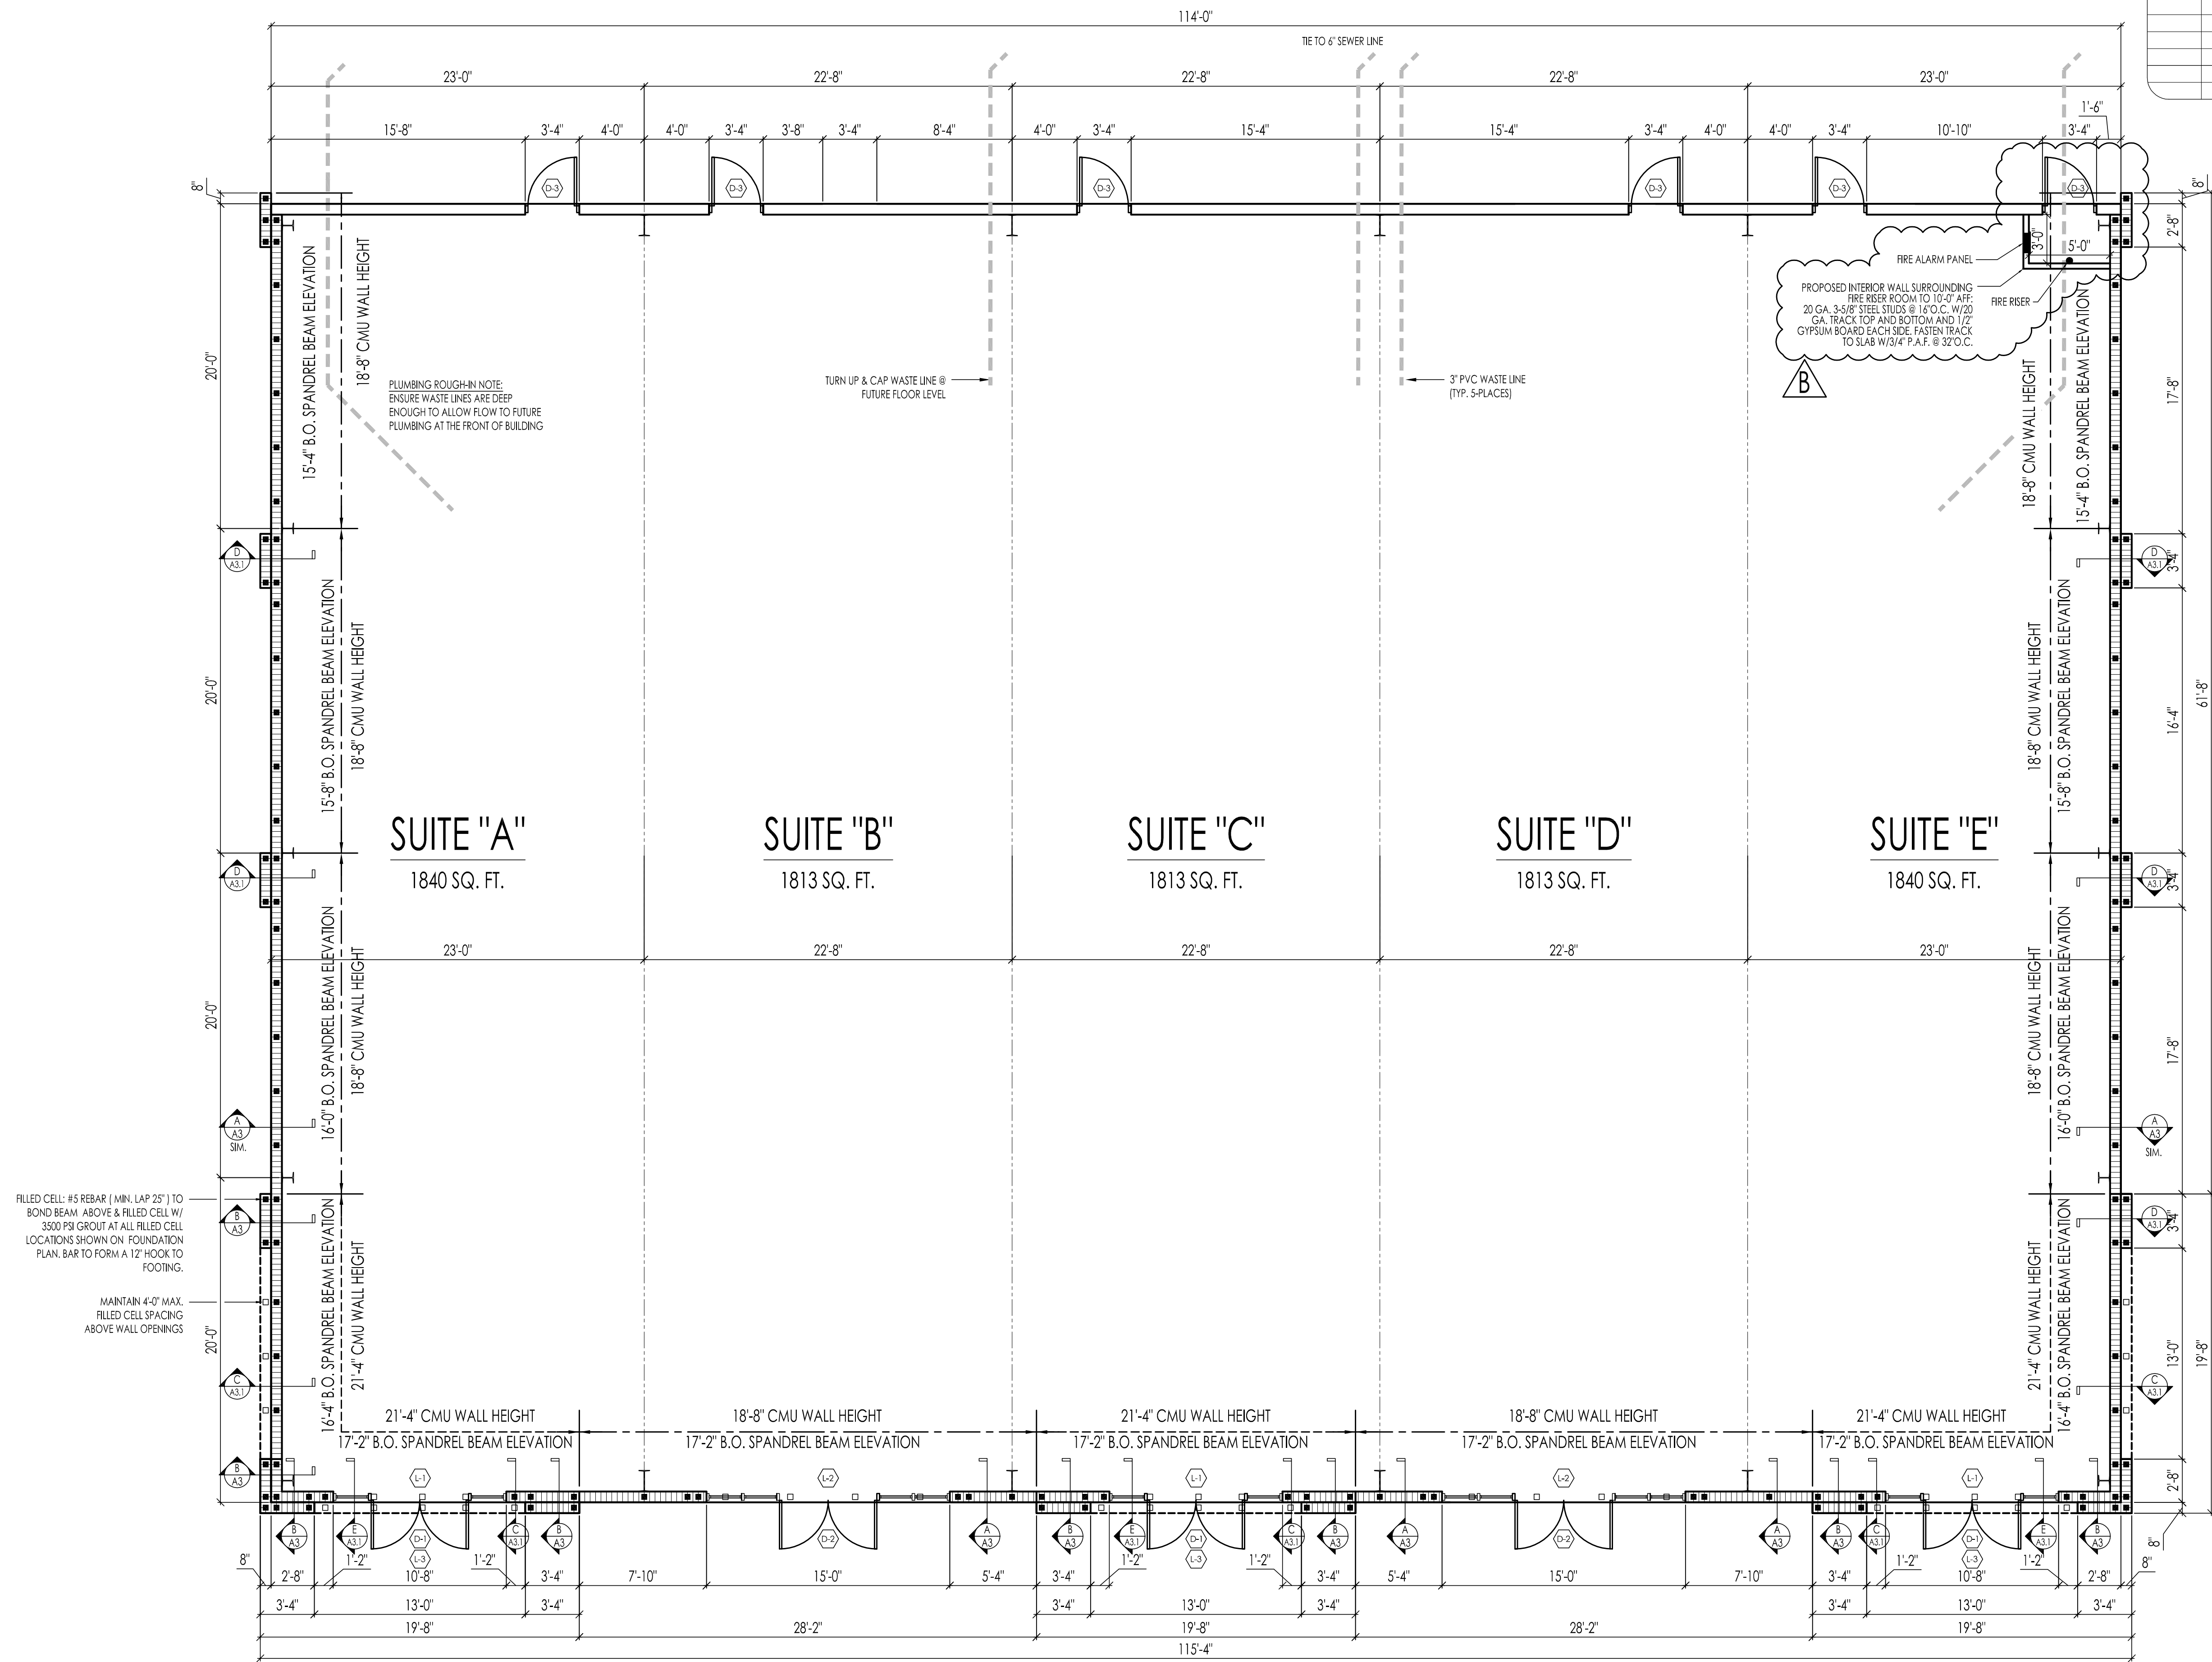

FLOOR PLAN
SCALE: 3/16" = 1'-0"

PROPOSED SHELL BUILDING FOR:
GROVELAND POINT CENTER
STATE ROAD 50
GROVELAND, FL
FLOOR PLAN

A1.0

DATE: 04/20/2021
PROJECT: RW
SCALE: 1/8"

MATTHEWS HANNA CONSTRUCTION
DESIGN BUILD GENERAL CONTRACTOR
715 BALMORAL CIRCLE
DADE COUNTY, FL 33138
OFF: (305) 367-6768
FAX: (305) 326-2331

GRIGS ENGINEERING, INC.
CIVIL ENGINEERING
FLORIDA P.E. LICENSE # 33570

REVISIONS TO ADDRESS CITY PLAN REVIEW COMMENTS
REVISIONS TO ADDRESS CITY FIRE REVIEW COMMENTS

715 BALMORAL CIRCLE
DADE COUNTY, FL 33138
OFF: (305) 367-6768
FAX: (305) 326-2331

REVISIONS TO ADDRESS CITY PLAN REVIEW COMMENTS
REVISIONS TO ADDRESS CITY FIRE REVIEW COMMENTS