

SITE PLAN
 1. Building
 2. Parking
 3. Neighbouring Build.

Room Schedule			
Label	Room Name	Area	Type
FLOOR AREA			
Lower Level	1. COMMERCIAL / LOWER	24,664.97	Commercial Heated
Main Level	1. COMMERCIAL/MAIN	48,120.03	Commercial Heated
Main Level	2. COVERED DECK	27.18	External / Covered
Main Level	3. COVERED DECK	1,969.00	External / Covered
Main Level	4. COVERED DECK	323.98	External / Covered
		75,105.16 ft²	

Sheet Index	
AS Built Drawings	
.1	Main Floor Plan
.2	Lower Floor Plan
.3	Generic Perspectives




PROJECT LOCATION MAP

GENERAL NOTES:
 1. DO NOT USE AS A BLUEPRINTS WITHOUT WR LLC PERMISSION.
 2. PLEASE NOTE: INTERIOR DIMENSIONS WERE NOT USED IN CALCULATING SQUARE FOOTAGE.
 3. SIZE OF HEATED AND NOT HEATED AREA AND OTHER INFORMATION WERE OBTAINED PER THE NC REAL ESTATE COMMISSION LICENSEE'S REPORT FOR EXTERNAL WALLS (EXCEPT CONDOMINIUMS).
 4. FOR FURTHER INFORMATION OR MORE DETAILED CAD DRAWINGS (INC. SITE PLAN, SECTIONS, ELEVATIONS), ALSO AS A MODEL, PLEASE CONTACT: ALPHIE DAVIDSON, MOB: 828.231.7395, EMAIL: A.DAVIDSON@HOTMAIL.COM

e-mail address
 phone number

LEGEND MAP:
 HEATED RESIDENT FINISHED
 HEATED COMMERCIAL FINISHED
 NOT HEATED/NOT FINISHED
 OPEN DECK
 COVERED PORCH

Revision	NO.	DATE	DESCRIPTION

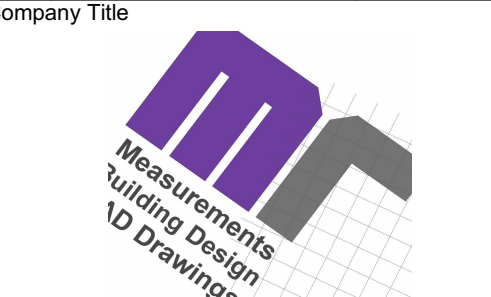

Measure Rite LLC
 103 Poplar Spring Trail, Hendersonville, NC 28739
 #Contact Country NC 28739

Site Address:
701 Oriole Dr, Hendersonville, NC 28792

Drawing Name:
Main Level, Room Schedule, Site Plan, Sheet Index

Drawing Status:


Project Name: #102 ZAL 19	Job No: MR 1141
Project Date: 08/23/2024	Issue: 025/2024
Drawing Scale: 1/8" = 1'-0"	Project Size: #MainLevelSubSet
Project ID: ANSI B	Revision: 1

2


3





Room Schedule			
Label	Room Name	Area	Type
FLOOR AREA			
Lower Level	1. COMMERCIAL / LOWER	24,664.97	Commercial Heated
Main Level	1. COMMERCIAL/MAIN	48,120.03	Commercial Heated
Main Level	2. COVERED DECK	27.18	External / Covered
Main Level	3. COVERED DECK	1,969.00	External / Covered
Main Level	4. COVERED DECK	323.98	External / Covered
		75,105.16 ft²	

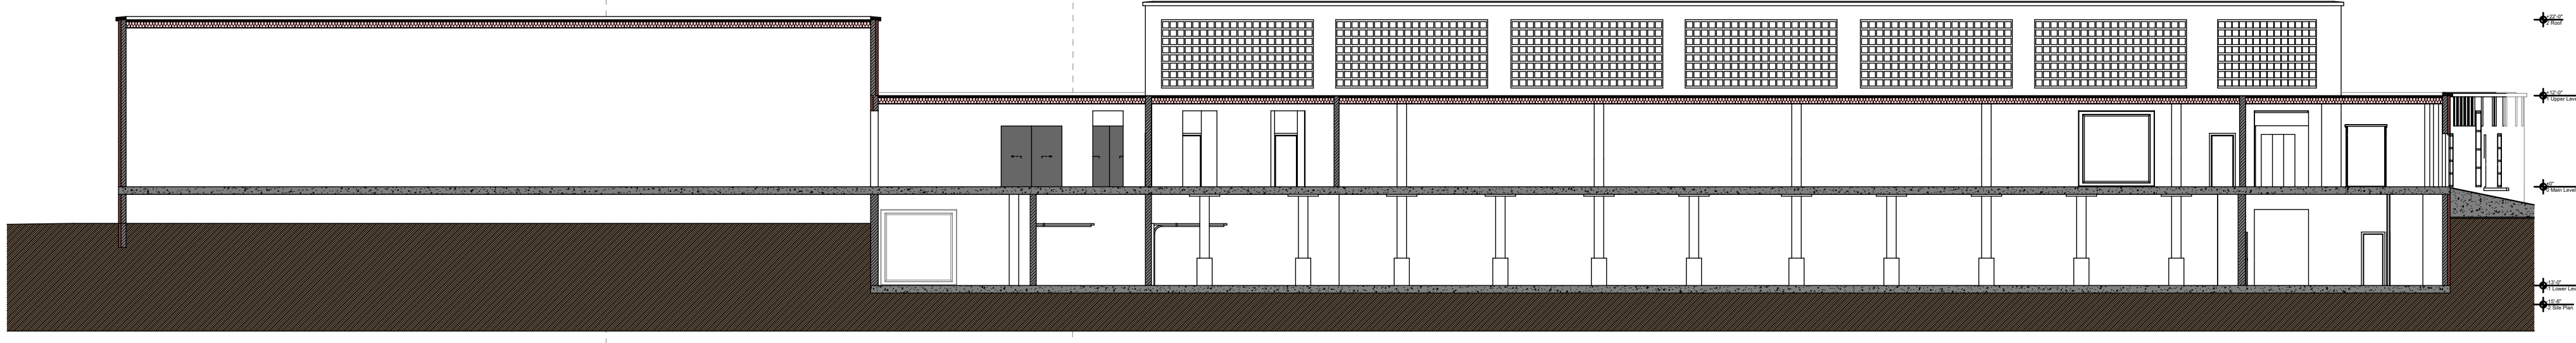

2 SEC
1/16" = 1'-0"

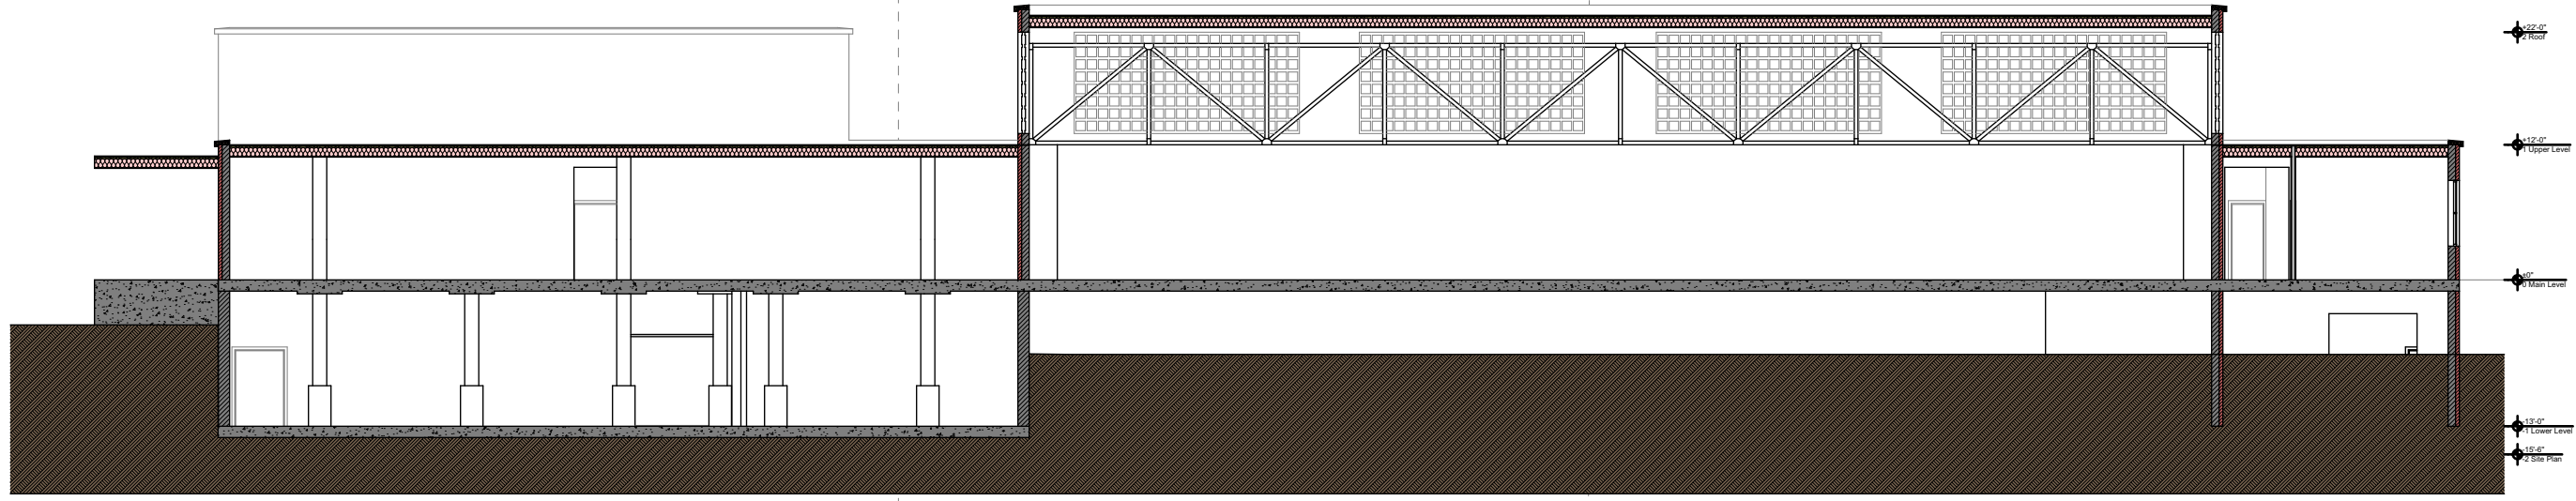

A SEC
1/16" = 1'-0"

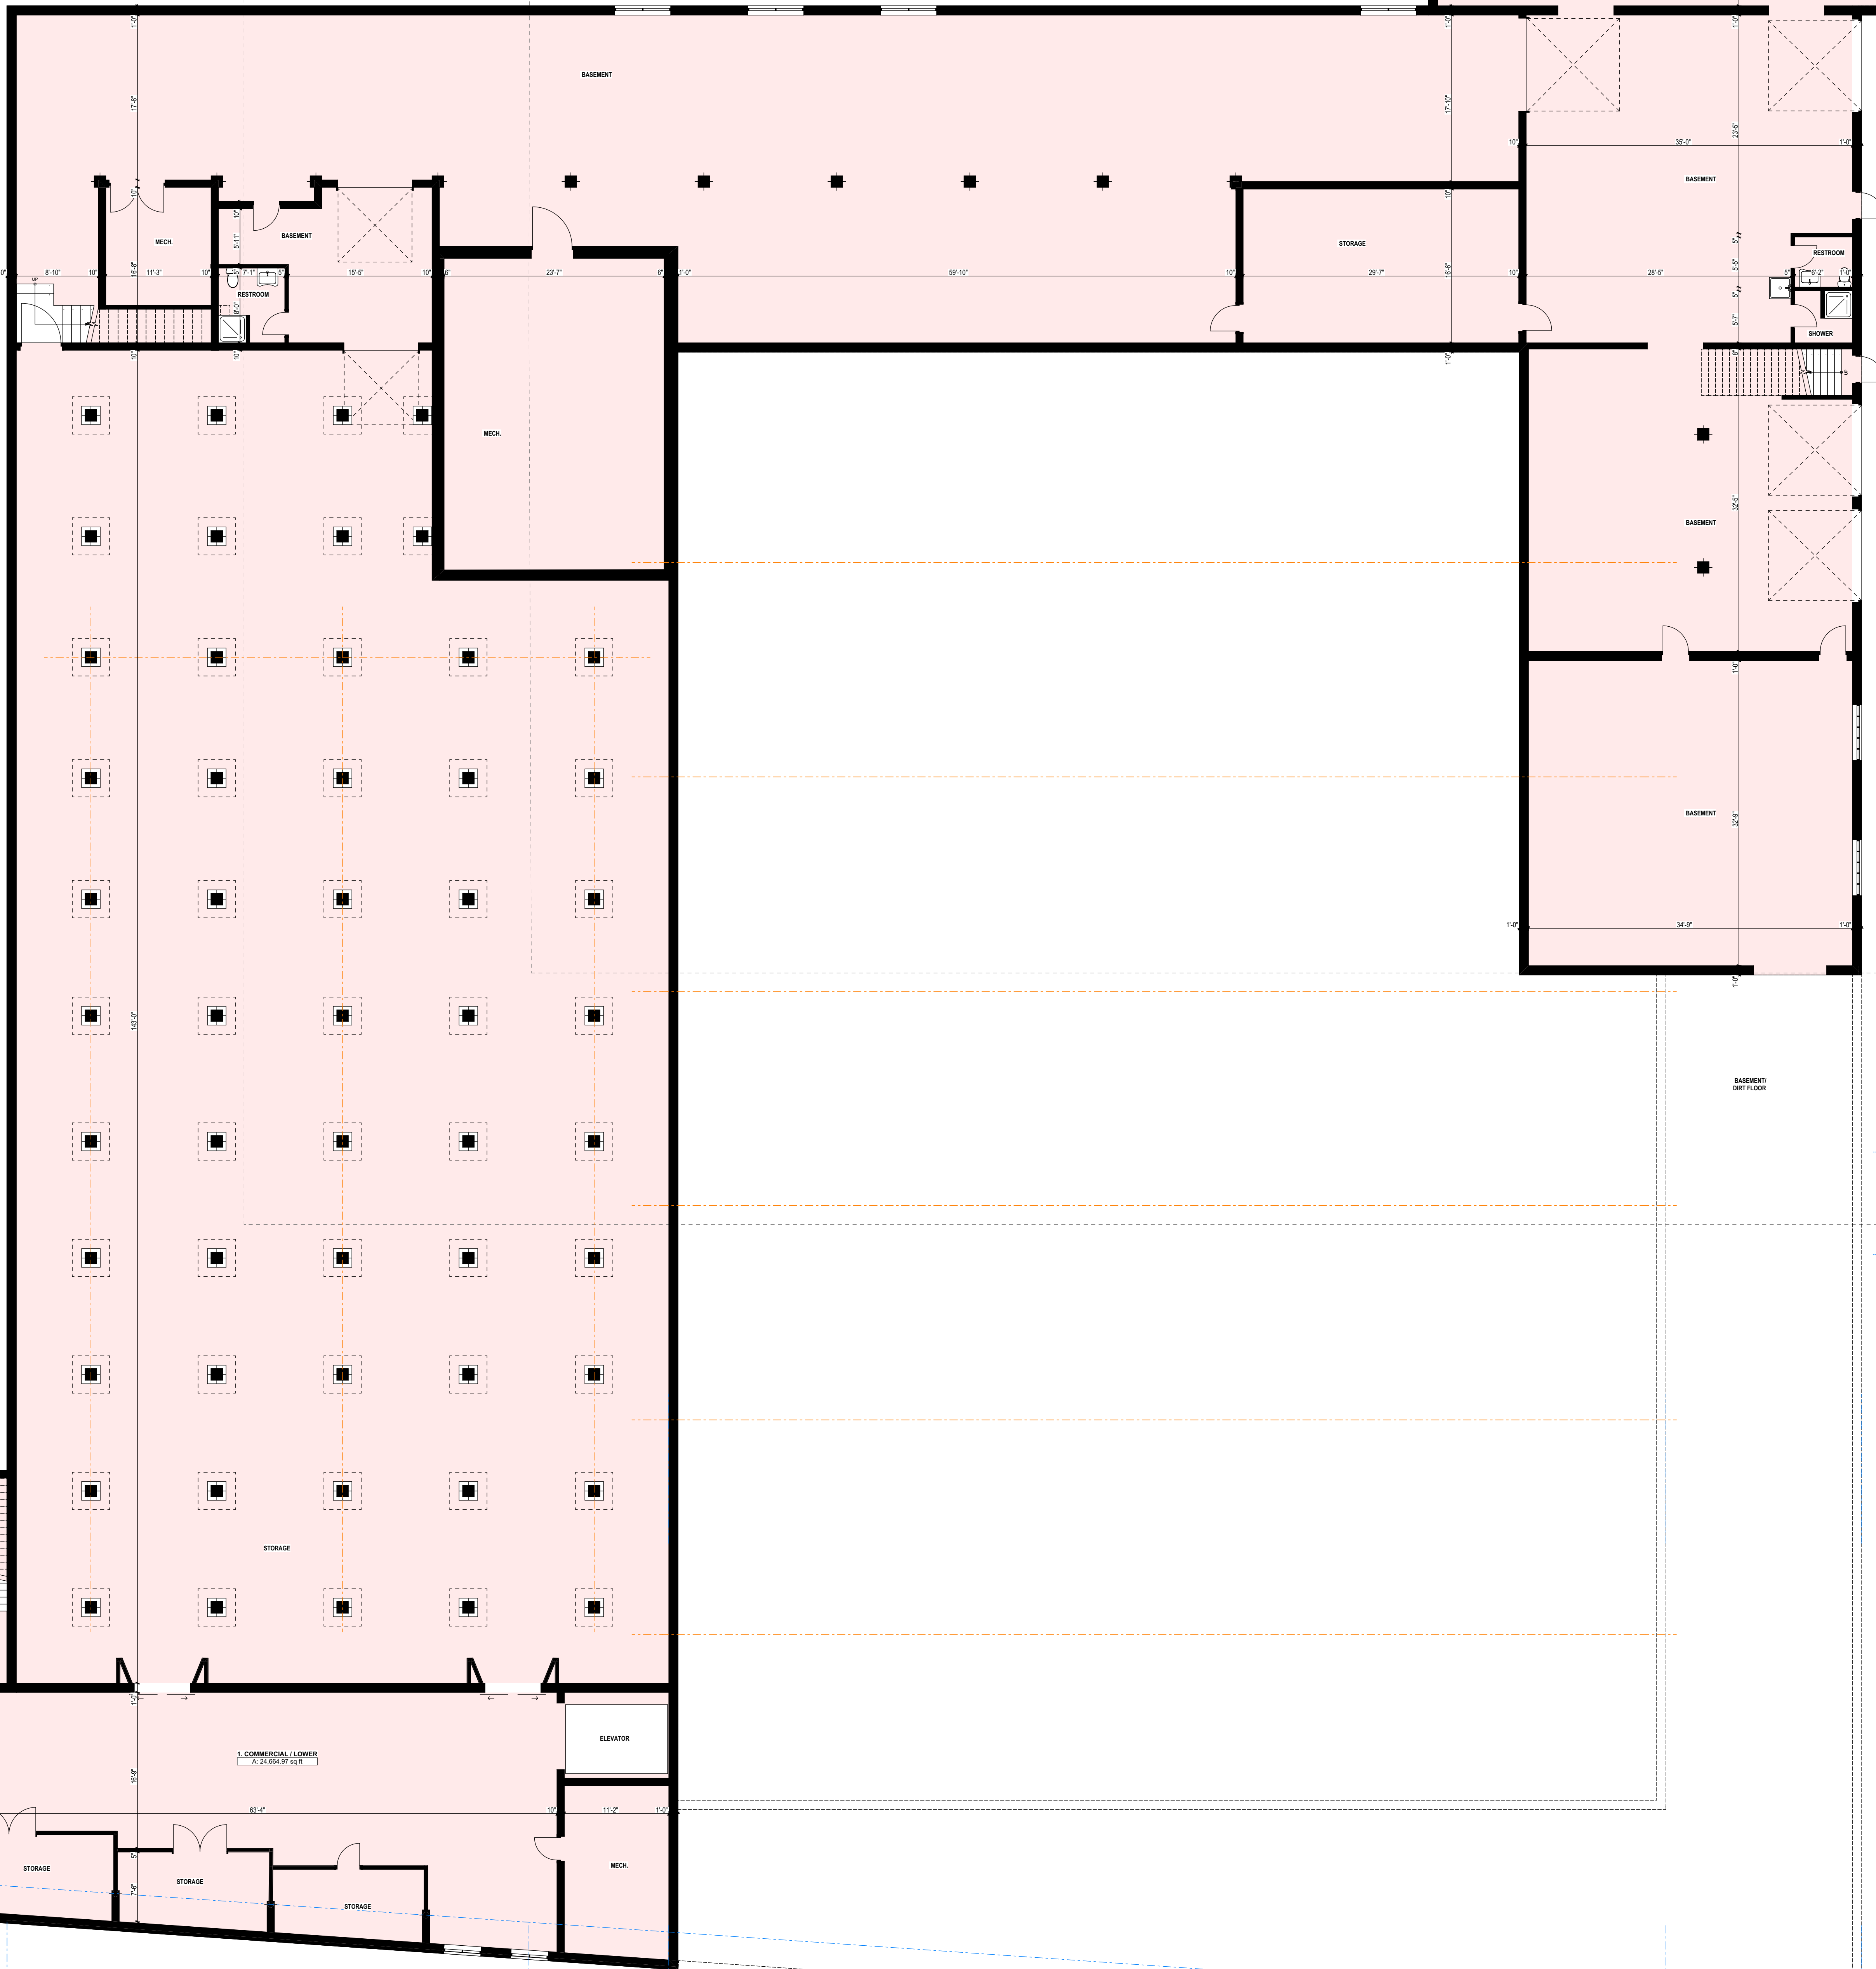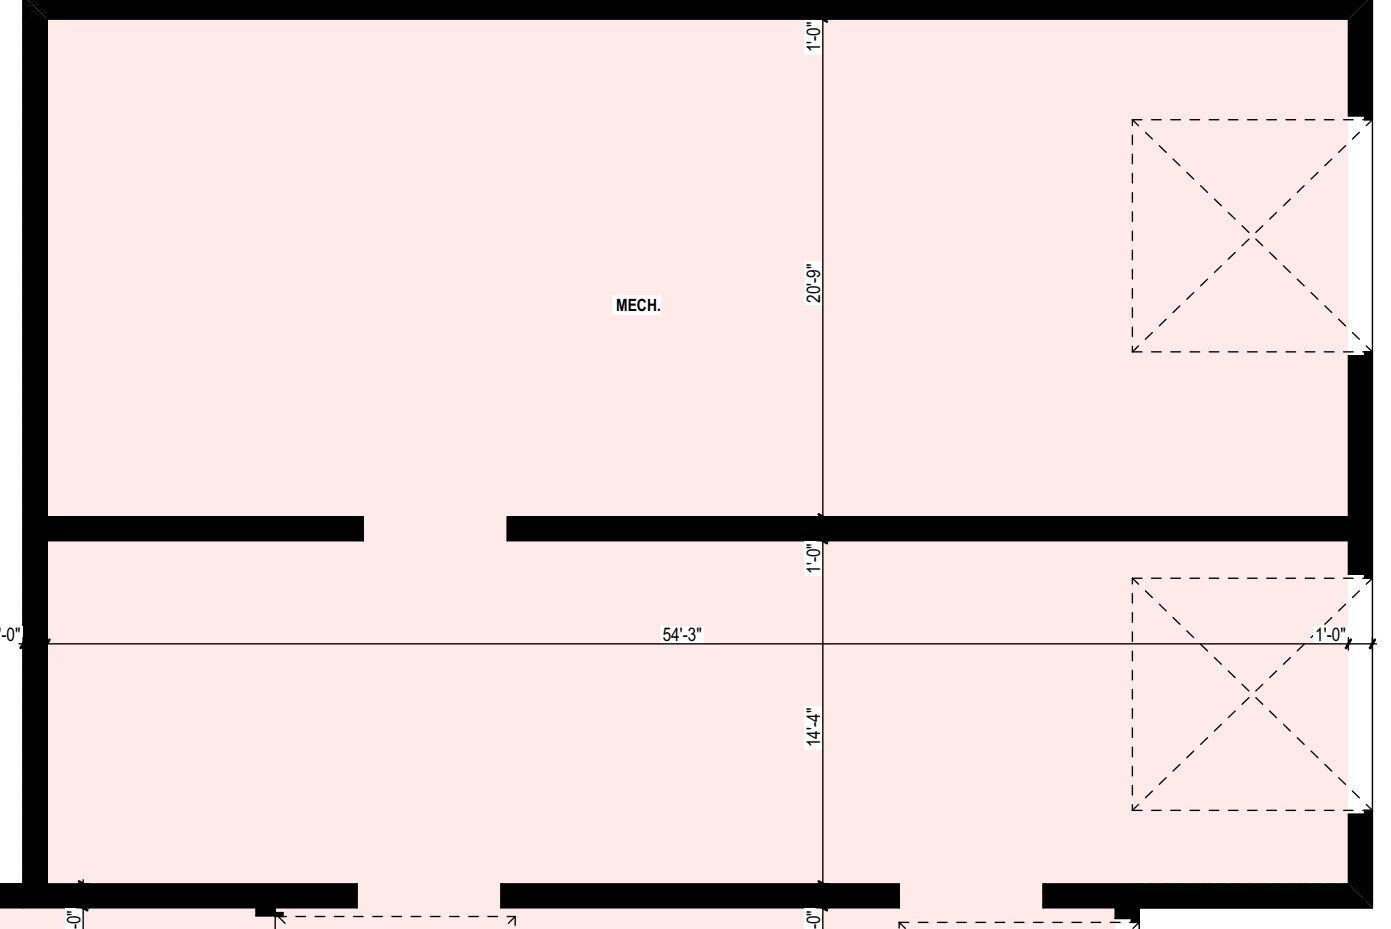


PROJECT LOCATION MAP

GENERAL NOTES:
 1. DO NOT USE AS A BLUEPRINTS WITHOUT WR LLC PERMISSION.
 2. PLEASE NOTE: WINDOW DIMENSIONS WERE NOT USED IN CALCULATING SQUARE FOOTAGE.
 3. SIZE OF HEATED AND NOT HEATED AREA AND OTHER INFORMATION WERE OBTAINED PER THE NC REAL ESTATE COMMISSION (R.E.C.) FILE # FOR EXTERNAL WALLS (EXCEPT CONDOMINIUMS).
 4. FOR FURNISHING, QUESTIONING OR MORE DETAILED CAD DRAWINGS (INC. SITE PLAN, SECTIONS, ELEVATIONS), ALSO FOR MODEL, PLEASE CONTACT: ALPHIE DAVIS, MOB: 828.231.7365, EMAIL: A.DAVIS@HOTMAIL.COM

DATE: _____
 e-mail address _____
 phone number _____

LEGEND MAP:
 HEATED RESIDEN FINISHED
 HEATED COMMERC FINISHED
 NOT HEATED/NOT FINISHED
 OPEN DECK
 COVERED PORCH

Revision	NO	DATE	CHANGE

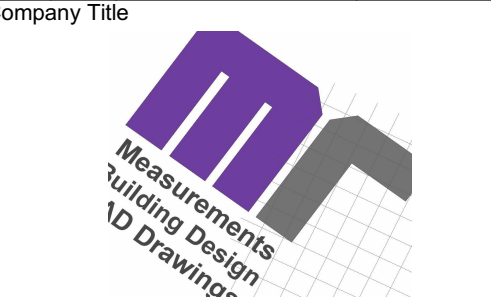


Company: **Measure Rite LLC**
 103 Poplar Spring Trail, Hendersonville, NC 28739
 #Contact Country NC 28739

Site Address: **701 Oriole Dr, Hendersonville, NC 28792**


Drawing Name: **Lower Level, Room Schedule, 2 SEC, A SEC**

Drawing Status: _____
 Project Name: _____ Job No: _____
 Project No: **MR 1141** Date: _____
 Drawing Scale: **1/8" = 1'-0"** Project Size: _____
 Project ID: **ANSI B** Project Size: _____


Lower Level
1/8" = 1'-0"

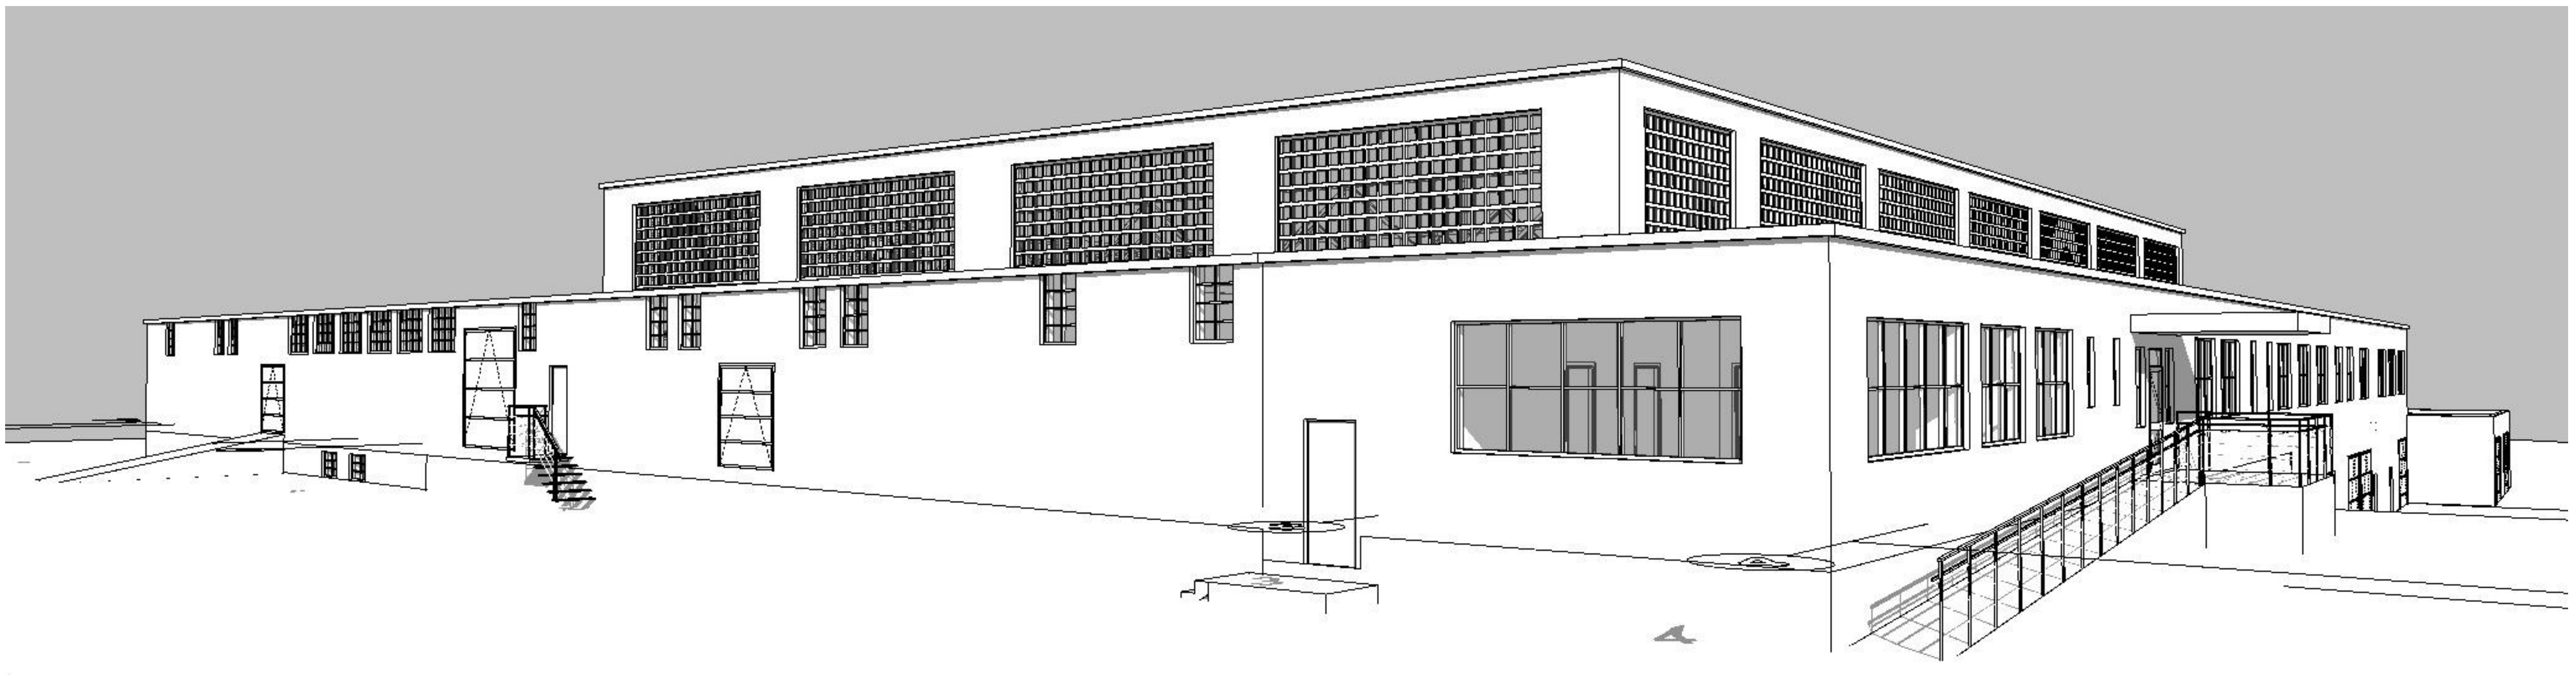

Camera-White
1/8" = 1'-0"

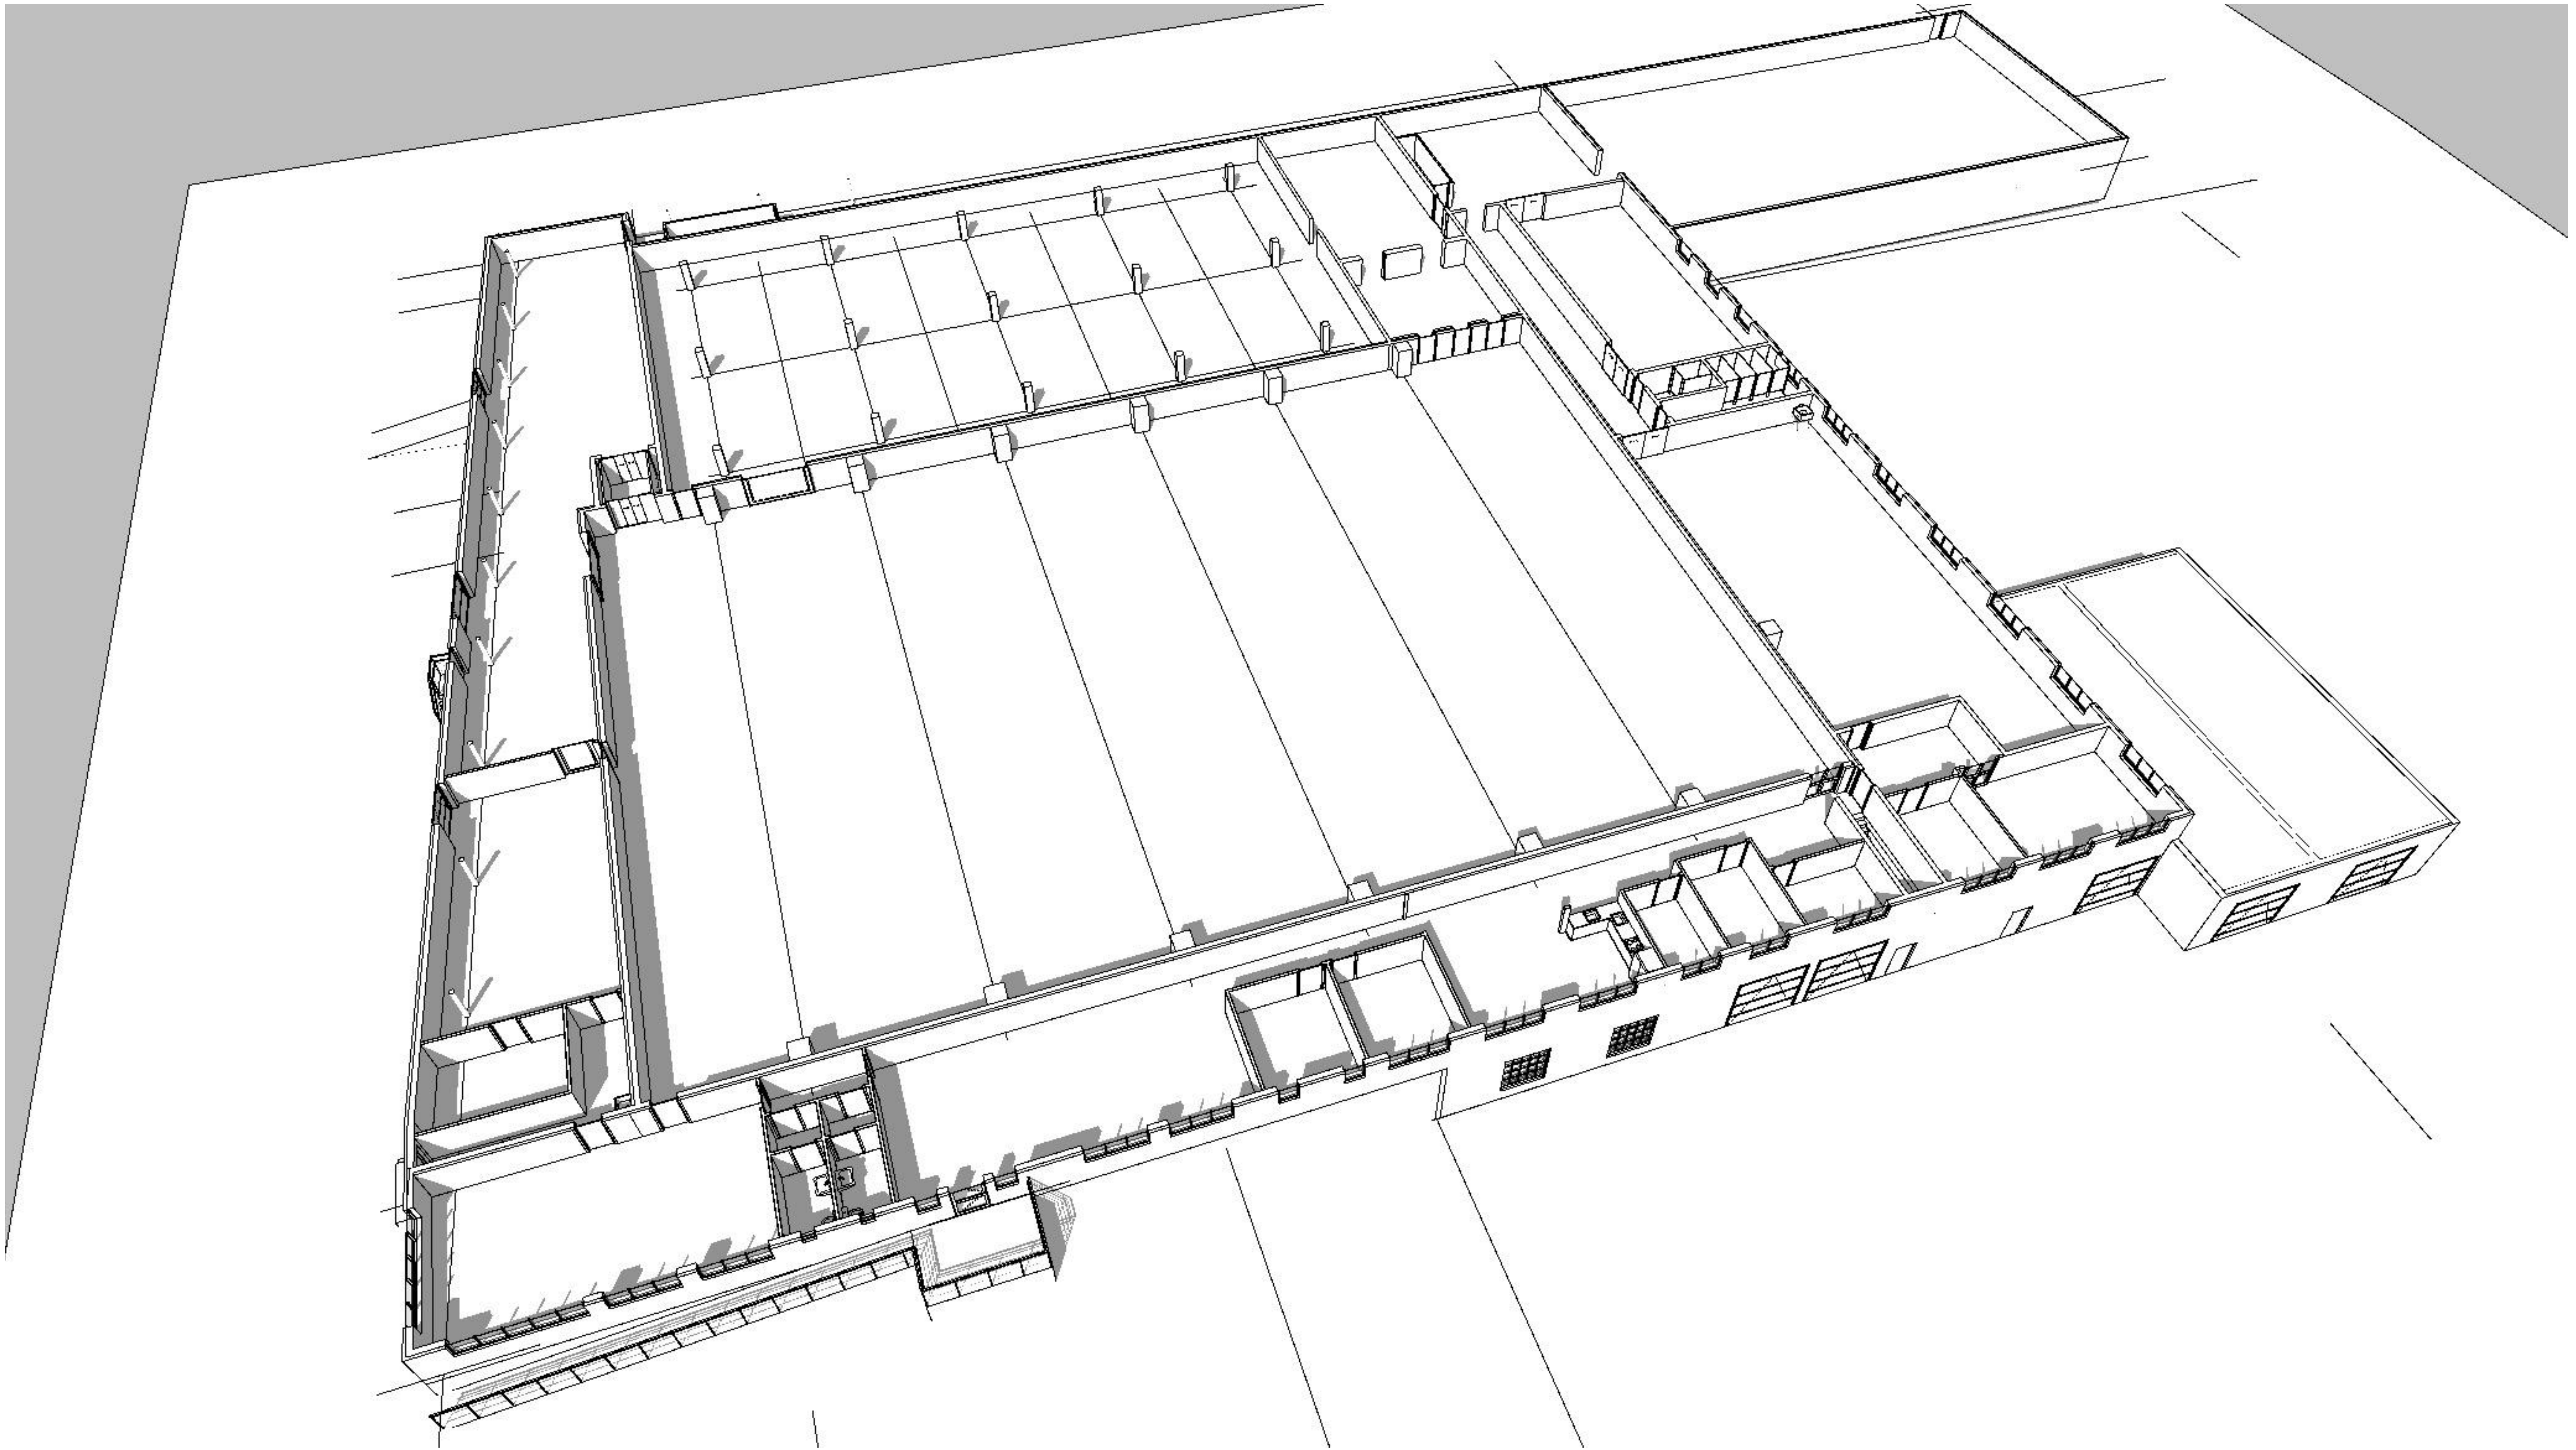

Generic Perspective / MAIN
1" = 1'-0"

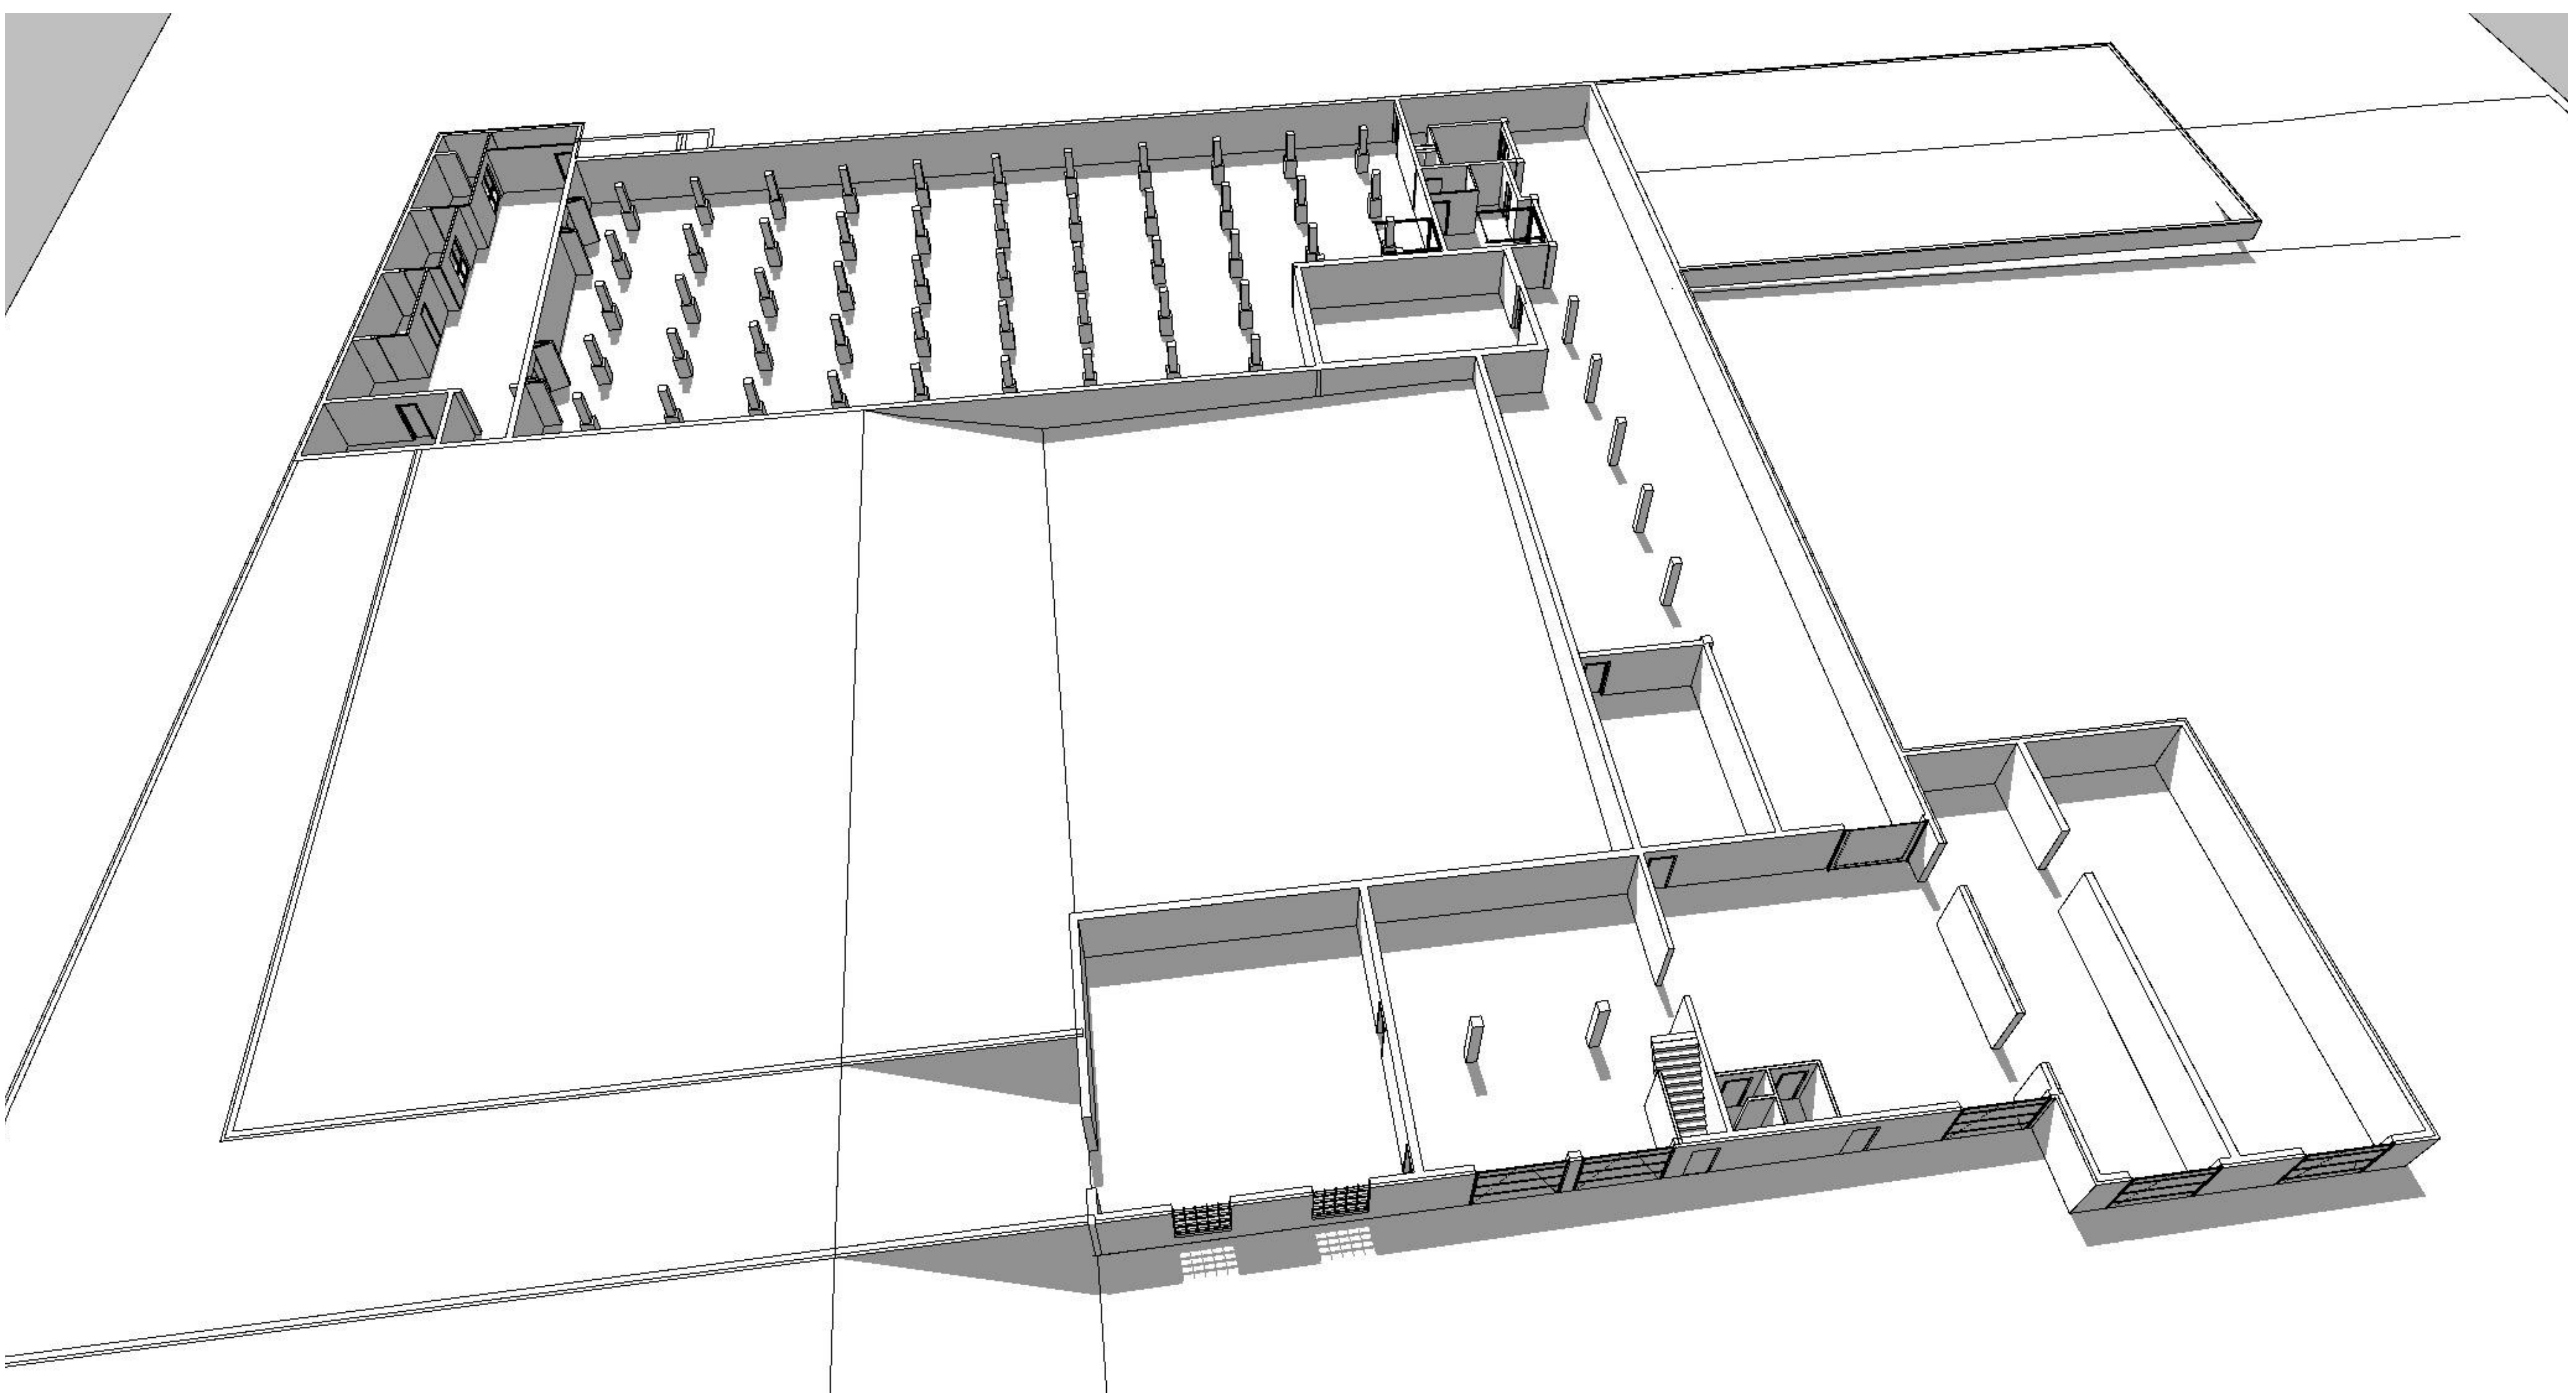

Generic Perspective (1)
1/8" = 1'-0"




PROJECT LOCATION MAP

GENERAL NOTES:
 1. DO NOT USE AS A BLUEPRINT WITHOUT WRITTEN PERMISSION.
 2. PLEASE NOTE: DIMENSIONS WERE NOT USED IN CALCULATING SQUARE FOOTAGE.
 3. SIZE OF HEATED AND NOT HEATED AREAS AND OTHER INFORMATION WERE OBTAINED PER THE NC REAL ESTATE COMMISSION LICENSEE'S FILE # FOR EXTERNAL WALLS (EXCEPT CONDOMINIUMS).
 4. FOR FURNISHING QUESTIONS OR MORE DETAILED CAD DRAWINGS (INC. SITE PLAN, SECTIONS, ELEVATIONS), ALSO 3D MODEL, PLEASE CONTACT: ARIANNE DAVIS, MOB: 838 231 7305, E-MAIL: A.DAVIS@HOTMAIL.COM

e-mail address
 phone number

LEGEND MAP:
 HEATED RESIDEN FINISHED
 HEATED COMMERC FINISHED
 NOT HEATED NOT FINISHED
 OPEN DECK
 COVERED PORCH

Revision	By	Check	Change	Date

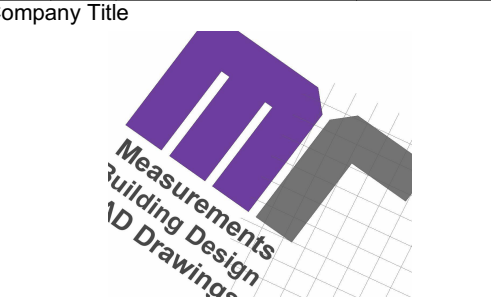

Measure Rite LLC
 103 Poplar Spring Trail, Hendersonville, NC 28739

701 Oriole Dr, Hendersonville, NC 28792

Camera-White, Generic Perspective / MAIN, Generic Perspective (1)

Sheet No.	Job No.
ANSI B	MR 1141