

LIVING AREA
3477 SQ FT

ALL DESIGNS HEREIN REMAIN
THE INTELLECTUAL PROPERTY
OF JOHN K. GEORGE & COMPANY.
ALL RIGHTS RESERVED.




JOHN K. GEORGE & CO.
A Design / Build Firm

JAMES RIVER LANDING BUSINESS CENTER

FLOOR PLAN - AS BUILT

1/8" = 1'-0"
12/9/2024

PAGE: **A1**

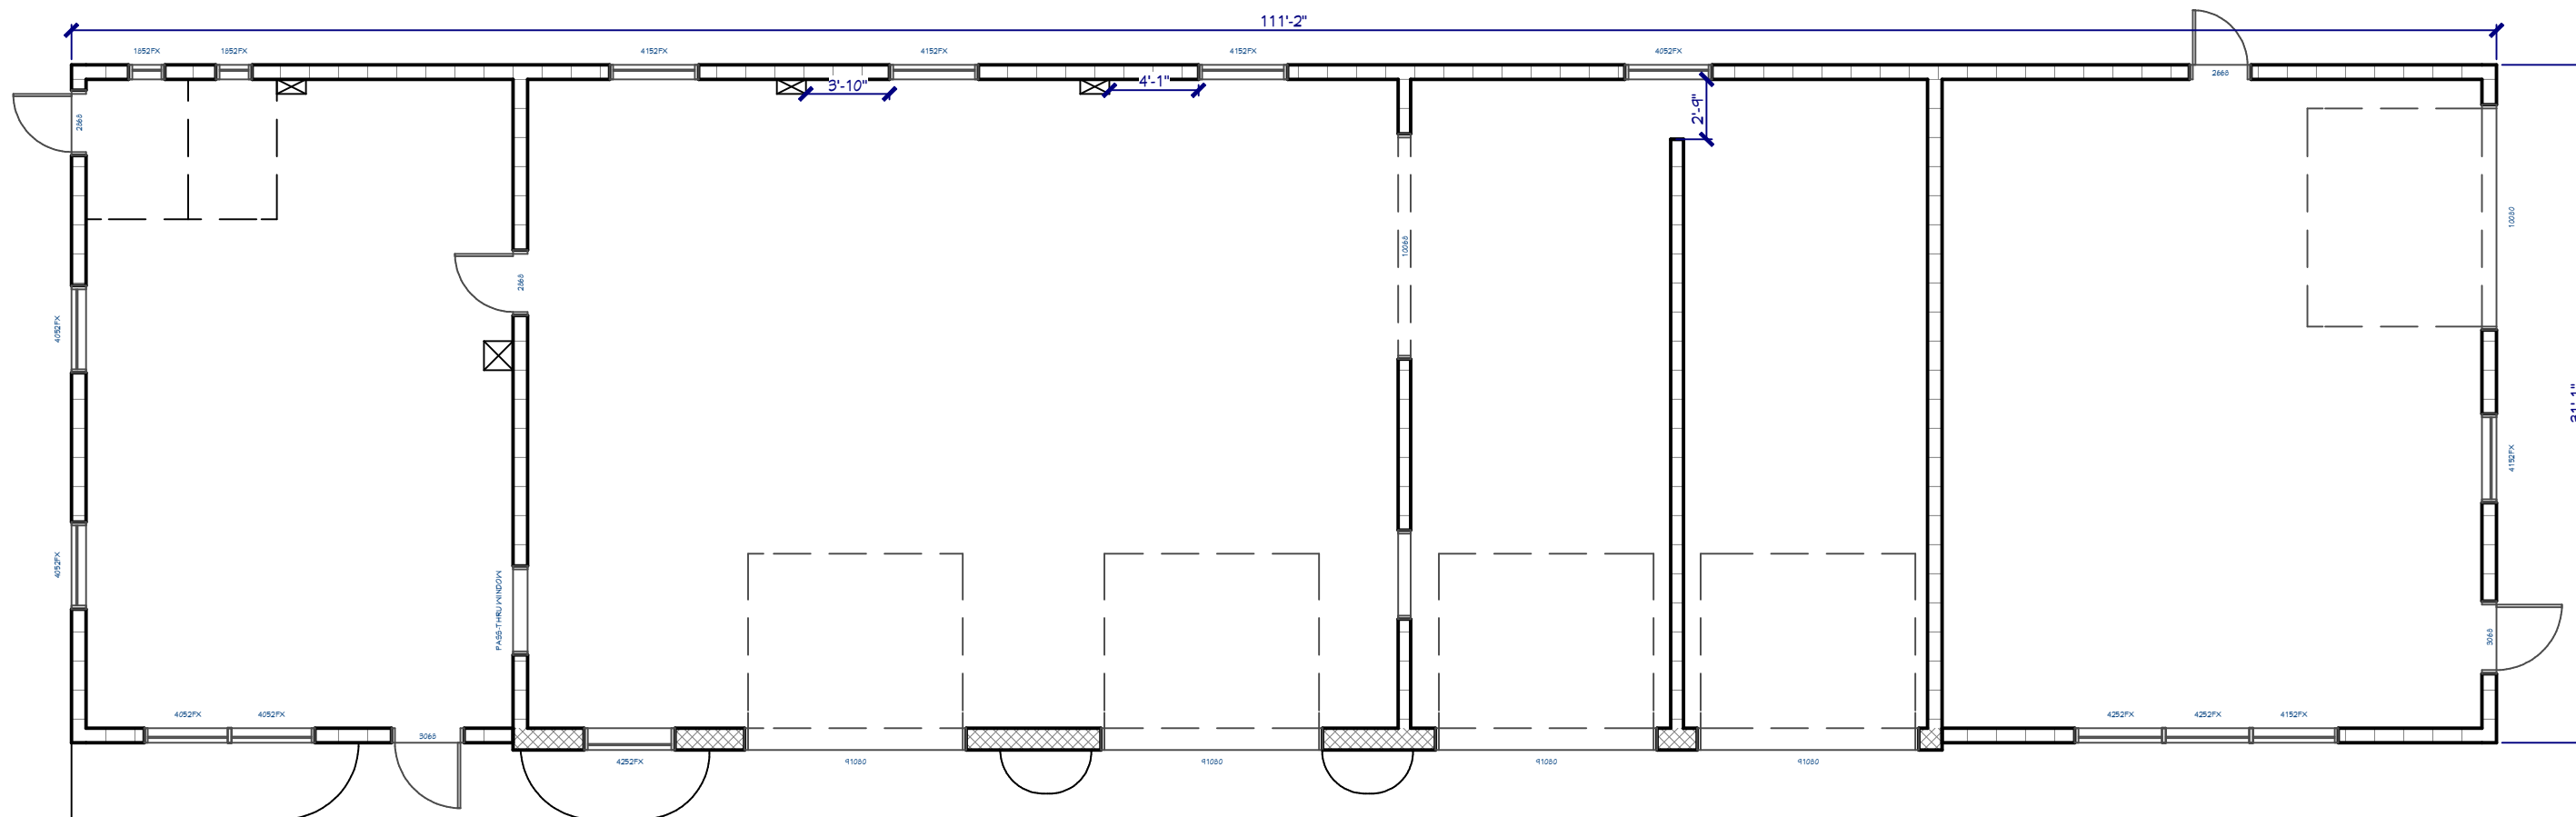

ALL DESIGNS HEREIN REMAIN
THE INTELLECTUAL PROPERTY
OF JOHN K. GEORGE & COMPANY.
ALL RIGHTS RESERVED.

1/8"=1'-0"
12/9/2024



JOHN K. GEORGE & CO.
A Design / Build Firm

JAMES RIVER LANDING BUSINESS CENTER

FLOOR PLAN - AS BUILT

PAGE: **A1**