


\\drawing\name: C:\Users\mehschuck\Desktop\Projects\BPR\_Wingate\Arch\Wingate\_Bldg\_1.dwg - 3rd Floor\_30 x 42 - 1/23/2022 10:01 AM



triad design group  
Architecture | Engineering | Interior Design

Triad Design Group, P.C.  
4807-C Koger Boulevard  
Greensboro, NC 27407  
Telephone 336-218-8282  
Facsimile 336-218-8010  
www.triad-designgroup.com


NC Architecture Reg. 50709  
NC Engineering Lic. C-1108

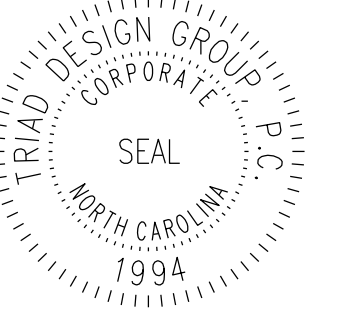

**PRELIMINARY**

NOT FOR CONSTRUCTION

**Wingate Building**  
ORP Management  
4900 Koger Boulevard  
Greensboro, North Carolina 27407

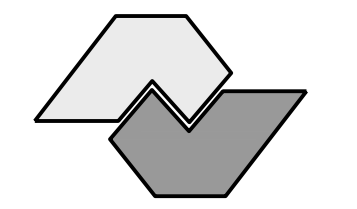

SUBMITTALS:

DATE	DESCRIPTION

REVISIONS:


NO	DATE	DESCRIPTION

SHEET TITLE:

**AS-BUILT OVERALL THIRD FLOOR**

Date: JANUARY 22, 2021  
Drawn: Check: MTM  
Job Number: 22-006  
Sheet:

**A103**

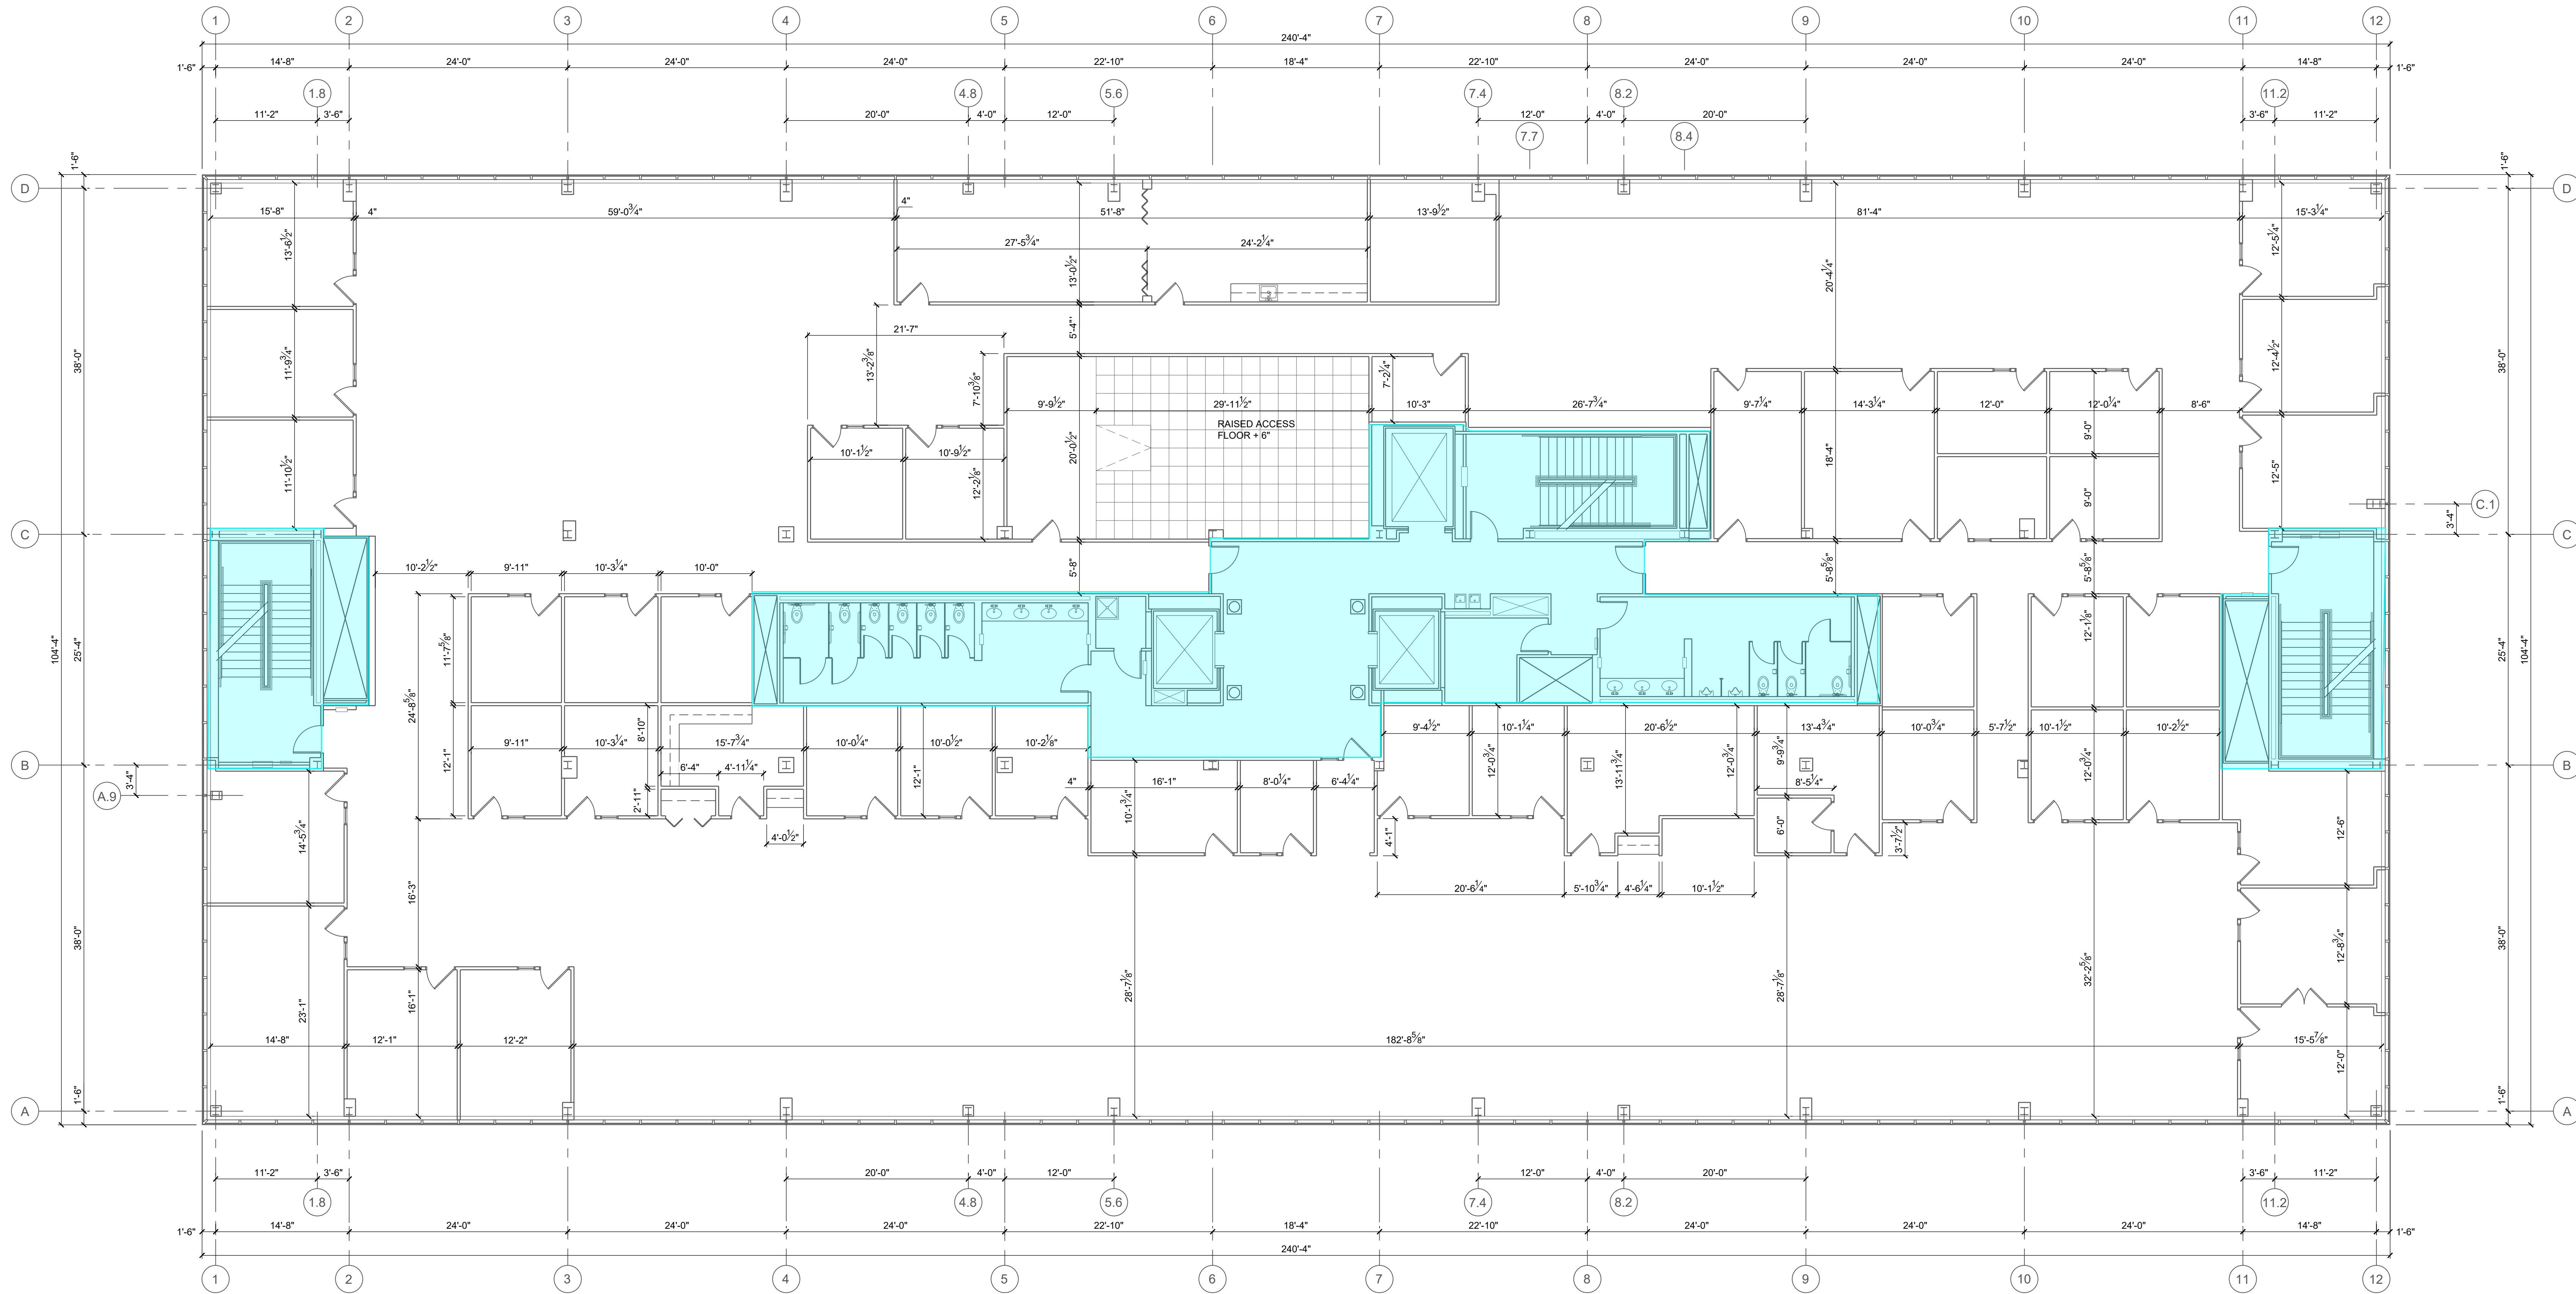

**A1** EXISTING THIRD FLOOR PLAN  
SCALE: 1/8"=1'-0"