

NORTH

1 1ST FLOOR PLAN
A-110 1/4"=1'-0"

GENERAL NOTES

- ALL WINDOWS ARE APPROXIMATELY REPRESENTED TO THE ROUGH OPENING IN THEIR RESPECTIVE WALLS. ACTUAL WINDOW SIZE TO BE CONFIRMED IN FIELD WHEN PRECISE DIMENSIONS ARE CRITICAL TO THE SCOPE OF WORK

- ALL WALL THICKNESS REPRESENTED DOES NOT INCLUDE TRIM SIZING

SQUARE FOOTAGE		
FIRST FLOOR		
UNCONDITIONED	2,158	SF
FRONT PORCH	79	SF
REAR PORCH	90	SF
REAR AWNING	484	SF
WAREHOUSE	2,990	SF
SECOND FLOOR		
CONDITIONED	2,990	SF
TOTAL OF ALL SPACES	8,791	SF

JODY BAKER 210.705.4101
jody@alamoasbuilt.com AlamoAsBuilt.com

2502 HARRY WURZBACH ROAD
SAN ANTONIO, TX


AS-BUILT FLOOR PLAN

DATE: 04.02.2025


AS-BUILTS

Sheet Number

A-110

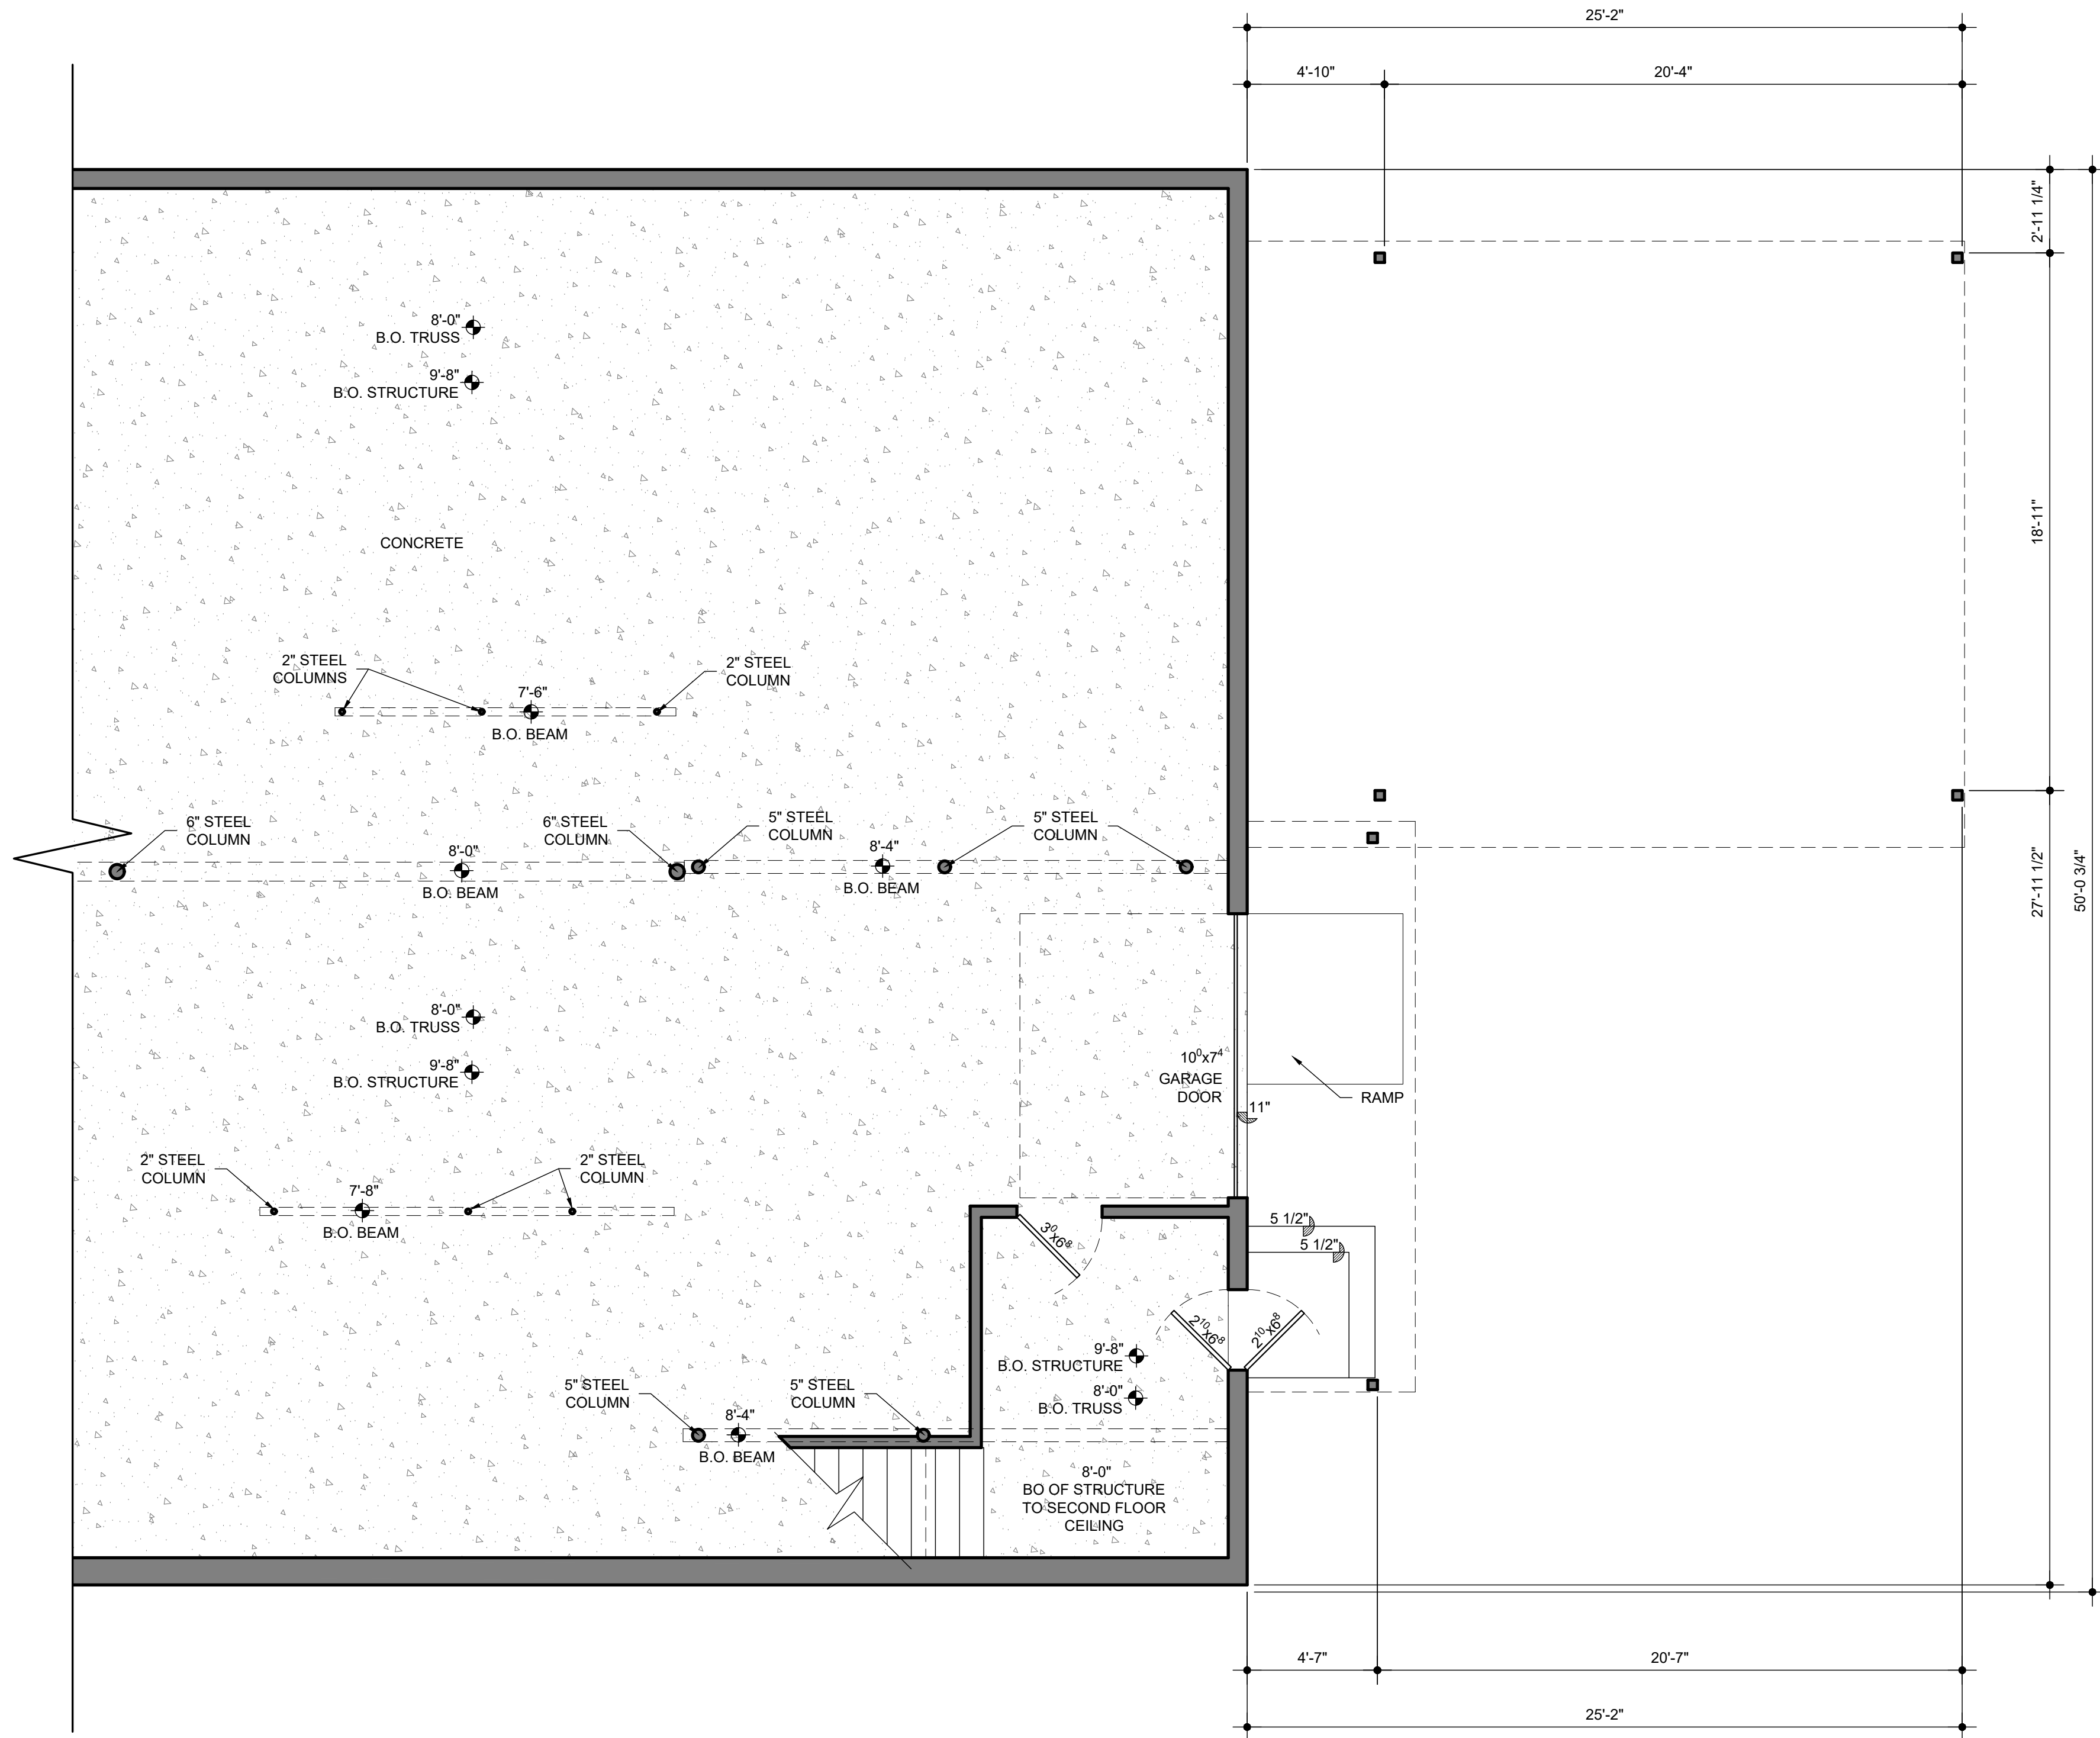

NORTH

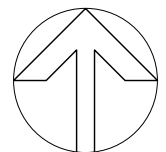

1 1ST FLOOR PLAN
A-111 1/4"=1'-0"

GENERAL NOTES

- ALL WINDOWS ARE APPROXIMATELY REPRESENTED TO THE ROUGH OPENING IN THEIR RESPECTIVE WALLS. ACTUAL WINDOW SIZE TO BE CONFIRMED IN FIELD WHEN PRECISE DIMENSIONS ARE CRITICAL TO THE SCOPE OF WORK
- ALL WALL THICKNESS REPRESENTED DOES NOT INCLUDE TRIM SIZING



JODY BAKER 210.705.4101
jody@alamoasbuilt.com AlamoAsBuilt.com

2502 HARRY
WURZBACH ROAD
SAN ANTONIO, TX

AS-BUILT FLOOR PLAN

DATE: 04.02.2025

AS-BUILTS

Sheet Number

A-111



NORTH
1
A-112
2ND FLOOR PLAN
1/4"=1'-0"

GENERAL NOTES


- ALL WINDOWS ARE APPROXIMATELY REPRESENTED TO THE ROUGH OPENING IN THEIR RESPECTIVE WALLS. ACTUAL WINDOW SIZE TO BE CONFIRMED IN FIELD WHEN PRECISE DIMENSIONS ARE CRITICAL TO THE SCOPE OF WORK


- ALL WALL THICKNESS REPRESENTED DOES NOT INCLUDE TRIM SIZING




JODY BAKER 210.705.4101
jody@alamoasbuilds.com AlamoAsBuilds.com

2502 HARRY WURZBACH ROAD SAN ANTONIO, TX	
AS-BUILT 2ND FLOOR PLAN	
Sheet Number A-112	

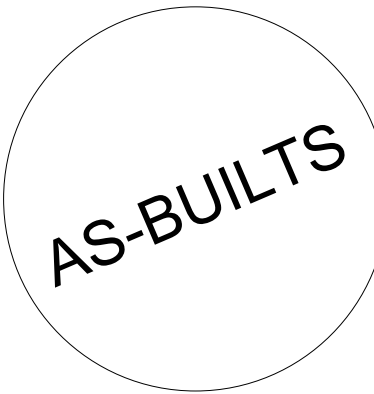

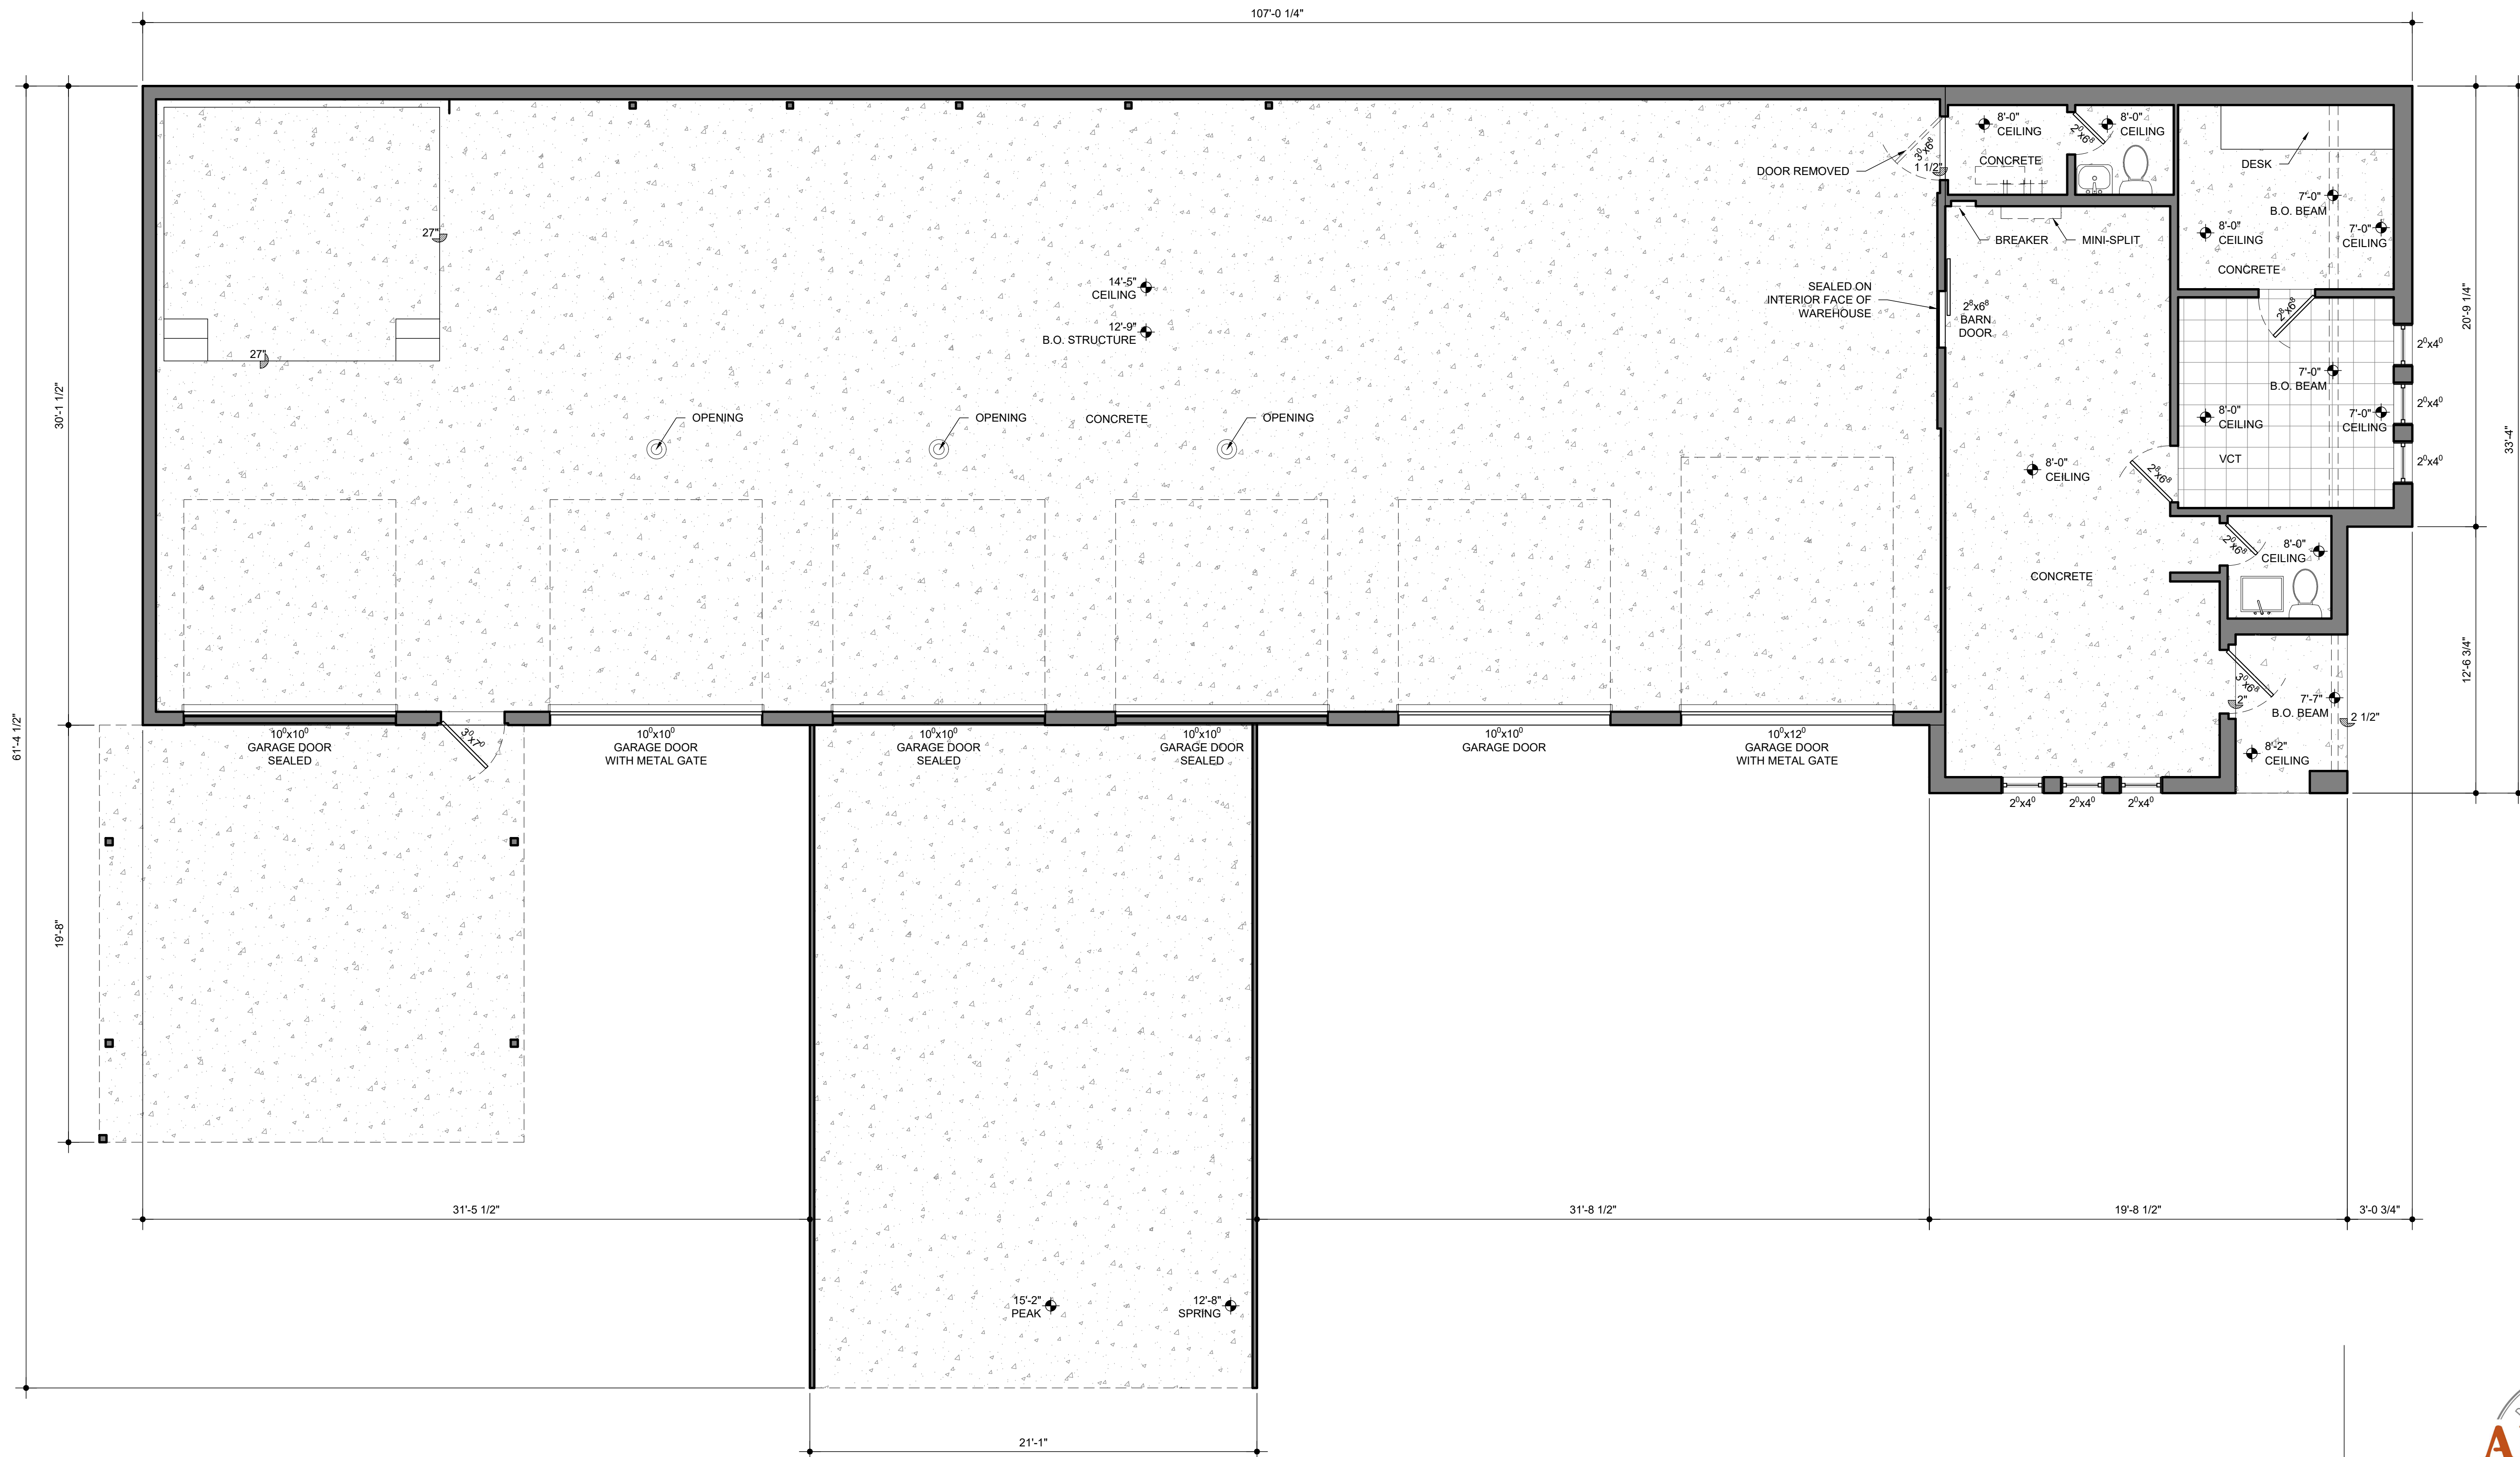

NORTH



1

1ST FLOOR PLAN

A-113

1/4"=1'-0"

GENERAL NOTES

- ALL WINDOWS ARE APPROXIMATELY REPRESENTED TO THE ROUGH OPENING IN THEIR RESPECTIVE WALLS, ACTUAL WINDOW SIZE TO BE CONFIRMED IN FIELD WHEN PRECISE DIMENSIONS ARE CRITICAL TO THE SCOPE OF WORK

- ALL WALL THICKNESS REPRESENTED DOES NOT INCLUDE TRIM SIZING

SQUARE FOOTAGE		
FIRST FLOOR		
CONDITIONED	658	SF
UNCONDITIONED		
WAREHOUSE	2,561	SF
FRONT PORCH	39	SF
AWNING	382	SF
AWNING	659	SF
TOTAL OF ALL SPACES	4,299	SF

DOCUMENTING THE

ALAMO

AS-BUILTS

BUILT ENVIRONMENT

JODY BAKER 210.705.4101
jody@alamoasbuilds.com AlamoAsBuilds.com

203 CORINNE DRIVE
SAN ANTONIO, TX

AS-BUILT FLOOR PLAN

AS-BUILTS

Sheet Number

A-113

DATE: 04.02.2025