


326 S. MARBLE ST.

326 S. MARBLE ST
ROCKMART, GA 30153
AS-BUILTS

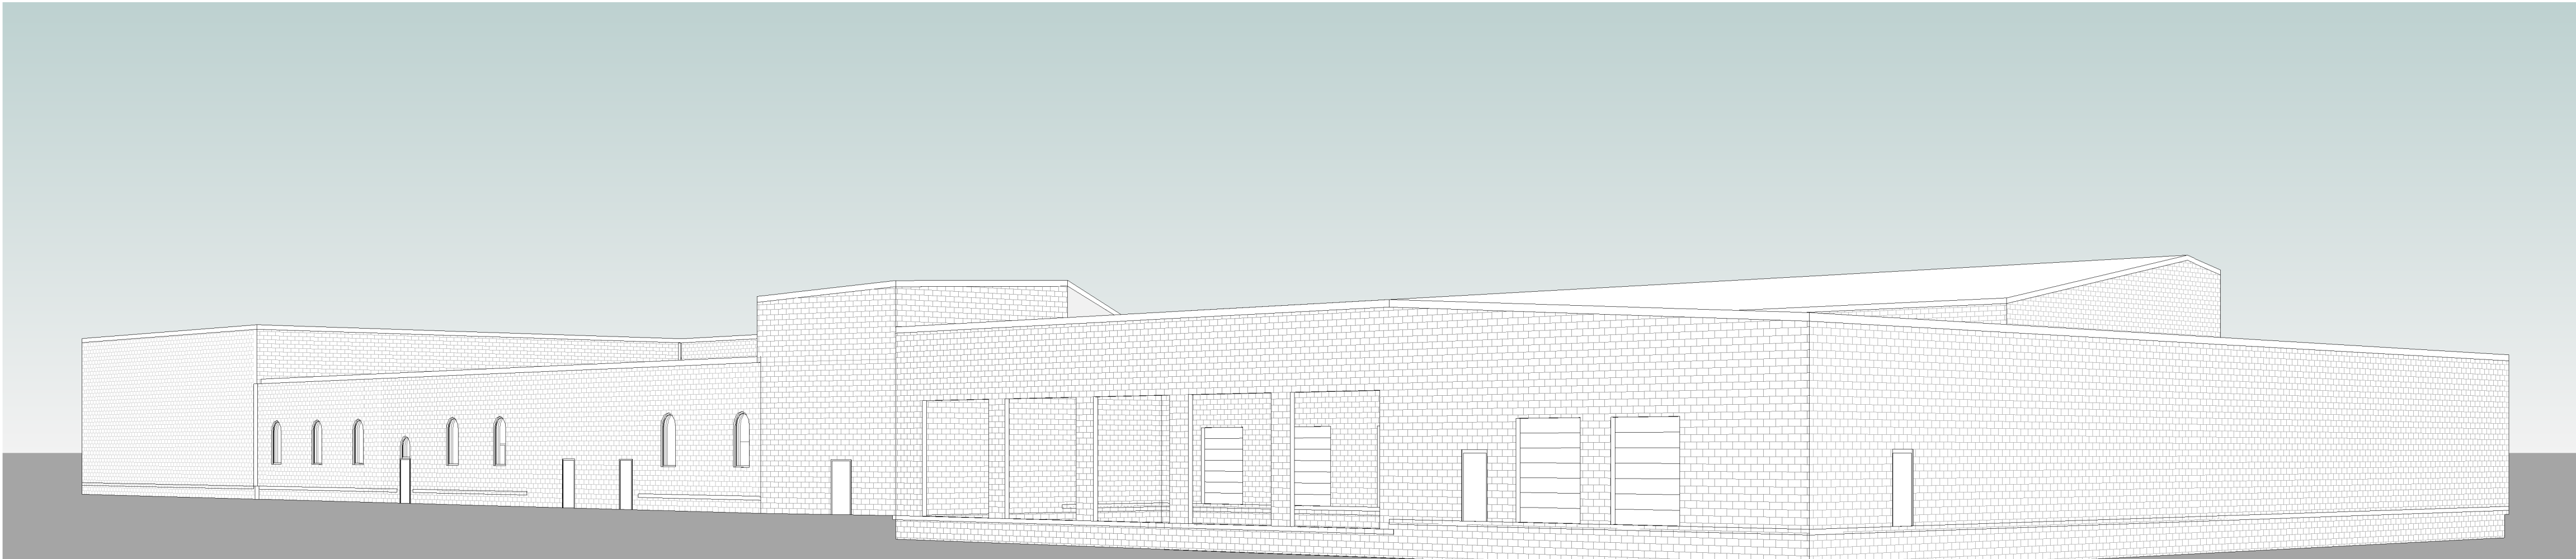


ARCHITECTURAL	
A0-0	COVER
A0-01	AREA PLANS
A1-01	OVERALL FLOOR PLAN
A1-02	ENLARGED OFFICE PLAN
A3-01	ELEVATIONS

BUILDING INFO

AS-BUILT MEASURMENTS TOOK PLACE
ON 11/05/2025

ADDRESS:
326 S. MARBLE ST.
ROCKMART, GA 30153

BUILDING LOCATION

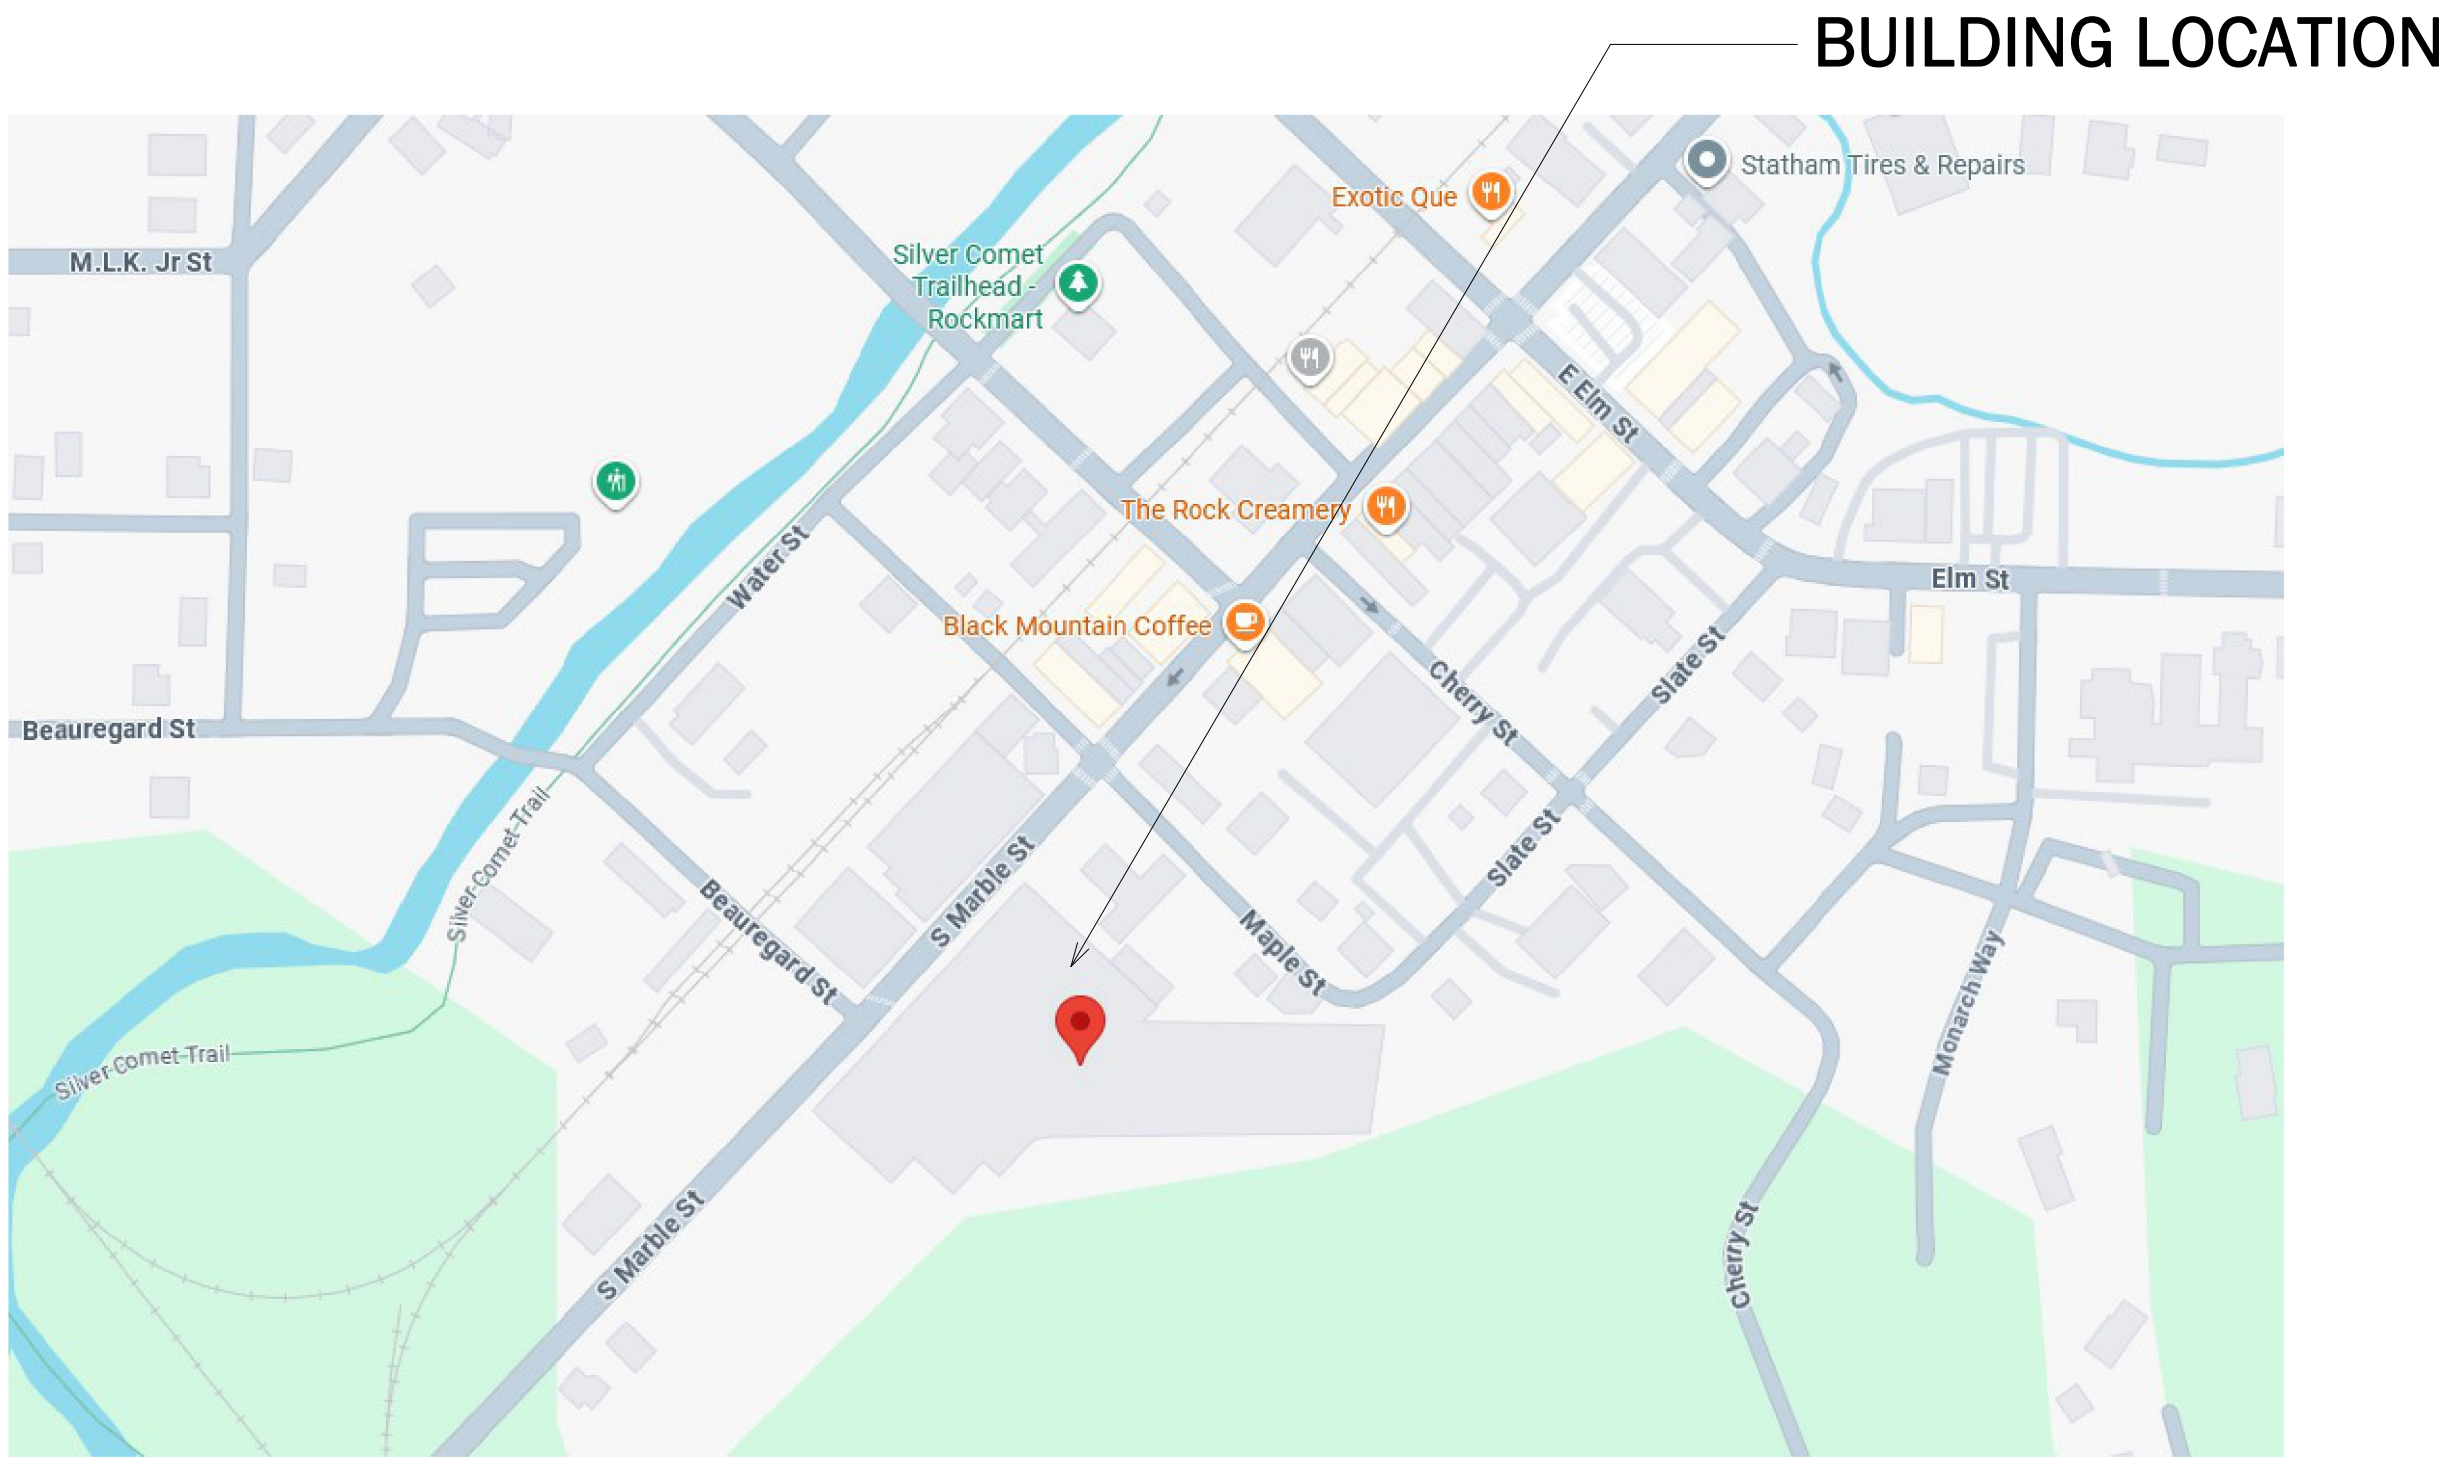

BIM DUDE
AREYNOLDS@BIMDUDE.DESIGN

PROJECT:
S. MARBLE ST.
AS-BUILT

CONSULTANTS:

SEAL


EXISTING
CONDITIONS

SCALE:		DATE: 11/14/25	
DRAWN BY: AR		CHECKED BY: AR	
NO.	REVISION:		DATE:

SHEET TITLE:
COVER

PROJECT NO.
2541-1

SHEET NO.
A0-0

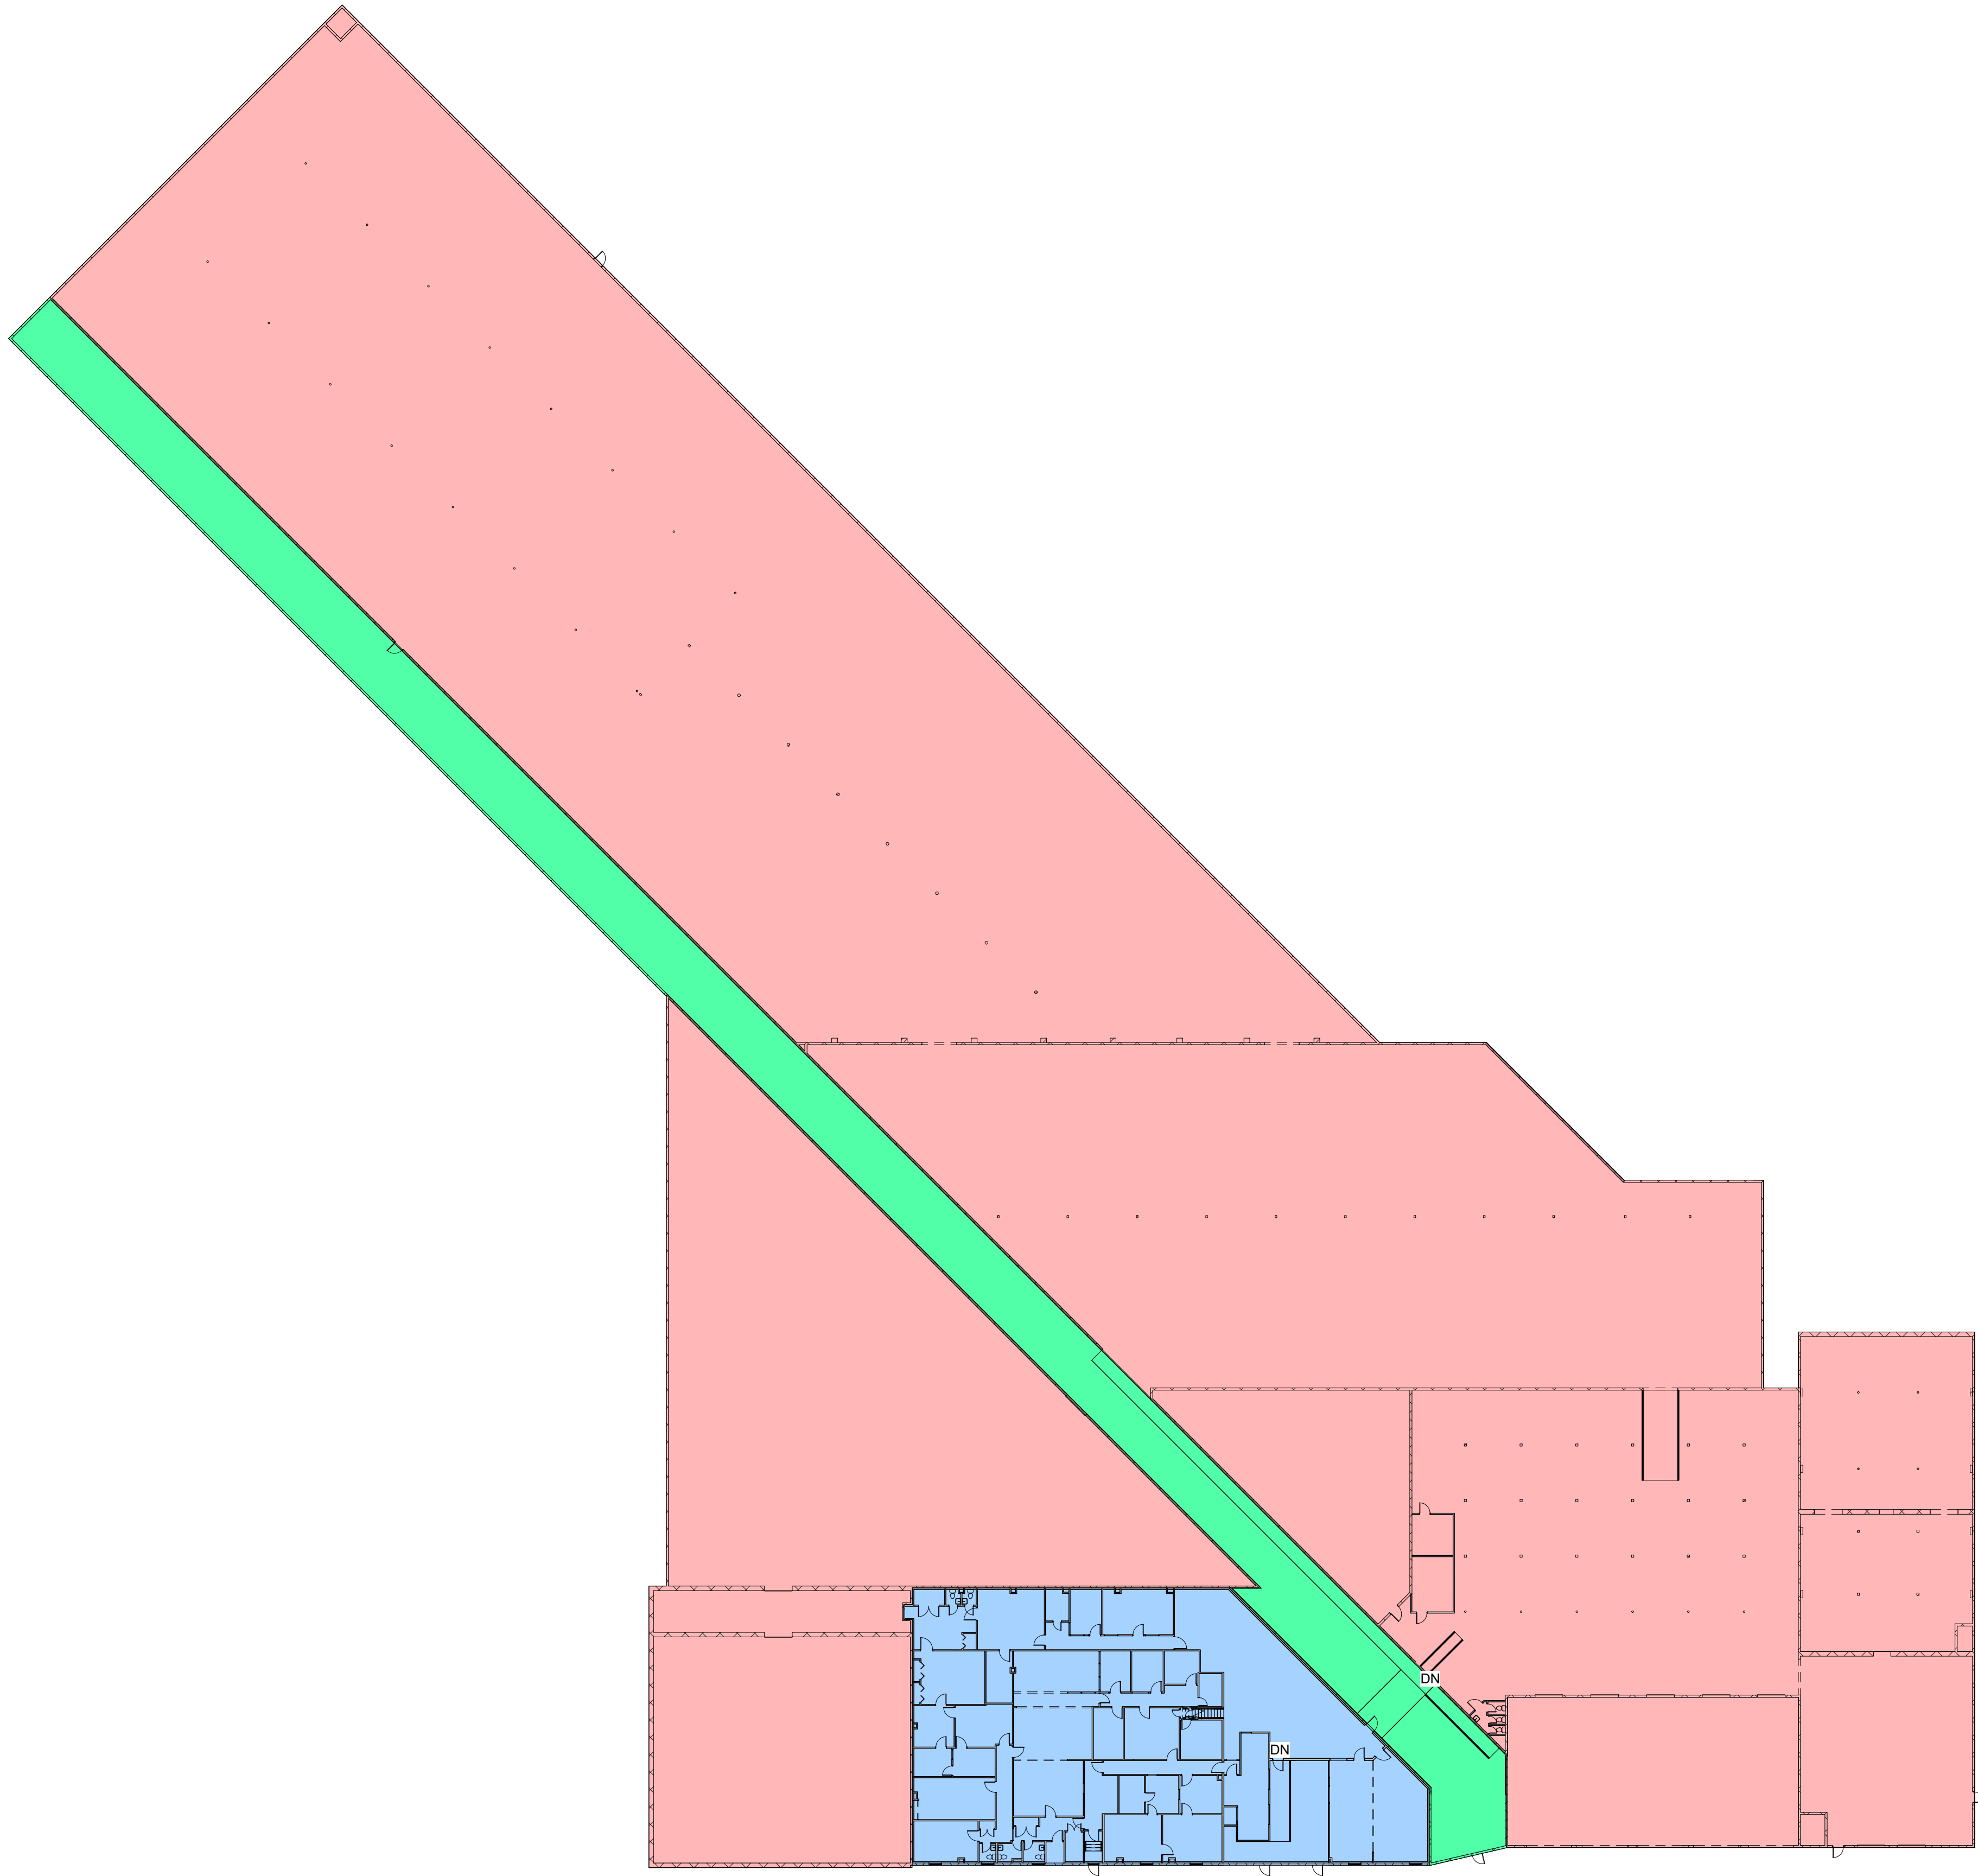

① AREA PLAN
1" = 30'-0"

326 S. MARBLE ST.		
	ROOM	SQ/FT
	WAREHOUSE	108,664
	OFFICE	10,256
	RAIL ROAD (NON FUNCTIONAL)	10,972
	TOTAL	129,892



BIM DUDE
AREYNOLDS@BIMDUDE.DESIGN

PROJECT:
S. MARBLE ST.
AS-BUILT


CONSULTANTS:

SEAL:

EXISTING
CONDITIONS

SCALE: As indicated		DATE: 11/14/25
DRAWN BY: AR		CHECKED BY:
NO.	REVISION:	DATE:

SHEET TITLE:
AREA PLANS

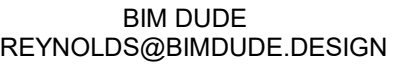


CONSULTANTS:


REAL:

SCALE: 1" = 30'-0"		DATE: 11/14/25	
DRAWN BY: AR		CHECKED BY: AR	
NO.	REVISION:		DATE:

PROJECT NO. 2541-1	SHEET NO. A1-01
-----------------------	--------------------

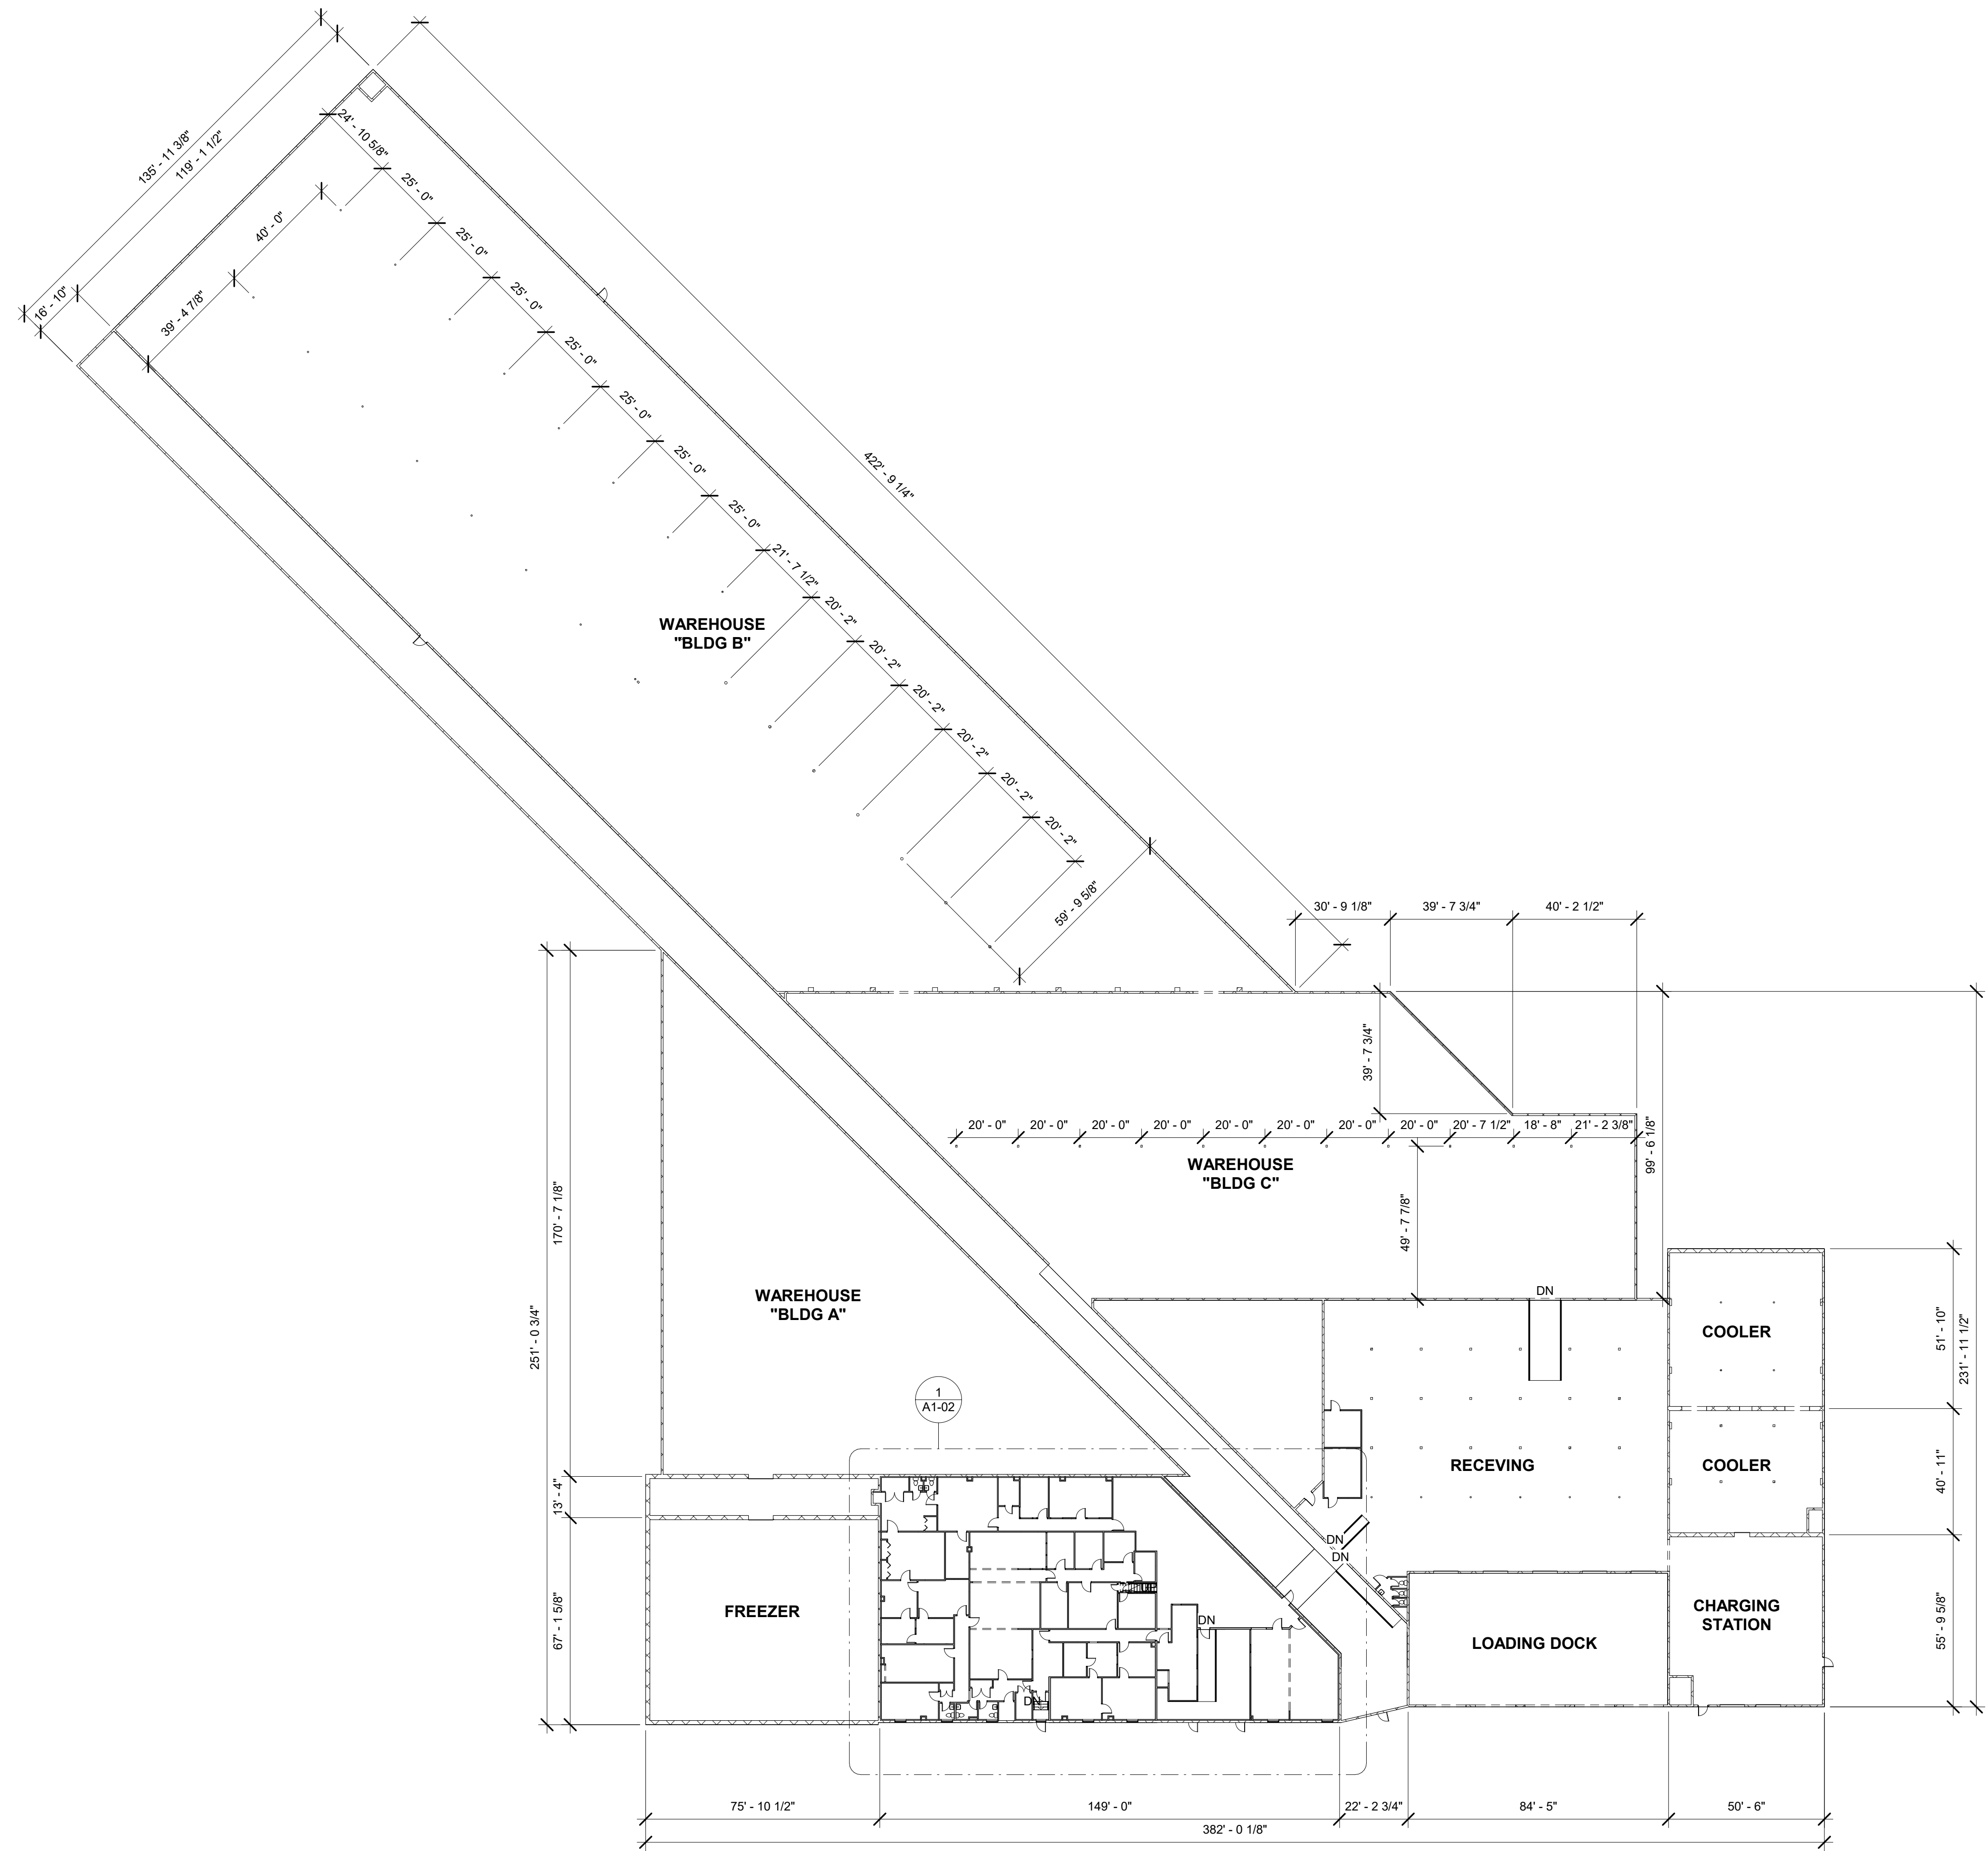

① OVERALL FLOOR PLAN
1" = 30'-0"

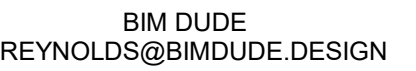

CONSULTANTS:

REAL:

SCALE: 1/8" = 1'-0"		DATE: 11/14/25	
DRAWN BY: AR		CHECKED BY: AR	
NO.	REVISION:		DATE:

PROJECT NO. 2541-1	SHEET NO. A1-02
------------------------------	---------------------------



BIM DUDE
AREYNOLDS@BIMDUDE.DESIGN

PROJECT:
S. MARBLE ST.
AS-BUILT

CONSULTANTS:


SEAL:

EXISTING
CONDITIONS

SCALE: 1/16" = 1'-0"		DATE: 11/14/25	
DRAWN BY: AR		CHECKED BY: AR	
NO.	REVISION:	DATE:	

SHEET TITLE:
ELEVATIONS

PROJECT NO. 2541-1	SHEET NO. A3-01
-----------------------	--------------------

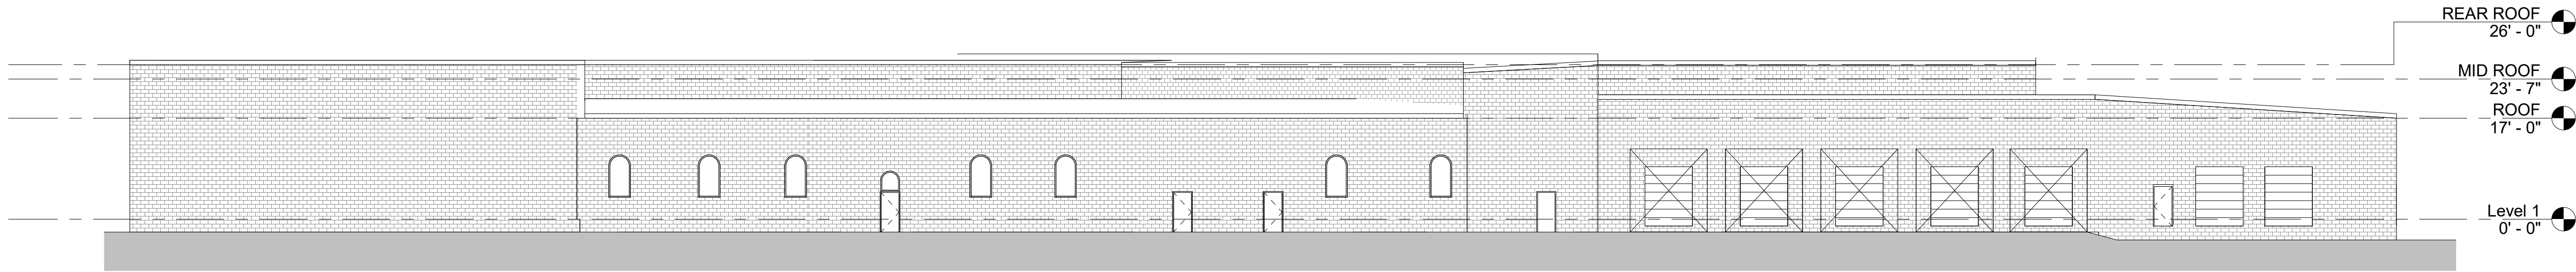

1 Elevation 1 - a
1/16" = 1'-0"