


PLANS DRAWN BY:

James Duhe
 LA ASBUILTS
 Ph. 310.502.5548
 Eml: la.asbuilts@mac.com
 WWW.LA-ASBUILTS.COM

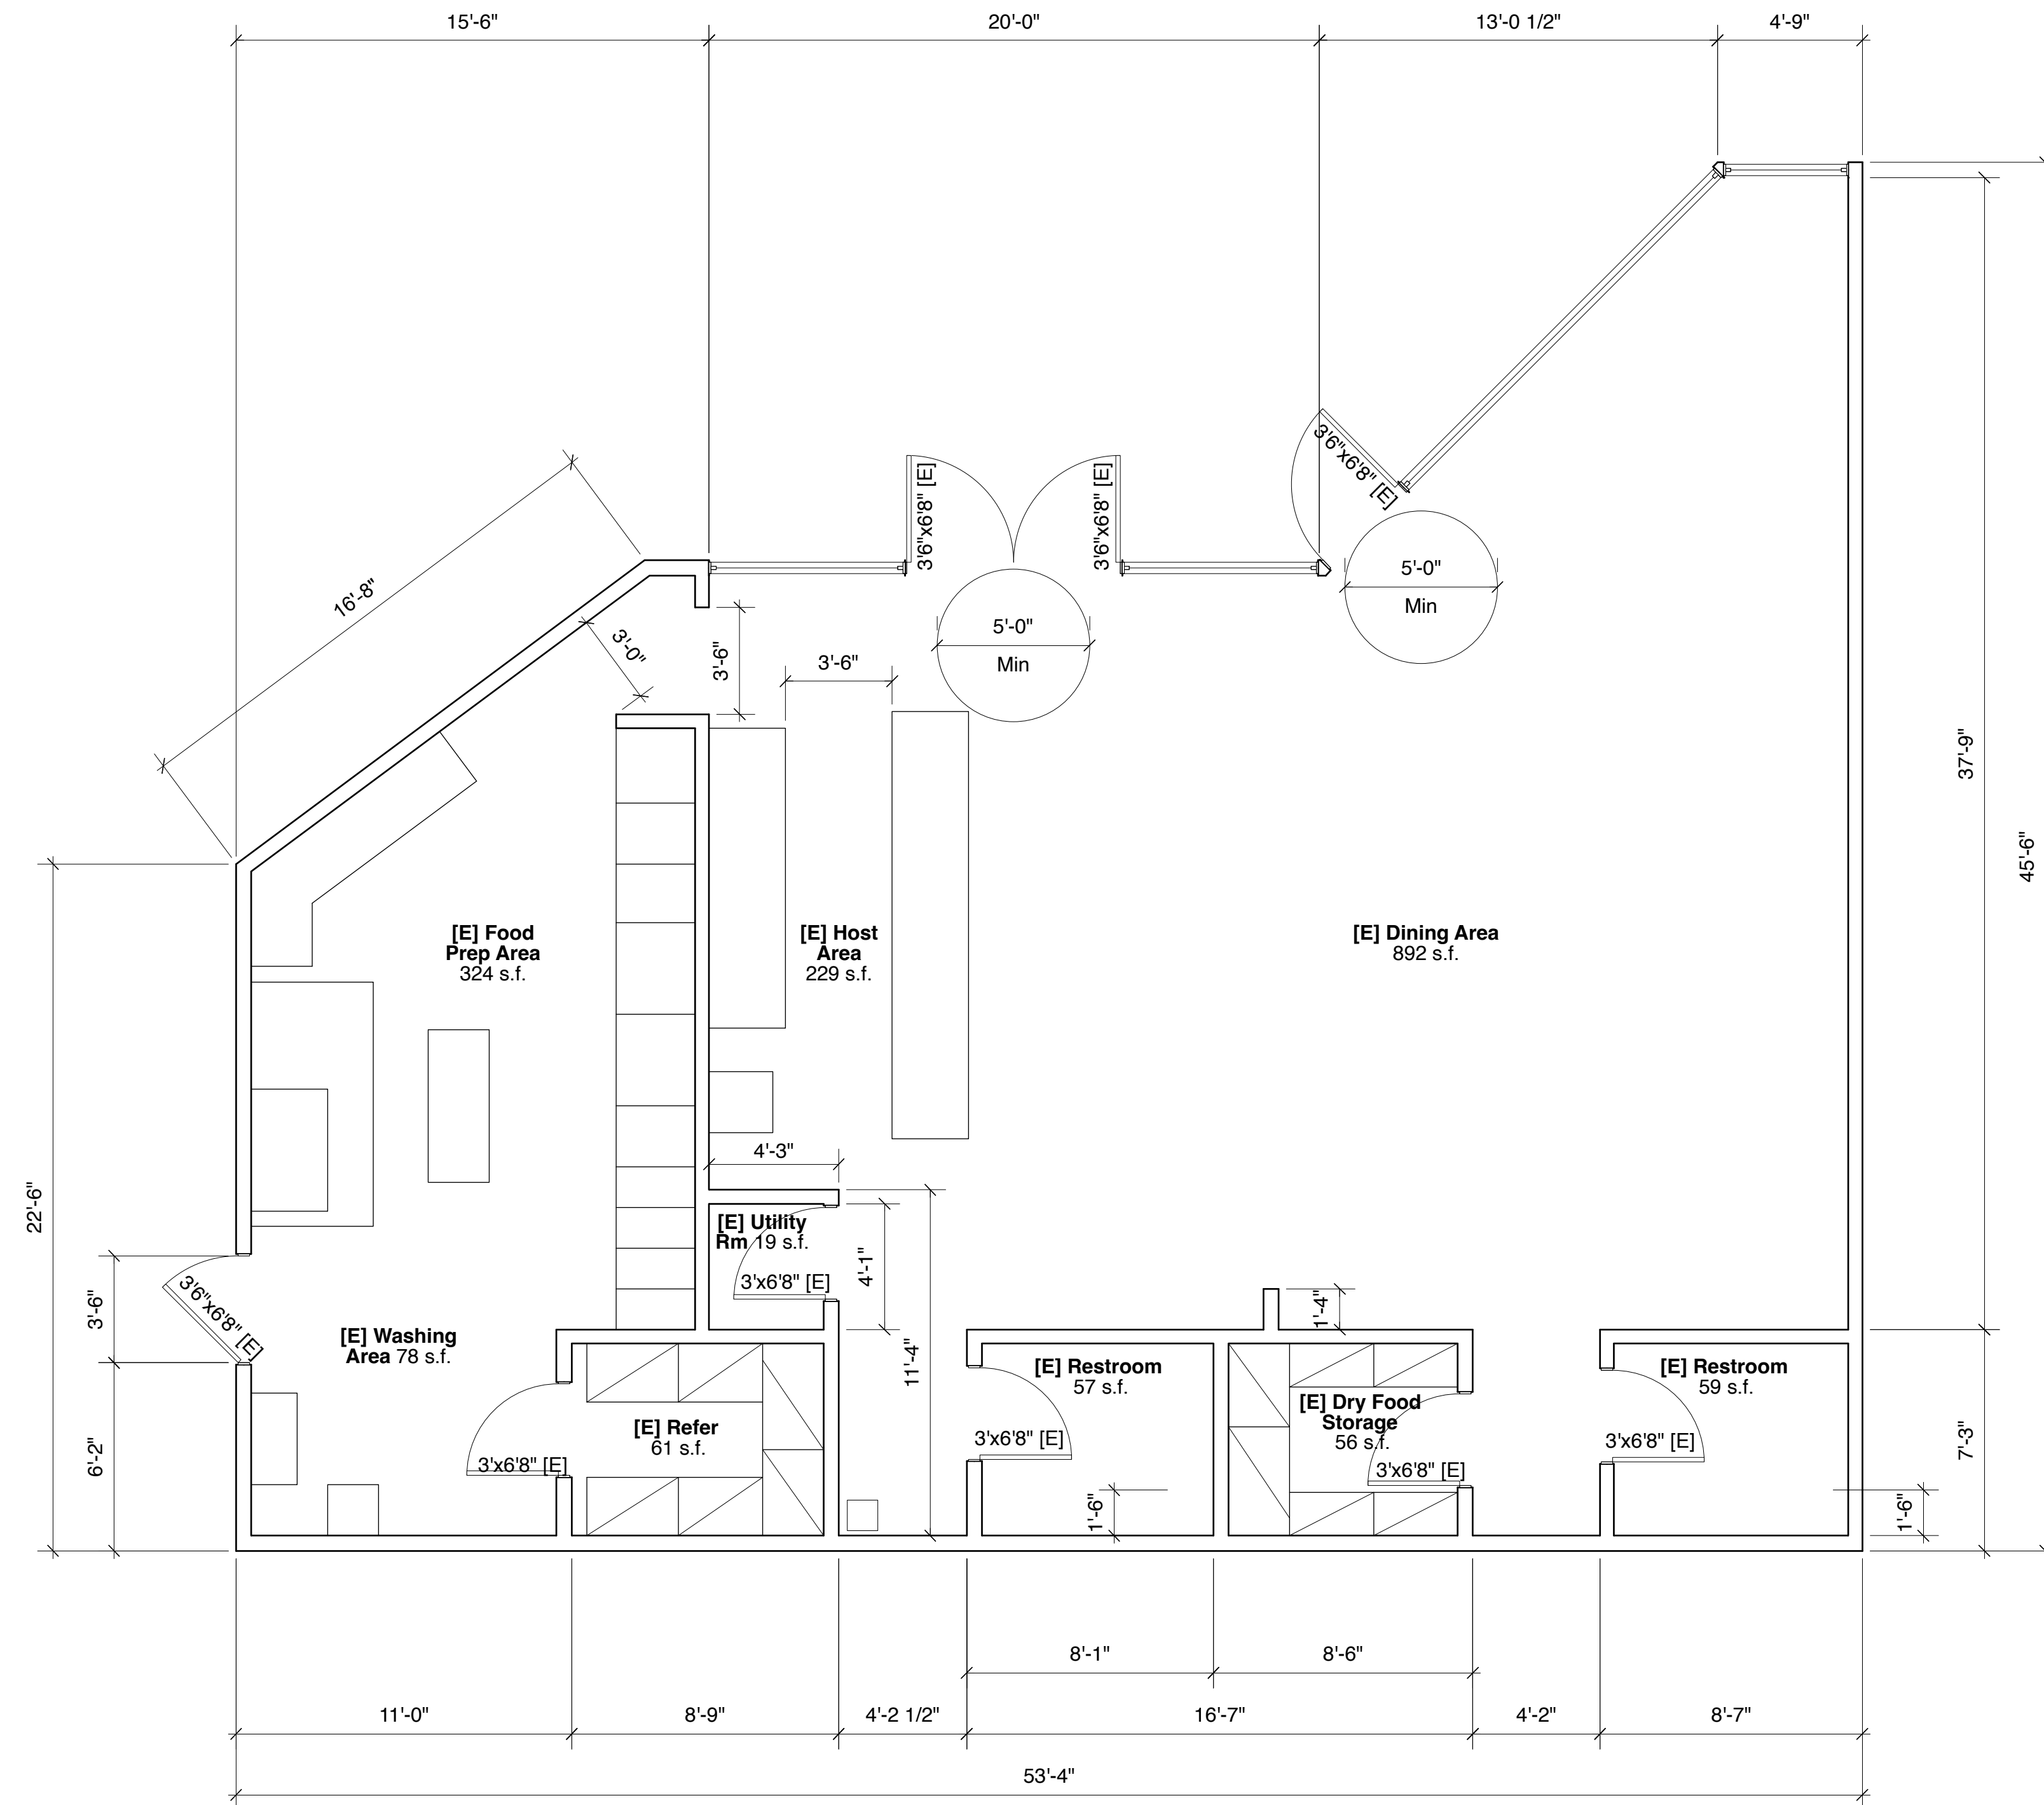

[E] Floor Plan
 1,810 s.f.
 Scale: 1/4" = 1'-0"

19006

Ventura Blvd.
 Tarzana,
 California 91356
 Scale: As Noted
 Date: 10.08.24

Sheet: