


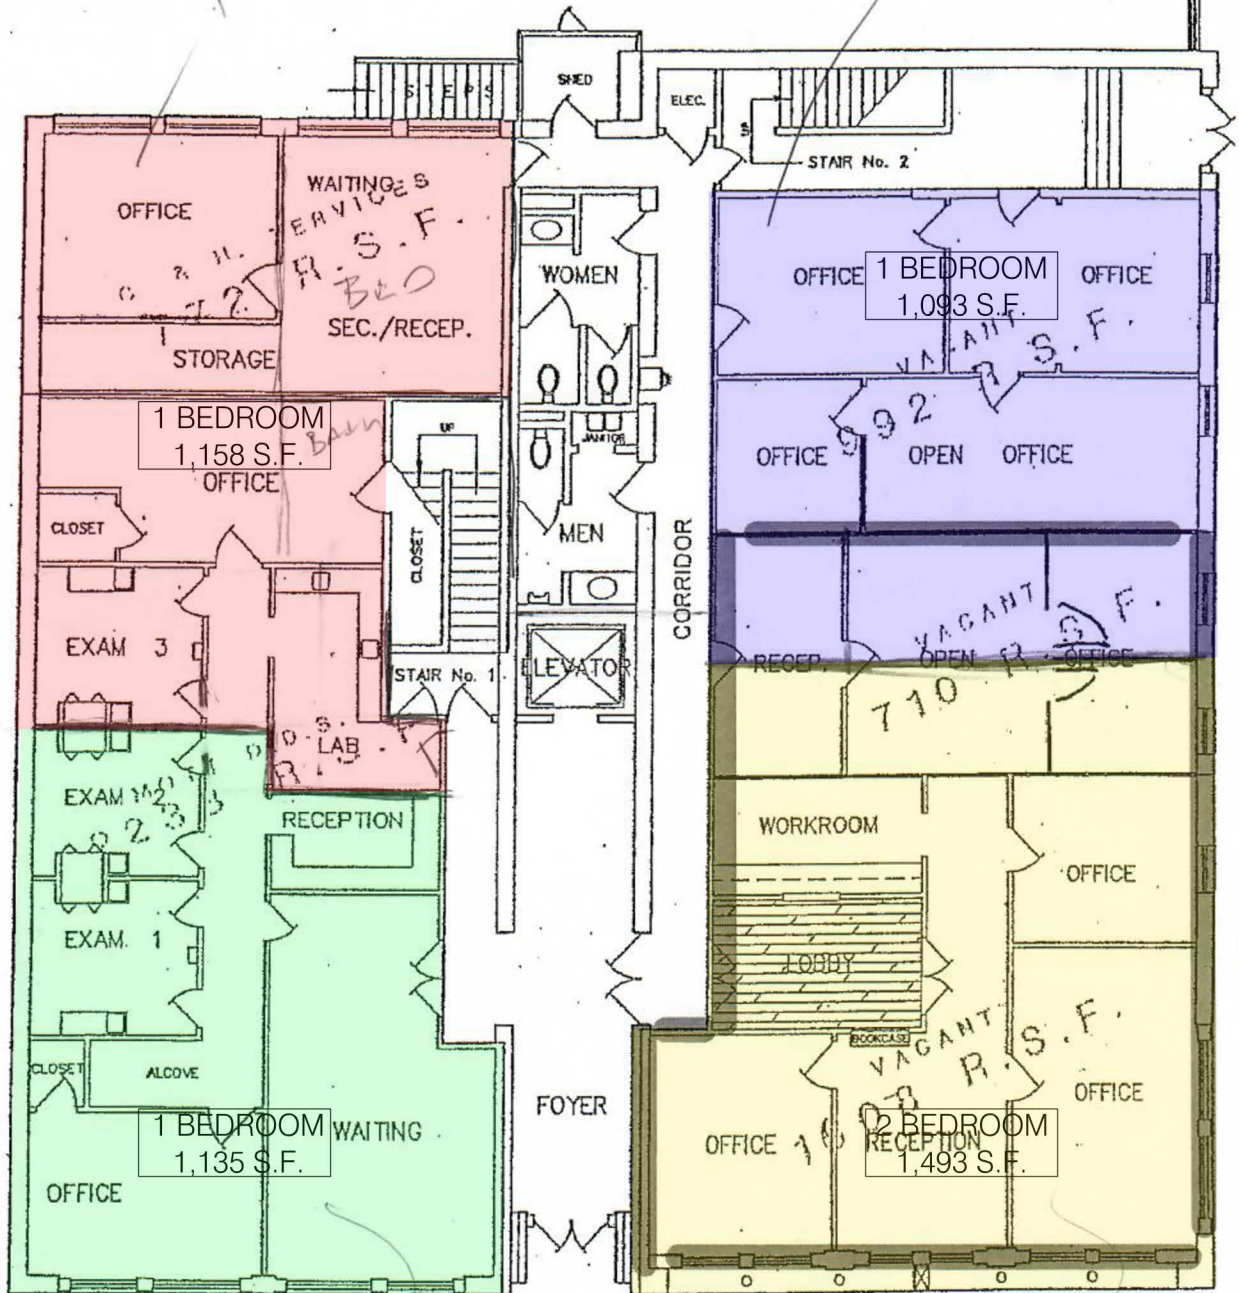

BLANCHARD BUILDING


SHEPHERD BUILDING

FIRST FLOOR RECORD DRAWING PLAN

SCALE: 1/8" = 1'-0"

631 Milam

2 BED

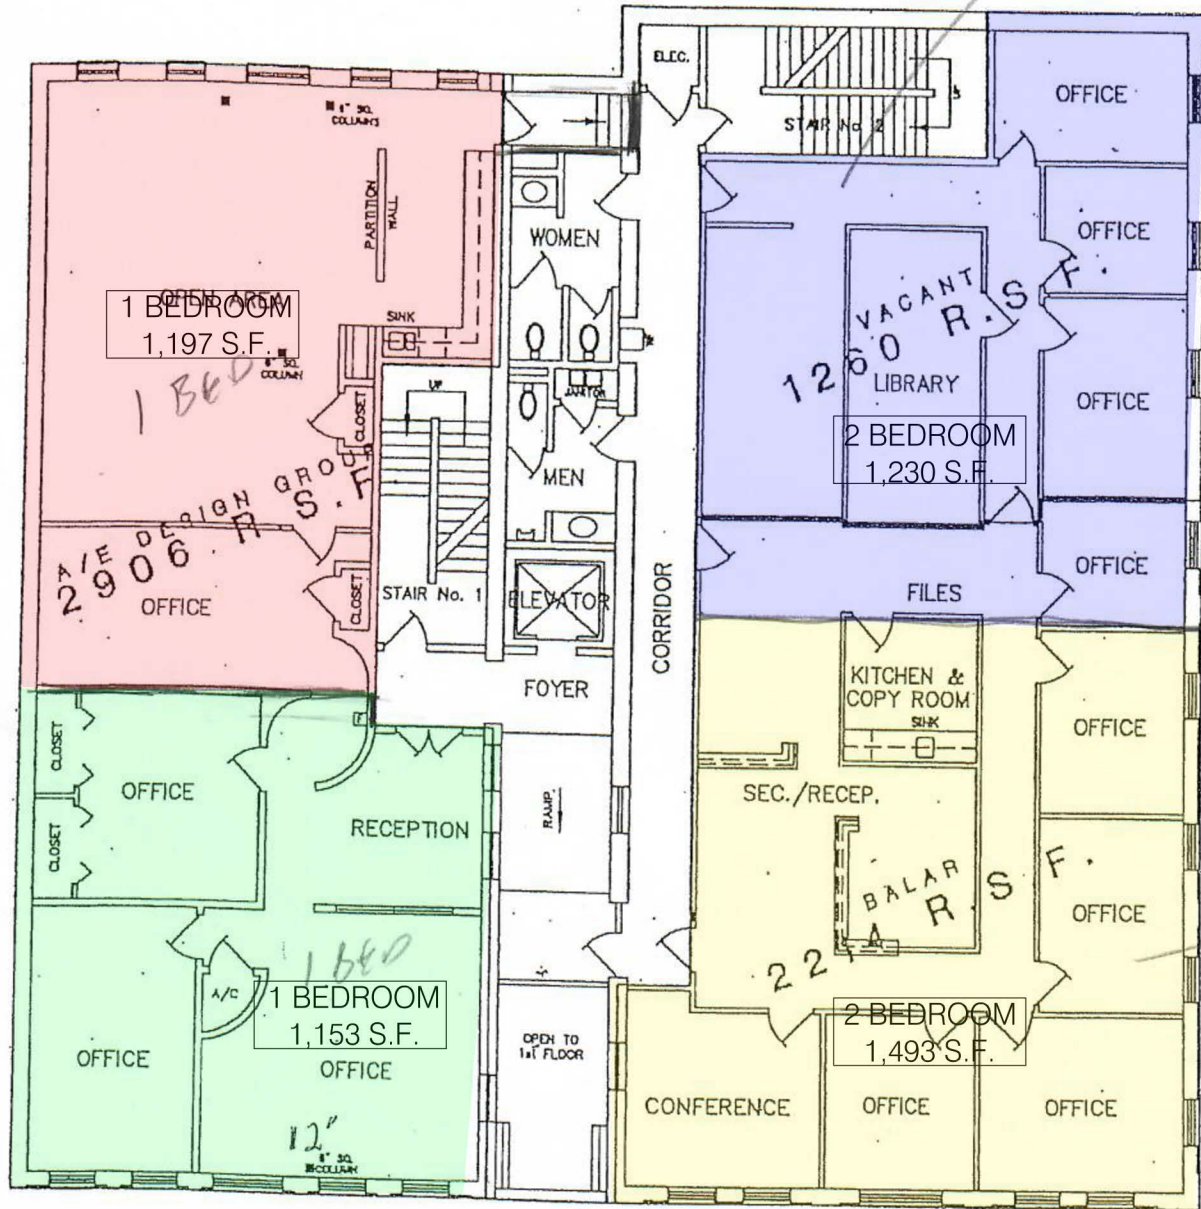

BLANCHARD BUILDING

SHEPHERD BUILDING

SECOND FLOOR RECORD DRAWING PLAN

SCALE: 1/8" = 1'-0"

