
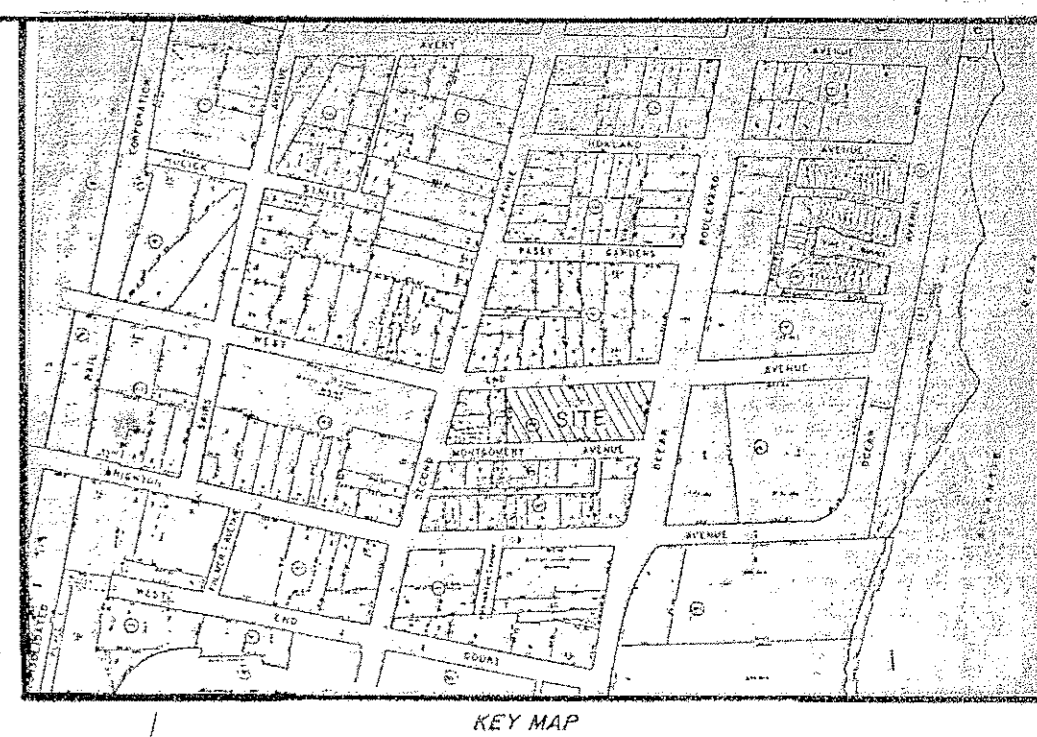



PROPERTY OWNERS
w/in 200'

BLK	LOT	OWNER	ADDRESS	APN
129	1	West End Building Co	525 Ocean Ave., Long Branch, NJ	07740
129	2	Ciddio, Stephen B	100 Ocean Ave., Long Branch, NJ	07740
129	3	Ciddio, Stephen B	100 Ocean Ave., Long Branch, NJ	07740
129	4	West End Building Co	525 Ocean Ave., Long Branch, NJ	07740
129	5	West End Building Co	525 Ocean Ave., Long Branch, NJ	07740
129	6	West End Building Co	525 Ocean Ave., Long Branch, NJ	07740
129	100	West End Building Co	525 Ocean Ave., Long Branch, NJ	07740

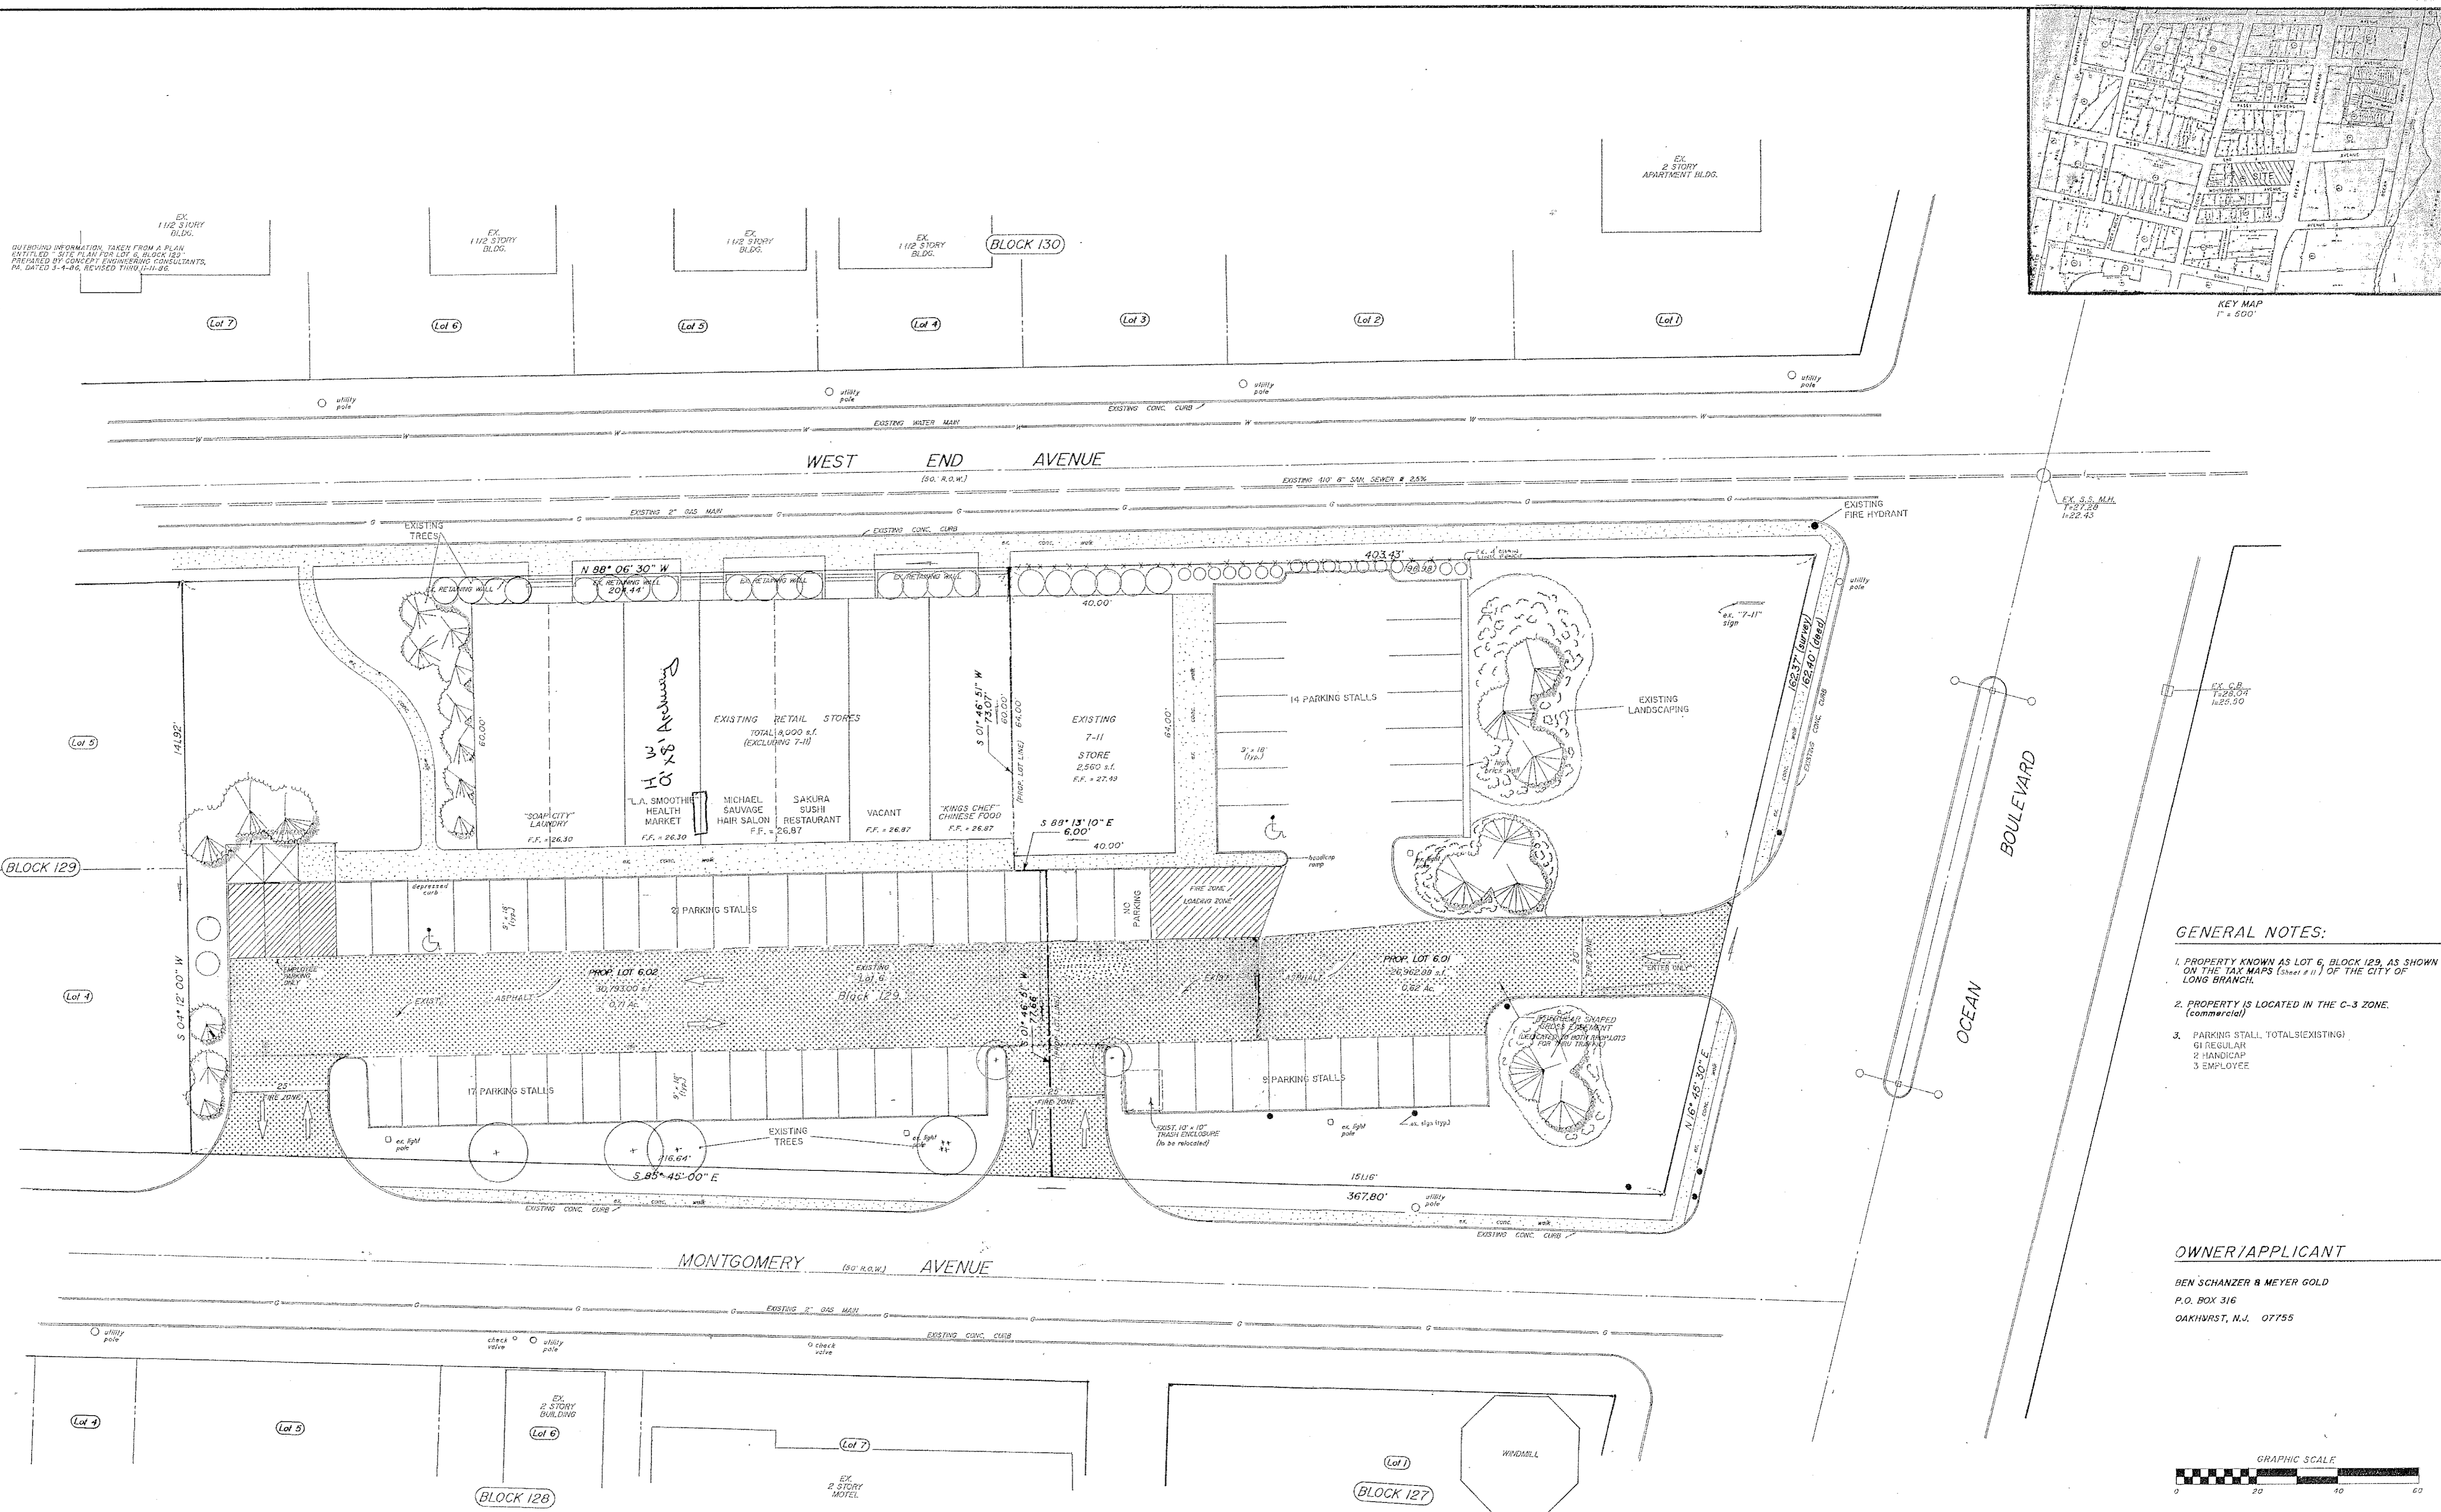

- GENERAL NOTES:**
- PROPERTY KNOWN AS LOT 6, BLOCK 129, AS SHOWN ON THE TAX MAPS (Sheet # 11) OF THE CITY OF LONG BRANCH.
 - PROPERTY IS LOCATED IN THE C-3 ZONE (commercial).
 - PARKING STALL TOTALS (EXISTING):
 - 61 REGULAR
 - 2 HANDICAP
 - 3 EMPLOYEE

OWNER/APPLICANT
 BEN SCHANZER & MEYER GOLD
 P.O. BOX 316
 OAKHURST, N.J. 07755

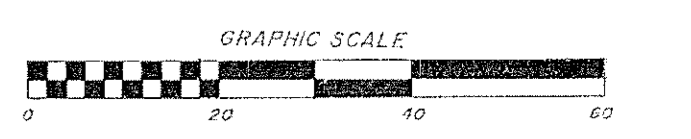


Please Note: Ocean Avenue is a State Road therefore, it may be necessary to contact the State of New Jersey, Trenton, New Jersey 08625.

Dennis A. Barty, CMA, CPA, IFA
 Tax Assessor

APPROVED BY THE PLANNING BOARD
 OF THE CITY OF LONG BRANCH


AS-BUILT PLAN FOR LOT 6 BLOCK 129 SITUATED IN City of Long Branch, Monmouth County, N.J.		DATE 6/6/97
APPROVED BY THE PLANNING BOARD OF THE CITY OF LONG BRANCH		SCALE 1"=20'
CONCEPT ENGINEERING CONSULTANTS, P.A. A PROFESSIONAL CORPORATION PROFESSIONAL ENGINEERS - LAND SURVEYORS 116 N. BROADWAY, SOUTH AMBOY, N.J. PHONE 201-727-6393, 201-790-4949		DRAWN BY JFM
JOHN J. PLOSKONKA, P.E. PROFESSIONAL ENGINEER N.J. LIC. NO. 15511		CHECKED BY TERENCE F. REILLY, L.S. LAND SURVEYOR N.J. LIC. NO. 11330
DATE 3/28/99	REVISION	FIELD BK
		PAGE
		SHEET
		JOB NO.
		30267

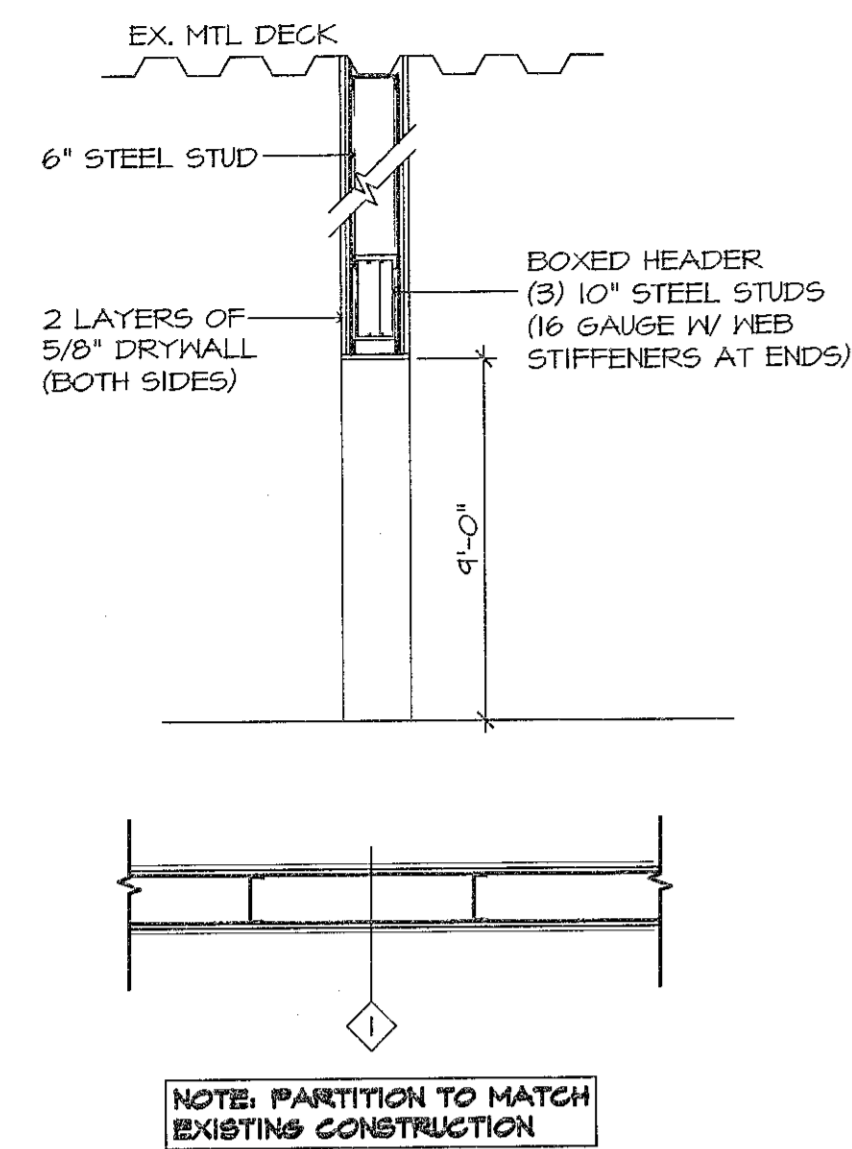

2 | WALL DETAIL

1/2" = 1'-0"

PARKING AREA

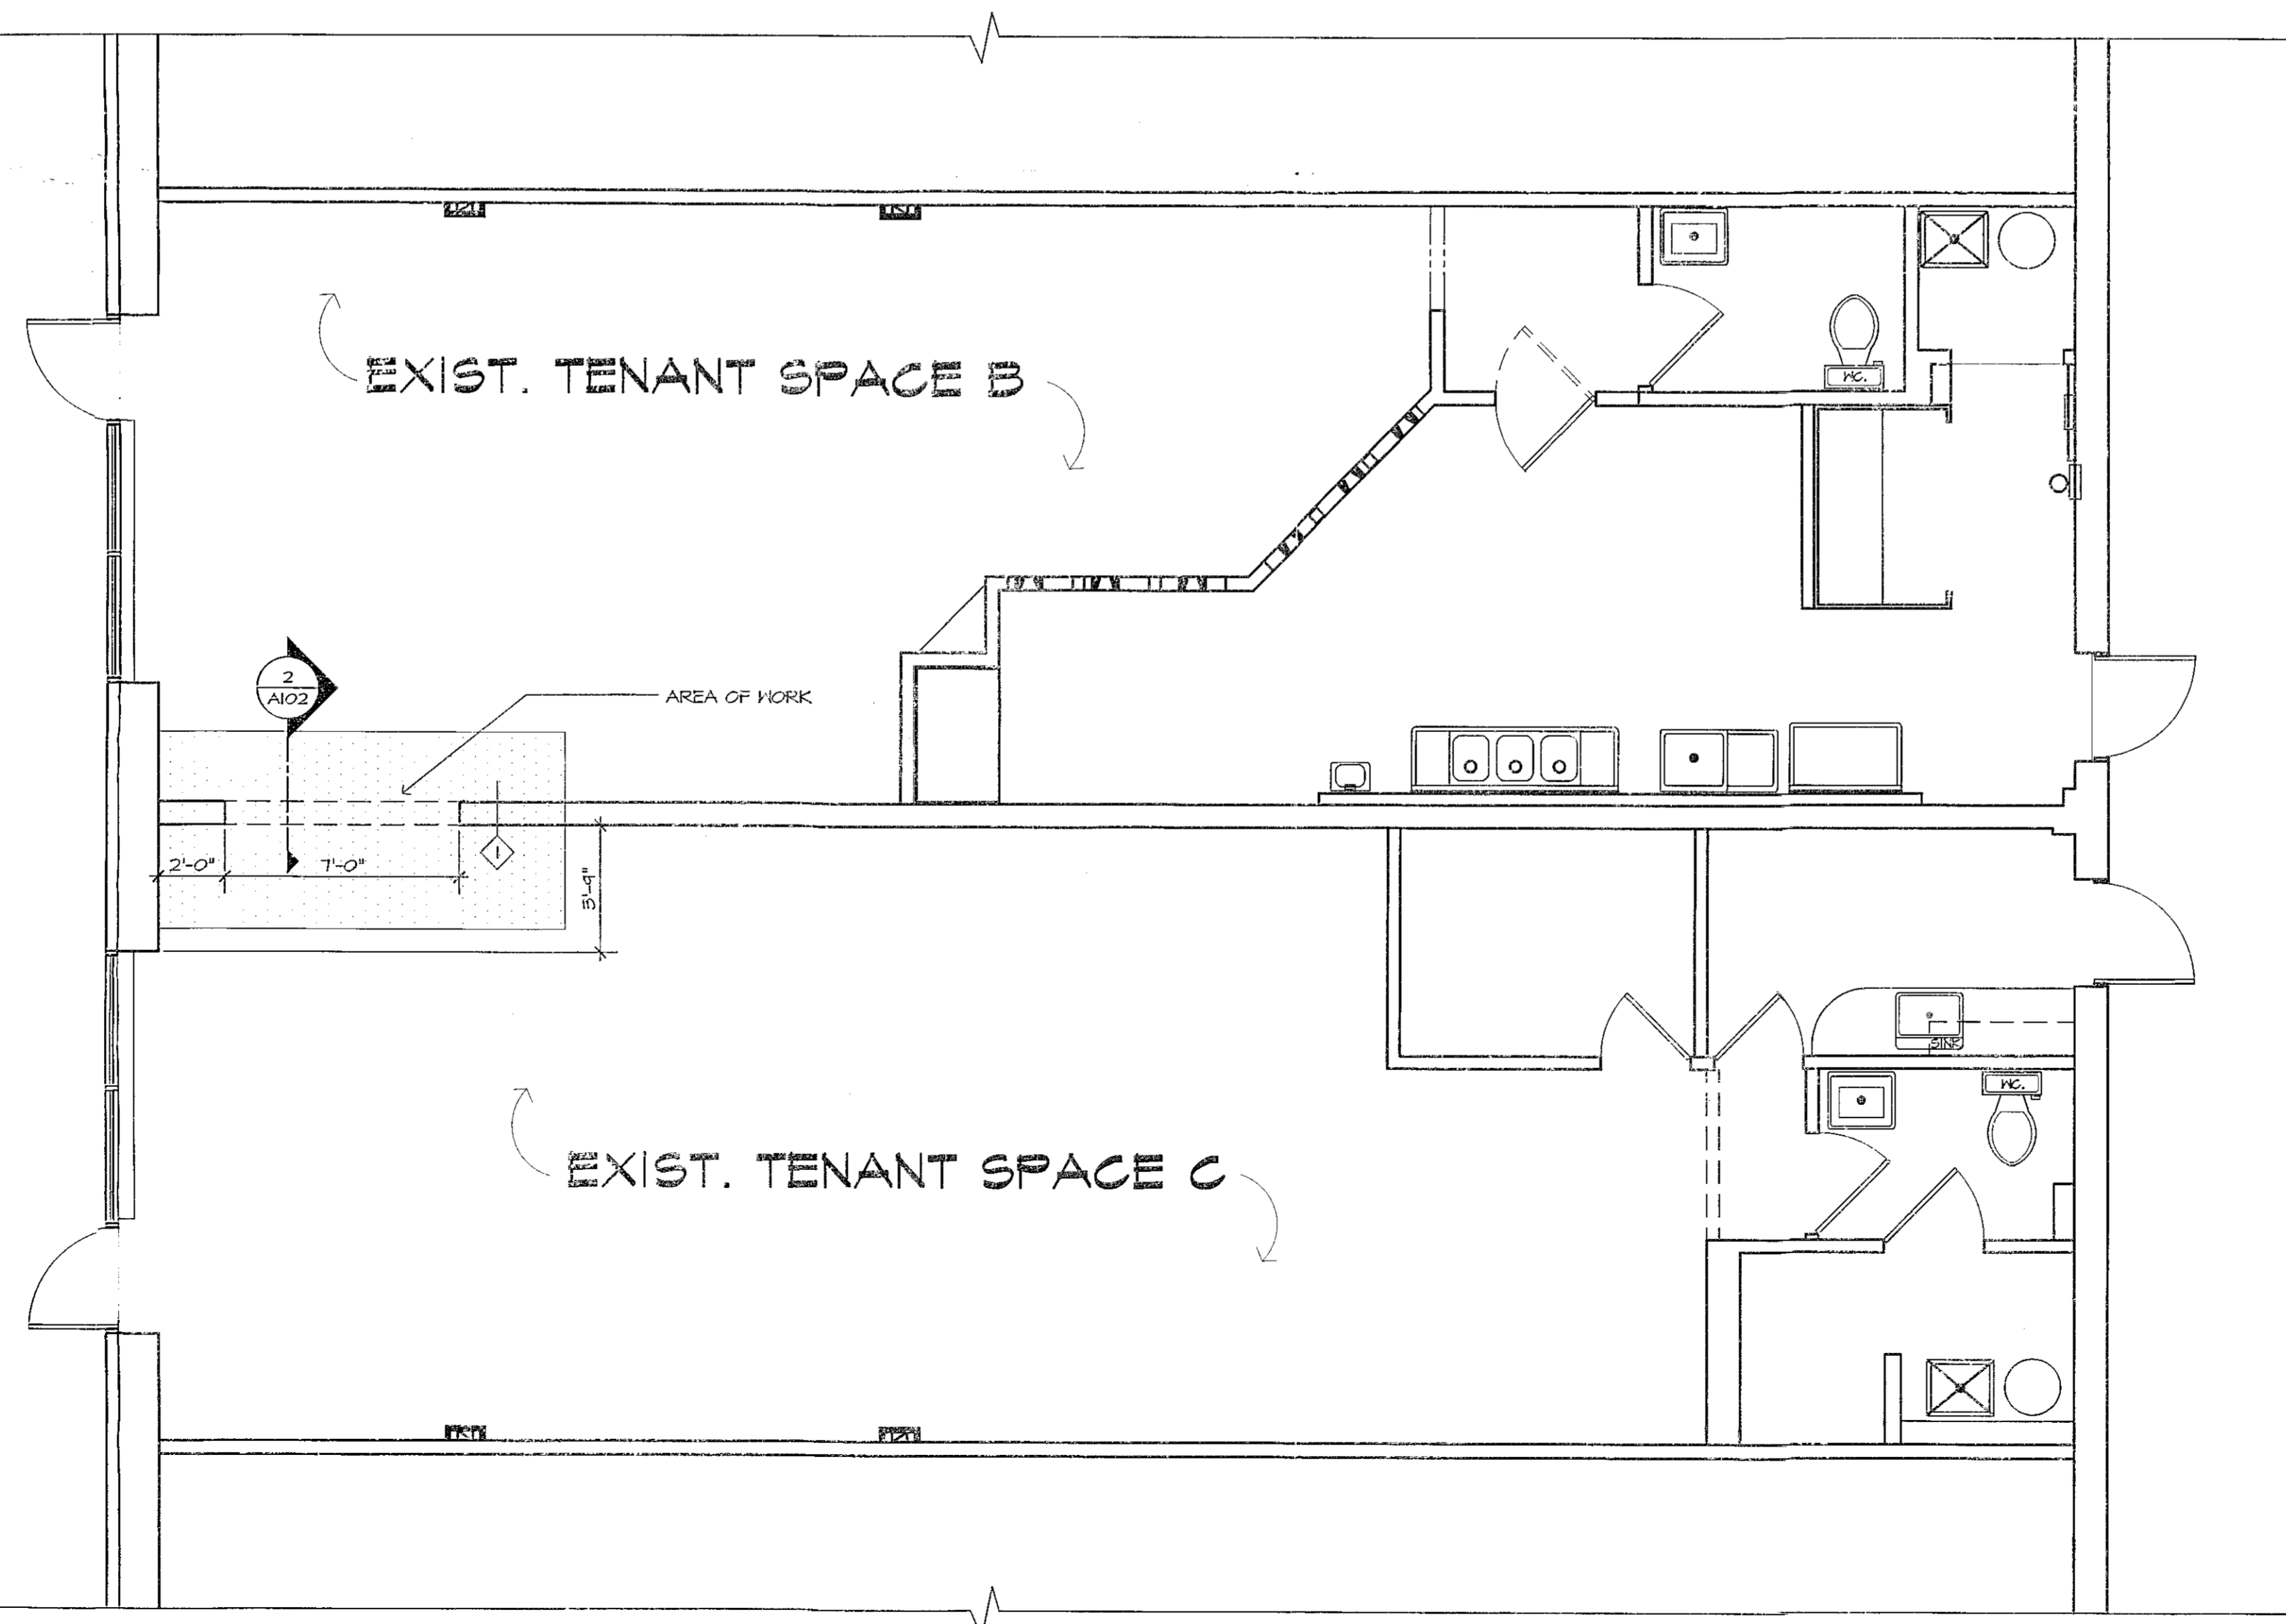

1 | FLOOR PLAN

1/4" = 1'-0"

USE OF THIS DESIGN IS PROHIBITED WITHOUT WRITTEN CONSENT. DRAWINGS ARE NOT FOR PROTOTYPICAL USE. MONTEFORTE ARCHITECTURAL STUDIO, LLC. © 2016

MONTEFORTE
ARCHITECTURAL STUDIO, LLC

JAMES J. MONTEFORTE, AIA
783 HIGHWAY 35, SUITE C OCEAN, NJ 07712 (732) 988-1900

- NJ LIC. NO. 12132
- NY LIC. NO. 026417
- PA LIC. NO. RA017093
- FLA. LIC. NO. 0016221
- N.C.A.R.B. LIC. NO. 43377
- CT LIC. NO. AR11059
- MA LIC. NO. 30598

ALTERATIONS FOR:
BLOWN AWAY
37 MONTGOMERY AVENUE
BLOCK 129
NEW JERSEY
LOT 6
LONG BRANCH

REVISIONS:	
AS NOTED	
DATE:	6-14-12
DRAWN BY:	SC
CHECKED BY:	
JOB NO.	122.16
DATE:	3.7.16

A102
2 OF 2
DWG. NO.