





**VARADY
 ASSOCIATES
 INC.**
 INTERIOR DESIGN

30400 TELEGRAPH · SUITE 120
 BINGHAM FARMS, · MI · 48025
 248 · 644 · 3990 FAX: 248 · 644 · 3952

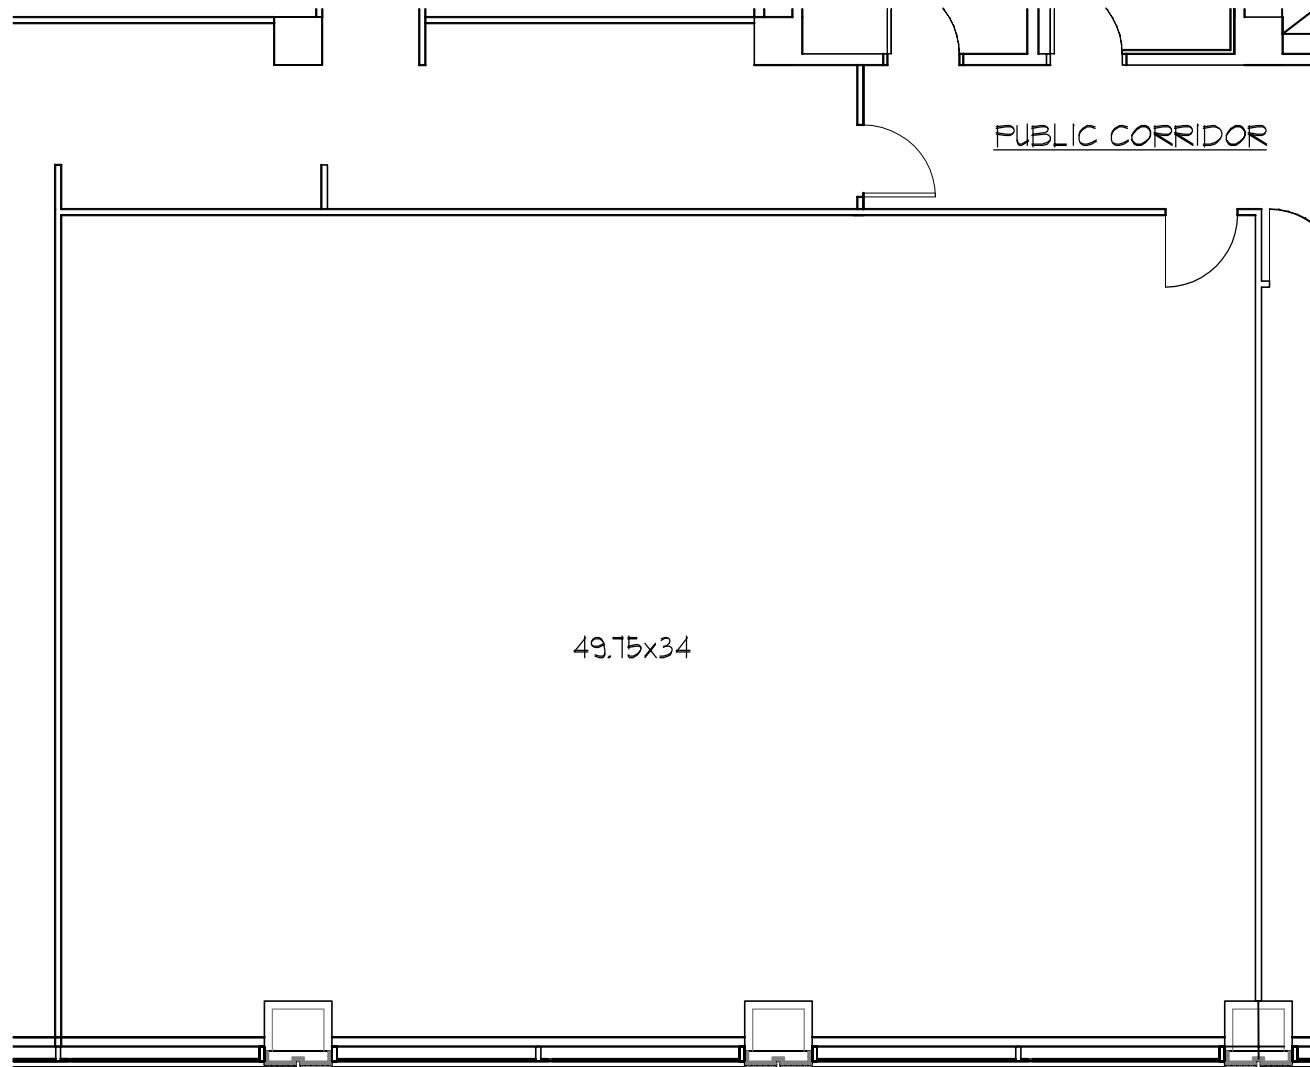

AS-BUILT PLAN
OAKLAND COMMONS II - SUITE 340
20750 CIVIC CENTER DRIVE
SOUTHFIELD, MICHIGAN 48076

DATE: 6-12-12

SCALE: 1/8" = 1'-0"

2,010 RENTABLE SQ. FT.

 **Farbman
 Group**
 FULL SERVICE REAL ESTATE SOLUTIONS

 **Farbman**
 COMMERCIAL REAL ESTATE SERVICES, WORLDWIDE

CONTACT: LESLEY GUTMAN
 (248) 351-4383 LGUTMAN@FARBMAN.COM