


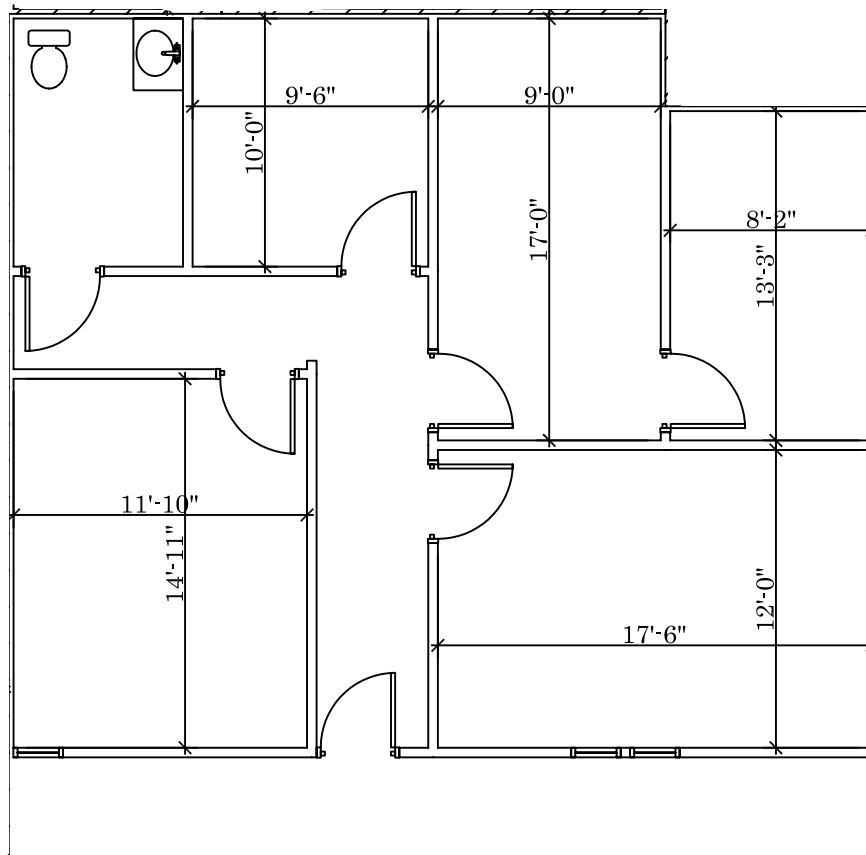

1 SUITE 203
I-P-1 SCALE : 1/8" = 1'-0"

NOTE:
THIS PLAN WAS DRAWN W/O THE BENEFIT OF AN ON SITE FIELD VERIFICATION. PRIOR TO CONSTRUCTION, FACILITEC, INC. RECOMMENDS THAT A VERIFICATION IS COMPLETED. IT WILL BE THE RESPONSIBILITY OF THE G.C. TO NOTIFY FACILITEC, INC OF ANY PROBLEMS. FACILITEC, INC. SHALL NOT BE HELD RESPONSIBLE FOR FOR ANY CODE INFRACTIONS DUE TO THIS MATTER.

ANY FURNITURE OR EQUIPMENT SHOWN IS NIC AND ONLY SHOWN FOR PLANNING PURPOSES.

PLEASE INDICATE THAT YOU HAVE REVIEWED THIS DOCUMENT CAREFULLY AND FIND THESE SPECIFICATIONS AND INTENTIONS AS APPROVED FOR CONSTRUCTION BY SIGNING YOUR NAME AND DATING BELOW.

SIGNED BY:

DATE:

PRELIMINARY PLAN
SHEET No:
P-1
SHEET No:

REV	DATE:	DISCRIPTION:
	09.08.11	AS-BUILT

DRAWN BY:
MS
JOB #:
11123
RSF:
1,304

SUITE 203
SPRAYBERRY OFFICE PARK
2790 SANDY PLAINS ROAD
MARIETTA, GA 30066



SUITE 501
260 PEACHTREE STREET
ATLANTA, GA 30303
(404) 816-6464

THE DRAWING IS THE
PROPERTY OF THE
DESIGNER AND MAY NOT
BE REPRODUCED OR
USED WITHOUT THE
WRITTEN PERMISSION
© COPYRIGHT
FACILITEC, INC.