

Structural Engineer:
Name
Street
City, State, Zip
Phone, Fax

M/E/P Engineer:
Name
Street
City, State, Zip
Phone, Fax

Landscape Architect:
Name
Street
City, State, Zip
Phone, Fax

Civil Engineer:
Name
Street
City, State, Zip
Phone, Fax


Seal: Unauthorized alteration or addition to this document is a violation of Section 7209 of the New York State Education Law.

These documents (or copies of any thereof) prepared by or bearing the seal of the Architect / Engineer, shall not be reused for any extensions of the project or any other project without the written consent of the Architect / Engineer.

[illegible]

Drawing Title: FIRST-FLOOR-P

A-2

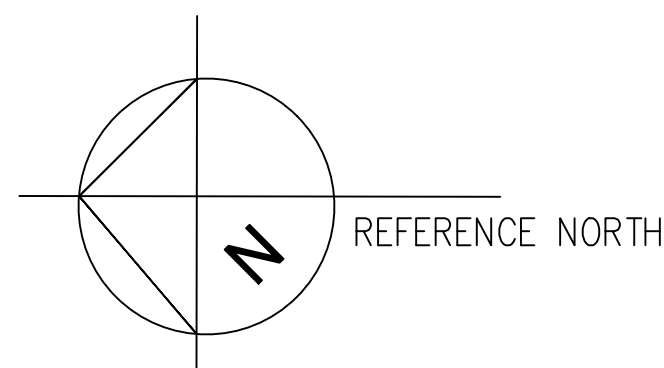

EXISTING CONDITION PLAN
AS-BUILTS 2/2/2019

Structural Engineer:

Name

Street _____
City, State, Zip _____

City, State, ZIP
Phone, Fax

M/E/P Engineer:

Name

Street _____
City State Zip _____

Phone, Fax

Landscape Architect:

Name

City State Zip

Phone, Fax

Civil Engineer:

Name

City State Zip

Phone, Fax

Seal:

Unauthorized alteration or addition to this document is a violation of Section 7209 of the New York State Education Law.

These documents (or copies of any thereof) prepared by or bearing the seal of the Architect / Engineer, shall not be reused for any extensions of the project or any other project without the written consent of the Architect / Engineer.

Project:

Proposed

Castaway Bar & Grill

906 West Beech Street
Long Beach, N.Y.

Addenda / Revisions:

[illegible]

Date: February 2, 2019

Scale: AS-NOTED

Drawn By: TLV


Checked By: TLV

Drawing Title:

SECOND-FLOOR-PLAN


Drawing Number:

A-3

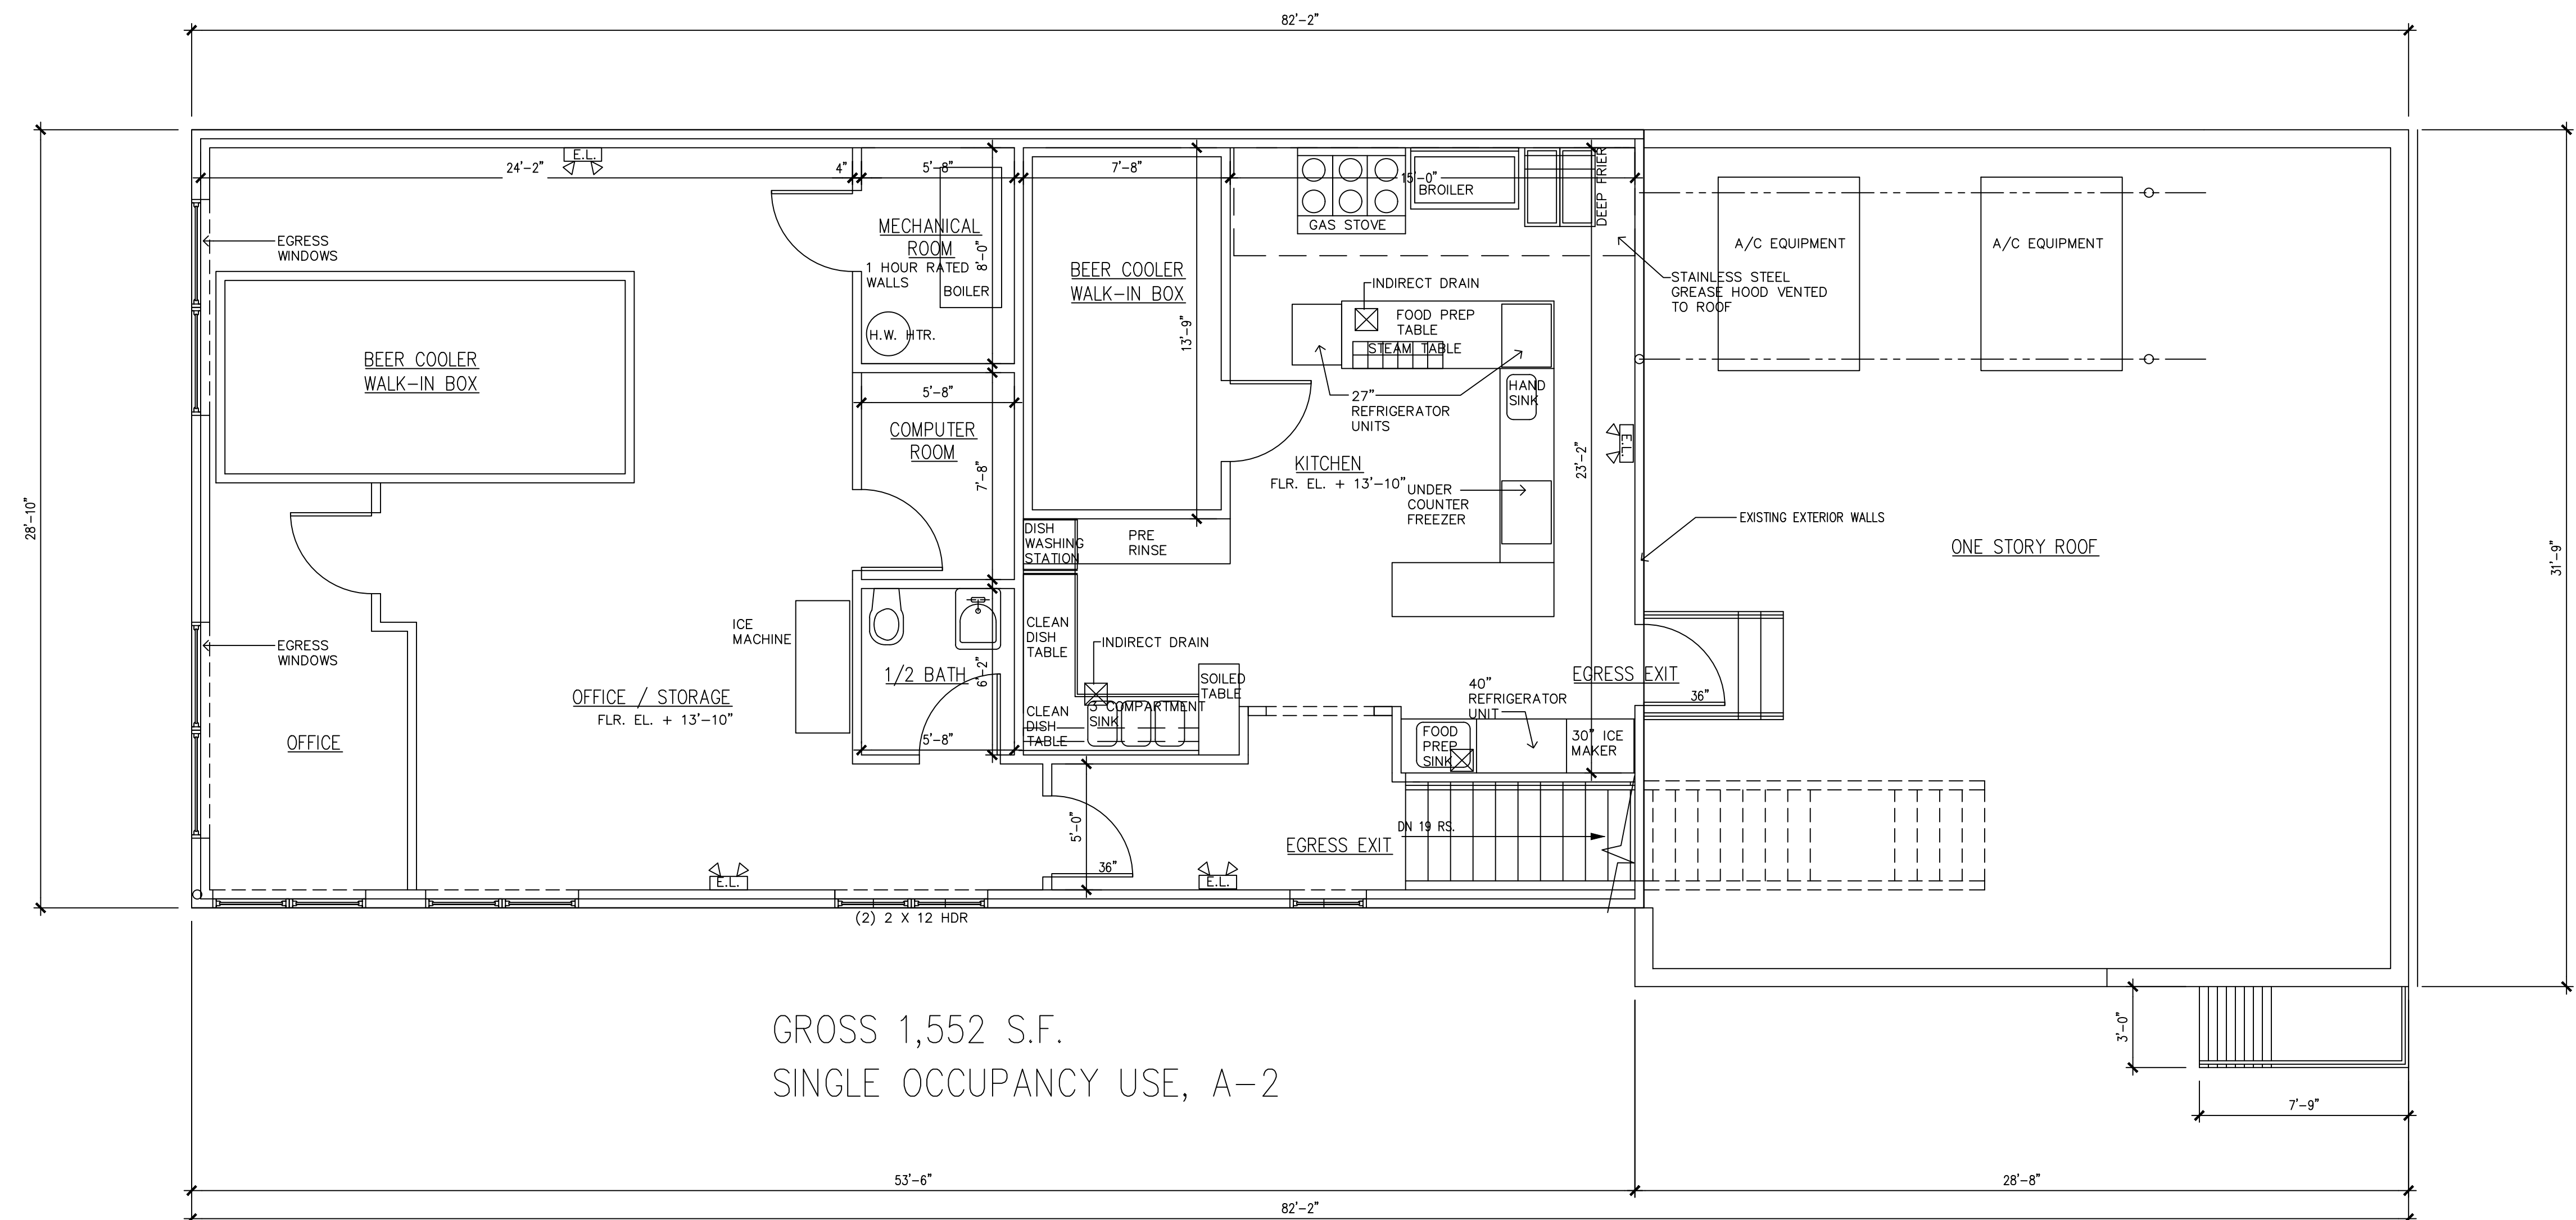

1 SECOND FLOOR PLAN

SCALE: 1/4" = 1'-0"
BUILDING FULLY SPRINKLERED.

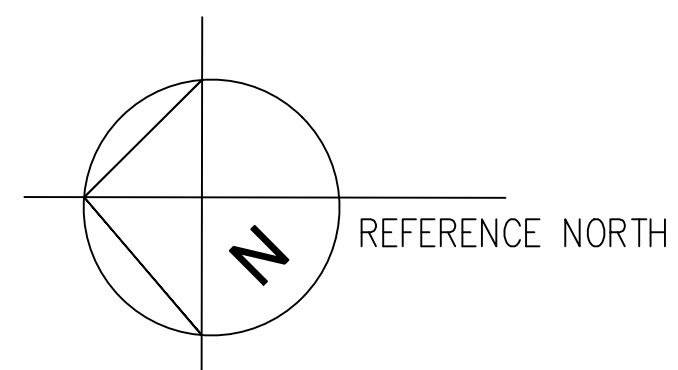

EXISTING CONDITION PLAN
AS-BUILTS 2/2/2019