


AREA TABULATION

UNIT 100 LEASABLE SPACE =

1790 S.F.

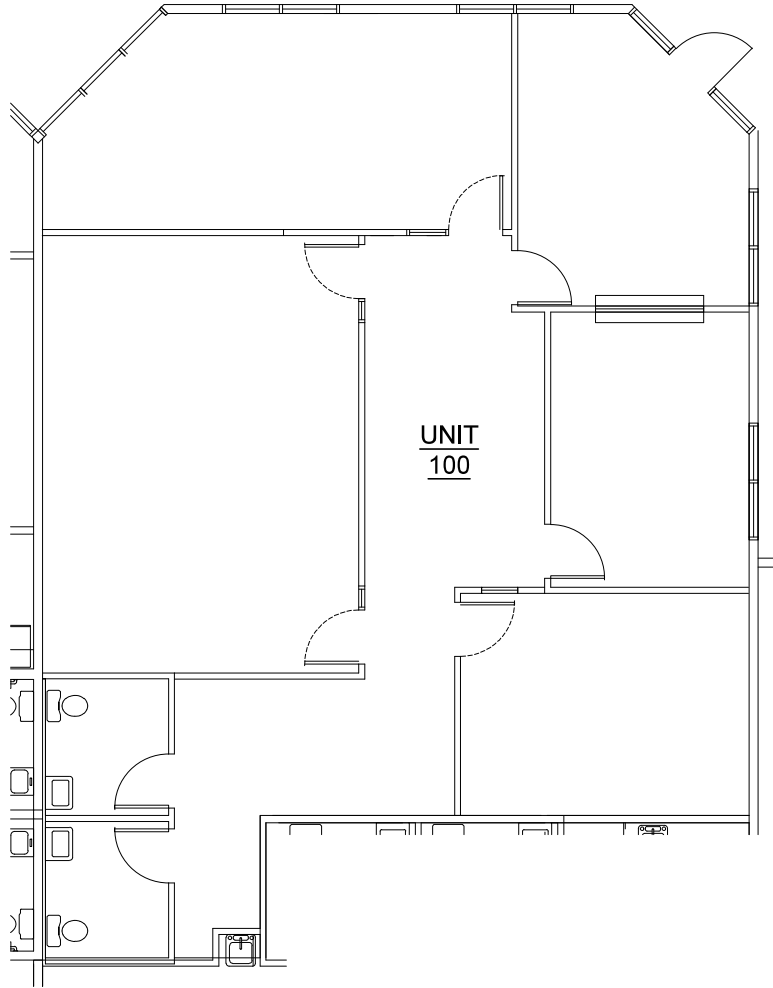

1
UNIT 100 AS-BUILT PLAN

A1.00
SCALE: 3/32" = 1'-0"

REVISIONS	#	DATE	DESCRIPTION	DRAFTER INFORMATION	PROPERTY OWNER: RENO JONES, LLC	PROJECT INFORMATION	PROJECT NAME: RENO JONES OFFICE SUITES	DRAWING INFORMATION	PLOT DATE: 09-17-2024
					COMPANY ADDRESS: 5052 SOUTH JONES BOULEVARD LAS VEGAS, NEVADA 89118		PROJECT ADDRESS: 5052 SOUTH JONES BOULEVARD LAS VEGAS, NEVADA 89118		PHASE: AS-BUILT SUBMITTAL
					COMPANY CONTACT: LOUIS CARNESALE 702-466-0444		PROJECT NUMBER: 002-01-24-002		SHEET NAME: AS-BUILT FLOOR PLAN
									SHEET NO. A1.00