


GENERAL NOTES

1. THE SUBJECT PROPERTY IS ZONED R-20 PER THE 2/02/04 COMPREHENSIVE ZONING PLAN AND PER COM. LITE ZONING AMENDMENTS EFFECTIVE 7/28/05.
2. ALL CONSTRUCTION SHALL BE IN ACCORDANCE WITH THE LATEST STANDARDS AND SPECIFICATIONS OF HOWARD COUNTY, PLUS ASIA STANDARDS AND SPECIFICATIONS, IF APPLICABLE.
3. THE CONTRACTOR SHALL NOTIFY THE DEPARTMENT OF PUBLIC WORKS, BUREAU OF ENGINEERING, CONSTRUCTION INSPECTION DIVISION AT 410-313-1880 AT LEAST FIVE (5) WORKING DAYS PRIOR TO THE START OF WORK.
4. THE CONTRACTOR SHALL NOTIFY "M&S UTILITY" AT 1-800-257-7777 AT LEAST 48 HOURS PRIOR TO ANY EXCAVATION WORK.
5. ALL ASPECTS OF THIS PROJECT SHALL BE IN CONFORMANCE WITH THE LATEST HOWARD COUNTY STANDARDS UNLESS WAIVED(S) HAVE BEEN APPROVED.
6. THE BOUNDARY SURVEY IS BASED ON A MONUMENTED FIELD-SURVEY PERFORMED BY BENCHMARK ENGINEERING, INC., DATED MARCH, 2003.
7. THE COORDINATES SHOWN HEREON ARE BASED UPON THE HOWARD COUNTY GEODETIC CONTROL, MONUMENTS 248 & 243, WHICH ARE BASED ON THE MARYLAND STATE PLANE COORDINATE SYSTEM.
8. EXISTING TOPOGRAPHY SHOWN HEREON WAS FIELD RUN BY BENCHMARK ENGINEERING, INC., DATED MARCH 2003 AND SUPPLEMENTED IN NOVEMBER 2006. CONTOUR INTERVAL IS 2 FEET. ADDITIONAL OFFSITE TOPOGRAPHY WAS PURCHASED FROM HOWARD COUNTY GEOGRAPHICAL INFORMATION SYSTEMS.
9. EXISTING UTILITIES SHOWN HEREON ARE BASED ON FIELD LOCATIONS AND RECORD DRAWINGS.
10. CONTRACTOR SHALL VERIFY ALL UTILITY LOCATIONS PRIOR TO ANY CONSTRUCTION ACTIVITY AND SHALL ADJUST ALL UTILITIES AND RM ELEVATIONS AS NEEDED TO MATCH THIS PLAN.
11. THIS PROJECT IS WITHIN THE METROPOLITAN DISTRICT. WATER AND SEWER SHALL BE PUBLIC, CONNECTING TO EX. CONTRACT NO. 845-WAS UNDER CONTR. NO. 3463. DRAINAGE AREA IS WITHIN THE PATAPSCO RIVER WATERSHED.
12. FOREST STAND DELINEATION PLAN WAS PREPARED BY ECO-SCIENCE PROFESSIONALS, INC. DATED MAY, 2003 AND APPROVED UNDER 5-03-017.
13. NO WETLANDS OR 100-YEAR FLOODPLAIN EXIST WITHIN THE LIMITS OF PROJECT AS PER A CERTIFICATION LETTER PREPARED BY ECO-SCIENCE PROFESSIONALS, INC. DATED APRIL, 2003 AND APPROVED UNDER 5-03-017.
14. NOISE LINE SHOWN ON PLANS FOR THIS PROJECT BASED ON DATA PROVIDED BY THE MSHA AS PER CONTRACT NO. H06625170 AND APPROVED UNDER 5-03-017.
15. THE NOISE CONTOUR LINE DRAWN ON THIS PLAN IS ADVISORY AS REQUIRED BY THE HOWARD COUNTY DESIGN MANUAL, CHAPTER 5, REVISED FEBRUARY 1992, AND CANNOT BE CONSIDERED TO EXACTLY LOCATE THE 65DBA EXPOSURE. THE 65DBA EXPOSURE WAS ESTABLISHED BY HOWARD COUNTY DEPT. OF PUBLIC WORKS, BUREAU OF ENGINEERING, CONSTRUCTION INSPECTION DIVISION, DATED MARCH 2003. ACCEPTED NOISE LEVELS ESTABLISHED BY THE US DEPARTMENT OF HOUSING AND URBAN DEVELOPMENT.
16. A.P.E.O. TRAFFIC STUDY WAS PREPARED BY THE M&S GROUP, INC. DATED MAY, 2003 AND APPROVED UNDER 5-03-017.
17. THE GEOGRAPHICAL REPORT FOR THIS PROJECT WAS PREPARED BY HELMS-CARVER ENGINEERING ASSOCIATES, DATED NOVEMBER 30, 2005 AND APPROVED UNDER P-06-008.
18. THERE IS AN EXISTING DWELLING LOCATED ON-SITE (LOT 1) TO REMAIN. NO NEW BUILDINGS, EXTENSIONS OR ADDITIONS TO THE EXISTING DWELLING ARE TO BE CONSTRUCTED AT A DISTANCE GREATER THAN THE ZONING REGULATIONS REQUIRE.
19. TO THE BEST OF OUR KNOWLEDGE THERE ARE NO CEMETERY LOCATIONS ON-SITE.
20. UNLESS NOTED AS "PRIVATE", ALL EASEMENTS ARE PUBLIC.
21. ALL DIMENSIONS ARE TO THE FACE OF CURB UNLESS OTHERWISE NOTED.
22. BRL INDICATES BUILDING RESTRICTION LINE.
23. ANY DAMAGE TO THE COUNTY'S RIGHT-OF-WAY SHALL BE CORRECTED AT THE BUILDERS EXPENSE.
24. THIS PLAN IS SUBJECT TO THE AMENDED SUB. EDITION OF THE HOWARD COUNTY SUBDIVISION REGULATIONS AND THE AMENDED HOWARD COUNTY ZONING REGULATIONS, 17 ALSO FALLS UNDER THE CRITERIA ESTABLISHED IN THE INFILL DEVELOPMENT REGULATIONS OF COUNCIL BILL 45-2003, EFFECTIVE OCTOBER 2, 2003.
25. STORMWATER MANAGEMENT SHALL BE PROVIDED FOR THIS PROJECT BASED ON GUIDELINES ESTABLISHED BY THE 2007 MARYLAND STORMWATER DESIGN MANUAL VOLUMES I AND II. QUALITY CONTROL WILL BE PROVIDED BY A SWM POND WITH SAND FILTER, MICRO-BIORETENTION FACILITIES, ROOFTOP AND CURB RUNOFF QUANTITY CONTROL SHALL BE PROVIDED BY THE SWM POND.
26. ALL MICRO-BIORETENTION FACILITIES EXCEPT FOR "M&A" WILL BE PRIVATELY OWNED AND MAINTAINED.
27. MICRO-BIORETENTION FACILITY "M&A" AND THE SWM POND WILL BE PRIVATELY OWNED AND JOINTLY MAINTAINED.
28. TRAFFIC CONTROL DEVICES, MARKINGS, AND SIGNING SHALL BE IN ACCORDANCE WITH THE MOST CURRENT EDITION OF THE MANUAL ON UNIFORM TRAFFIC CONTROL DEVICES (MUTCD). ALL STREET AND REGULATORY SIGNS SHALL BE IN PLACE PRIOR TO THE PLACEMENT OF ANY ASPHALT.
29. ALL SIGN POSTS USED FOR TRAFFIC CONTROL, SIGNS INSTALLED IN THE COUNTY RIGHT-OF-WAY SHALL BE MOUNTED ON A 2" GALVANIZED STEEL, PERFORATED, SQUARE TUBE POST (14 GAUGE), INSERTED INTO A 2-1/2" GALVANIZED STEEL, PERFORATED, SQUARE TUBE SLEEVE (12 GAUGE) - 3' LONG. A GALVANIZED STEEL, POLE CAP SHALL BE MOUNTED ON TOP OF EACH POST.
30. EXTERIOR LIGHTING SHALL BE DIRECTED/REFLECTED AWAY FROM ALL ADJACENT PUBLIC ROADS AND RESIDENTIAL ZONING DISTRICTS. STREET LIGHTS, LIGHT FIXTURES AND THE TYPE OF FIXTURES AND POLE SHALL BE IN ACCORDANCE WITH THE REQUIREMENTS OF SECTION 16.12 OF THE HOWARD COUNTY ZONING REGULATIONS. THE HOWARD COUNTY DESIGN MANUAL, VOLUME 1, (2003), AND AS MODIFIED BY GUIDELINES FOR STREET LIGHTS IN RESIDENTIAL DEVELOPMENTS (1988). A MINIMUM SPACING OF TWENTY FEET (20') SHALL BE MAINTAINED BETWEEN ANY STREET LIGHT AND ANY TREE.
31. PERMETER LANDSCAPING AND TRASH PAD SCREENING SHALL BE PROVIDED IN ACCORDANCE WITH SECTION 16.12 OF THE LANDSCAPE MANUAL AND AS SHOWN ON THE LANDSCAPE PLAN SHEET OF THE ROAD CONSTRUCTION PLANS F-07-110. SURETY IN THE AMOUNT OF \$15,000.00 FOR 35 SHADE TREES, 18 EVERGREENS AND \$54,667.80 SHRUBS SHALL BE POSTED WITH THE DEVELOPER'S AGREEMENT FOR THIS PLAN F-07-110.
32. FOR FLAG OR PIPESTEM LOTS, REFUSE COLLECTION, SNOW REMOVAL AND ROAD MAINTENANCE OR PROVIDED TO THE JUNCTION OF THE FLAG OR PIPESTEM AND ROAD RIGHT-OF-WAY AND NOT TO THE PRESENT LOT DRIVEWAY.
33. DRIVEWAYS SHALL BE PROVIDED PRIOR TO ISSUANCE OF A USE AND OCCUPANCY PERMIT FOR ANY NEW DWELLINGS FOR FIRE AND EMERGENCY VEHICLES FOR THE FOLLOWING MINIMUM REQUIREMENTS:
 - a) WIDTH - 12' OR SERVING MORE THAN ONE RESIDENCE
 - b) SURFACE - 6" OF COMPACT CRUSHER RUN BASE WITH TAR AND CHIP COATING.
 - c) CEMENTITY - MAX. 10% GRADE, MAX. 10% GRADE GRADIENT & MIN. 45' TURNING RADIUS.
 - d) STRUCTURE/STRENGTH (PROPOSED) - CAPABLE OF SUPPORTING 25 GROSS TONS (45,000 LB)
 - e) DRAINAGE ELEMENTS - CAPABLE OF SAFELY PASSING 100 YEAR FLOODPLAIN WITH NO MORE THAN 1 FOOT DEPTH OVER DRIVEWAY.
 - f) STRUCTURE CLEARANCES - MINIMUM 12 FEET.
 - g) MAINTENANCE - SUFFICIENT TO INSURE ALL WEATHER USE.
34. WAIVER PETITION WP-04-72 WAS REQUESTED AND APPROVED ON SEPTEMBER 23, 2003 TO WAIVE SECTION 16.12(2)(c) PER THE FOLLOWING CONDITIONS: THE PROPOSED OPEN SPACE LOT 1 SHALL BE DEDICATED TO THE HOA FOR SWAMP PURPOSES; MINIMUM RESIDENTIAL LOT SIZES MUST BE 20,000 SF. OR GREATER; AND ACCESS TO THESE OPEN SPACE LOTS SHALL BE DIRECTLY FROM THE PROPOSED PUBLIC RIGHT-OF-WAY EXTENSION OF NEW TOP ROAD.
35. WAIVER PETITION WP-04-31 WAS REQUESTED AND APPROVED ON SEPTEMBER 23, 2003 TO WAIVE SECTION 16.12(2)(c) PER THE FOLLOWING CONDITIONS: THE PROPOSED OPEN SPACE LOT 2 SHALL BE DEDICATED TO THE HOA FOR SWAMP PURPOSES; MINIMUM RESIDENTIAL LOT SIZES MUST BE 20,000 SF. OR GREATER; AND ACCESS TO THESE OPEN SPACE LOTS SHALL BE DIRECTLY FROM THE PROPOSED PUBLIC RIGHT-OF-WAY EXTENSION OF NEW TOP ROAD.
36. WAIVER PETITION WP-04-31 WAS REQUESTED AND APPROVED ON SEPTEMBER 23, 2003 TO WAIVE SECTION 16.12(2)(c) PER THE FOLLOWING CONDITIONS: THE PROPOSED OPEN SPACE LOT 3 SHALL BE DEDICATED TO THE HOA FOR SWAMP PURPOSES; MINIMUM RESIDENTIAL LOT SIZES MUST BE 20,000 SF. OR GREATER; AND ACCESS TO THESE OPEN SPACE LOTS SHALL BE DIRECTLY FROM THE PROPOSED PUBLIC RIGHT-OF-WAY EXTENSION OF NEW TOP ROAD.
37. A DESIGN MANUAL WAS SUBMITTED TO THE DEVELOPMENT ENGINEERING DIVISION AND APPROVED BY LETTER DATED JUNE 22, 2006 FOR DIV II, CHAPTER 2, SECTION 2.4.1, TO ALLOW FOR GRADING DEVIATIONS FROM THE TYPICAL ROADWAY SECTION FOR A PUBLIC ACCESS PLACE (FIGURE 2.6) IN CONJUNCTION WITH THE ORDER TO EXISTING CONDITIONS FOR THE PROPOSED PUBLIC RIGHT-OF-WAY EXTENSION OF NEW TOP ROAD. HOWARD COUNTY WILL NOT BE LIABLE FOR ANY DAMAGES TO THE PUBLIC R/W INCURRED DURING NECESSARY MAINTENANCE OF THE EXISTING RETAINING WALL LOCATED ON LOT 1.
38. A DESIGN MANUAL WAS SUBMITTED TO THE DEVELOPMENT ENGINEERING DIVISION AND APPROVED BY LETTER DATED JULY 26, 2003, FOR DIV II, CHAPTER 2, SECTION 2.3.2.3, TO ALLOW FOR THE MINIMUM LENGTH OF A HORIZONTAL CURVE IN A PUBLIC ROADWAY TO BE LESS THAN 100' FOR A CUBIC-SPARC OR LOGICAL ROAD IN ORDER TO MEET EXISTING CONDITIONS FOR THE PROPOSED PUBLIC RIGHT-OF-WAY EXTENSION OF NEW TOP ROAD.
39. FOREST CONSERVATION IN ACCORDANCE WITH SECTION 16.12(2) OF THE FOREST CONSERVATION MANUAL, 1.5 - PROVIDED BY PLACEMENT OF 2.5 ACRES OF FOREST PLANTING. FOREST PLANTING SHALL BE IN ACCORDANCE WITH THE FOREST CONSERVATION MANUAL, 1.5 - PROVIDED BY PLACEMENT OF 2.5 ACRES OF FOREST PLANTING. FOREST PLANTING SHALL BE IN ACCORDANCE WITH THE FOREST CONSERVATION MANUAL, 1.5 - PROVIDED BY PLACEMENT OF 2.5 ACRES OF FOREST PLANTING.
40. ALL AREAS OF CONTROLLED FILL TO BE AT 95% COMPACTION PER ASTM-D1557 STANDARDS.
41. SHA APPROVAL IS REQUIRED FOR THE PROPOSED OUTFALL AND STORM DRAIN SYSTEM WITHIN THE SHA RIGHT-OF-WAY.
42. THE DRIVEWAY RELOCATION FOR EXISTING PARCELS 384 AND 257 MUST BE RESOLVED PRIOR TO FINAL PLAN APPROVAL.
43. THE HOMEOWNER'S SIGNATURE SHALL BE RESPONSIBLE FOR REMOVAL OF GRAFFITI FROM THE RETAINING WALLS.
44. THE CURRENT OWNERS (VIVENCIO R. REYES & JEANNE C. REYES) OF THE ADJOINING PARCEL (P.755, LOT 8) TO THE NORTH OF THIS PROPERTY HAVE SIGNED A LETTER OF ACKNOWLEDGEMENT STATING THEY ARE AWARE THAT, IN EXISTING DRAINAGE, THE SMALL CREEK/STREAM LOCATED AT THE NORTH OF THIS PROPERTY, THAT THIS SMALL CREEK/STREAM, AND WILL AFTER COMPLETION OF THIS PROJECT, CONVEY FLOW FROM THIS SITE. THAT ANY NEW HOMES TO BE BUILT ON THEIR PROPERTY SHOULD NOT BE LOCATED IN THIS AREA UNLESS THEY ARE MADE TO BE ROUTE THE WATER FLOW, AND THAT THIS SITUATION WILL NOT BE EXAMINED BY THIS PROJECT. A COPY OF THIS LETTER IS ON FILE WITH THE DEVELOPER AND WITH PERTINENT HOWARD COUNTY REVIEW AGENCIES.
45. FOREST CONSERVATION IN ACCORDANCE WITH SECTION 16.12(2) OF THE FOREST CONSERVATION MANUAL, SHALL BE PROVIDED BY PLACEMENT OF 2.5 ACRES OF FOREST PLANTING. FOREST PLANTING SHALL BE IN ACCORDANCE WITH THE FOREST CONSERVATION MANUAL, 1.5 - PROVIDED BY PLACEMENT OF 2.5 ACRES OF FOREST PLANTING. FOREST PLANTING SHALL BE IN ACCORDANCE WITH THE FOREST CONSERVATION MANUAL, 1.5 - PROVIDED BY PLACEMENT OF 2.5 ACRES OF FOREST PLANTING.
46. WAIVER PETITION WP-12-61, REQUESTED TO WAIVE SECTION 16.14(4) AND (c) REGARDING PAYMENT OF FEES, POSTING OF ALL MONIES AND FILING OF APPROPRIATE SURETY AND SUBMITTAL OF THE ORIGINAL PLAN AND FILING OF SURETY TO OCTOBER 30, 2012 AND SUBMITTAL OF THE FINAL PLAN MYLAR AND EXTENDED THE DEADLINE FOR PAYMENT OF FEES AND POSTING OF SURETY TO OCTOBER 30, 2012 AND SUBMITTAL OF THE FINAL PLAN MYLAR AND EXTENDED THE DEADLINE FOR PAYMENT OF FEES AND POSTING OF SURETY TO OCTOBER 30, 2012.

HAWES PROPERTY SUBDIVISION (RE-SUBDIVISION OF LOT 2) LOTS 3 THRU 8, OPEN SPACE LOT 9 AND NON-BUILDABLE BULK PARCEL 'A' PARCEL 253 / ZONE: R-20 2nd ELECTION DISTRICT HOWARD COUNTY, MARYLAND REVISED FINAL ROAD CONSTRUCTION PLANS F-07-110

BENCH MARKS - NAD '83
HO. CO. #24FB EL.=423.279
N-582652-103 EL.=1,364,259.930
STAMPED DISC ON CONC. MONUMENT 42' NW FROM PK SET ALONG N. EDGE OF MANAHAN ROAD; 128' FROM EX. TWINSEE; WITHIN TRANSMISSION LINE R/W
HO. CO. #2413 EL.=404.482
N-580,642-103 EL.=1,364,974.471
STAMPED DISC ON CONC. MONUMENT 159' NE FROM BGE POLE #501794; 97.3' SE FROM EX. 10' CEDAR TREE IN CENTER OF TRANSMISSION LINE R/W

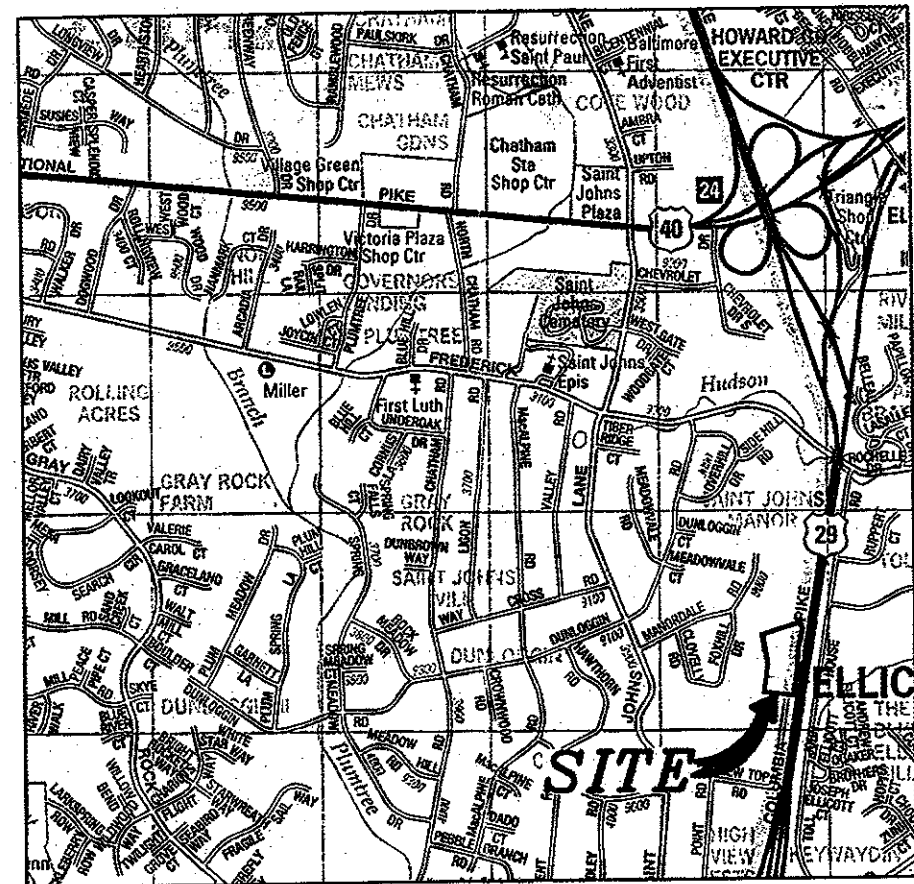

VICINITY MAP
ADD. MAP DATA GRID 1-8
SCALE: 1"=2000'

LEGEND

- SOILS CLASSIFICATION
- SOILS DELINEATION
- EXISTING CONTOURS
- PROPOSED CONTOURS
- EXISTING WOODS LINE
- PROPOSED WOODS LINE
- EXISTING STRUCTURE
- PROPOSED STRUCTURE
- STEEP SLOPES
15% TO 24.9%
- STEEP SLOPES
25% OR GREATER
- LIMIT OF DISTURBANCE
- STABILIZED CONSTRUCTION ENTRANCE
- SILT DIVERSION FENCE
- SUPER SILT FENCE
- INLET PROTECTION
- EARTH DIKE
- RIP-RAP
- PIPE SLOPE DRAIN

MINIMUM LOT SIZE CHART

LOT #	GROSS AREA (SF)	PIPESTEM AREA (SF)	MIN. LOT SIZE (SF)
7	23,021	1,235	21,786
8	31,711	1,539	30,172

RIGHT-OF-WAY CURVE DATA

CURVE	RADIUS	ARC	DELTA	TANGENT	CHORD
RC1	184.87'	8.27'	02°52'26"	4.14'	N26°24'42"E 8.27'
RC2	101.00'	83.76'	47°30'57"	44.46'	N04°05'29"E 81.38'
RC3	140.00'	45.46'	18°36'25"	22.93'	N102°14'37"W 45.27'
RC4	141.00'	116.97'	47°31'51"	62.08'	S04°05'58"W 113.64'
RC5	107.30'	125.70'	67°07'07"	71.18'	S05°23'43"E 118.63'
RC6	188.00'	14.32'	04°21'54"	7.10'	S38°58'37"E 14.32'


SITE DATA TABULATION

1. GENERAL SITE DATA
 - a. PRESENT ZONING: R-20
 - b. LOCATION: TAX MAP 24 - GRID 17 - PARCEL 253
 - c. APPLICABLE DPZ FILE REFERENCES: 5-03-017, F-03-190, WP-03-137, WP-04-072, P-06-008, CONTR. #14-4481-D
 - d. DEED REFERENCE: L7868 / F.646 (PLAT REFERENCE: 16323)
 - e. PROPOSED USE OF SITE: 7 SFD HOMES (INCLUDES 1 EXIST. SFD ON LOT 1)
 - f. PROPOSED WATER AND SEWER SYSTEMS: PUBLIC
2. AREA TABULATION
 - a. TOTAL AREA OF SITE: 5.61 AC± (INCL. LOT 1)
 - b. AREA OF 100 YEAR FLOODPLAIN (APPROX.): N/A
 - c. AREA OF STEEP SLOPES (25% OR GREATER): 0.84 AC±
 - d. NET AREA OF SITE: 4.77 AC±
 - e. AREA OF THIS PLAN SUBMISSION: 5.61 AC±
 - f. LIMIT OF DISTURBANCE (APPROX.): 5.02 AC±
3. UNIT/LOT TABULATION
 - a. TOTAL NUMBER OF RESIDENTIAL LOTS PROPOSED ON THIS SUBMISSION: 7 (INCL. 1 EXIST. ON LOT 1)
 - b. TOTAL NUMBER OF OPEN SPACE LOTS PROPOSED ON THIS SUBMISSION: 1
 - c. OPEN SPACE DATA
 - i. MINIMUM RESIDENTIAL LOT SIZE SELECTED: 20,000 SF.
 - ii. OPEN SPACE REQUIRED FOR TOTAL AREA OF SITE (6% OF 5.61 AC±): 0.34 AC±
 - iii. TOTAL AREA OF PROPOSED OPEN SPACE LOTS PROVIDED WITH THIS SUBMISSION: 0.43 AC±
 - iv. OPEN SPACE AREAS LESS THAN 35' IN WIDTH (NON-CREDITED): 0.00 AC±
 - v. TOTAL AREA OF OPEN SPACE MEETING MINIMUM OPEN SPACE REQUIREMENTS (CREDITED): 0.43 AC±
 - vi. AREA OF RECREATIONAL OPEN SPACE REQUIRED: N/A
 - d. TOTAL AREA OF RECREATIONAL OPEN SPACE PROVIDED: 0.00 AC±

THE PURPOSE OF THESE PLANS IS TO PROVIDE A REVISED LOT LAYOUT AND TO REVISE THE STORMWATER MANAGEMENT DESIGN.

PROFESSIONAL CERTIFICATION

I hereby certify that these documents were prepared or approved by me, and that I am a duly licensed professional engineer under the laws of the State of Maryland, License No. 40091 Expiration Date 2-13-2013

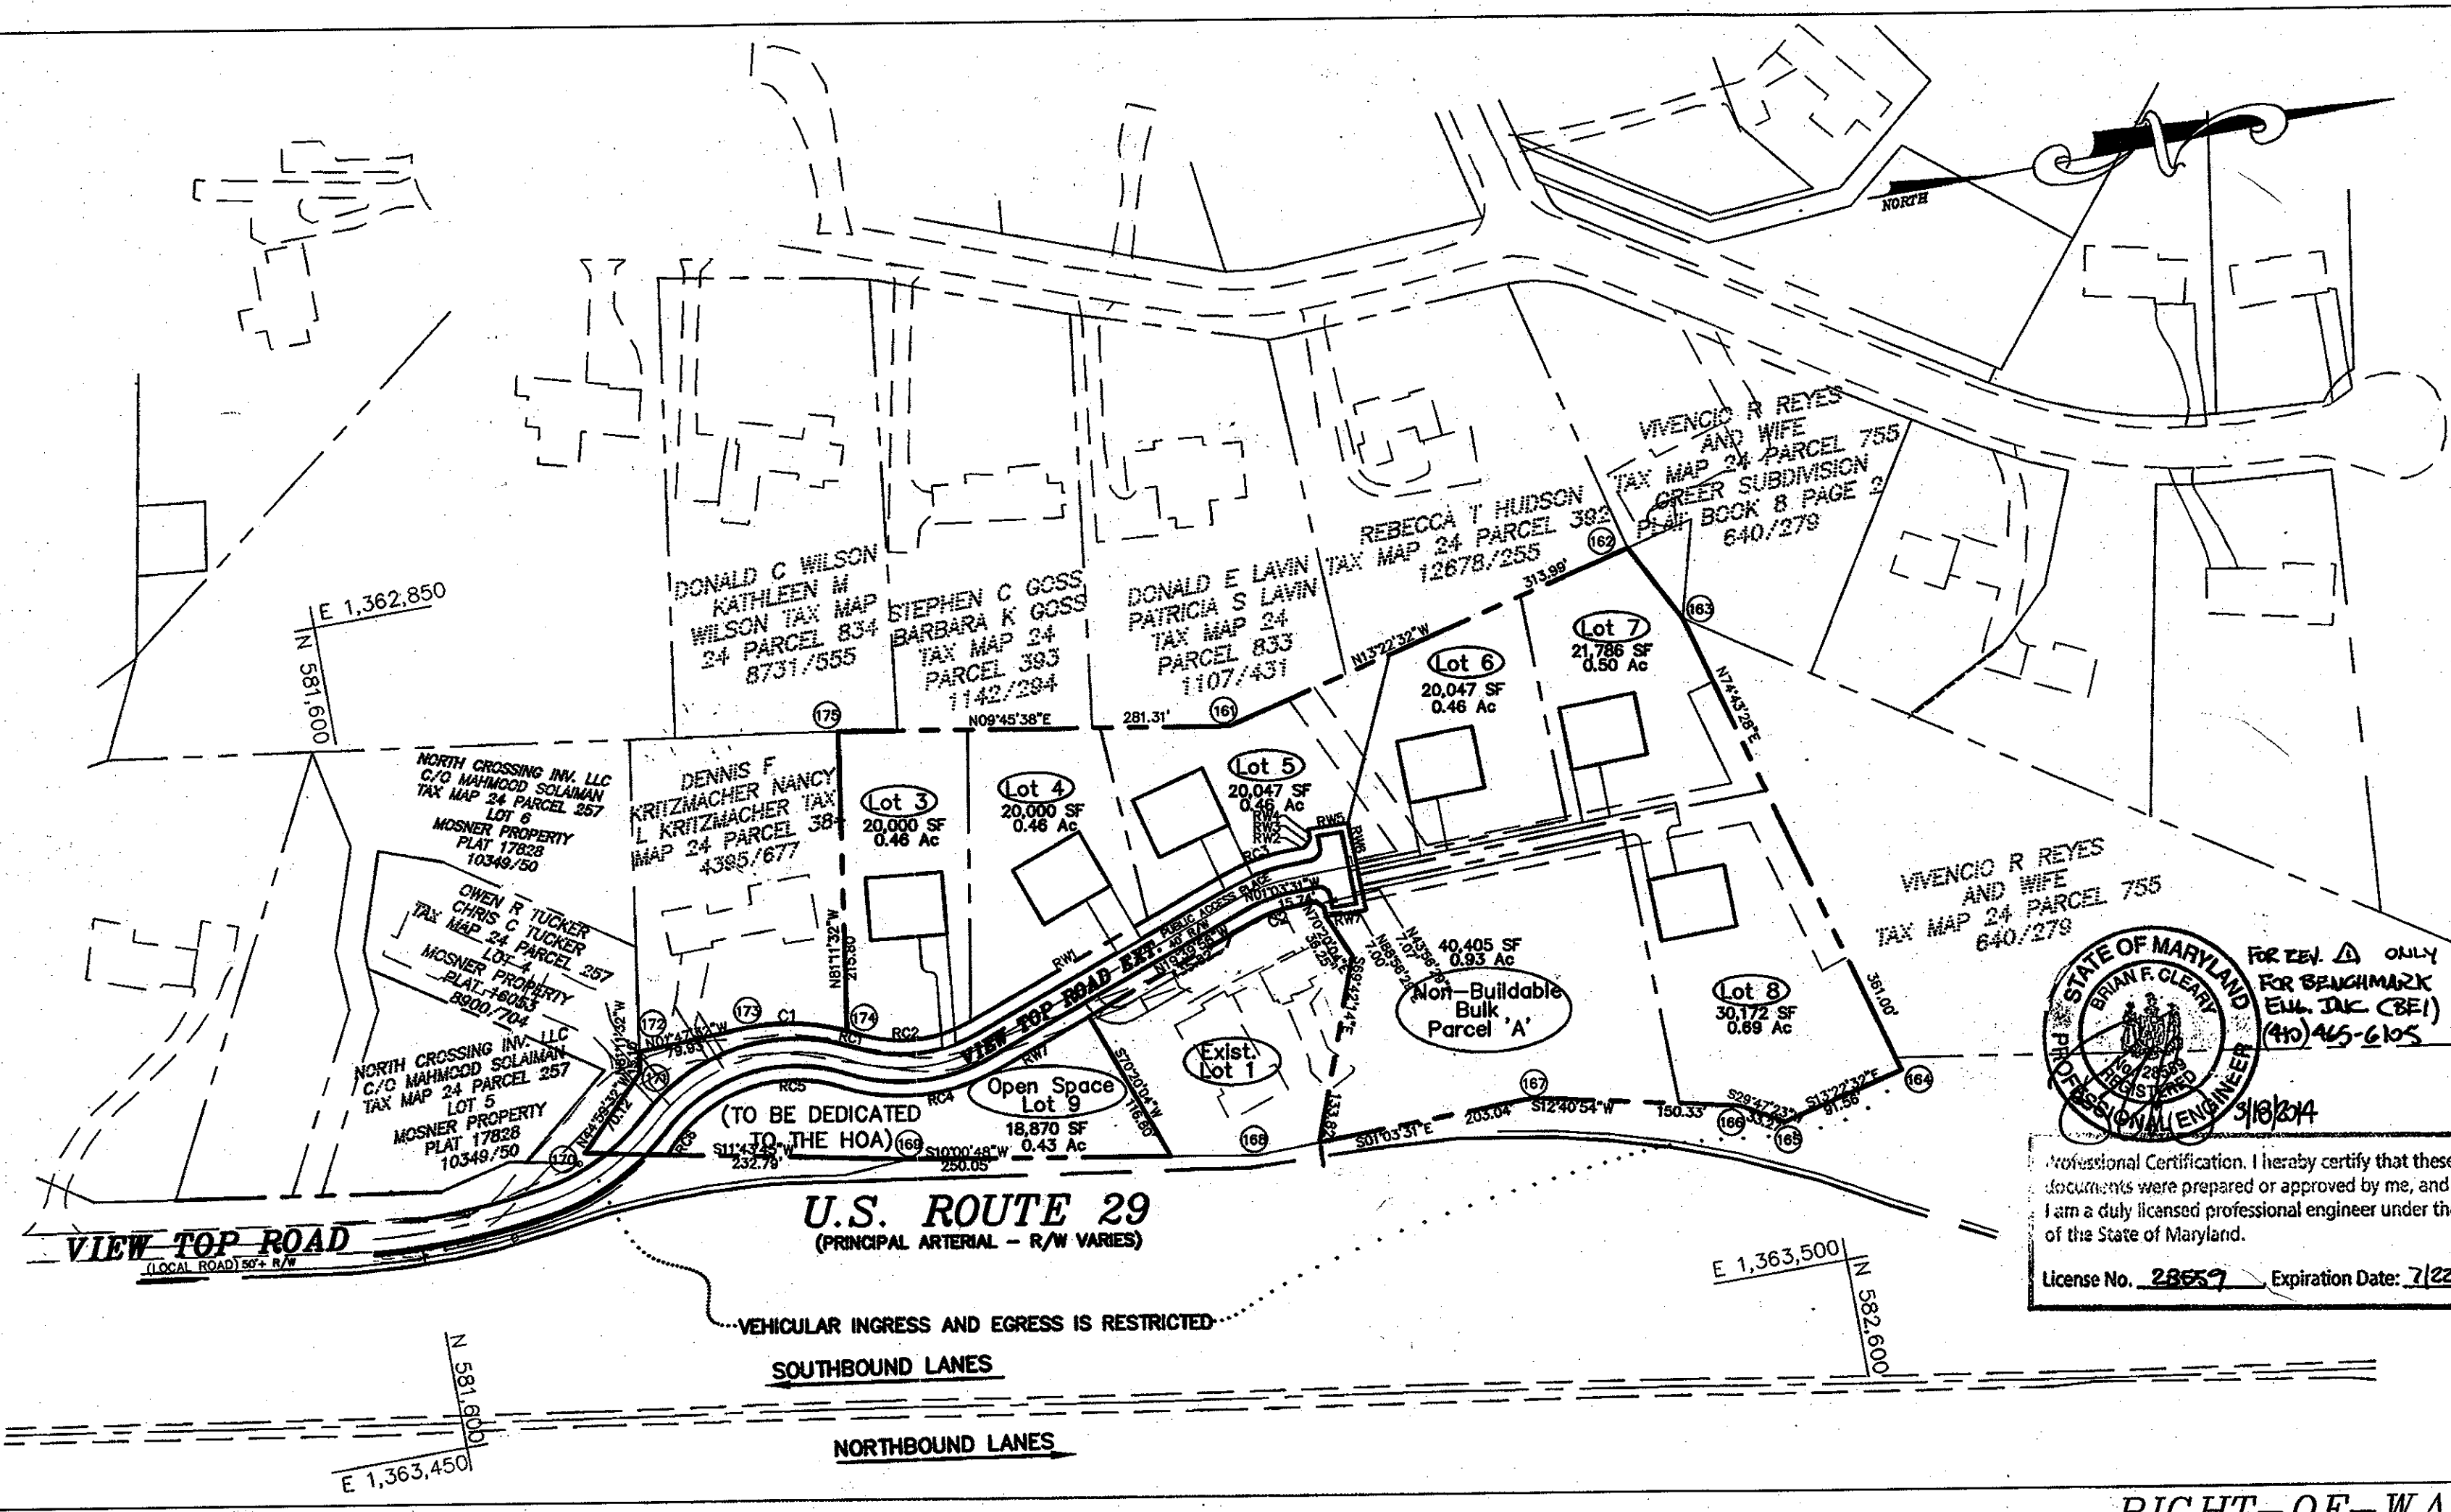

LOCATION PLAN

SCALE: 1"=100'

BOUNDARY COORDINATE TABLE (NAD '83)

NO.	NORTHING	EASTING
161	582,233.9625	1,363,040.6109
162	582,539.4354	1,362,967.9745
163	582,968.8933	1,363,024.9128
164	582,683.8030	1,363,373.1588
165	582,574.7231	1,363,394.3404
166	582,545.8458	1,363,377.8090
167	582,399.1802	1,363,344.8060
168	582,196.1755	1,363,348.5575
169	581,949.9344	1,363,305.0797
170	581,722.0094	1,363,257.7577
171	581,771.5999	1,363,208.1808
172	581,773.9120	1,363,193.2587
173	581,853.8017	1,363,190.7589
174	581,923.6813	1,363,206.1755
175	581,956.7245	1,362,992.9202

RIGHT-OF-WAY BEARINGS AND DISTANCES

LINE	BEARING	DIST.
RW1	N19°39'56"W	211.22'
RW2	N01°03'31"W	15.72'
RW3	N48°03'31"W	7.07'
RW4	S88°56'29"W	7.00'
RW5	N01°03'31"E	29.00'
RW6	N88°56'29"E	64.00'
RW7	S01°03'31"E	29.00'
RW8	S19°39'56"E	75.40'

SHEET INDEX

NO.	DESCRIPTION
1	COVER SHEET
2	ROAD CONSTRUCTION PLAN, NOTES AND DETAILS
3	ROADWAY PROFILE, NOTES, AND DETAILS
4	GRADING PLAN
5	SEDIMENT & EROSION CONTROL PLAN, NOTES, AND DETAILS
6	EROSION AND SEDIMENT CONTROL PLAN
7	(SHEET ELIMINATED)
8	STORMWATER MANAGEMENT PROFILES, NOTES AND DETAILS
9	STORM DRAIN AREA AND SOLS MAP
10	STORM DRAIN PROFILES
11	LANDSCAPE PLAN, NOTES AND DETAILS
12	(SHEET ELIMINATED)
13	MISCELLANEOUS SITE PLAN PROFILES, NOTES AND DETAILS
14	RETAINING WALL CONSTRUCTION DETAILS
15	OFF-SITE FOREST CONSERVATION PLAN, NOTES AND DETAILS
16	MICRO-BIORETENTION FACILITY SECTIONS AND DETAILS

BOUNDARY CURVE DATA

CURVE	RADIUS	ARC	DELTA	TANGENT	CHORD
C1	184.87'	72.13'	25°04'05"	36.65'	S12°26'28"W 71.56'
C2	100.00'	32.47'	18°36'24"	16.38'	S10°21'44"E 32.33'

OWNER/DEVELOPER

3804 VIEW TOP, LLC
1055 WEST JOPPA ROAD
APT. 330
TOWSON, MARYLAND 21204
ATTN: RUSSELL HAWES

THIS DEVELOPMENT PLAN IS APPROVED FOR SOIL EROSION AND SEDIMENT CONTROL BY THE HOWARD SOIL CONSERVATION DISTRICT

John R. Roberts 4/16/12
HOWARD SOIL CONSERVATION DISTRICT DATE

APPROVED: HOWARD COUNTY DEPARTMENT OF PUBLIC WORKS

William Z. Hall 4-16-12
CHIEF, BUREAU OF HIGHWAYS DATE

APPROVED: HOWARD COUNTY DEPARTMENT OF PLANNING AND ZONING

Jeffrey Sloman 4/27/12
CHIEF, DEVELOPMENT ENGINEERING DIVISION DATE

Keat Shuchman 4/30/12
CHIEF, DIV. DIRECTOR OF LAND DEVELOPMENT DATE

BY THE OWNER / DEVELOPER:

"I/WE CERTIFY THAT ALL DEVELOPMENT AND/OR CONSTRUCTION WILL BE DONE ACCORDING TO THESE PLANS, AND THAT ANY RESPONSIBLE PERSONNEL INVOLVED IN THE CONSTRUCTION PROJECT WILL HAVE A CERTIFICATE OF ATTENDANCE AT A DEPARTMENT OF THE ENVIRONMENT APPROVED TRAINING PROGRAM FOR THE CONTROL OF SEDIMENT AND EROSION BEFORE BEGINNING THE PROJECT. I ALSO AUTHORIZE PERIODIC ON-SITE INSPECTIONS BY THE HOWARD CONSERVATION DISTRICT."

OWNER / DEVELOPER - OWNER'S AGENT

BY THE ENGINEER:

I CERTIFY THAT THIS PLAN FOR SEDIMENT AND EROSION CONTROL REPRESENTS A PRACTICAL AND WORKABLE PLAN BASED ON MY PERSONAL KNOWLEDGE OF THE SITE CONDITIONS AND THAT IT WAS PREPARED IN ACCORDANCE WITH THE REQUIREMENTS OF THE HOWARD SOIL CONSERVATION DISTRICT.


ENGINEER - JEFFREY SLOMAN, PE #40091

project	date	revision
SEP 2011	engineering	1
10-024	illustration	1
11-024	11/5	1
11-024	11/5	1
11-024	11/5	1


date	description	revision
3-13-14	REVISED PER COMMENTS	1
2/2/2012	REVISED PER COMMENTS	1
11/2/2011	REVISED PER COMMENTS	1

HAWES PROPERTY
LOTS 3 THRU 8, O.S. LOT 9, AND NON-BUILDABLE BULK PARCEL 'A'
TAX MAP 24 GRID 17 PARCEL 253
2nd ELECTION DISTRICT
HOWARD COUNTY, MARYLAND
COVER SHEET

MILDENBERG, BOENDER & ASSOC., INC.
Engineers Planners Surveyors
6800 Deerpath Road, Suite 150, Ellicott City, Maryland 21075
(410) 997-0296 Fax: (410) 997-0298 Fax

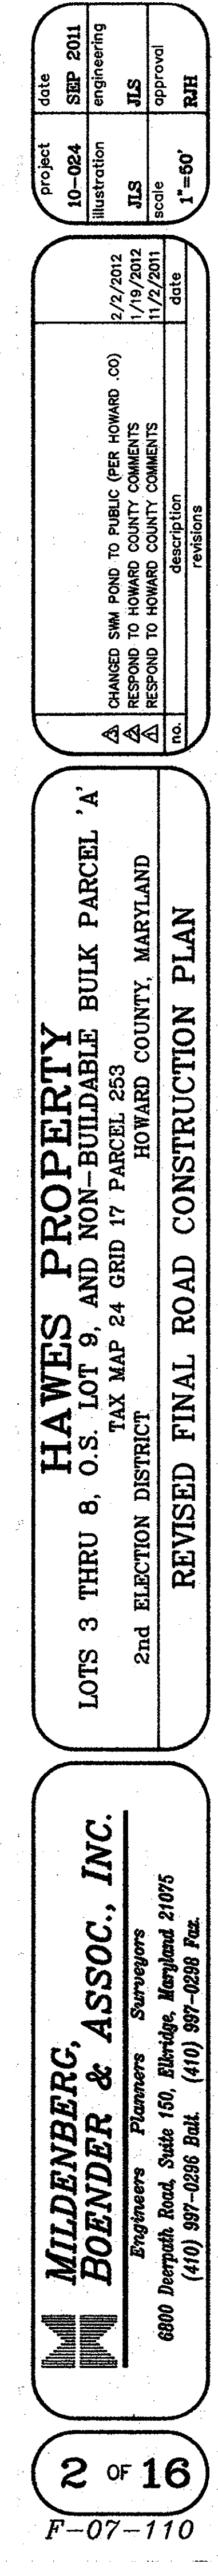


F-07-110

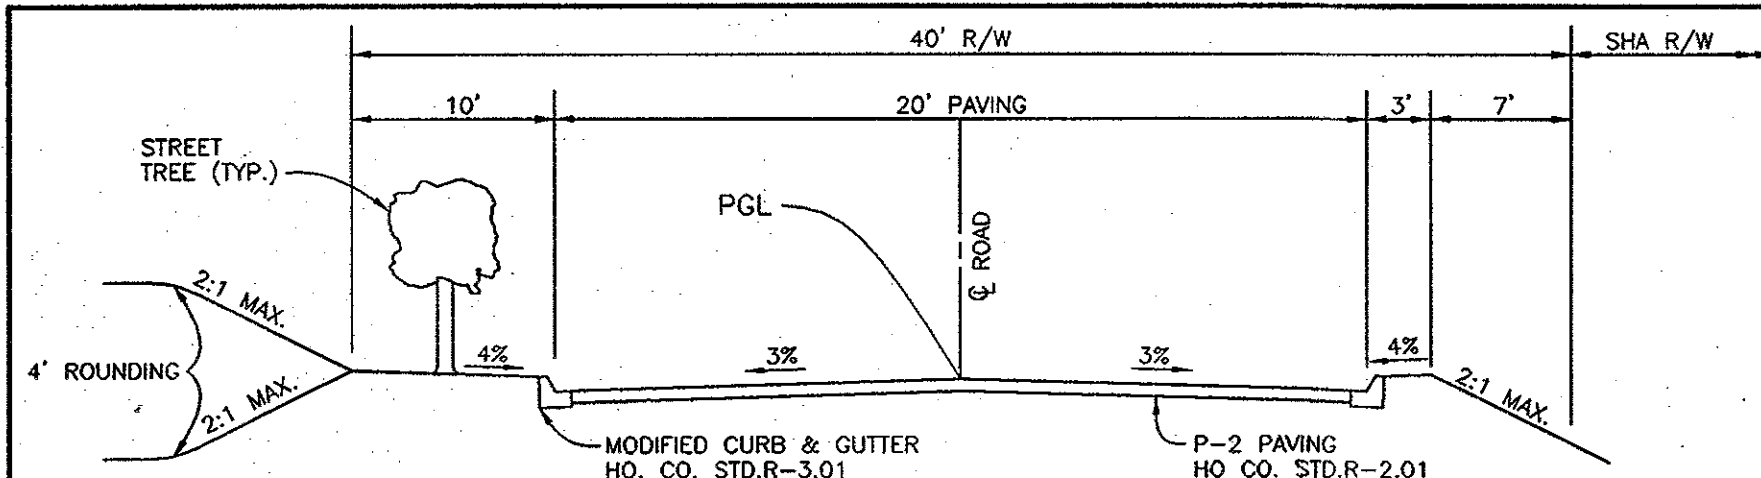


TYPICAL ROADWAY SECTION
NOT TO SCALE

VIEW TOP ROAD
PUBLIC ACCESS PLACE - LESS THAN 200 ADT
POSTED SPEED: 15 MPH (DESIGN SPEED: 25 MPH)
FROM STA. 0+00.00 (BEGIN ROADWAY IMPROVEMENTS)
TO STA. 0+49.60 (PROP. RETAINING WALL) AND

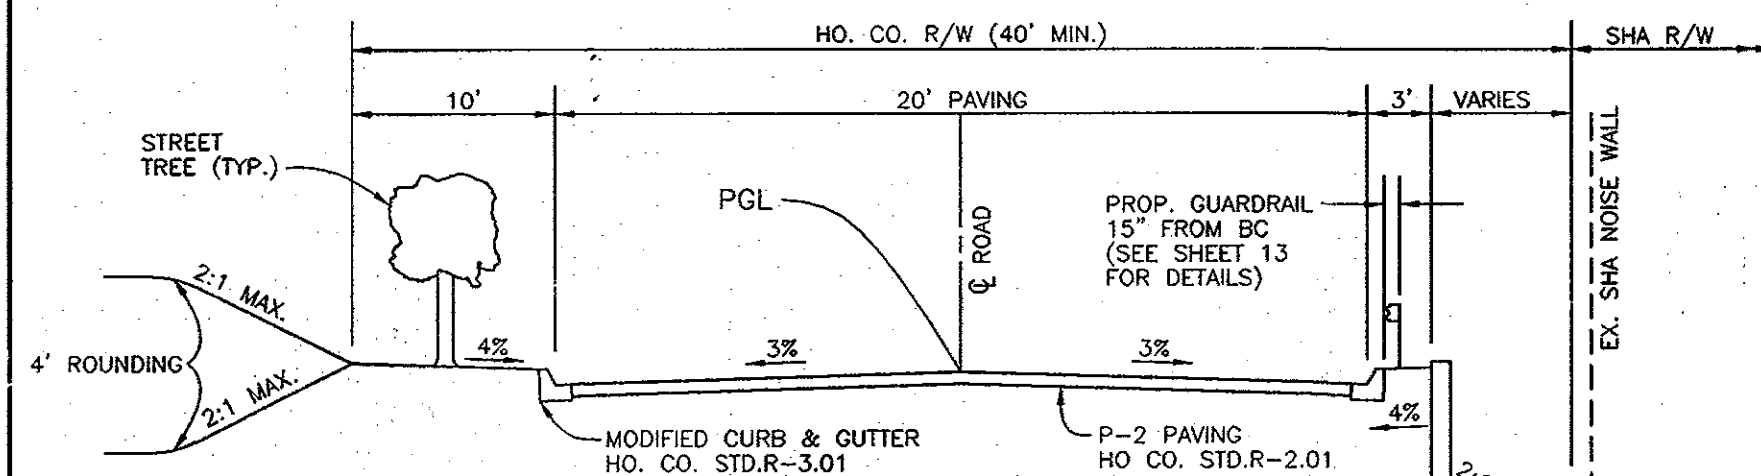


TYPICAL ROADWAY SECTION
NOT TO SCALE

VIEW TOP ROAD
PUBLIC ACCESS PLACE - LESS THAN 200 ADT
POSTED SPEED: 15 MPH (DESIGN SPEED: 25 MPH)
FROM STA. 0+49.60 (PROP. RETAINING WALL)
TO STA. 1+79.30 (END PROP. RETAINING WALL)

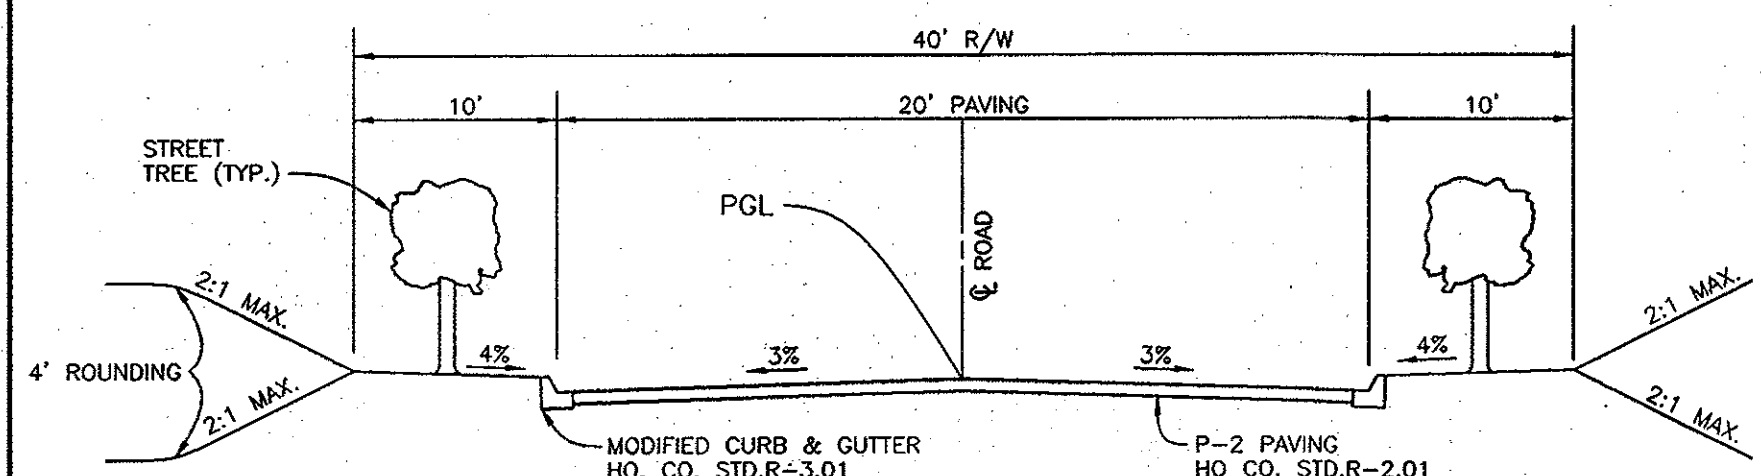



TYPICAL ROADWAY SECTION
NOT TO SCALE

VIEW TOP ROAD
PUBLIC ACCESS PLACE - LESS THAN 200 ADT
POSTED SPEED: 15 MPH (DESIGN SPEED: 25 MPH)
FROM STA. 1+79.30 (END PROP. RETAINING WALL)
TO STA. 5+65.98 (C/L NEW DRIVEWAY EX. LOT 1)

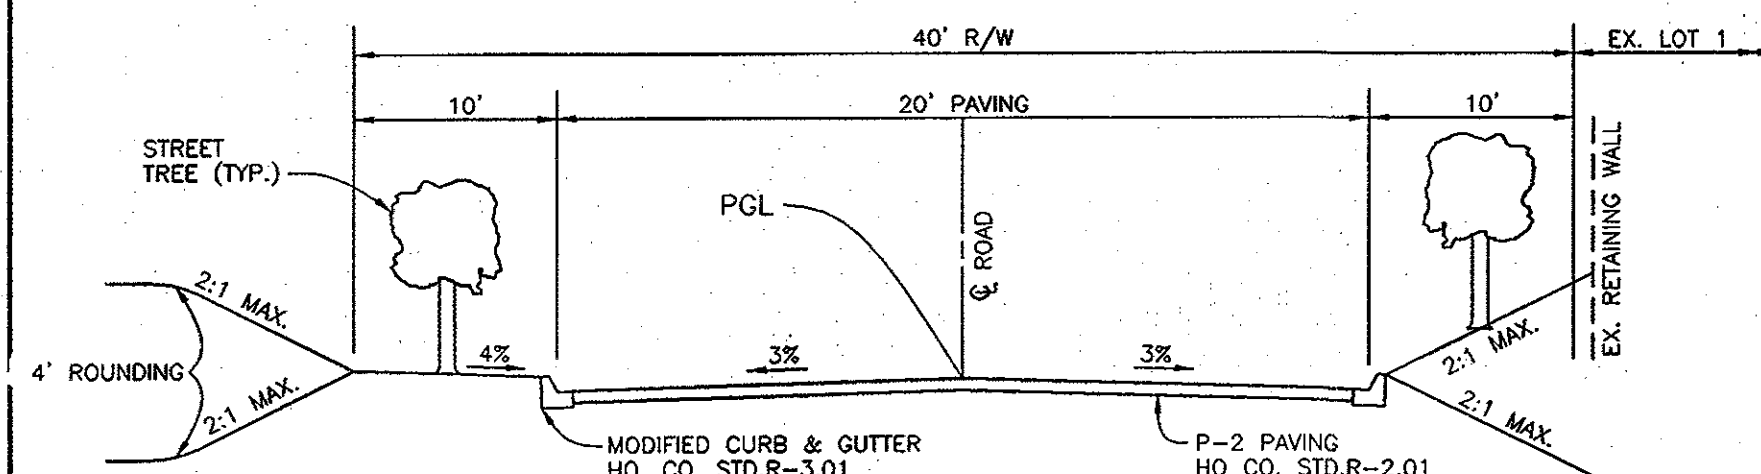


TYPICAL ROADWAY SECTION
NOT TO SCALE

VIEW TOP ROAD
PUBLIC ACCESS PLACE - LESS THAN 200 ADT
POSTED SPEED: 15 MPH (DESIGN SPEED: 25 MPH)
FROM STA. 5+65.98 (C/L NEW DRIVEWAY EX. LOT 1)
TO STA. 7+55.79 (END FILLETS @ TEE-TURNAROUND)

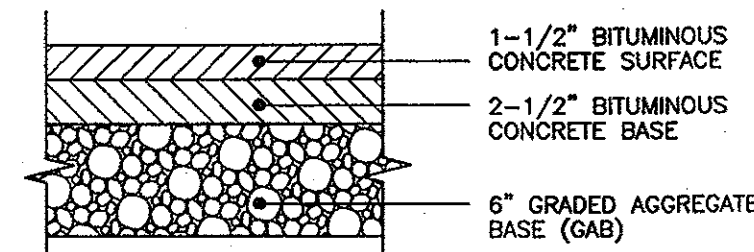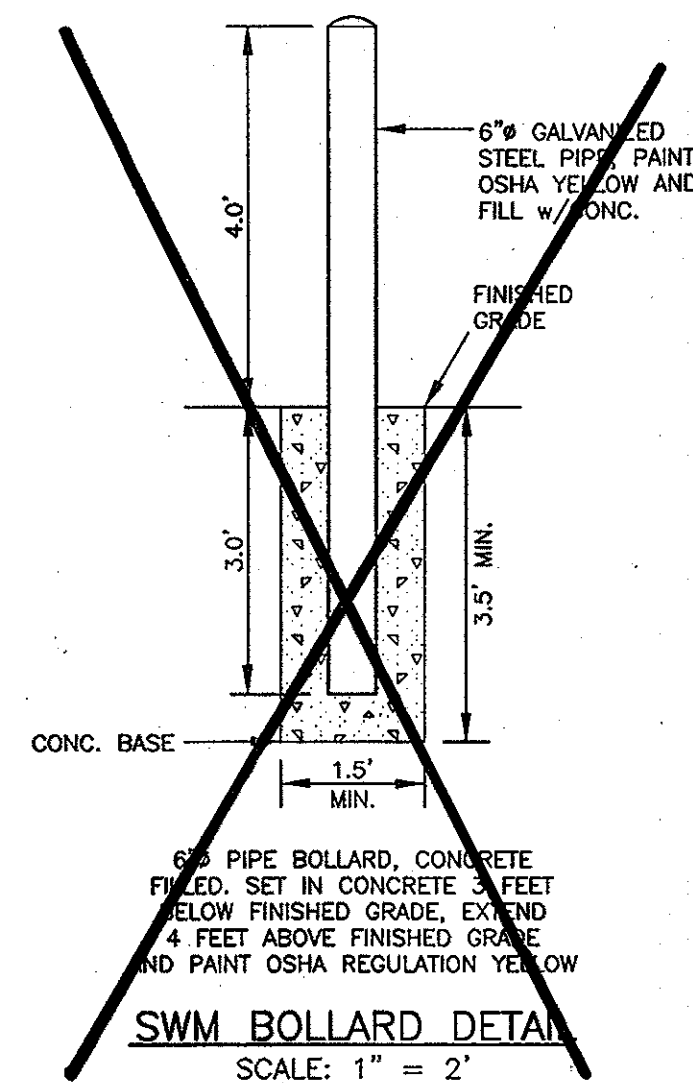


ALTERNATIVE SECTION

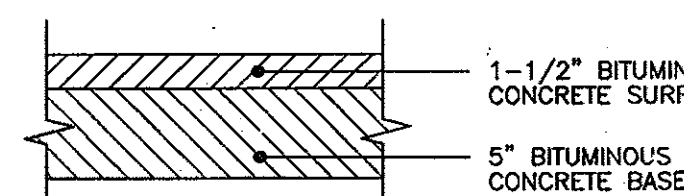

TYPICAL SECTION


P-2 PAVEMENT DETAIL
NOT TO SCALE

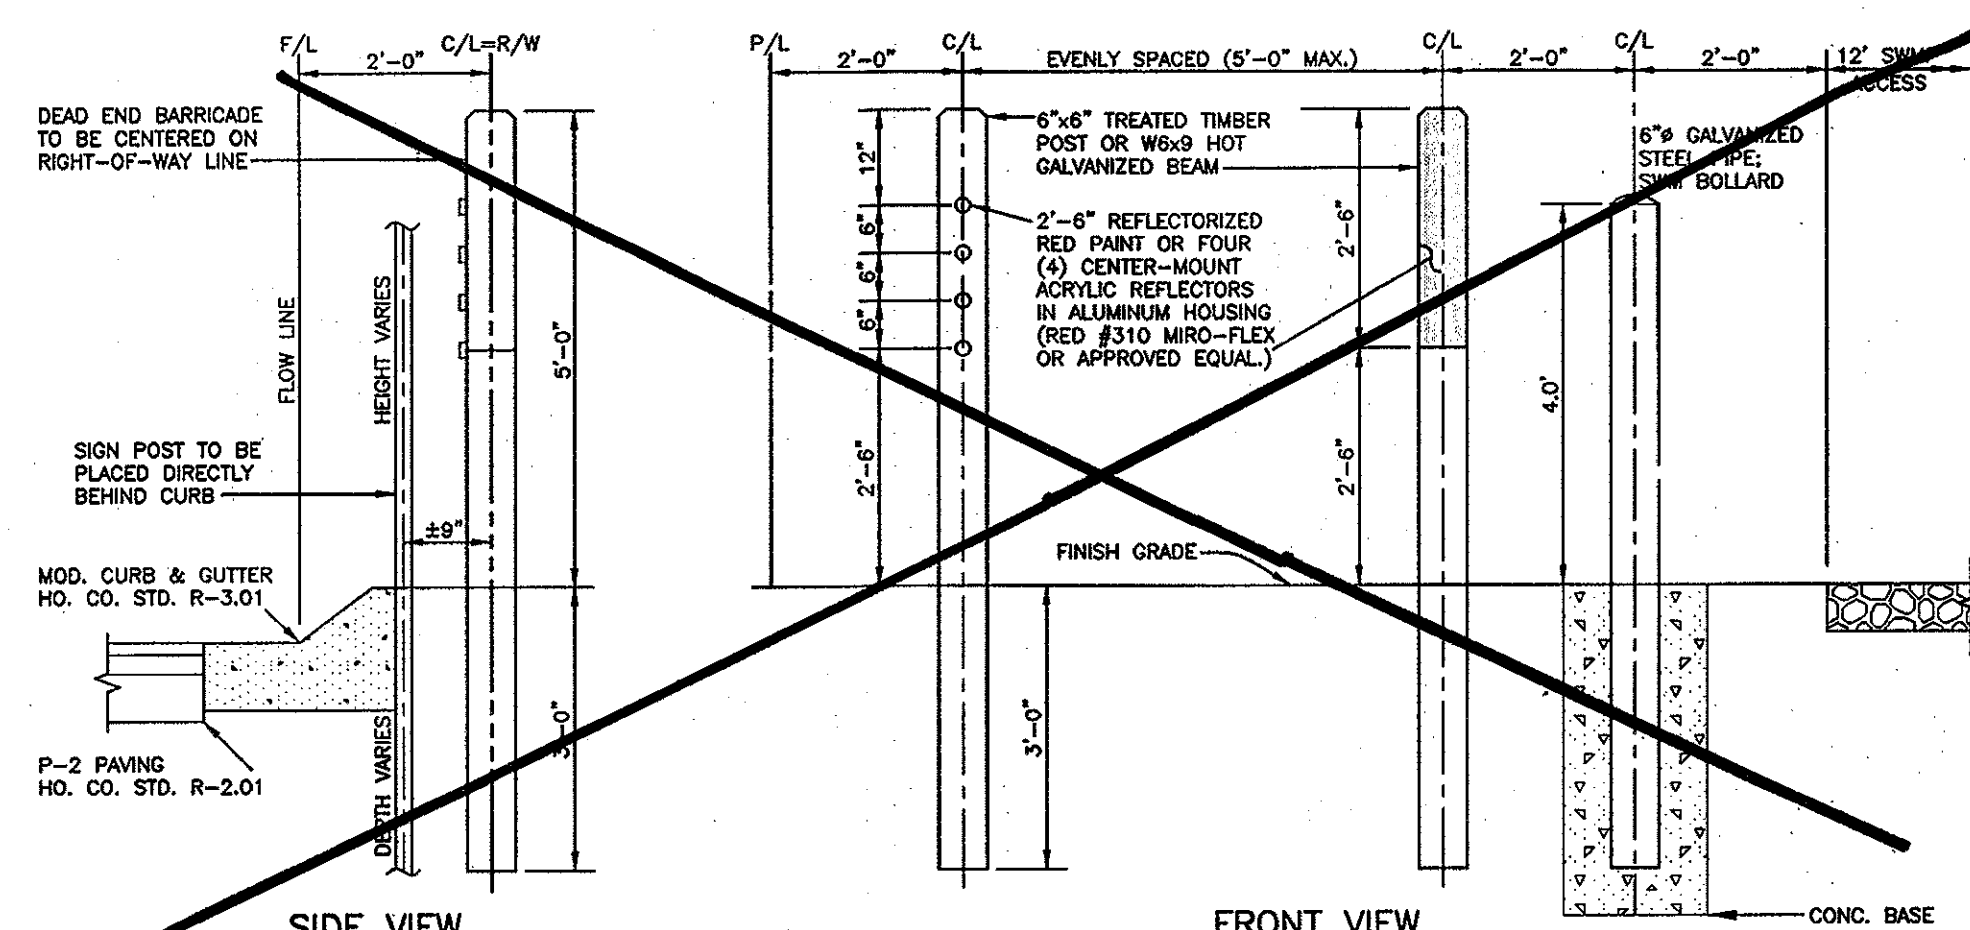

NOTE: THIS DETAIL CONFORMS TO HO.CO. STD.R-7.10

DEAD END BARRICADE DETAIL

SCALE: 1" = 2"

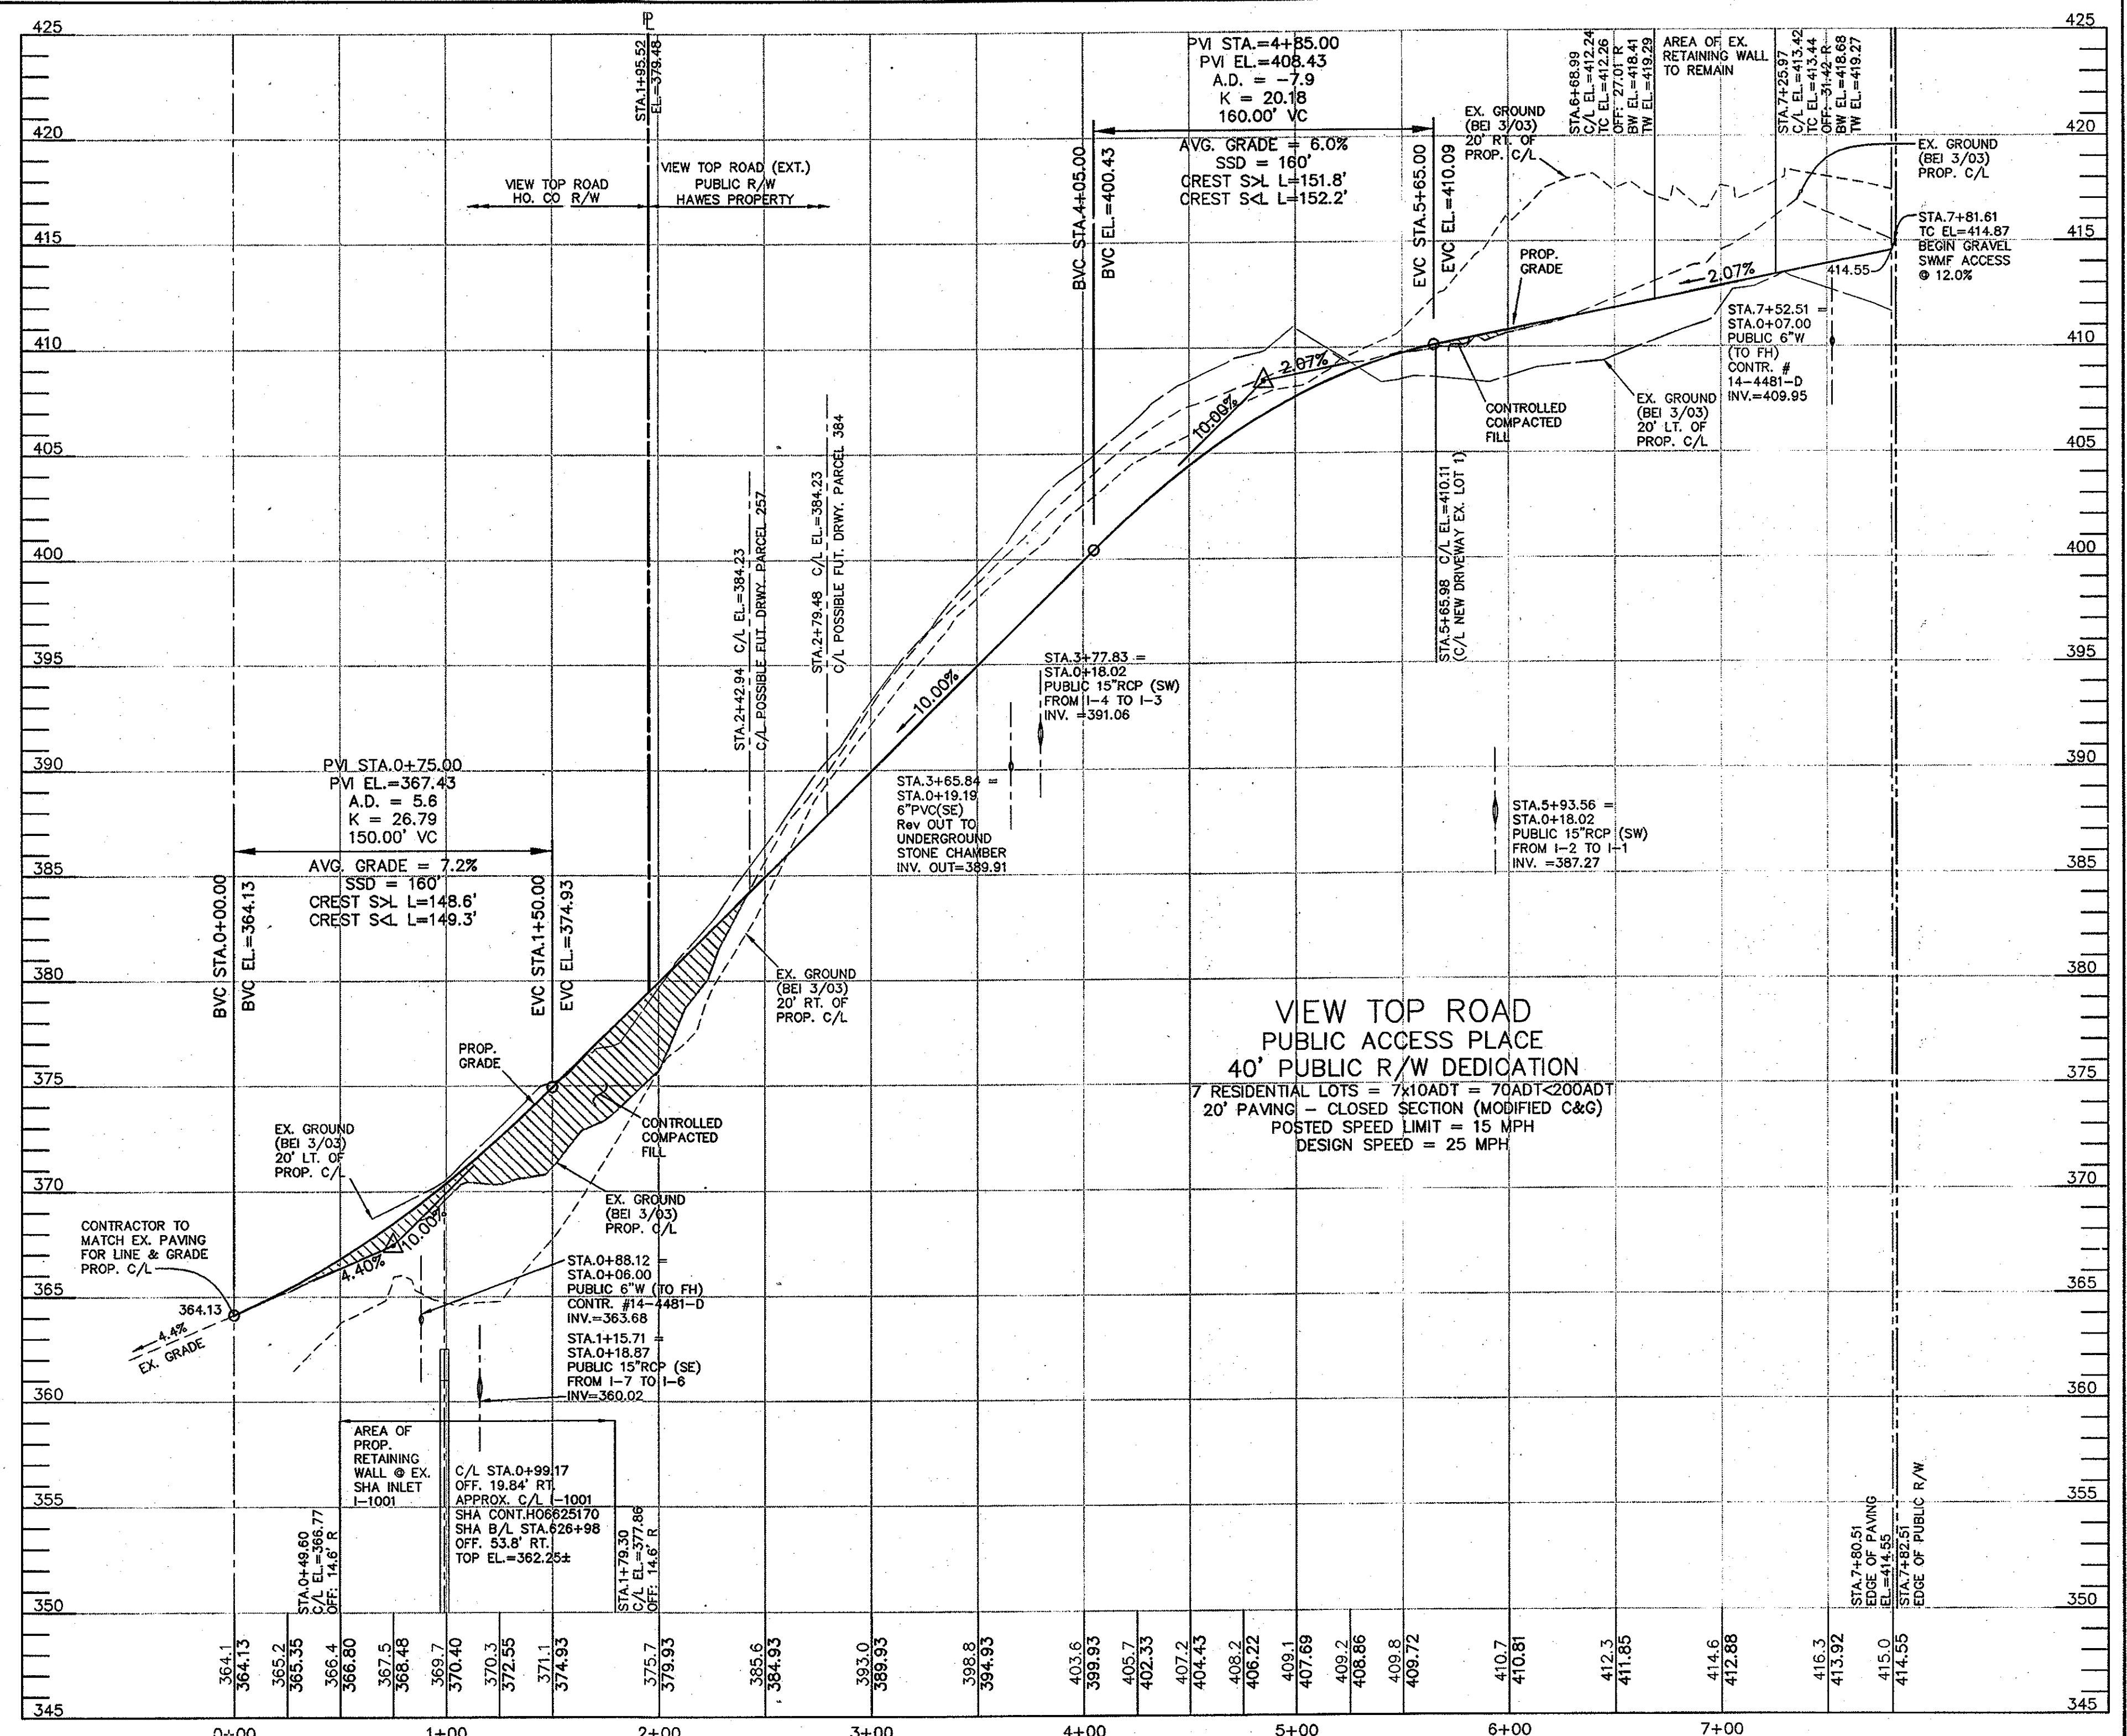

ROAD PROFILE


VERTICAL SCALE: 1" = 5'
HORIZONTAL SCALE: 1" = 50'



1 9/13/11 REVISED LOT LAYOUT, STORMWATER MANAGEMENT AND LOT GRADING	
NO.	DATE
REVISION	
BENCHMARK ENGINEERING, INC.	
8480 BALTIMORE NATIONAL PIKE # SUITE 418 ELLICOTT CITY, MARYLAND 21043 PHONE: 410-465-6105 FAX: 410-465-6844 E-MAIL: bei@bei-civilengineering.com	
PROFESSIONAL CERTIFICATION: I hereby certify that these documents were prepared or approved by me, and that I am a duly licensed professional engineer under the laws of the State of Maryland. License No. 21445, Expiration Date: 12-21-2008	

APPROVED: HOWARD COUNTY DEPARTMENT OF PUBLIC WORKS	
WILLIAM H. HARRIS	5-5-08
CHIEF, BUREAU OF HIGHWAYS	DATE
APPROVED: HOWARD COUNTY DEPARTMENT OF PLANNING AND ZONING	
CINDY HARRIS	5/5/08
CHIEF, DIVISION OF LAND DEVELOPMENT	DATE
CHIEF, DEVELOPMENT ENGINEERING DIVISION	

DEVELOPER/CONTRACT PURCHASER:	
SECURITY DEVELOPMENT, L.L.C. P.O. BOX 417 ELLICOTT CITY, MARYLAND 21041 PHONE: (410) 465-4244	
PROJECT: HAWES PROPERTY SUBDIVISION (RE-SUBDIVISION OF LOT 2) LOTS 1 & 5-10 AND O.S. LOTS 3 & 4	
LOCATION: TAX MAP 24 - GRID 17 PARCEL 253 - ZONE R-20 2nd ELECTION DISTRICT HOWARD COUNTY, MARYLAND	
TITLE: FINAL/CONSTRUCTION PLAN ROAD PROFILE, NOTES AND DETAILS	
DATE: DECEMBER 20, 2006 MARCH 14, 2008	PROJECT NO. 1574
SCALE: AS SHOWN	DRAWING 3 OF 16

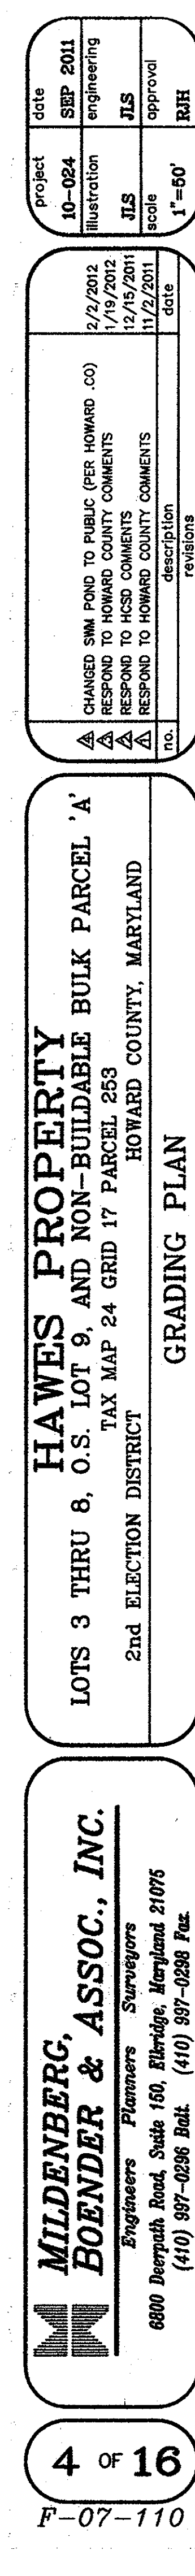

4 OF 16
F-07-110

SEDIMENT CONTROL NOTES

- A MINIMUM OF 48 HOURS NOTICE MUST BE GIVEN TO THE HOWARD COUNTY DEPARTMENT OF INSPECTIONS AND PERMITS SEDIMENT CONTROL DIVISION PRIOR TO THE START OF ANY CONSTRUCTION.
- ALL VEGETATIVE AND STRUCTURAL PRACTICES ARE TO BE INSTALLED ACCORDING TO THE PROVISIONS OF THIS PLAN AND ARE TO BE IN CONFORMANCE WITH THE 1994 MARYLAND STANDARDS AND SPECIFICATIONS FOR SOIL EROSION AND SEDIMENT CONTROL AND REVISIONS THERETO.
- FOLLOWING INITIAL SOIL DISTURBANCE OR REDISTURBANCE, PERMANENT OR TEMPORARY STABILIZATION SHALL BE COMPLETED WITHIN: A) 7 CALENDAR DAYS FOR ALL PERIMETER SEDIMENT CONTROL STRUCTURES, DIKES, PERIMETER SLOPES AND ALL SLOPES GREATER THAN 3:1, B) 14 DAYS AS TO ALL OTHER DISTURBED OR GRADED AREAS ON THE PROJECT SITE.
- ALL SEDIMENT TRAPS/BASINS SHOWN MUST BE FENCED AND WARNING SIGNS POSTED AROUND THEIR PERIMETER IN ACCORDANCE WITH VOL. 1, CHAPTER 12, OF THE HOWARD COUNTY DESIGN MANUAL, STORM DRAINAGE.
- ALL DISTURBED AREAS MUST BE STABILIZED WITHIN THE TIME PERIOD SPECIFIED ABOVE IN ACCORDANCE WITH THE 1994 MARYLAND STANDARDS AND SPECIFICATIONS FOR SOIL EROSION AND SEDIMENT CONTROL FOR PERMANENT SEEDINGS (SEC. 51) SOD (SEC. 54), TEMPORARY SEEDING (SEC. 50) AND MULCHING (SEC. 52). TEMPORARY STABILIZATION WITH MULCH ALONE CAN ONLY BE DONE WHEN RECOMMENDED SEEDING DATES DO NOT ALLOW FOR PROPER GERMINATION AND ESTABLISHMENT OF GRASSES.
- ALL SEDIMENT CONTROL STRUCTURES ARE TO REMAIN IN PLACE AND ARE TO BE MAINTAINED IN OPERATIVE CONDITION UNTIL PERMISSION FOR THEIR REMOVAL HAS BEEN OBTAINED FROM THE HOWARD COUNTY SEDIMENT CONTROL INSPECTOR.
- SITE ANALYSIS:

TOTAL AREA OF SITE	5.61 ACRES
TOTAL AREA DISTURBED	5.00 ACRES
AREA TO BE ROOFED OR PAVED	1.44 ACRES
AREA TO BE VEGETATIVELY STABILIZED	1.56 ACRES
TOTAL CUT	500 CU. YDS.
TOTAL FILL	500 CU. YDS.
OFF-SITE HAUL	0000 CU. YDS.
- ANY SEDIMENT CONTROL PRACTICE WHICH IS DISTURBED BY GRADING ACTIVITY FOR PLACEMENT OF UTILITIES MUST BE REPAIRED ON THE SAME DAY OF DISTURBANCE.
- ADDITIONAL SEDIMENT CONTROLS MUST BE PROVIDED, IF DEEMED NECESSARY BY THE HOWARD COUNTY SEDIMENT CONTROL INSPECTOR.
- ON ALL SITES WITH DISTURBED AREAS IN EXCESS OF 2 ACRES, APPROVAL OF THE INSPECTION AGENCY SHALL BE REQUESTED UPON COMPLETION OF INSTALLATION OF PERIMETER EROSION AND SEDIMENT CONTROLS, BUT BEFORE PROCEEDING WITH ANY OTHER EARTH DISTURBANCE OR GRADING. AFTER THE BUILDING GRADING INSPECTION APPROVALS MAY NOT BE AUTHORIZED UNTIL THIS INITIAL APPROVAL BY THE INSPECTION AGENCY IS MADE.
- TRENCHES FOR THE CONSTRUCTION OF UTILITIES ARE LIMITED TO THREE PIPE LENGTHS OR THAT WHICH CAN BE BACK FILLED AND STABILIZED WITHIN ONE WORKING DAY, WHICHEVER IS SHORTER.
- IT IS THE RESPONSIBILITY OF THE CONTRACTOR TO IDENTIFY AN OFF-SITE SPOIL AREA WITH AN APPROVED SEDIMENT & EROSION CONTROL PLAN AND PERMIT.

TEMPORARY SEEDBED PREPARATION

APPLY TO GRADED OR CLEARED AREAS LIKELY TO BE REDISTURBED WHERE A SHORT-TERM VEGETATIVE COVER IS NEEDED.

SEEDBED PREPARATION: LOOSEN UPPER THREE INCHES OF SOIL BY RAKING, DISKING OR OTHER ACCEPTABLE MEANS BEFORE SEEDING, IF NOT PREVIOUSLY LOOSENED.

SOIL AMENDMENTS: APPLY 600 LBS PER ACRE 10-10-10 FERTILIZER (14 LBS/1000 SQ FT).

SEEDING: FOR PERIOD MARCH 1 THROUGH APRIL 30 AND FROM AUGUST 15 THROUGH NOVEMBER 15, SEED WITH 2-1/2 BUSHELS PER ACRE OF ANNUAL RYE (3.2 LBS/1000 SQ FT). FOR THE PERIOD MAY 1 THROUGH AUGUST 14, SEED WITH 3 LBS PER ACRE OF WEEPING LOVEGRASS (.07 LBS/1000 SQ FT). FOR THE PERIOD NOVEMBER 16 THROUGH FEBRUARY 28, PROTECT SITE BY APPLYING 2 TONS PER ACRE OF WELL ANCHORED STRAW MULCH AND SEED AS SOON AS POSSIBLE IN THE SPRING, OR USE SOD.

MULCHING: APPLY 1-1/2 TO 2 TONS PER ACRE (70 TO 90 LBS/1000 SQ FT) OF UNROTTED SMALL GRAIN STRAW IMMEDIATELY AFTER SEEDING. ANCHOR MULCH IMMEDIATELY AFTER APPLICATION USING MULCH ANCHORING TOOL OR 218 GALLONS PER ACRE (5 GAL/1000 SQ FT) OF EMULSIFIED ASPHALT ON FLAT AREAS, ON SLOPES 8 FT OR HIGHER, USE 348 GALLONS PER ACRE (8 GAL/1000 SQ FT) FOR ANCHORING.

REFER TO THE 1994 MARYLAND STANDARDS AND SPECIFICATIONS FOR SOIL EROSION AND SEDIMENT CONTROL FOR RATE AND METHODS NOT COVERED.

PERMANENT SEEDBED PREPARATION

SEEDBED PREPARATION: LOOSEN UPPER THREE INCHES OF SOIL BY RAKING, DISKING OR OTHER ACCEPTABLE MEANS BEFORE SEEDING, IF NOT PREVIOUSLY LOOSENED.

SOIL AMENDMENTS: IN LIEU OF SOIL TEST RECOMMENDATIONS, USE ON OF THE FOLLOWING SCHEDULES:

- PREFERRED - APPLY 2 TONS PER ACRE DOLOMITIC LIMESTONE (92 LBS/1000 SQ FT) AND 600 LBS PER ACRE 10-10-10 FERTILIZER (14 LBS/1000 SQ FT) BEFORE SEEDING. HARROW OR DISC INTO UPPER THREE INCHES OF SOIL. AT TIME OF SEEDING, APPLY 400 LBS PER ACRE 30-0-0-0 UREAFORM FERTILIZER (9 LBS/1000 SQ FT).
- ACCEPTABLE - APPLY 2 TONS PER ACRE DOLOMITIC LIMESTONE (92 LBS/1000 SQ FT) AND 1000 LBS PER ACRE 10-10-10 FERTILIZER (23 LBS/1000 SQ FT) BEFORE SEEDING. HARROW OR DISC INTO UPPER THREE INCHES OF SOIL.

SEEDING: FOR THE PERIODS MARCH 1 THROUGH APRIL 30 AND AUGUST 1 THROUGH OCTOBER 15, SEED WITH 80 LBS PER ACRE (1.4 LBS/1000 SQ FT) OF KENTUCKY 31 TALL FESCUE PER ACRE AND 2 LBS PER ACRE (.05 LBS/1000 SQ FT) OF WEEPING LOVEGRASS. DURING THE PERIOD OF OCTOBER 16 THROUGH FEBRUARY 28, PROTECT SITE BY: OPTION (1) 2 TONS PER ACRE OF WELL ANCHORED STRAW MULCH AND SEED AS SOON AS POSSIBLE IN THE SPRING. OPTION (2) USE SOD. OPTION (3) SEED WITH 60 LBS PER ACRE OF KENTUCKY 31 TALL FESCUE AND MULCH WITH 2 TONS PER ACRE OF WELL ANCHORED STRAW.

MULCHING: APPLY 1-1/2 TO 2 TONS PER ACRE (70 TO 90 LBS/1000 SQ FT) OF UNROTTED SMALL GRAIN STRAW IMMEDIATELY AFTER SEEDING. ANCHOR MULCH IMMEDIATELY AFTER APPLICATION USING MULCH ANCHORING TOOL OR 218 GALLONS PER ACRE (5 GAL/1000 SQ FT) OF EMULSIFIED ASPHALT ON FLAT AREAS, ON SLOPES 8 FEET OR HIGHER, USE 348 GALLONS PER ACRE (8 GAL/1000 SQ FT) FOR ANCHORING.

MAINTENANCE: INSPECT ALL SEEDBED AREAS AND MAKE NEEDED REPAIRS, REPLACEMENTS AND RESEEDINGS.

SEQUENCE OF CONSTRUCTION

NOTIFY SEDIMENT CONTROL DIVISION 48 HOURS PRIOR TO START OF CONSTRUCTION ACTIVITY

DAY 1	OBTAIN GRADING PERMIT	DAY 71-83	BEGIN INSTALLATION OF PROPOSED UTILITIES AND BRING PROP. ROADWAY TO SUBGRADE UP TO STA. 3+77.81 AND THE INTO EX. DRIVEWAY
DAY 2-5	INSTALL CONSTRUCTION ENTRANCE; CLEAR & GRUB FOR PERIMETER SEDIMENT CONTROL DEVICES	DAY 84-103	UPON APPROVAL OF HOWARD COUNTY SEDIMENT CONTROL INSPECTOR, FINISH UTILITY AND STORM DRAIN INSTALLATION.
DAY 6-15	INSTALL PERIMETER SEDIMENT CONTROL DEVICES, UTILITY AND STORM DRAINS. TEMPORARY STABILIZATION SHALL BE COMPLETED WITHIN: A) 7 CALENDAR DAYS FOR ALL PERIMETER SEDIMENT CONTROL STRUCTURES, DIKES, PERIMETER SLOPES AND ALL SLOPES GREATER THAN 3:1, B) 14 DAYS AS TO ALL OTHER DISTURBED OR GRADED AREAS ON THE PROJECT SITE.	DAY 104-105	STABILIZE SITE IN ACCORDANCE WITH TEMPORARY SEEDBED NOTES.
DAY 16-20	TEST PIT AREA OF EXISTING UTILITY CONNECTIONS TO DETERMINE EXACT LOCATIONS AND ELEVATIONS; RAZE EXISTING STRUCTURES.	DAY 106-120	BRING REMAINING ROADWAY TO SUBGRADE AND FINISH INSTALLING BASE COURSE PAVING.
DAY 21-22	TIE INTO EX. WATER MAIN AND PROVIDE TEMPORARY WHO'S AS SPECIFIED UNDER CONTR. #14-4481-D	DAY 121-125	FINAL GRADE REMAINDER OF SITE AND STABILIZE IN ACCORDANCE WITH PERMANENT SEEDING NOTES.
DAY 23-35	INSTALL STORM DRAIN PIPES AND STRUCTURES FROM EX. SHA 1-1001 TO PROP. I-9. RAISE EX. SHA INLET 1-1001 AND CONSTRUCT RETAINING WALL AT SITE ENTRANCE. ADJUST EX. SHA SWALE AS REQUIRED AND TEMPORARILY STABILIZE AFFECTED AREAS. THESE ACTIVITIES TO OCCUR WITHIN A FIVE(5) DAY CLEAR WEATHER (NO PRECIPITATION). FORECAST BY THE NATIONAL WEATHER SERVICE (NWS).	DAY 126-130	UPON APPROVAL FROM HO. CO. CID, REMOVE TEMPORARY UTILITY CONNECTIONS AND BEGIN SERVICE TO AFFECTED PARCELS/LOTS
DAY 36-50	UPON APPROVAL OF HOWARD COUNTY SEDIMENT CONTROL INSPECTOR, CLEAR & GRUB REMAINDER OF SITE	DAY 131-140	INSTALL REQUIRED LANDSCAPING AS SPECIFIED ON THESE PLANS.
DAY 51-70	UPON APPROVAL OF HOWARD COUNTY SEDIMENT CONTROL INSPECTOR, BEGIN MASS GRADING OF THE SITE. INSTALL PIPE CURVE DRAWS. GRADED AREA OF 14 IS TO BE IMMEDIATELY STABILIZED WITH SOD.	DAY 141-185	UPON APPROVAL OF HOWARD COUNTY SEDIMENT CONTROL INSPECTOR, FILL IN SEDIMENT TRAPS. 1. INSTALL REMAINING SWMF APPURTENANCES AND PERMANENTLY STABILIZE SLOPES; 2. INSTALL MICRO-DRAINAGE FACILITIES
		DAY 186-192	UPON APPROVAL OF HOWARD COUNTY SEDIMENT CONTROL INSPECTOR, REMOVE REMAINING SEDIMENT CONTROL DEVICES AND PERMANENTLY STABILIZE ANY REMAINING DISTURBED AREAS.

21.0 STANDARD AND SPECIFICATIONS FOR TOPSOIL

Definition

Placement of topsoil over a prepared subsoil prior to establishment of permanent vegetation.

Purpose

To provide a suitable medium for vegetative growth. Soils of concern have low moisture content, low nutrient levels, low pH, materials toxic to plants, and/or unacceptable soil gradation.

Conditions Where Practice Applies

This practice is limited to areas having 2:1 or flatter slopes where:

- The texture of the exposed subsoil/parent material is not adequate to produce vegetative growth.
- The soil material is so shallow that the rooting zone is not deep enough to support plants or furnish continuing supplies of moisture and plant nutrients.
- The original soil to be vegetated contains material toxic to plant growth.
- The soil is so acidic that treatment with limestone is not feasible. If, for the purpose of these Standards and Specifications, areas having slopes steeper than 2:1 require special consideration and design for adequate stabilization. Areas having slopes steeper than 2:1 shall have the appropriate stabilization shown on the plans.

Construction and Material Specifications

I. Topsoil salvaged from the existing site may be used provided that it meets the standards as set forth in these specifications. Typically, the depth of topsoil to be salvaged for a given soil type can be found in the representative soil profile section in the Soil Survey published by USDA-SCS in cooperation with Maryland Agricultural Experimental Station.

II. Topsoil Specifications - Soil to be used as topsoil must meet the following:

- Topsoil shall be a loam, sandy loam, clay loam, silt loam, sandy clay loamy loamy sand. Other soils may be used if recommended by an agronomist or soil scientist and approved by the appropriate approval authority. Regardless, topsoil shall not be a mixture of contrasting textured subsoils and shall contain less than 5% by volume of cinders, stones, slag, coarse fragments, gravel, sticks, roots, trash, or other materials larger than 1 1/2" in diameter.
- Topsoil must be free of plants or plant parts such as Bermuda grass, quack grass, Johnson grass, nutsedge, poison ivy, thistle, or others as specified.

III. Where the subsoil is either highly acidic or composed of heavy clays, ground limestone shall be spread at the rate of 4-8 tons/acre (200-400 pounds per 1,000 square feet) prior to the placement of topsoil. Lime shall be distributed uniformly over designated areas and worked into the soil in conjunction with tillage operations as described in the following procedures.

III. For sites having disturbed areas under 5 acres:

- Place topsoil (if required) and apply soil amendments as specified in 20.0 Vegetative Stabilization - Section I - Vegetative Stabilization Methods and Materials.

IV. For sites having disturbed areas over 5 acres:

- On soil meeting topsoil specifications, obtain test results dictating fertilizer and lime amendments required to bring the soil into compliance with the following:
 - pH for topsoil shall be between 6.0 and 7.5. If the tested soil demonstrates a pH of less than 6.0, sufficient lime shall be prescribed to raise the pH to 6.5 or higher.
 - Organic content of topsoil shall be not less than 1.5 percent by weight.
 - Topsoil having soluble salt content greater than 500 parts per million shall not be used.
 - No sod or seed shall be placed on soil which has been treated with soil sterilants or chemicals used for weed control until sufficient time has elapsed (14 days min.) to permit dissipation of phytotoxic materials.

Note: Topsoil substitutes or amendments, as recommended by a qualified agronomist or soil scientist and approved by the appropriate approval authority, may be used in lieu of natural topsoil.

II. Place topsoil (if required) and apply soil amendments as specified in 20.0 Vegetative Stabilization - Section I - Vegetative Stabilization Methods and Materials.

V. Topsoil Application

- When topsoiling, maintain needed erosion and sediment control practices such as diversion, Grade Stabilization Structures, Earth Dikes, Slope Silt Fence and Sediment Traps and Basins.
- Grades on the areas to be topsoiled, which have been previously established, shall be maintained, about 4" - 8" higher in elevation.

III. Topsoil shall be uniformly distributed in a 4" - 8" layer and lightly compacted to a minimum thickness of 4". Spreading shall be performed in such a manner that sodding or seeding can proceed with a minimum of additional preparation and tillage. Any irregularities in the surface resulting from topsoiling or other operations shall be corrected in order to prevent the formation of depressions or water pockets.


IV. Topsoil shall not be placed while the topsoil or subsoil is in a frozen or muddy condition, when the subsoil is excessively wet or in a condition that may otherwise be detrimental to proper grading and seedbed preparation. G-21-2

V. Alternative for Permanent Seeding - Instead of applying the full amounts of lime and commercial fertilizer, composted sludge and amendments may be applied as specified below:

- Composted Sludge Material for use as a soil conditioner for sites having disturbed areas over 5 acres shall be tested to prescribed amendments and for sites having disturbed areas under 5 acres shall conform to the following requirements:
 - Composted sludge shall be supplied by, or originate from, a person or persons that are permitted (at the time of acquisition of the compost) by the Maryland Department of the Environment under COMAR 26.04.06.
 - Composted sludge shall contain at least 1 percent nitrogen, 1.5 percent phosphorus, and 0.2 percent potassium and have a pH of 7.0 to 8.0. If compost does not meet these requirements, the appropriate constituents must be added to meet the requirements prior to use.
 - Composted sludge shall be applied at a rate of 1 ton/1,000 square feet.
- Composted sludge shall be amended with a potassium fertilizer applied at the rate of 4 lb/1,000 square feet, and 1/3 the normal lime application rate.

References: Guideline Specifications, Soil Preparation and Sodding. MD-VA, Pub. #1, Cooperative Extension Service, University of Maryland and Virginia Polytechnic Institutes. Revised 1973.


SILT FENCE DIVERSION

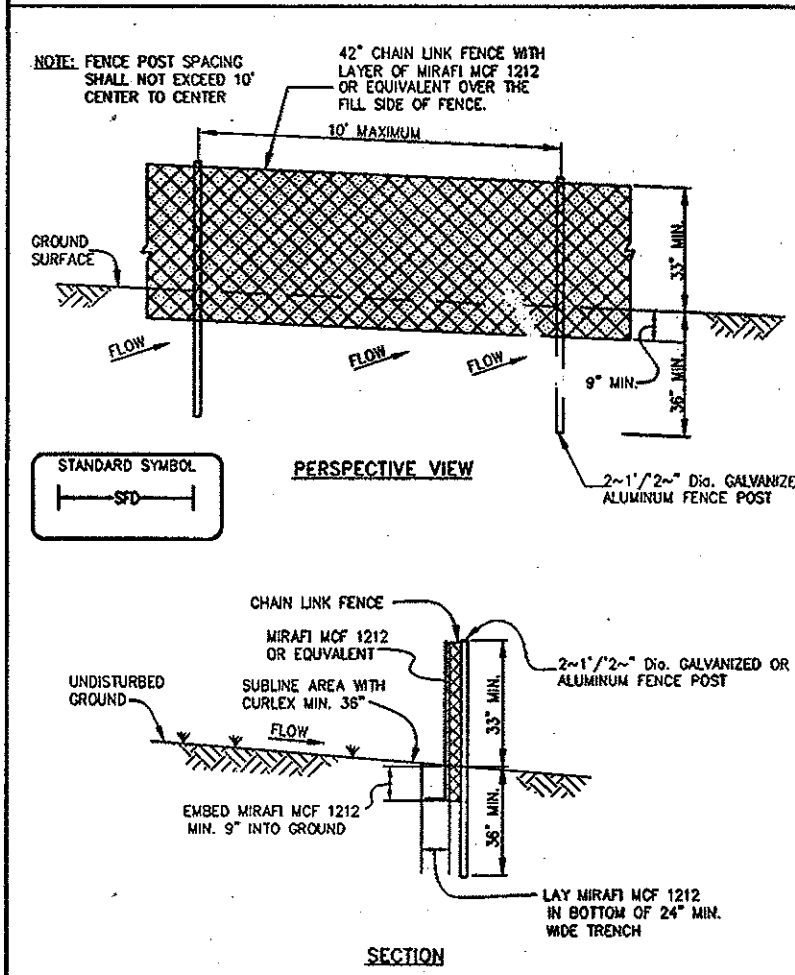

SILT FENCE DIVERSION

- Fencing shall be 42" in height and constructed in accordance with the latest Maryland State Highway Details 690.01 & 690.02 for Chain Link Fencing. The specification for the fabric shall be 42" fabric and 8" length posts. Posts shall be placed without concrete embedment.
- Chain link fence shall be fastened securely to the fence posts with wire ties. The lower tension wire, brace and truss rods, drive anchors and post caps are not required except on the ends of the fence.
- Diversion cloth shall be fastened securely to the chain link fence with ties spaced every 24" of the top and mid section.
- Diversion cloth shall be embedded a minimum of 9" into the ground.
- When two sections of diversion cloth adjoin each other, they shall be overlapped by 6" and folded.
- Maintenance shall be performed as needed.

DETAIL 33 - SUPER SILT FENCE

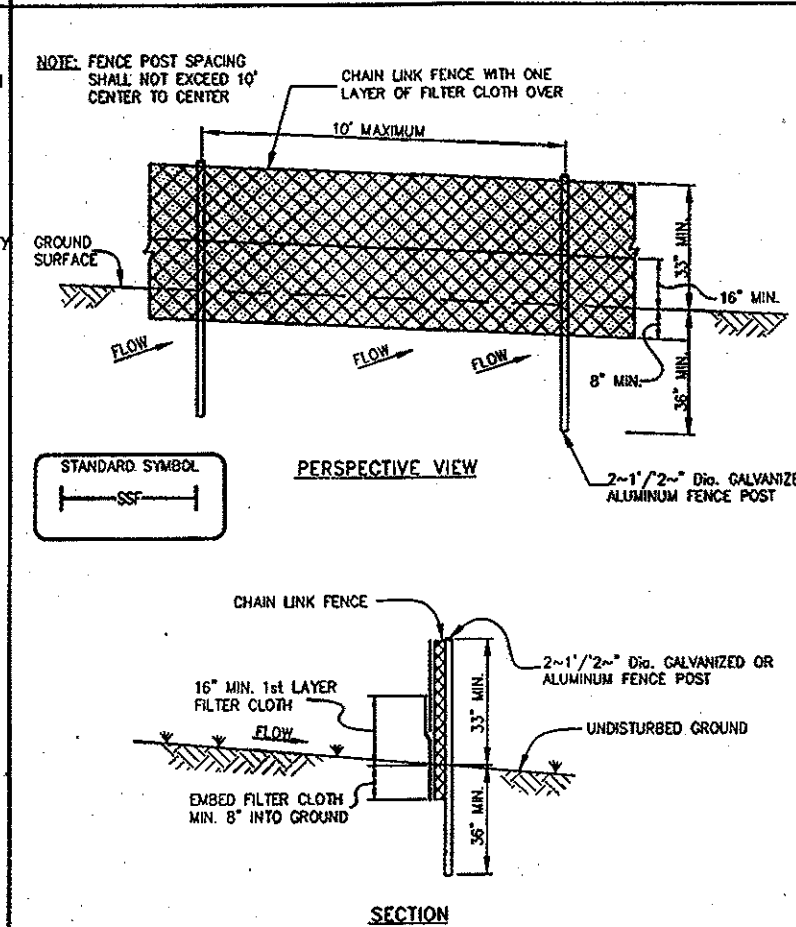

SUPER SILT FENCE


- Fencing shall be 42" in height and constructed in accordance with the latest Maryland State Highway Details for Chain Link Fencing. The specification for a 6" fence shall be used, substituting 42" fabric and 8" length posts.
- Chain link fence shall be fastened securely to the fence posts with wire ties. The lower tension wire, brace and truss rods, drive anchors and post caps are not required except on the ends of the fence.
- Filter cloth shall be fastened securely to the chain link fence with ties spaced every 24" of the top and mid section.
- Filter cloth shall be embedded a minimum of 9" into the ground.
- When two sections of filter cloth adjoin each other, they shall be overlapped by 6" and folded.
- Maintenance shall be performed as needed and all buildups removed when "bulges" develop in the silt fence, or when silt reaches 20% of fence height.
- Filter cloth shall be fastened securely to each fence post with wire ties or staples at top and mid section and shall meet the following requirements for Geotextile Class F:

Tensile Strength	50 lb/in (min.)	Test: MSMT 509
Tensile Modulus	20 lb/in (min.)	Test: MSMT 509
Flow Rate	0.5 gal/min (max.)	Test: MSMT 322
Filtering Efficiency	75% (min.)	Test: MSMT 322

SUPER SILT FENCE DESIGN CRITERIA


Slope Steepness	Slope Length (Maximum)	Silt Fence Length (Maximum)
0 - 10%	0 - 10:1	Unlimited
10 - 20%	10:1 - 5:1	1,500 feet
20 - 33%	5:1 - 3:1	1,000 feet
33 - 50%	3:1 - 2:1	500 feet
50% +	2:1 +	250 feet

DETAIL 24 - STABILIZED CONSTRUCTION ENTRANCE

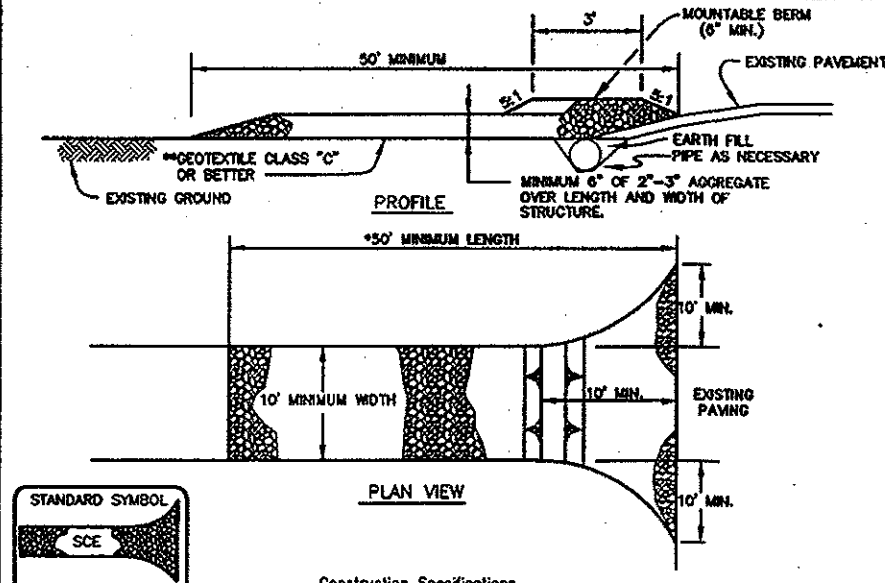


- Length - minimum of 50' (30' for single residence lots).
- Width - 10' minimum, shall be fixed at the existing road to provide a turning radius.
- Geotextile fabric (filter cloth) shall be placed over the existing ground prior to grading slope. The plan approval authority may not require single family residences to use geotextile.
- Slope - finished aggregate (2" to 3") or reinforced or recycled concrete equivalent shall be placed at least 6" deep over the length and width of the entrance.
- Location - A stabilized construction entrance shall be located at every spot where construction traffic enters or leaves a construction site. Vehicles leaving the site must leave over the entire length of the stabilized construction entrance.

DETAIL 23C - CURB INLET PROTECTION (CDS OR CDS INLETS)

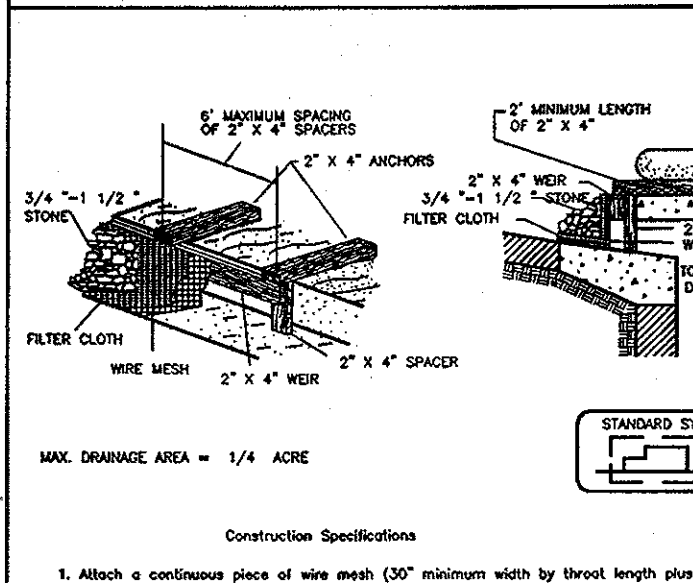


- Attach a continuous piece of wire mesh (50" minimum width by throat length 4") to the 2" x 4" curb (overlapped throat length 2") as shown on the standard drawing.
- Place a continuous piece of Geotextile Class E of the same dimensions as the wire mesh over the wire mesh and securely attach it to the 2" x 4" curb.
- Securely nail the 2" x 4" curb to a 6" long vertical spacer to be located between the curb and the filter cloth.
- Place the Geotextile Class E tightly over the wire mesh and the 2" x 4" curb to the top of the curb at the curb locations. These 2" x 4" anchors shall extend across the curb and be held in place by sandbags or alternate weights.
- The assembly shall be placed to the curb and spaced on a minimum 1' beyond both ends of the throat opening.
- From the 1/2" x 1/2" wire mesh and the geotextile fabric to the concrete curb and against the base of the curb on both sides of the curb. Place clean 3/4" x 1/2" gravel over the wire mesh and geotextile in such a manner to prevent water from entering the inlet under the curb.
- The type of protection must be inspected frequently and the filter cloth and stone replaced when clogged with sediment.
- Ensure that storm line does not bypass the inlet by installing a temporary earth or asphalt dike to direct the flow to the inlet.

DETAIL 23A - STANDARD INLET PROTECTION

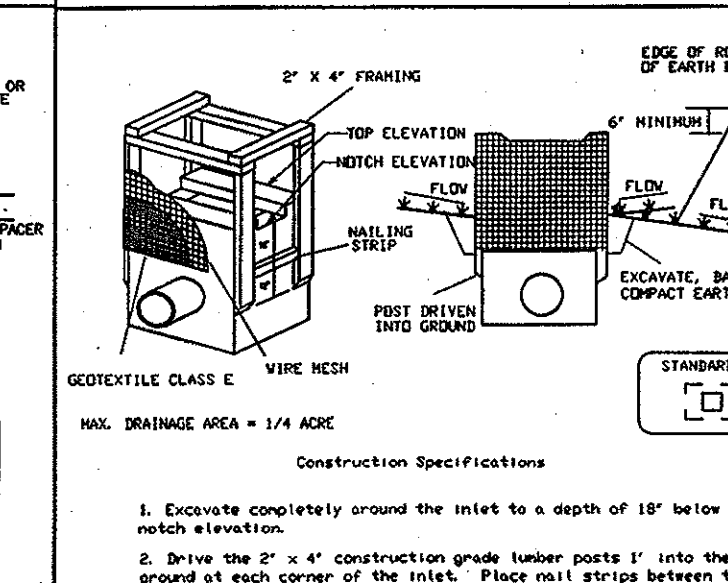

- Excavate completely around the inlet to a depth of 18" below the curb elevation.
- Drive the 2" x 4" construction grade timber posts 1' into the ground at each corner of the inlet. Place nail strips between the posts on the ends of the inlet. Assemble the top portion of the 2" x 4" frame using the over-top joint shown on detail 23A. The top of the frame must be 6" below adjacent roadway frame. Flooding and safety issues may arise.
- Stretch the 1/2" x 1/2" wire mesh tightly around the frame and fasten securely. The ends must meet and overlap at a post.
- Stretch the Geotextile Class E tightly over the wire mesh with the geotextile extending from the top of the frame to 18" below the inlet curb. The geotextile must be fastened to the frame at the ends. The ends of the geotextile must meet at a post, be overlapped and folded, then fastened down.
- Backfill around the inlet in compacted 6" layers until the layer of earth is level with the curb elevation on the ends and top elevation on the inlet.
- If the inlet is not in a slump, construct a compacted earth dike across the ditch line directly below it. The top of the earth dike should be at least 6" higher than the top of the frame.
- The structure must be inspected periodically and after each rain and the geotextile replaced when it becomes clogged.

DETAIL 23B - AT GRADE INLET PROTECTION

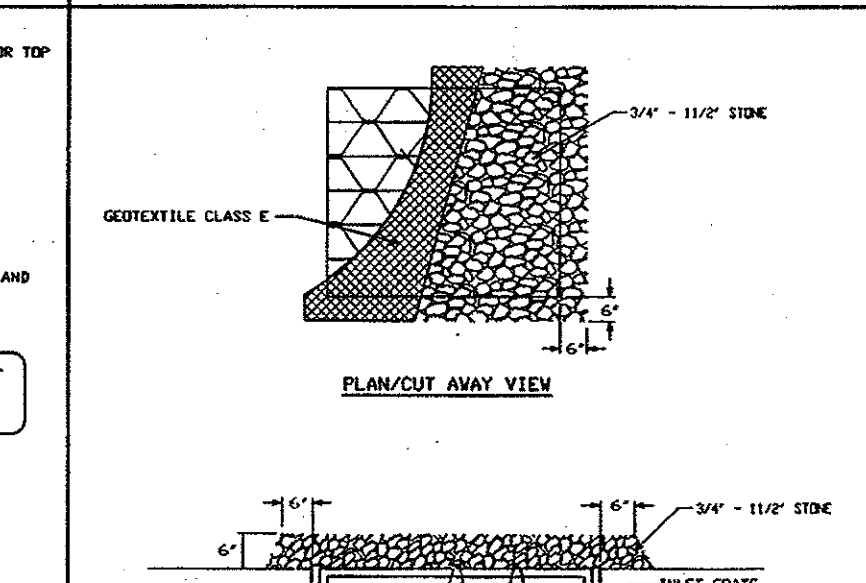

- Lift grate and wrap with Geotextile Class E to completely cover all openings. Then set grate back in place.
- Place 3/4" x 1 1/2" stone, 4" x 6" thick on the grate to secure the fabric and provide additional filtration.

THIS DEVELOPMENT PLAN IS APPROVED FOR SOIL EROSION AND SEDIMENT CONTROL BY THE HOWARD SOIL CONSERVATION DISTRICT

HOWARD SOIL CONSERVATION DISTRICT DATE

ALL PERIMETER SEDIMENT & EROSION CONTROL FEATURES ARE TO BE INSTALLED AT THE LIMIT OF DISTURBANCE

ALL SEDIMENT & EROSION CONTROL FEATURES ARE TO BE REPAIRED IMMEDIATELY IF DISRUPTED BY UTILITY INSTALLATION

SUPER SILT FENCE IS TO BE INSPECTED FREQUENTLY & CLEANED, REPAIRED AND/OR RE-INSTALLED IMMEDIATELY AS NECESSARY

SEDIMENT CONTROL LOCATION AND IMPLEMENTATION SHOWN ON THIS PLAN IS SUBJECT TO REVISIONS IN THE FIELD AT THE DISCRETION OF THE SEDIMENT CONTROL INSPECTOR

ALL SEDIMENT CONTROL FEATURES SHALL BE INSTALLED IN ACCORDANCE WITH STANDARD DETAILS SHOWN IN THE 1994 MARYLAND STANDARDS AND SPECIFICATIONS FOR SOIL EROSION AND SEDIMENT CONTROL.

BY THE OWNER/DEVELOPER:

I, THE SIGNER, CERTIFY THAT ALL DEVELOPMENT AND/OR CONSTRUCTION WILL BE DONE ACCORDING TO THESE PLANS, AND THAT ANY RESPONSIBLE PERSONNEL INVOLVED IN THE CONSTRUCTION PROJECT WILL HAVE A CERTIFICATE OF ATTENDANCE AT A DEPARTMENT OF THE ENVIRONMENT APPROVED TRAINING PROGRAM FOR THE CONTROL OF SEDIMENT AND EROSION BEFORE BEGINNING THE PROJECT. I SHALL ENGAGE A REGISTERED PROFESSIONAL ENGINEER TO SUPERVISE POND CONSTRUCTION AND PROVIDE THE HOWARD SOIL CONSERVATION DISTRICT WITH AN "AS-BUILT" PLAN OF THE POND WITHIN 30 DAYS OF COMPLETION. I ALSO AUTHORIZE PERIODIC ON-SITE INSPECTIONS BY THE HOWARD SOIL CONSERVATION DISTRICT.

SECURITY DEVELOPMENT, LLC
OWNER/DEVELOPER - OWNER'S AGENT
DATE: 3-14-08
STEWART BREECHES James R. Maxley III

BY THE ENGINEER:

I, THE SIGNER, CERTIFY THAT THIS PLAN FOR POND CONSTRUCTION, EROSION AND SEDIMENT CONTROL REPRESENTS A PRACTICAL AND WORKABLE PLAN BASED ON MY PERSONAL KNOWLEDGE OF THE SITE CONDITIONS. THIS PLAN WAS PREPARED IN ACCORDANCE WITH THE REQUIREMENTS OF THE HOWARD SOIL CONSERVATION DISTRICT. I HAVE NOTIFIED THE DEVELOPER THAT HE/SHE MUST ENGAGE A REGISTERED PROFESSIONAL ENGINEER TO SUPERVISE POND CONSTRUCTION AND PROVIDE THE HOWARD SOIL CONSERVATION DISTRICT WITH AN "AS-BUILT" PLAN OF THE POND WITHIN 30 DAYS OF COMPLETION.

Donald Mason
ENGINEER - DONALD A. MASON, P.E. # 21443
DATE: 3-13-08

THIS PLAN IS FOR SEDIMENT AND EROSION CONTROL PURPOSES ONLY

THESE PLANS HAVE BEEN REVIEWED FOR THE HOWARD SOIL CONSERVATION DISTRICT BY THE TECHNICAL REVIEW BOARD FOR SMALL POND CONSTRUCTION, SOIL EROSION AND SEDIMENT CONTROL.

RESOURCES CONSERVATION SERVICE DATE: 3/20/08

APPROVED: HOWARD COUNTY DEPARTMENT OF PUBLIC WORKS
DATE: 3/20/08

APPROVED: HOWARD COUNTY DEPARTMENT OF PLANNING AND ZONING
DATE: 3/20/08

APPROVED: HOWARD COUNTY DEPARTMENT OF PLANNING AND ZONING
DATE: 3/20/08

1 9/13/11 REVISED LAYOUT, STORMWATER MANAGEMENT AND LOT GRADING

NO. DATE REVISION

1 9/13/11 REVISED LAYOUT, STORMWATER MANAGEMENT AND LOT GRADING

1 9/13/11 REVISED LAYOUT, STORMWATER MANAGEMENT AND LOT GRADING


1 9/13/11 REVISED LAYOUT, STORMWATER MANAGEMENT AND LOT GRADING

1 9/13/11 REVISED LAYOUT, STORMWATER MANAGEMENT AND LOT GRADING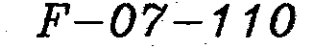

HORIZONTAL SCALE: 1" = 50'
VERTICAL SCALE: 1" = 5'

FRONT VIEW

SIDE VIEW (TYP.)

~~TOP VIEW~~

ATL

SCALE: 1"=2'

- NOTES:
1. TRASH RACKS SHALL BE GALVANIZED AFTER FABRICATION
 2. TRASH RACKS SHALL BE PAINTED BATTLESHIP GRAY.
 3. TRASH RACKS SHALL BE PLACED ON ALL FOUR (4) SIDES OF RISER/OPENINGS
 4. FOR ALL INVERTS, ELEVATIONS, AND LOCATIONS, REFER TO STRUCTURE SCHEDULE

SECTION B-B

TYPICAL SECTION
GRAVEL OUTFALL CHANNEL

SECTION A-A

PLAN - BELOW SLAB

ANCHOR DETAIL
FOR VALVE STEEL

PROFILE DETAIL
FOREBAY WEIR

TYPE A-2
CONCRETE CRADLE
NOT TO SCALE

PROFILE ALONG C/L FOREBAY DAM

HORIZONTAL SCALE: 1" = 50'
VERTICAL SCALE: 1" = 5'

NOTES:

1. IF WATER IS ENCOUNTERED DURING THE CONSTRUCTION OF THE CORE TRENCH, IT IS TO BE REMOVED BY PUMPING.
2. CORE TRENCH SHALL CONSIST OF IMPERVIOUS MATERIAL (GC, SC, CL, CH) AS DIRECTED BY A GEOTECHNICAL ENGINEER ONSITE AND MAY REQUIRE TO BE HAULED FROM AN OFFSITE LOCATION.

COLLAR SIZE: 8'-10"L x 7'-8.5"H x 6"W
ANTI-SEEP COLLAR
NOT TO SCALE

NOTE: UPON CONVERSION TO A PERMANENT SWMF THE 6" PVC DEWATERING PIPE SHALL BE CUT TO PERMANENT POOL ELEVATION; INFLOW SHALL BE REPLACED WITH 6" PERFORATED PVC AND INTERIOR CAP REMOVED


THIS PRACTICE CONFORMS TO MDE DETAIL C-10-3


NOTE: UPON CONVERSION TO A PERMANENT SWMF THE 6" PVC DEWATERING PIPE SHALL BE CUT TO PERMANENT POOL ELEVATION; INFLOW SHALL BE REPLACED WITH 6" PERFORATED PVC AND INTERIOR CAP REMOVED

THIS PRACTICE CONFORMS TO MDE DETAIL C-10-30


6" DEWATERING PIPE DETAIL AND
PERMANENT EXTENDED DETENTION CONTROL ORIFIC
NOT TO SCALE

<u>AS-BUILT CERTIFICATION</u> I HEREBY CERTIFY THAT THE FACILITY SHOWN ON THIS PLAN WAS CONSTRUCTED AS SHOWN ON THE "AS-BUILT" PLANS AND MEETS THE APPROVED PLANS AND SPECIFICATIONS. PE NO. <u>21443</u> _____ DONALD A. MASON _____ DATE	
CERTIFY MEANS TO STATE OR DECLARE A PROFESSIONAL OPINION BASED UPON ON-SITE INSPECTIONS AND MATERIAL TESTS WHICH ARE CONDUCTED DURING CONSTRUCTION. THE ON-SITE INSPECTIONS AND MATERIAL TESTS, WHICH THESE INSPECTIONS AND TESTS DEEMED SUFFICIENT AND APPROPRIATE BY COMMONLY ACCEPTED ENGINEERING STANDARDS. CERTIFY DOES NOT MEAN A FULLY A GUARANTEE BY THE ENGINEER NOR DOES AN ENGINEER'S CERTIFICATION RELIEVE ANY OTHER PARTY FROM MEETING REQUIREMENTS IMPOSED BY CONTRACT, EMPLOYMENT, OR OTHER MEANS, INCLUDING MEETING COMMONLY ACCEPTED INDUSTRY PRACTICES.	
BY THE OWNER/DEVELOPER: _____ I/WE CERTIFY THAT ALL DEVELOPMENT AND/OR CONSTRUCTION WILL BE DONE ACCORDING TO THESE PLANS, AND THAT ANY RESPONSIBLE PERSONNEL INVOLVED IN THE CONSTRUCTION PROJECT WILL HAVE A CERTIFICATE OF ATTENDANCE AT DEPARTMENT OF THE ENVIRONMENT APPROVED TRAINING PROGRAM FOR THE CONTROL OF SEDIMENT AND EROSION BEFORE BEGINNING THE PROJECT. I SHALL ENGAGE A REGISTERED PROFESSIONAL ENGINEER TO SUPERVISE POND CONSTRUCTION AND PROVIDE THE HOWARD SOIL CONSERVATION DISTRICT WITH AN "AS-BUILT" PLAN OF THE POND WITHIN 30 DAYS OF COMPLETION. I ALSO AUTHORIZE PERIODIC ON-SITE INSPECTIONS BY THE HOWARD SOIL CONSERVATION DISTRICT. <u>STEVEN BREASON DEVELOPMENT LLC</u> <u>James R. Masley, PE</u> 3-14-08 OWNER/DEVELOPER <u>STEVEN BREASON</u> Member DATE: _____ <u>James R. Masley, III</u>	
BY THE ENGINEER: _____ I/WE CERTIFY THAT THIS PLAN FOR POND CONSTRUCTION, EROSION AND SEDIMENT CONTROL, REPRESENTS A PRACTICAL AND WORKABLE PLAN BASED ON MY PERSONAL KNOWLEDGE OF THE SITE CONDITIONS. THIS PLAN WAS PREPARED IN ACCORDANCE WITH THE REQUIREMENTS OF THE HOWARD SOIL CONSERVATION DISTRICT. I HAVE NOTIFIED THE DEVELOPER THAT HE/SHE MUST ENGAGE A REGISTERED PROFESSIONAL ENGINEER TO SUPERVISE POND CONSTRUCTION AND PROVIDE THE HOWARD SOIL CONSERVATION DISTRICT WITH AN "AS-BUILT" PLAN OF THE POND WITHIN 30 DAYS OF COMPLETION. <u>Donald A. Mason</u> 3/13/08 ENGINEER - DONALD A. MASON, P.E. # 21443 DATE _____	
THIS PLAN HAS BEEN REVIEWED FOR THE HOWARD SOIL CONSERVATION DISTRICT'S EROSION AND SEDIMENT CONTROL TECHNICAL REQUIREMENTS FOR SMALL POND CONSTRUCTION. SOIL EROSION AND SEDIMENT CONTROL USE THE FOLLOWING RESOURCES CONSTRUCTION SERVICE	
_____ THESE PLANS FOR SMALL POND CONSTRUCTION, SOIL EROSION, AND SEDIMENT CONTROL MEET THE REQUIREMENTS OF THE HOWARD SOIL CONSERVATION DISTRICT. <u>Jeffrey S. Lee</u> 3/22/08 HOWARD SOIL CONSERVATION DISTRICT DATE _____	
APPROVED: DEPARTMENT OF PUBLIC WORKS <u>Walter A. Masley, Jr.</u> 5-5-08 CHIEF, BUREAU OF HIGHWAYS DATE _____	
APPROVED: DEPARTMENT OF PLANNING AND ZONING <u>Carly Hamilton</u> 5/8/08 CHIEF, DIVISION OF LAND DEVELOPMENT DATE _____ 63 <u>5/11/08</u> CHIEF, DEVELOPMENT ENGINEERING DIVISION DATE _____	

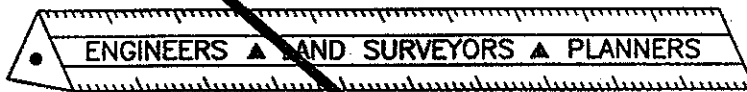NO.		DATE		REVISION	
BENCHMARK  ENGINEERING, INC. 8480 BALTIMORE NATIONAL PIKE ▲ SUITE 418 ELLICOTT CITY, MARYLAND 21043 PHONE: 410-465-8105 FAX: 410-465-6644 E-MAIL: bei@bei-civilengineering.com					
DEVELOPER/CONTRACT PURCHASER: SECURITY DEVELOPMENT, L.L.C. P.O. BOX 417 ELLICOTT CITY, MARYLAND 21041 PHONE: (410) 465-4244				PROJECT: HAWES PROPERTY SUBDIVISION (RE-SUBDIVISION OF LOT 2) LOTS 1 & 5-10 AND O.S. LOTS 3 & 4 LOCATION: TAX MAP 24 - GRID 17 PARCEL 253 - ZONE: R-20 2nd ELECTION DISTRICT HOWARD COUNTY, MARYLAND	
TITLE: FINAL/CONSTRUCTION PLAN STORMWATER MANAGEMENT PROFILES, NOTES, AND DETAILS				DATE: DECEMBER 20, 2006 PROJECT NO. 1574	
Des: DMR/DAM	Draft: MCR	Check: DAM	SCALE: AS SHOWN	DRAWING <u>1</u> OF <u>16</u>	

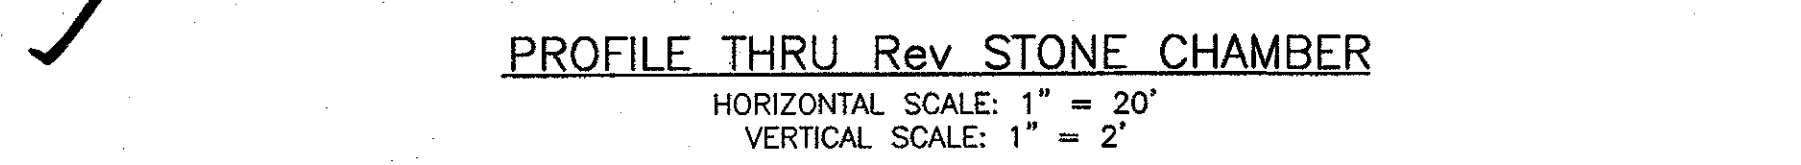

BORING NO.	DEPTH OF TEST	MEASURED RATE (IN./HR.)
B-1	7.0'	0.1875
B-2	17.0'	0.25
B-3	18.0'	0.0625
B-4	9.0'	0.125
B-5	11.0'	0.25
B-6	13.0'	0.3125
B-7	9.0'	0.1875

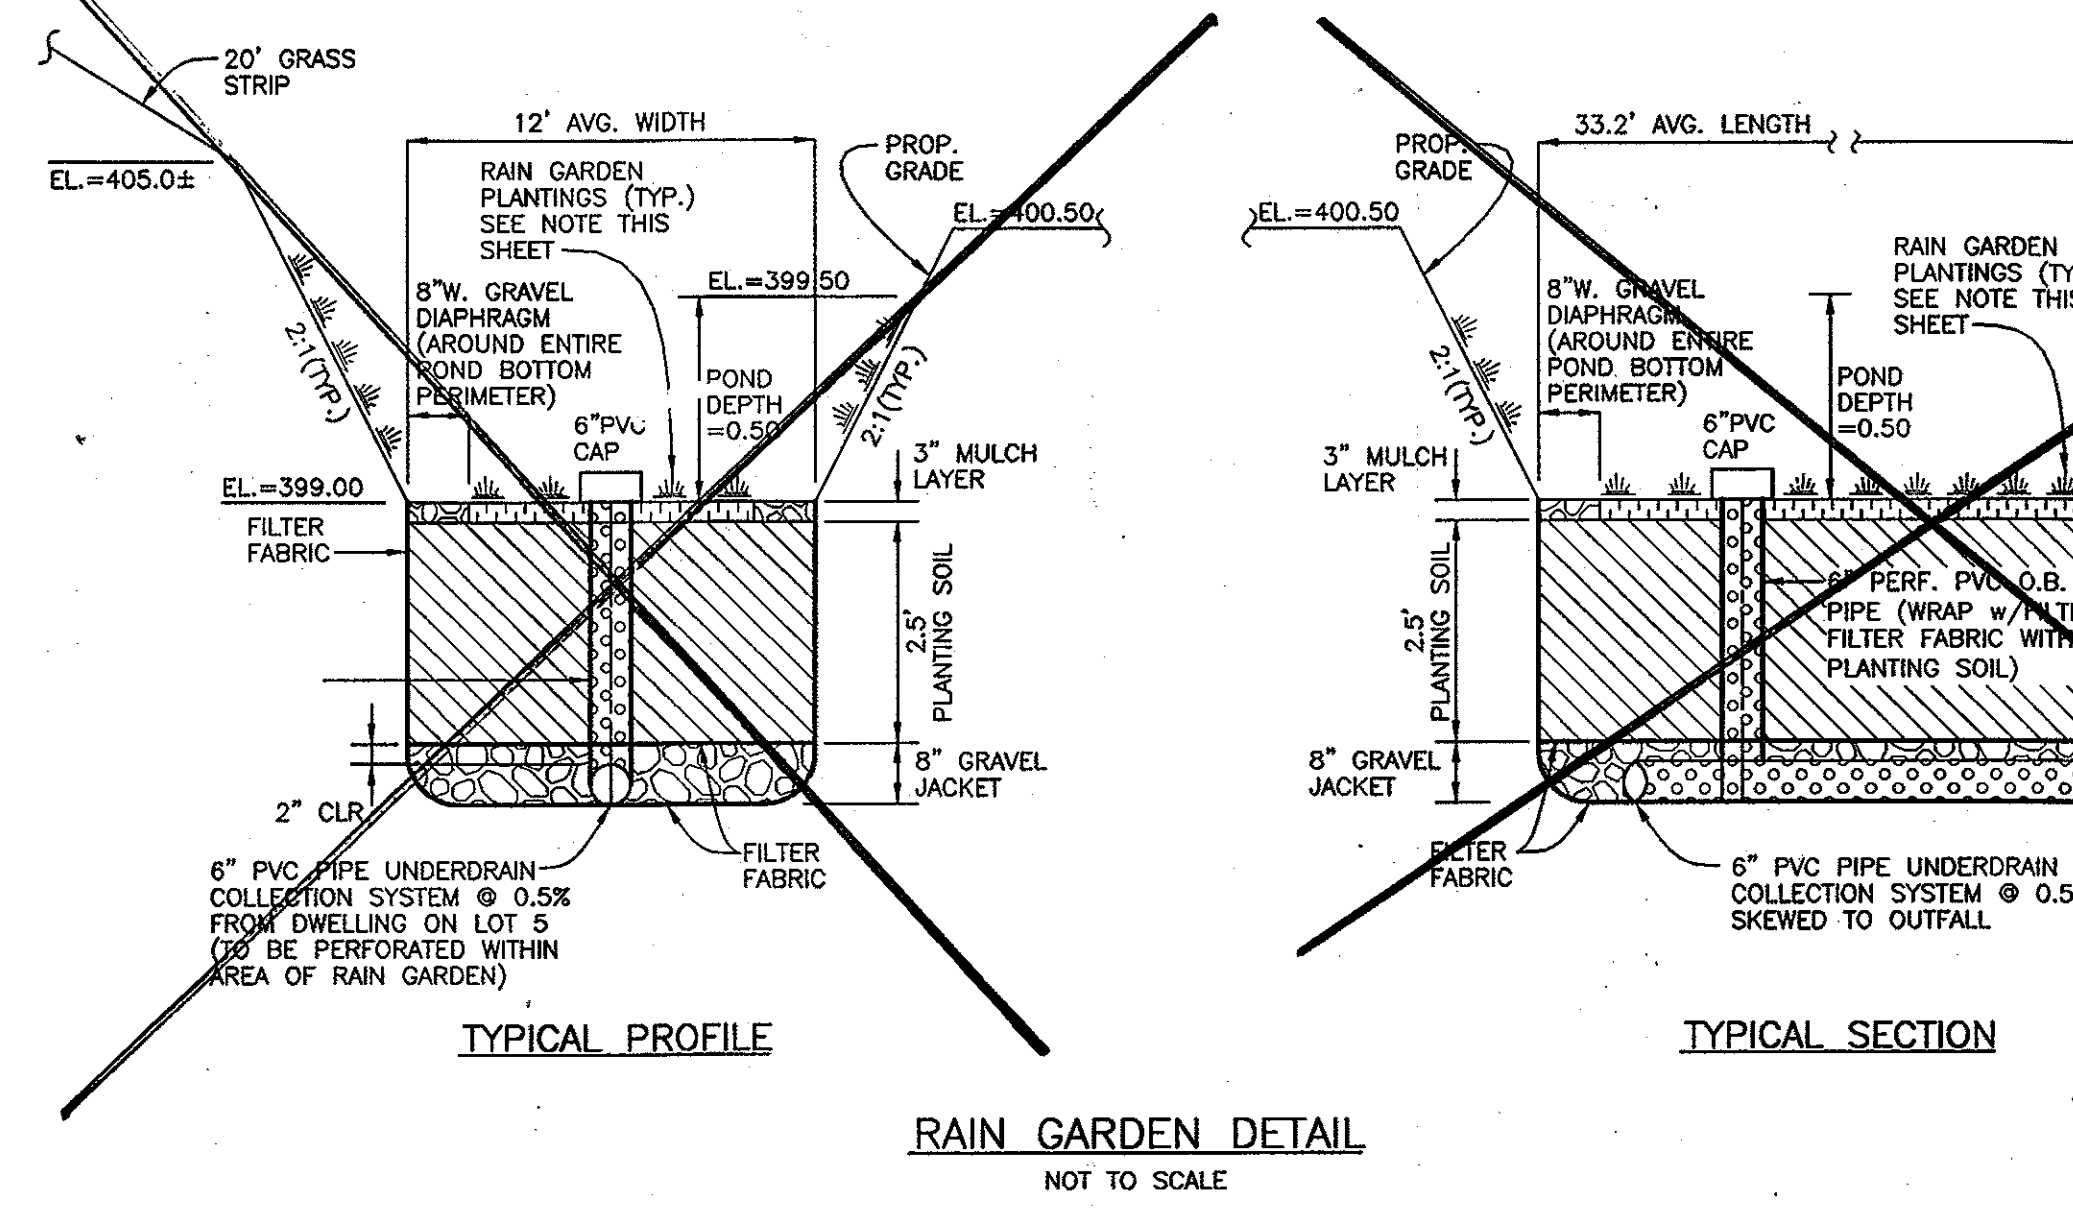

MATERIALS AND SPECIFICATIONS FOR RAIN GARDEN			
MATERIAL	SPECIFICATION	SIZE	NOTES:
PLANTINGS	SEE APPENDIX A, TABLE A.4	N/A	PLANTINGS ARE SITE SPECIFIC
PLANTING SOIL (2.5' TO 4.0' DEEP)	SAND: 30-60% SILT: 30-55% CLAY: 0-25%	N/A	USDA SOIL TYPE: LOAMY SAND, SANDY LOAM OR LOAM
MULCH	SHREDDED HARDWOOD	N/A	AGED 6 MONTHS MINIMUM
GEOTEXTILE (CLASS "C")	APPARENT OPENING SIZE: (ASTM D-4751) GRAB TENSILE STRENGTH: (ASTM D-4632) PUNCTURE RESISTANCE: (ASTM D-4833)	N/A	FOR USE AS NECESSARY BENEATH UNDERDRAINS ONLY
UNDERDRAIN GRAVEL	AASHTO M-43	0.375" TO 0.750"	
UNDERDRAIN PIPING	F758, TYPE PS28 OR AASHTO M-278	4" TO 6" RIGID SCH.40 PVC, SDR35 OR HOPE	3/8" PERF. @ 6" O/C, 4 HOLES PER ROW; MINIMUM OF 3" OF GRAVEL OVER PIPES, NOT NECESSARY UNDERNEATH PIPES

1. ANNUAL MAINTENANCE OF PLANT MATERIAL AND MULCH LAYER IS REQUIRED. MAINTENANCE OF MULCH IS LIMITED TO CORRECTING AREAS OF EROSION OR WASH-OUT. ANY REPLACEMENT OF MULCH SHALL BE DONE IN THE SPRING. PLANT MATERIAL SHALL BE CHECKED FOR DISEASE & INSECT INFESTATION AND MAINTENANCE WILL ADDRESS DEAD MATERIAL & PRUNING.
2. SCHEDULE OF PLANT INSPECTION WILL BE TWICE A YEAR IN THE SPRING AND FALL. THIS INSPECTION WILL INCLUDE REMOVAL OF DEAD DISEASED VEGETATION CONSIDERED BEYOND TREATMENT; TREATMENT OF ALL DISEASED TREES & SHRUBS; AND REPLACEMENT OF ALL DEFICIENT STAKES & WIRES.
3. MULCH SHALL BE INSPECTED EACH SPRING. REMOVE THE PREVIOUS MULCH LAYER BEFORE APPLYING NEW LAYER ONCE EVERY 2 TO 3 YEARS.
4. SOIL EROSION TO BE ADDRESSED ON AN AS-NEEDED BASIS, WITH A MINIMUM OF ONCE PER MONTH AND AFTER HEAVY STORM EVENTS.

GARDEN — PLANTING SCHEDULE	
VINCA MINOR (COMMON PERIWINKLE)	34
AJUSTA REPTAN S (CRESPING BUGLEWEED)	30
IRIS VERSICOLOR (IRIS)	16
HEMEROCALLIS SP (DAYLILY)	10
ACER RUBRUM (RED MAPLE)	2

APPROVED: HOWARD COUNTY DEPARTMENT OF PUBLIC WORKS

Walter F. Minkley 5-5-08

CHIEF, BUREAU OF HIGHWAYS DATE:

APPROVED: HOWARD COUNTY DEPARTMENT OF PLANNING AND ZONING

Cindy Hamer 5/8/08

CHIEF, DIVISION OF LAND DEVELOPMENT DATE:

[Signature] 5/9/08

CHIEF, DEVELOPMENT ENGINEERING DIVISION DATE:

[illegible]

1	9/13/11	REVISED LOT LAYOUT, STORMWATER MANAGEMENT, AND LOT GRADING
NO.	DATE	REVISION

BENCHMARK

ENGINEERS ▲ LAND SURVEYORS ▲ PLANNERS

ENGINEERING, INC.

8480 BALTIMORE NATIONAL PIKE ▲ SUITE 418
 ELLICOTT CITY, MARYLAND 21043
 PHONE: 410-465-6105 FAX: 410-465-6544
 E-MAIL: be1@be1-civilengineering.com

PROFESSIONAL CERTIFICATION:
 I hereby certify that these documents were prepared or approved by me, and that I am a duly licensed professional engineer under the laws of the State of Maryland, License No. 210448, Expiration Date: 12-21-2008



David Alan Laszlo

3-13-08

DEVELOPER/CONTRACT PURCHASER: SECURITY DEVELOPMENT, L.L.C. P.O. BOX 417 ELLICOTT CITY, MARYLAND 21041 PHONE: (410) 465-4244	PROJECT: HAWES PROPERTY SUBDIVISION (RE-SUBDIVISION OF LOT 2) LOTS 1 & 5-10 AND O.S. LOTS 3 & 4		
	LOCATION:	TAX MAP 24 - GRID 17 PARCEL 253 - ZONE: R-20 2nd ELECTION DISTRICT HOWARD COUNTY, MARYLAND	
	TITLE: FINAL/CONSTRUCTION PLAN STORMWATER MANAGEMENT PROFILES, NOTES, AND DETAILS		
	DATE:	DECEMBER 20, 2006 MARCH 14, 2008	PROJECT NO. 1574
Des: MCR/DAM	Draft: MCR	Check: DAM	SCALE: AS SHOWN DRAWING 8 OF 16

HA-10-024 HAWES\10-024 HAWES\DWG\10-024-EGP-AUGUST 2011.DWG

APPROVED: HOWARD COUNTY DEPARTMENT OF PUBLIC WORKS

Walter M. Hall 4-16-12
CHIEF, BUREAU OF HIGHWAYS

APPROVED: HOWARD COUNTY DEPARTMENT OF PLANNING AND ZONING

Chad M. Munn 4/17/12
CHIEF, DEVELOPMENT ENGINEERING DIVISION

Karl S. Landman 4/30/12
CHIEF, DLO

OWNER/DEVELOPER

3804 VIEW TOP, LLC
1055 WEST JOPPA ROAD
APT. 330
TOWSON, MARYLAND 21204
ATTN: RUSSELL HAWES


DRAINAGE AREA SUMMARY

STRUCTURE NUMBER	DRAINAGE AREA (AC)	C FACTOR (10 YEAR)	TIME OF CONC. (MIN)
ES-1	N/A	N/A	10
I-2	0.12	0.24	10
MH-3	1.92**	0.43	10
I-4	1.37	0.23	10
ES-5	N/A	N/A	10
MH-6	N/A	N/A	10
I-7	0.30	0.87	10
I-8	0.18	0.58	10
I-9	0.06	0.68	10
I-10	0.74	0.68	10
ES-11	N/A	0.31	10
I-12	0.07	0.51	10
I-13	0.18	0.33	10

**FLOW FROM LOTS 6 THRU 8, BULK PARCEL 'A', AND THE USE-IN-COMMON DRIVEWAY IS ASSUMED TO ENTER THE SYSTEM AT MH-3 FOR THE PURPOSE OF STORM DRAIN ANALYSIS

NOTE: THIS SHEET IS
FOR DRAINAGE AREA
DELINEATION ONLY

NOTE: THIS SHEET
REPLACES SHEET 9 OF 15
OF THE PREVIOUSLY
APPROVED PLANS
(F-07-110) BY
BENCHMARK ENGINEERING

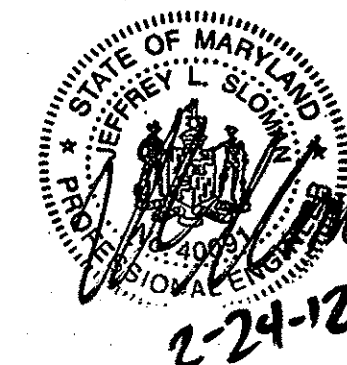

PROFESSIONAL CERTIFICATION

I hereby certify that these documents
were prepared or approved by me, and
that I am a duly licensed professional
engineer under the laws of the State
of Maryland, License No. 40091
Expiration Date 2-13-2013

**MILDENBERG,
BOENDER & ASSOC., INC.**
Engineers Planners Surveyors
6800 Deepwater Road, Suite 150, Elbridge, Maryland 21075
(410) 987-0286 Fax: (410) 987-0288 Fax

HAWES PROPERTY
LOTS 3 THRU 8, O.S. LOT 9, AND NON-BUILDABLE BULK PARCEL 'A'
TAX MAP 24 GRID 17 PARCEL 253
2nd ELECTION DISTRICT
HOWARD COUNTY, MARYLAND
PROPOSED DRAINAGE AREA MAP (STORM DRAIN)

9 OF 16

F-07-110

Project: 10-024
Date: SEP 2011
Illustration: engineering
Scale: 1"=40'
Approval: R/H

Revisions:
11/2/2011
RESPOND TO HOWARD COUNTY COMMENTS
description
revisions
date

10-024 HAWES\10-024 HAWES\DWG\24-EP-AUGUST 2011.DWG

OWNER/DEVELOPER

3804 VIEW TOP, LLC
1055 WEST KOPPA ROAD
APT. 330
TOWSON, MARYLAND 21204
ATTN: RUSSELL HAWES

APPROVED: HOWARD COUNTY DEPARTMENT OF PUBLIC WORKS

Walter J. Mahaffey 4-16-12
CHIEF, BUREAU OF HIGHWAYS DATE

APPROVED: HOWARD COUNTY DEPARTMENT OF PLANNING AND ZONING

Michael J. Mahaffey 4/16/12
CHIEF, DEVELOPMENT ENGINEERING DIVISION DATE

Kurt J. Mahaffey 4/30/12
CHIEF, PLANNING DIVISION DATE


PIPE SCHEDULE

SIZE	LENGTH	TYPE / CLASS
6"	215 LF	HDPE (PERFORATED)
6"	643 LF	HDPE (NON-PERFORATED)
15"	216 LF	HDPE
18"	439 LF	HDPE

STRUCTURE SCHEDULE


STRUCTURE	TYPE	LOCATION	COORDINATES	TOP/RIM/ GRATE EL.	INV. IN	INV. OUT
EW-1	TYPE 'A' HEADWALL		N = 582,611.7856 E = 1,363,214.0246	N/A	371.46	N/A
I-2	PRECAST TYPE 'D' INLET		N = 582,594.2634 E = 1,363,162.2900	378.00 (GRATE)	374.25	374.15
MH-3	PRECAST 4' DIA. MANHOLE		N = 582,354.0465 E = 1,363,165.9681	409.00 (RIM)	394.11	393.96
I-4	PRECAST TYPE 'D' INLET		N = 582,232.7664 E = 1,363,033.3021	399.75 (GRATE)	N/A	395.75
ES-5	END SECTION	VIEW TOP ROAD EXT. STA. 4+98.4, 48.0' R		N/A	399.00	N/A
MH-6	PRECAST 4' DIA. MANHOLE	VIEW TOP ROAD EXT. STA. 5+00.1, 17.5' R		408.00 (RIM)	399.26	399.16
I-7	PRECAST TYPE 'A-5' INLET	VIEW TOP ROAD EXT. STA. 4+35.6, 11.0' R		403.00 (EP)	399.96	399.71
I-8	PRECAST TYPE 'A-5' INLET	VIEW TOP ROAD EXT. STA. 4+36.2, 11.0' L		403.00 (EP)	N/A	400.07
I-9	PRECAST TYPE 'A-5' INLET	VIEW TOP ROAD EXT. STA. 0+96.1, 11.0' R		369.85 (EP)	360.55	356.05
I-10	PRECAST TYPE 'A-5' INLET	VIEW TOP ROAD EXT. STA. 0+93.5, 11.0' L		369.85 (EP)	N/A	362.28
ES-11	END SECTION	VIEW TOP ROAD EXT. STA. 2+82.4, 11.0' R		N/A	383.00	N/A
I-12	PRECAST TYPE 'A-5' INLET	VIEW TOP ROAD EXT. STA. 3+00.0, 11.0' R		380.00 (EP)	386.53	386.28
I-13	PRECAST TYPE 'A-5' INLET	VIEW TOP ROAD EXT. STA. 3+00.0, 11.0' L		380.00 (EP)	N/A	387.85

NOTE: STRUCTURE 'I-9' IS REFERRED TO AS STRUCTURE 'I-6' IN THE PREVIOUSLY HOWARD COUNTY APPROVED PLAN SET (F-07-110). ALL STRUCTURES, STRUCTURE DATA, ETC. DOWNSTREAM FROM STRUCTURE I-9/I-6 TO THE EXISTING SHA INLET WILL NOT CHANGE FROM THE PREVIOUSLY APPROVED PLANS.

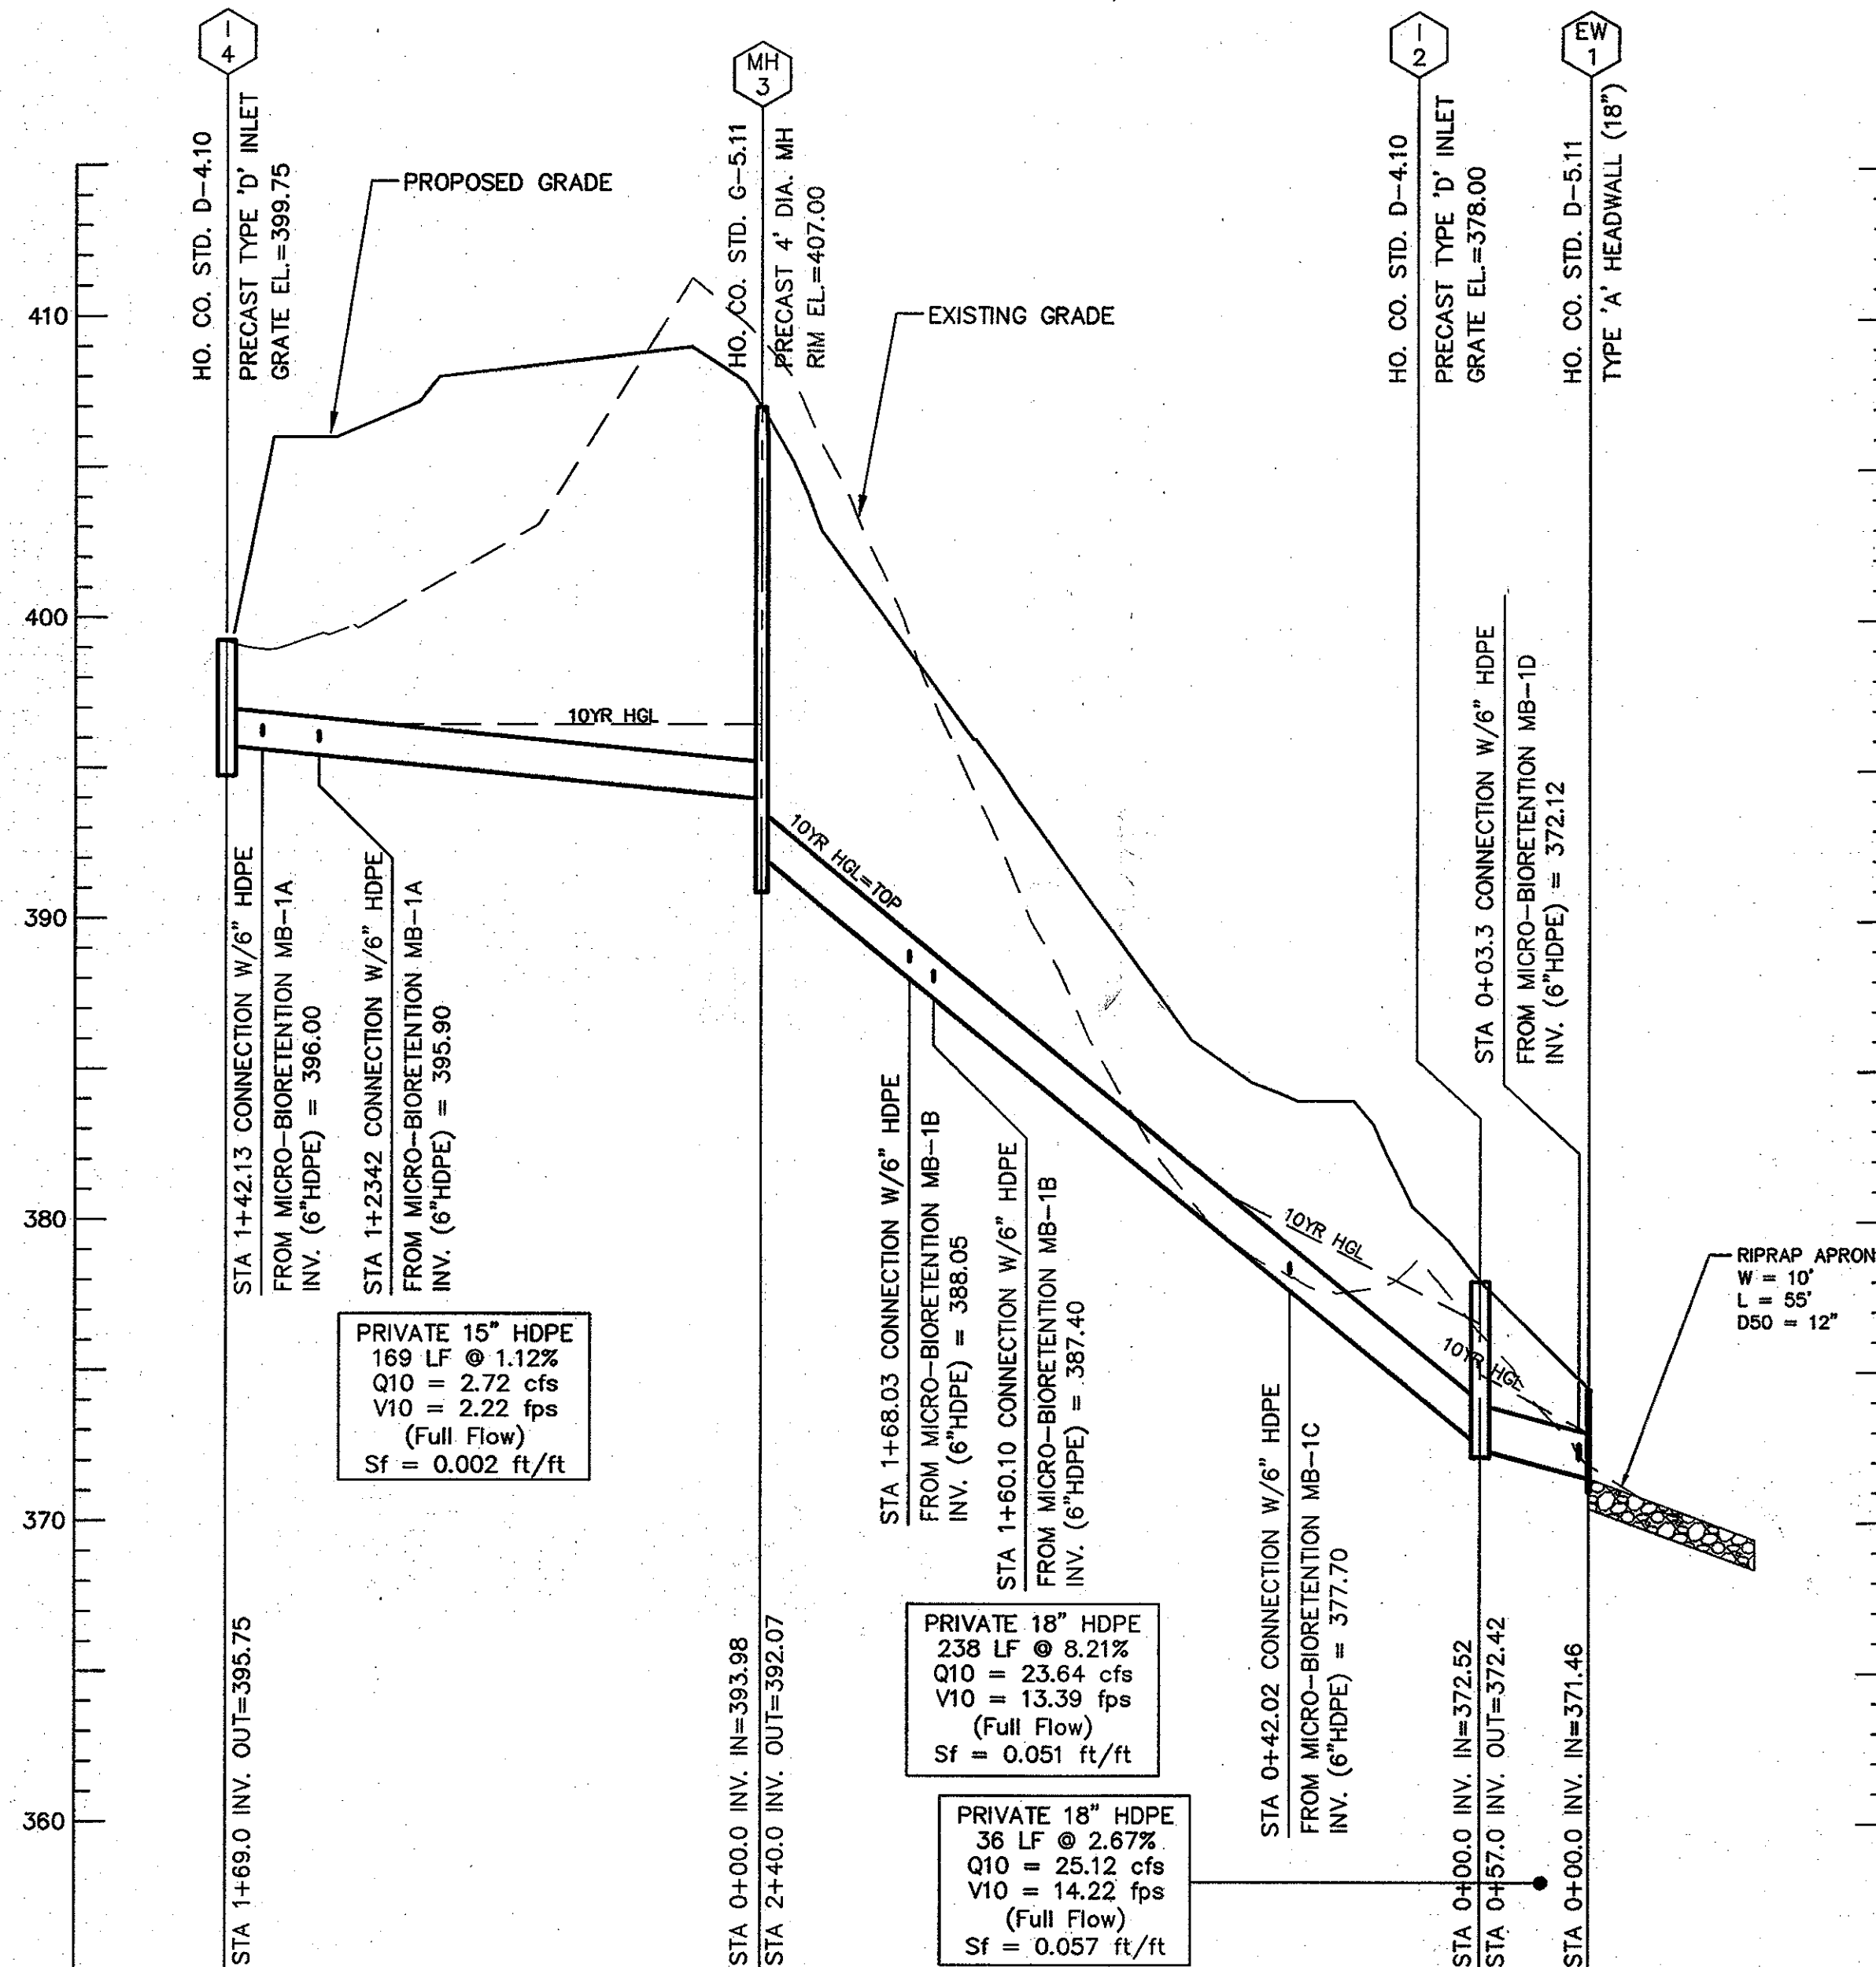


PROFILE - STRUCTURES I-4 TO ES-1

SCALE: 1"=50' HOR
1"=5' VER

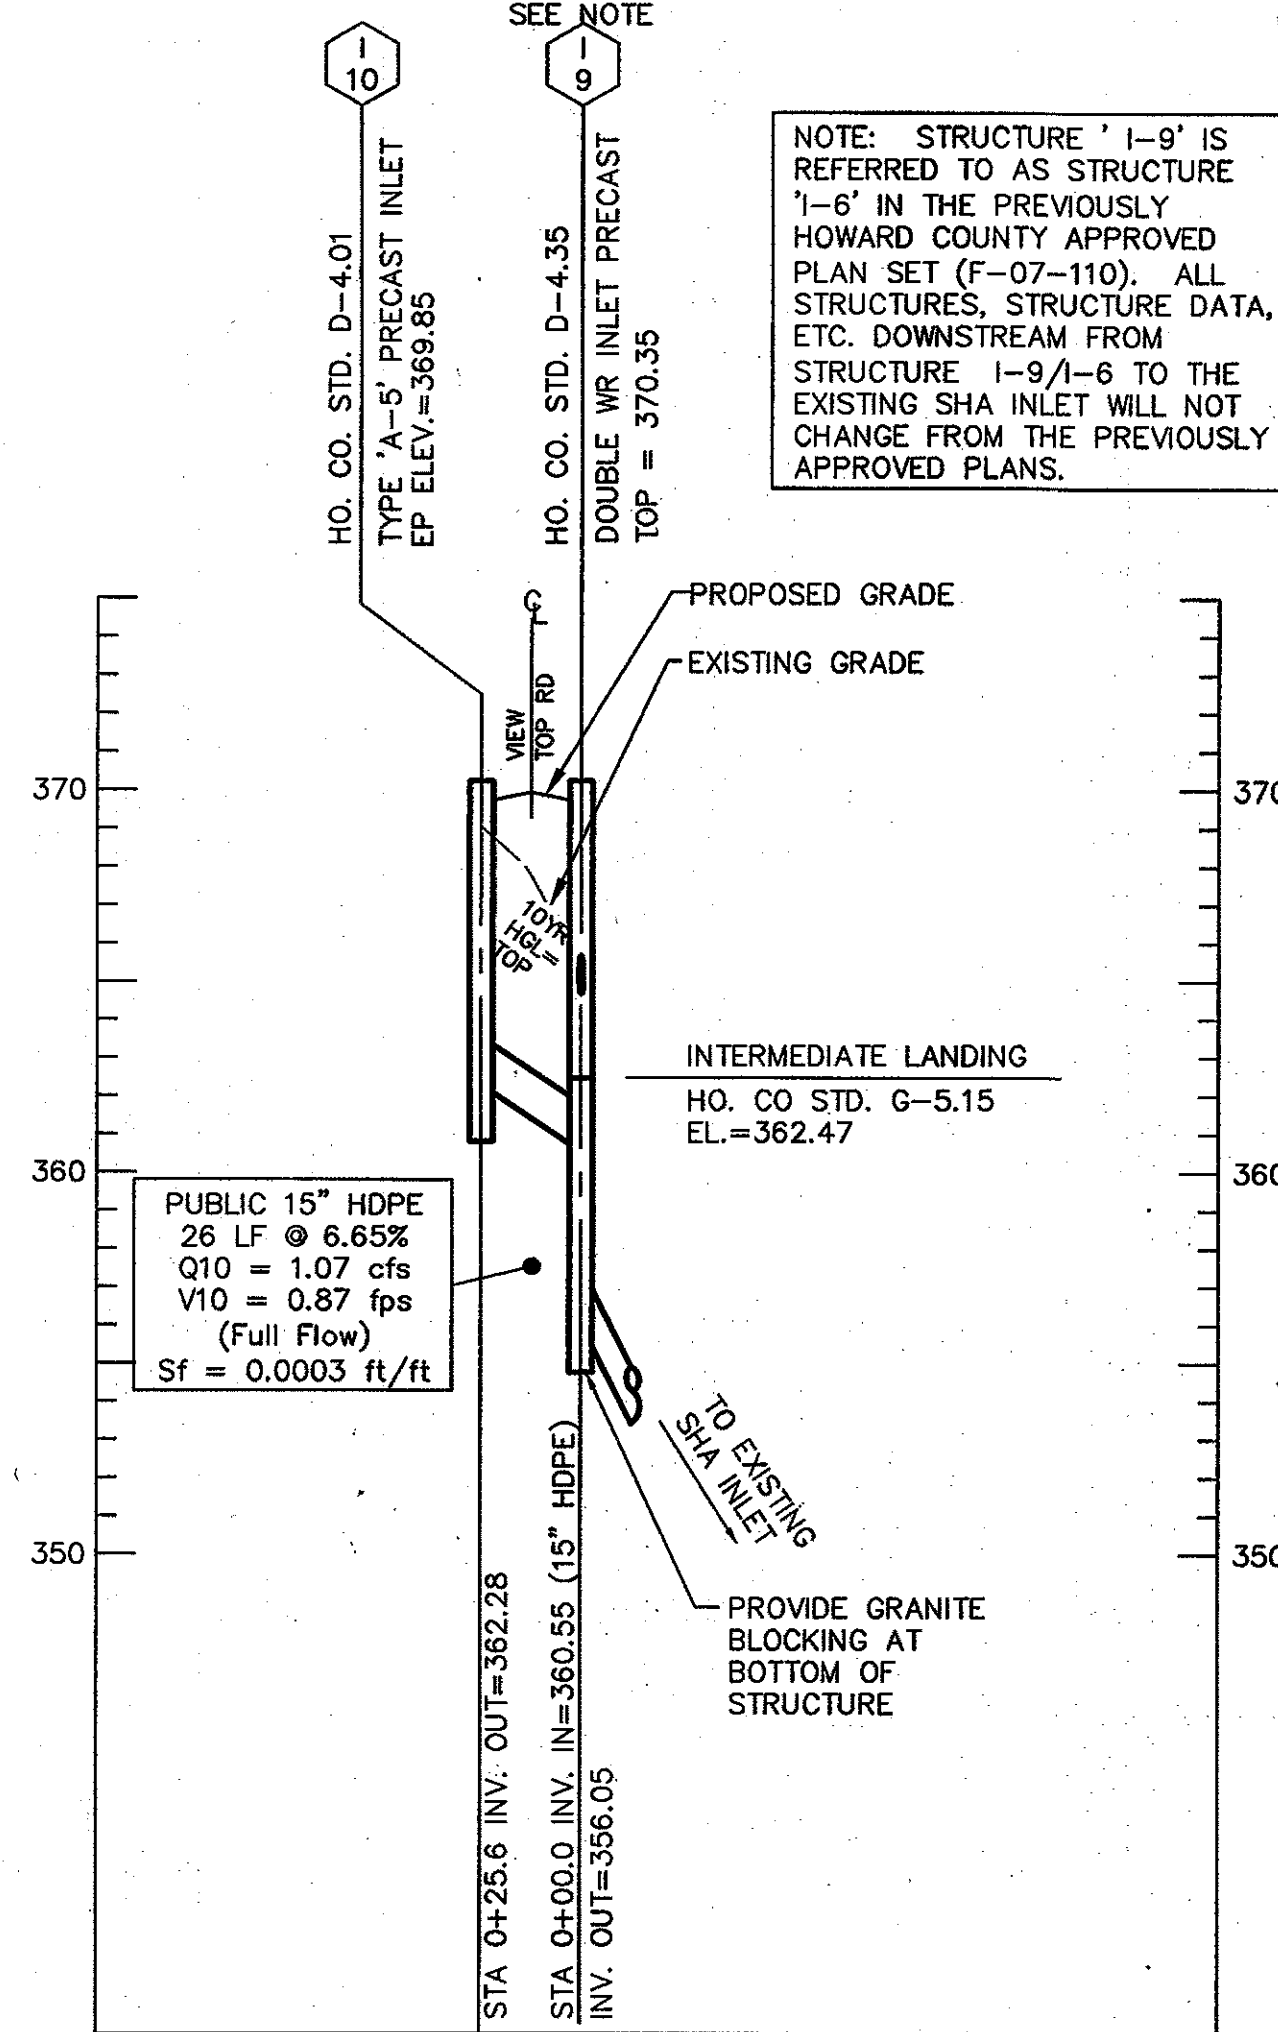


PROFILE - STRUCTURES I-10 TO I-9

SCALE: 1"=50' HOR
1"=5' VER

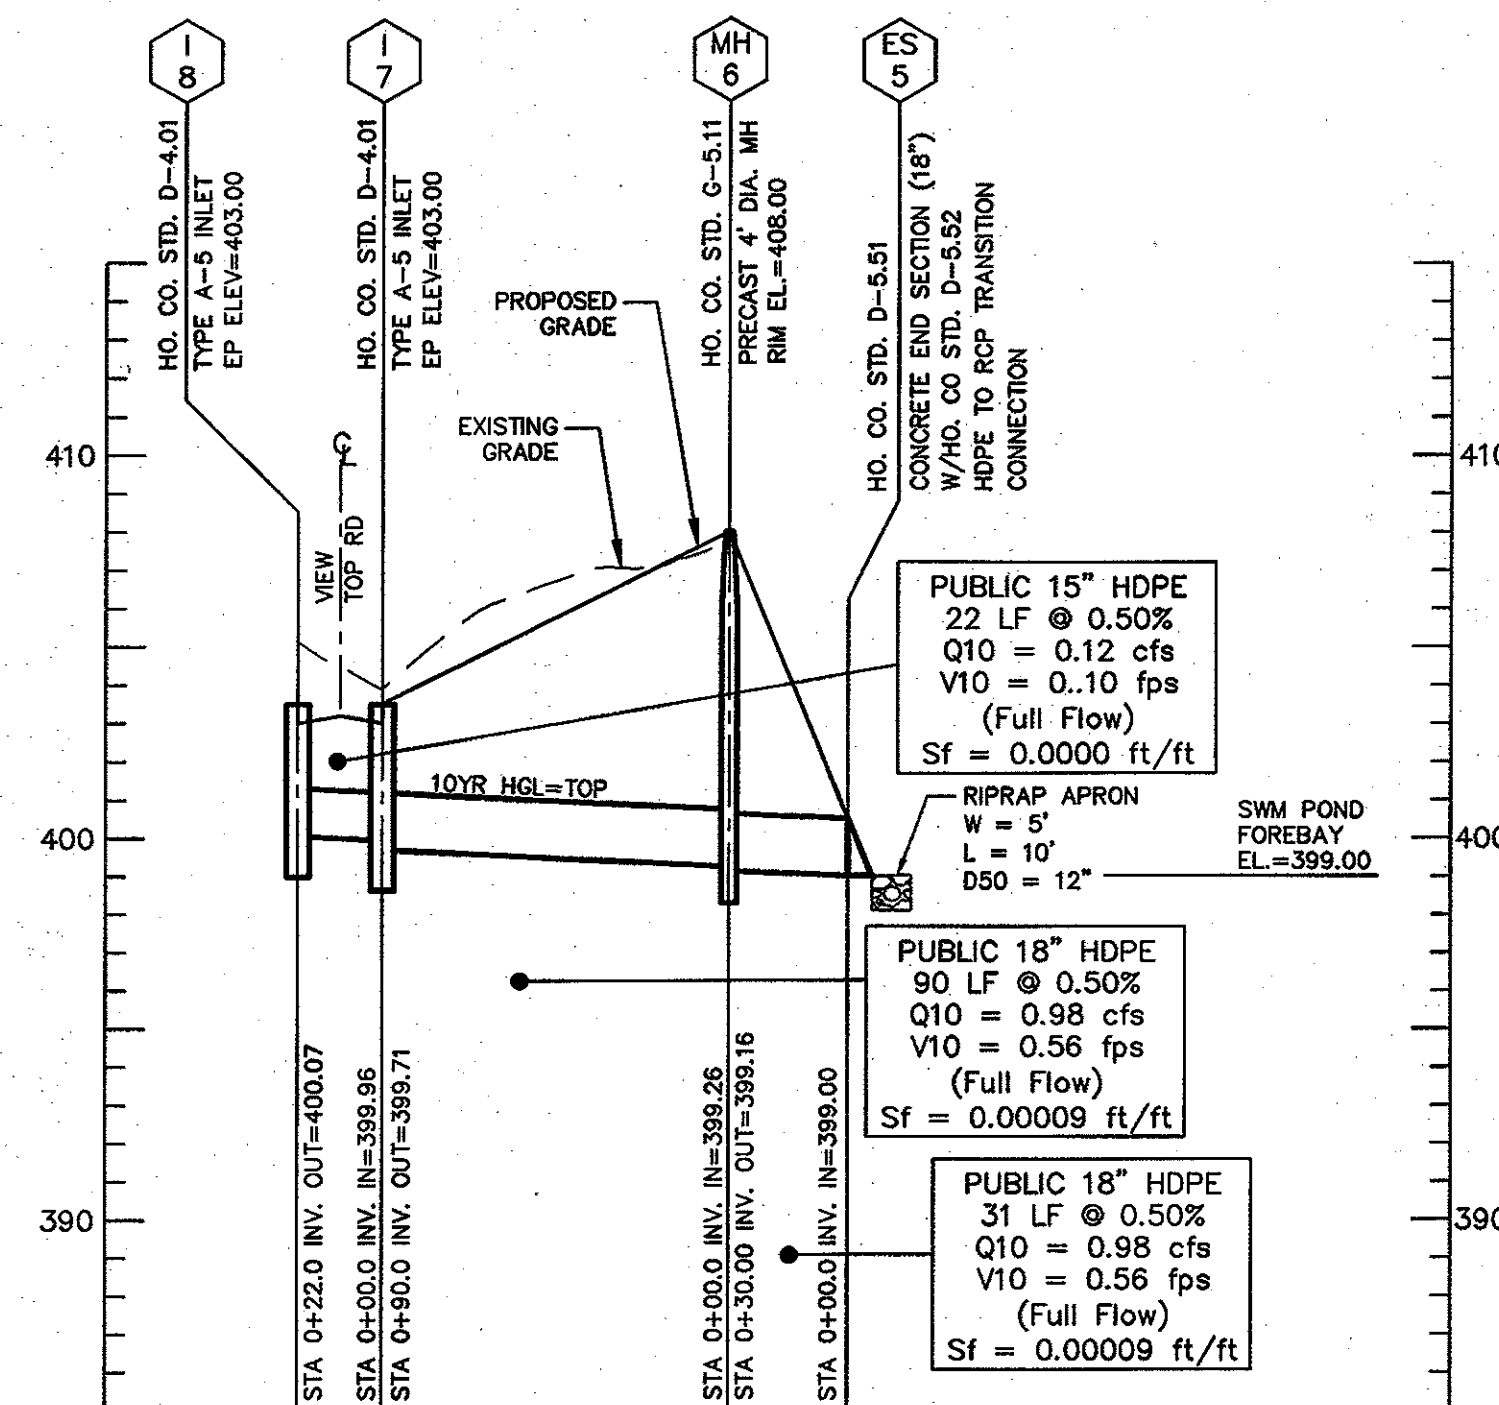

PROFILE - STRUCTURES I-8 TO ES-5

SCALE: 1"=50' HOR
1"=5' VER

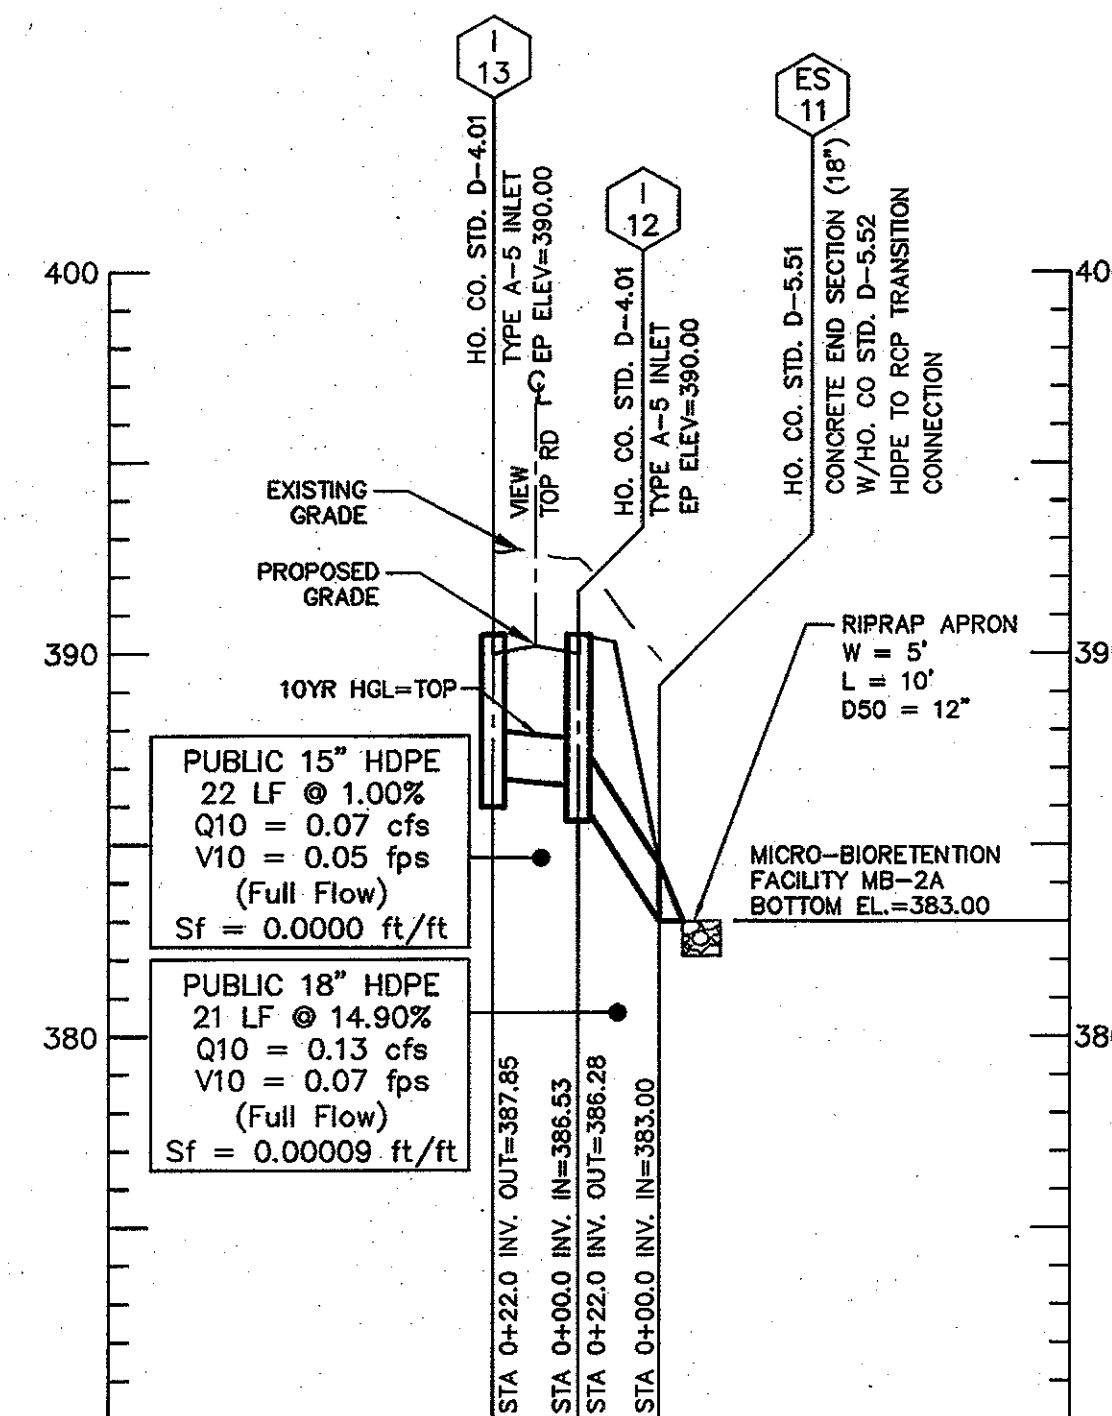

PROFILE - STRUCTURES I-13 TO ES-11

SCALE: 1"=50' HOR
1"=5' VER

ALL MEASUREMENTS TO MANHOLES AND INLETS ARE TO THE CENTER OF STRUCTURE UNLESS OTHERWISE NOTED.

NOTE: THIS SHEET REPLACES SHEET 10 OF 15 OF THE PREVIOUSLY APPROVED PLANS (F-07-110) BY BENCHMARK ENGINEERING

PROFESSIONAL CERTIFICATION

I hereby certify that these documents were prepared or approved by me, and that I am a duly licensed professional engineer under the laws of the State of Maryland, License No. 40091
Expiration Date 2-13-2013


MILDENBERG, BOENDER & ASSOC., INC.
Engineers Planners Surveyors
6800 Deepwater Road, Suite 150, Ellicott City, Maryland 21075
(410) 997-0296 Fax: (410) 997-0298 Fax

HAWES PROPERTY
LOTS 3 THRU 8, O.S. LOT 9, AND NON-BUILDABLE BULK PARCEL 'A'
TAX MAP 24 GRID 17 PARCEL 253
2nd ELECTION DISTRICT
HOWARD COUNTY, MARYLAND

STORM DRAIN PROFILES

project	date	SEP 2011
10-024	illustration	engineering
JLS	scale	JLS
AS SHOWN	approval	AS SHOWN

RESPOND TO HOWARD COUNTY COMMENTS	1/19/2012
RESPOND TO HOWARD COUNTY COMMENTS	11/2/2011
revisions	date
1.	

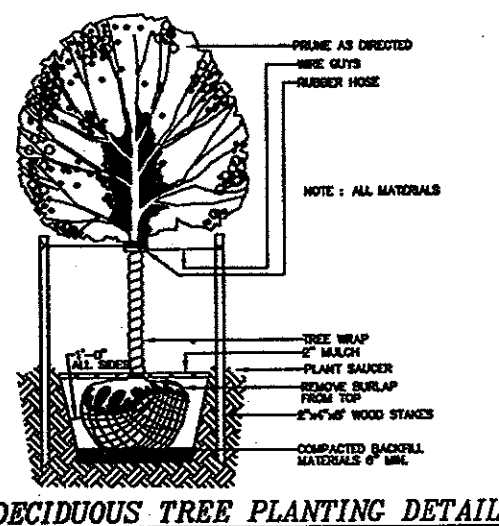


SCHEDULE B: STORMWATER MANAGEMENT AREA LANDSCAPING

LINEAR FEET OF PERIMETER	(A-C)	1,186 LF
CREDIT FOR EXISTING VEGETATION (NO, YES AND LINEAR FEET)	N/A	
CREDIT FOR OTHER LANDSCAPING (NO, YES AND %)	N/A	
NUMBER OF TREES REQUIRED		
SHADE TREES	24 SHADE TREES	
EVERGREEN TREES	30 EVERGREEN TREES	


SWM PERIMETER	EDGE TYPE
SWM PERIMETER A - 858 LF	B
1 SHADE TREE / 50 LF	17
1 EVERGREEN / 40 LF	22
SWM PERIMETER B - 83 LF	B
1 SHADE TREE / 50 LF	2
1 EVERGREEN / 40 LF	2
SWM PERIMETER C - 245 LF	B
1 SHADE TREE / 50 LF	5
1 EVERGREEN / 40 LF	6
TOTAL PLANTING OBLIGATION	
SHADE TREES	24
EVERGREEN TREES	30

STORMWATER MANAGEMENT AREA PLANTING SCHEDULE

QUANTITY	SYMBOL	BOTANICAL NAME	COMMON NAME	SIZE
24		ACER SACCHARUM 'GREEN MOUNTAIN'	GREEN MOUNTAIN SUGAR MAPLE OR EQUIVALENT	2 1/2" - 3" CAL.
30		PINUS STROBUS OR EQUIVALENT	WHITE PINE OR EQUIVALENT	6' - 8' HT.
TOTAL				
54 TREES (24 SHADE TREES, 30 EVERGREENS)				

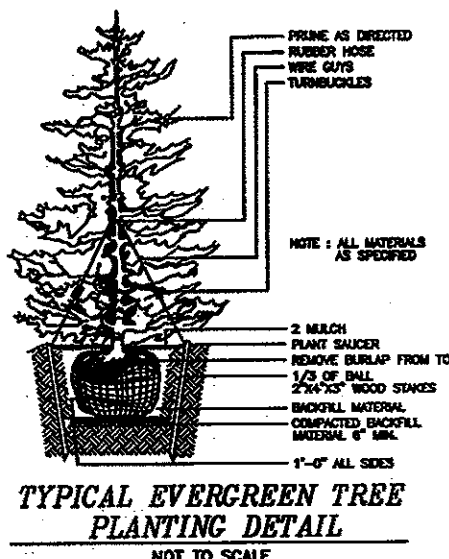

TYPICAL EVERGREEN TREE PLANTING DETAIL
NOT TO SCALE

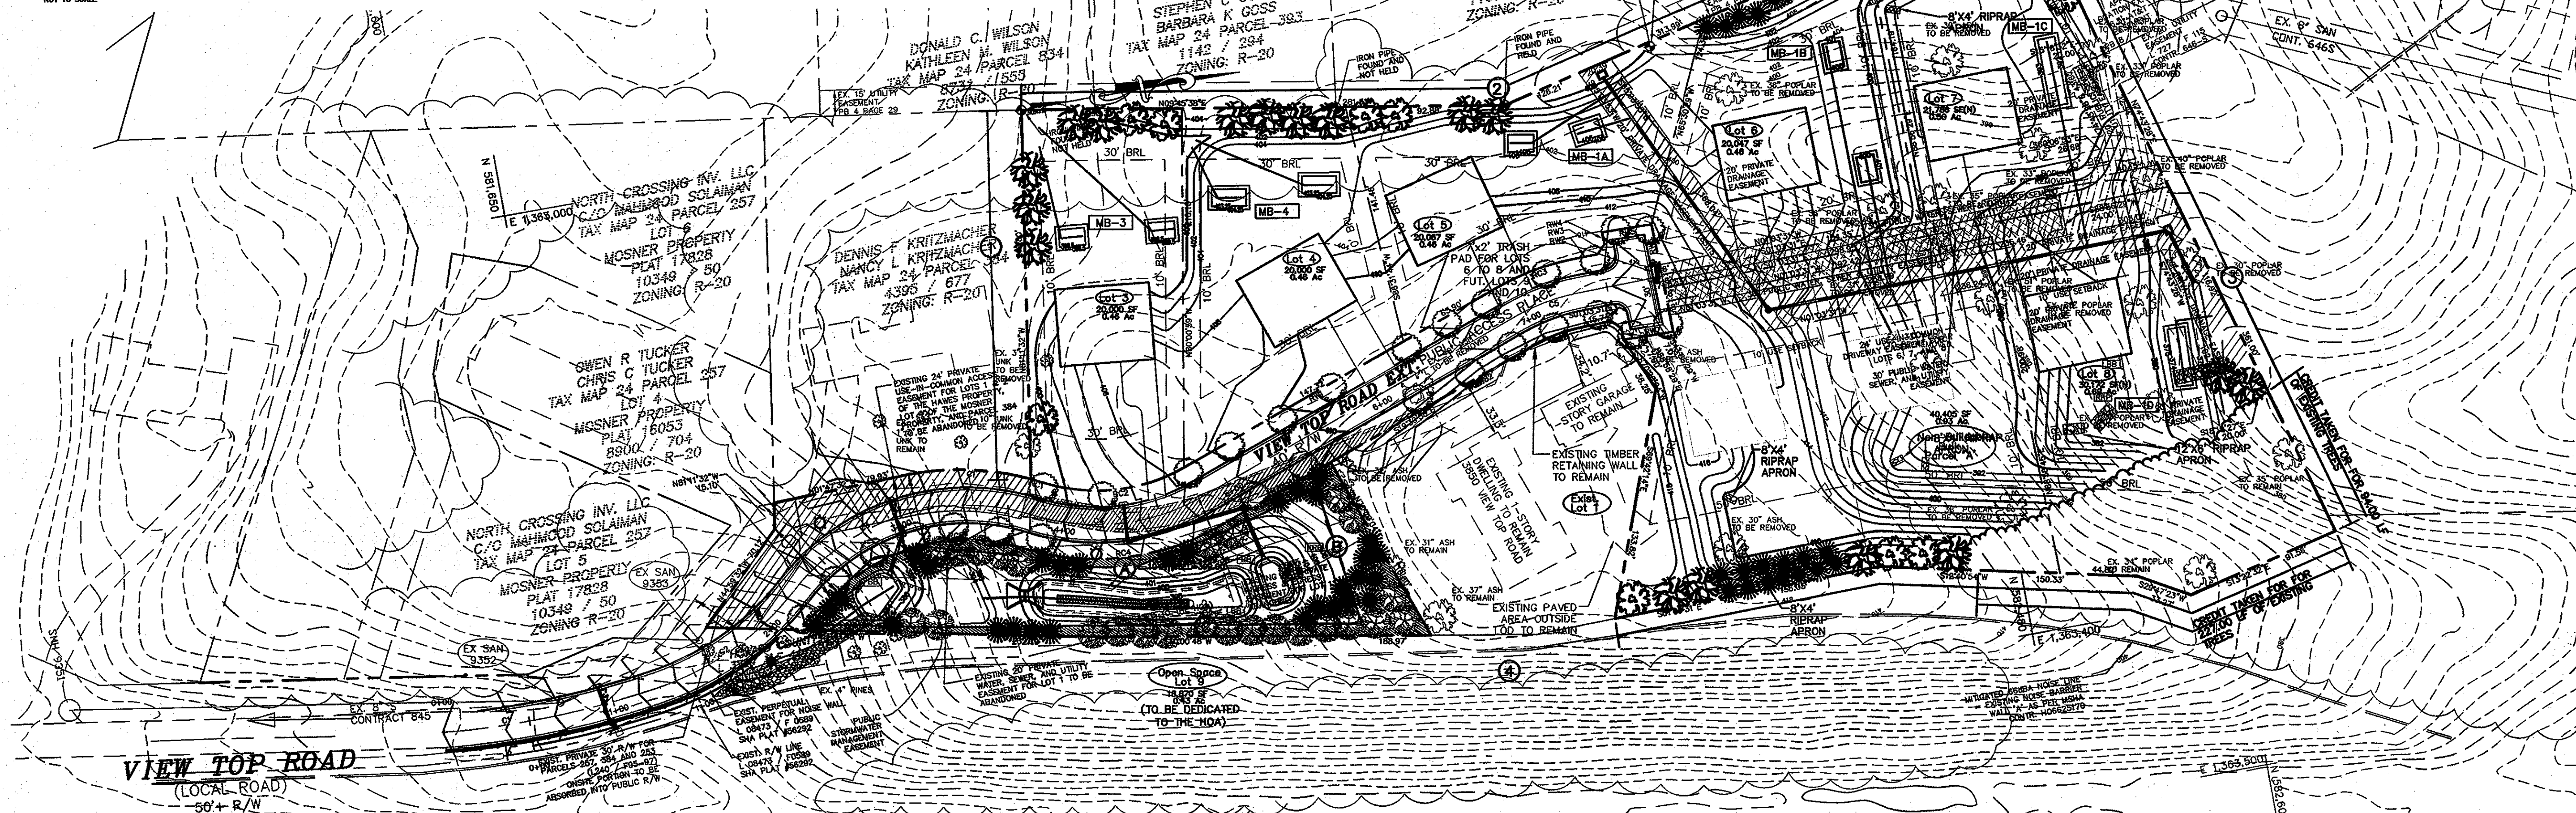

SCREEN CALCULATIONS

TRASH PAD - 11 LF - TYPE C BUFFER
1 EVERGREENS REQUIRED
10 SHRUBS PROVIDED
NOTE - EVERGREEN SHRUBS HAVE BEEN PROPOSED TO BUFFER THE TRASH PAD AREA.

STREET TREE PLANTING SCHEDULE

QUANTITY	SYMBOL	BOTANICAL NAME	COMMON NAME	SIZE
29		PRUNUS SARGENTII OR EQUIVALENT	SARGENT CHERRY OR EQUIVALENT	2-1/2" - 3" CAL.
TOTAL				
29 TREES				

OWNER/DEVELOPER

3804 VIEW TOP, LLC
1055 WEST TOPPA ROAD
APT. 330
TOWSON, MARYLAND 21204
ATTN: RUSSELL HAWES

APPROVED:


Walter J. Russell
CHIEF, BUREAU OF HIGHWAYS
4-16-12
DATE

APPROVED: HOWARD COUNTY DEPARTMENT OF PLANNING AND ZONING

Walter J. Russell
CHIEF, DEVELOPMENT ENGINEERING DIVISION
4/30/12
DATE

STREET TREE CALCULATIONS

VIEW TOP ROAD - 1170 / 40 = 29
TOTAL TREES REQUIRED = 29 TREES
TOTAL TREES PROVIDED = 29 TREES

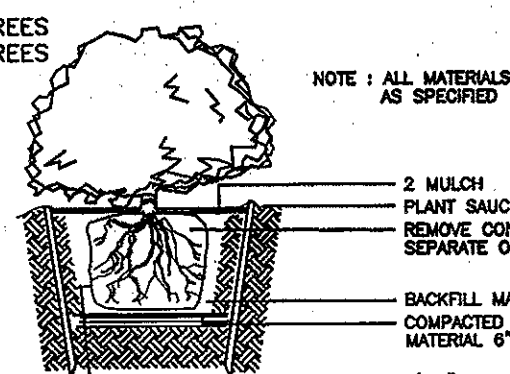

TYPICAL SHRUB PLANTING DETAIL
NOT TO SCALE

AT THE TIME OF INSTALLMENT, ALL SHRUBS AND OTHER PLANTINGS HEREWITH LISTED AND APPROVED FOR THIS SITE, SHALL BE OF THE PROPER HEIGHT REQUIREMENTS IN ACCORDANCE WITH THE HOWARD COUNTY LANDSCAPE MANUAL. IN ADDITION, NO SUBSTITUTIONS OR RELOCATION OF REQUIRED PLANTINGS MAY BE MADE WITHOUT PRIOR REVIEW AND APPROVAL FROM THE DEPARTMENT OF PLANNING AND ZONING. ANY DEVIATION FROM THIS APPROVED LANDSCAPE PLAN MAY RESULT IN DENIAL OR DELAY IN RELEASE OF LANDSCAPE SURETY UNTIL SUCH TIME AS ALL REQUIRED MATERIALS ARE PLANTED AND/OR REVISIONS ARE MADE TO APPLICABLE PLANS AND CERTIFICATES.

DEVELOPER'S/BUILDER'S CERTIFICATE

I/WE CERTIFY THAT THE LANDSCAPING SHOWN ON THIS PLAN WILL BE DONE ACCORDING TO THE PLAN, SECTION 16.124 OF THE HOWARD COUNTY CODE AND THE HOWARD COUNTY LANDSCAPE MANUAL. I/WE FURTHER CERTIFY THAT UPON COMPLETION, A LETTER OF LANDSCAPE INSTALLATION, ACCOMPANIED BY AN EXECUTED ONE YEAR GUARANTEE OF PLANT MATERIALS, WILL BE SUBMITTED TO THE DEPARTMENT OF PLANNING AND ZONING.

DEVELOPER/CONTRACT PURCHASER
3/1/12
DATE

MB-2 MICRO-BIOTENTION FACILITY NUMBER

LANDSCAPE REQUIREMENT PLANTING SCHEDULE

QUANTITY	SYMBOL	BOTANICAL NAME	COMMON NAME	SIZE
15		QUERCUS RUBRA OR EQUIVALENT	RED OAK OR EQUIVALENT	2 1/2" - 3" CAL.
20		PRUNUS SARGENTII OR EQUIVALENT	SARGENT CHERRY OR EQUIVALENT	2-1/2" - 3" CAL.
18		PINUS STROBUS OR EQUIVALENT	WHITE PINE OR EQUIVALENT	6' - 8' HT.
10		TAXUS MEDIA 'HICKSII'	HICKS YEW OR EQUIVALENT	2 1/2" - 3" HT.
TOTAL				
53 TREES (35 SHADE TREES, 18 EVERGREENS, 10 SHRUBS)				

SCHEDULE A: PERIMETER LANDSCAPED EDGE

CATEGORY	ADJACENT TO PERIMETER PROPERTIES	ADJACENT TO ROADWAYS	TRASH PAD
LANDSCAPE TYPE	A (PERIMETER 1) 215.80' LF	A (PERIMETER 2) 595.30 LF	A (PERIMETER 3) 425.02 LF
CREDIT FOR EXISTING VEGETATION (YES, NO, LINEAR FEET)	NO	NO	YES, 84.00 LF
CREDIT FOR WALL, FENCE, OR BERM (YES, NO, LINEAR FEET)	NO	NO	NO
NUMBER OF PLANTS REQUIRED	4 SHADE TREES 0 EVERGREEN TREES 0 SHRUBS	10 SHADE TREES 0 EVERGREEN TREES 0 SHRUBS	6 SHADE TREES 18 EVERGREEN TREES 0 SHRUBS
NUMBER OF PLANTS PROVIDED	4 SHADE TREES 0 EVERGREEN TREES 0 SHRUBS	10 SHADE TREES 0 EVERGREEN TREES 0 SHRUBS	15 SHADE TREES 18 EVERGREEN TREES 0 SHRUBS

* NOTE THAT PART OF PERIMETER 4 HAS BEEN EXCLUDED SINCE THERE IS AN EXISTING HOUSE TO REMAIN.


LANDSCAPING NOTES


- THE PROPOSED LANDSCAPING SHALL BE PROVIDED BY THE PLANTINGS SHOWN ON THESE PLANS.
- THE DEVELOPER SHALL BE RESPONSIBLE FOR ALL INTERNAL PLANTINGS; THE PRESERVATION OF THE EXISTING PERMETER VEGETATION; AND FOR THE PERMETER PLANTINGS AS SHOWN ON THESE PLANS. BONDING FOR THE PROPOSED PLANTINGS IS THE OBLIGATION OF THE DEVELOPER AS PART OF THE DEVELOPER'S AGREEMENT.
- TREES MUST BE A MINIMUM OF FOUR (4) FEET FROM THE CURB OR SIDEWALK AND MUST BE A MINIMUM OF FIVE (5) FEET FROM ANY STORM DRAIN.
- A MINIMUM DISTANCE OF TWENTY (20) FEET MUST BE MAINTAINED BETWEEN ANY TREES LOCATED ALONG THE CURB LINE AND FROM STREET LIGHTS.
- TREES MUST BE PLANTED A MINIMUM OF FIVE (5) FEET FROM AN OPEN SPACE ACCESS STRIP AND TEN (10) FEET FROM A DRIVEWAY.
- THIS PLAN HAS BEEN PREPARED IN ACCORDANCE WITH THE PROVISIONS OF SEC.-16.124 OF THE HOWARD COUNTY CODE AND LANDSCAPE MANUAL.
- STREET TREES SHALL BE PLANTED SIX (6) FEET BEHIND THE FACE OF CURB WHEN THERE ARE NO SIDEWALKS.
- ALL LANDSCAPING PLANT TYPES SHOWN ON THESE PLANS ARE RECOMMENDATIONS AND MAY BE SUBSTITUTED WITH APPROVED EQUIVALENTS FROM THE HOWARD COUNTY LANDSCAPE MANUAL.
- NO TREES SHALL BE PLACED WITHIN 10' BEHIND A RETAINING WALL OR WITHIN A RELATED MAINTENANCE EASEMENT, WHICHEVER IS GREATER.
- PERIMETER LANDSCAPING AND TRASH PAD SCREENING SHALL BE PROVIDED IN ACCORDANCE WITH SECTION 16.124 OF THE LANDSCAPE MANUAL AND AS SHOWN ON THIS LANDSCAPE PLAN SHEET OF THE ROAD CONSTRUCTION DRAWINGS FOR F-07-110. SURETY IN THE AMOUNT OF \$13,500 FOR THE REQUIRED 35 SHADE TREES, 18 EVERGREEN TREES, AND 10 SHRUBS SHALL BE POSTED WITH THE DEVELOPER'S AGREEMENT UNDER THIS FINAL PLAN, F-07-110.

NOTE: THIS SHEET REPLACES SHEET 11 OF 15 OF THE PREVIOUSLY APPROVED PLANS (F-07-110) BY BENCHMARK ENGINEERING

PROFESSIONAL CERTIFICATION


I hereby certify that these documents were prepared or approved by me, and that I am a duly licensed professional engineer under the laws of the State of Maryland, License No. 40091
Expiration Date 2-13-2013

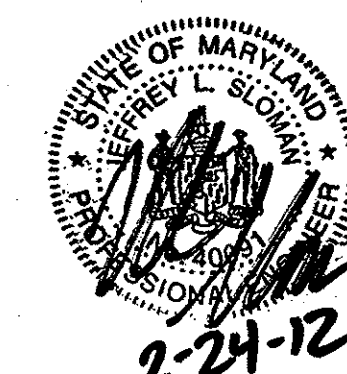

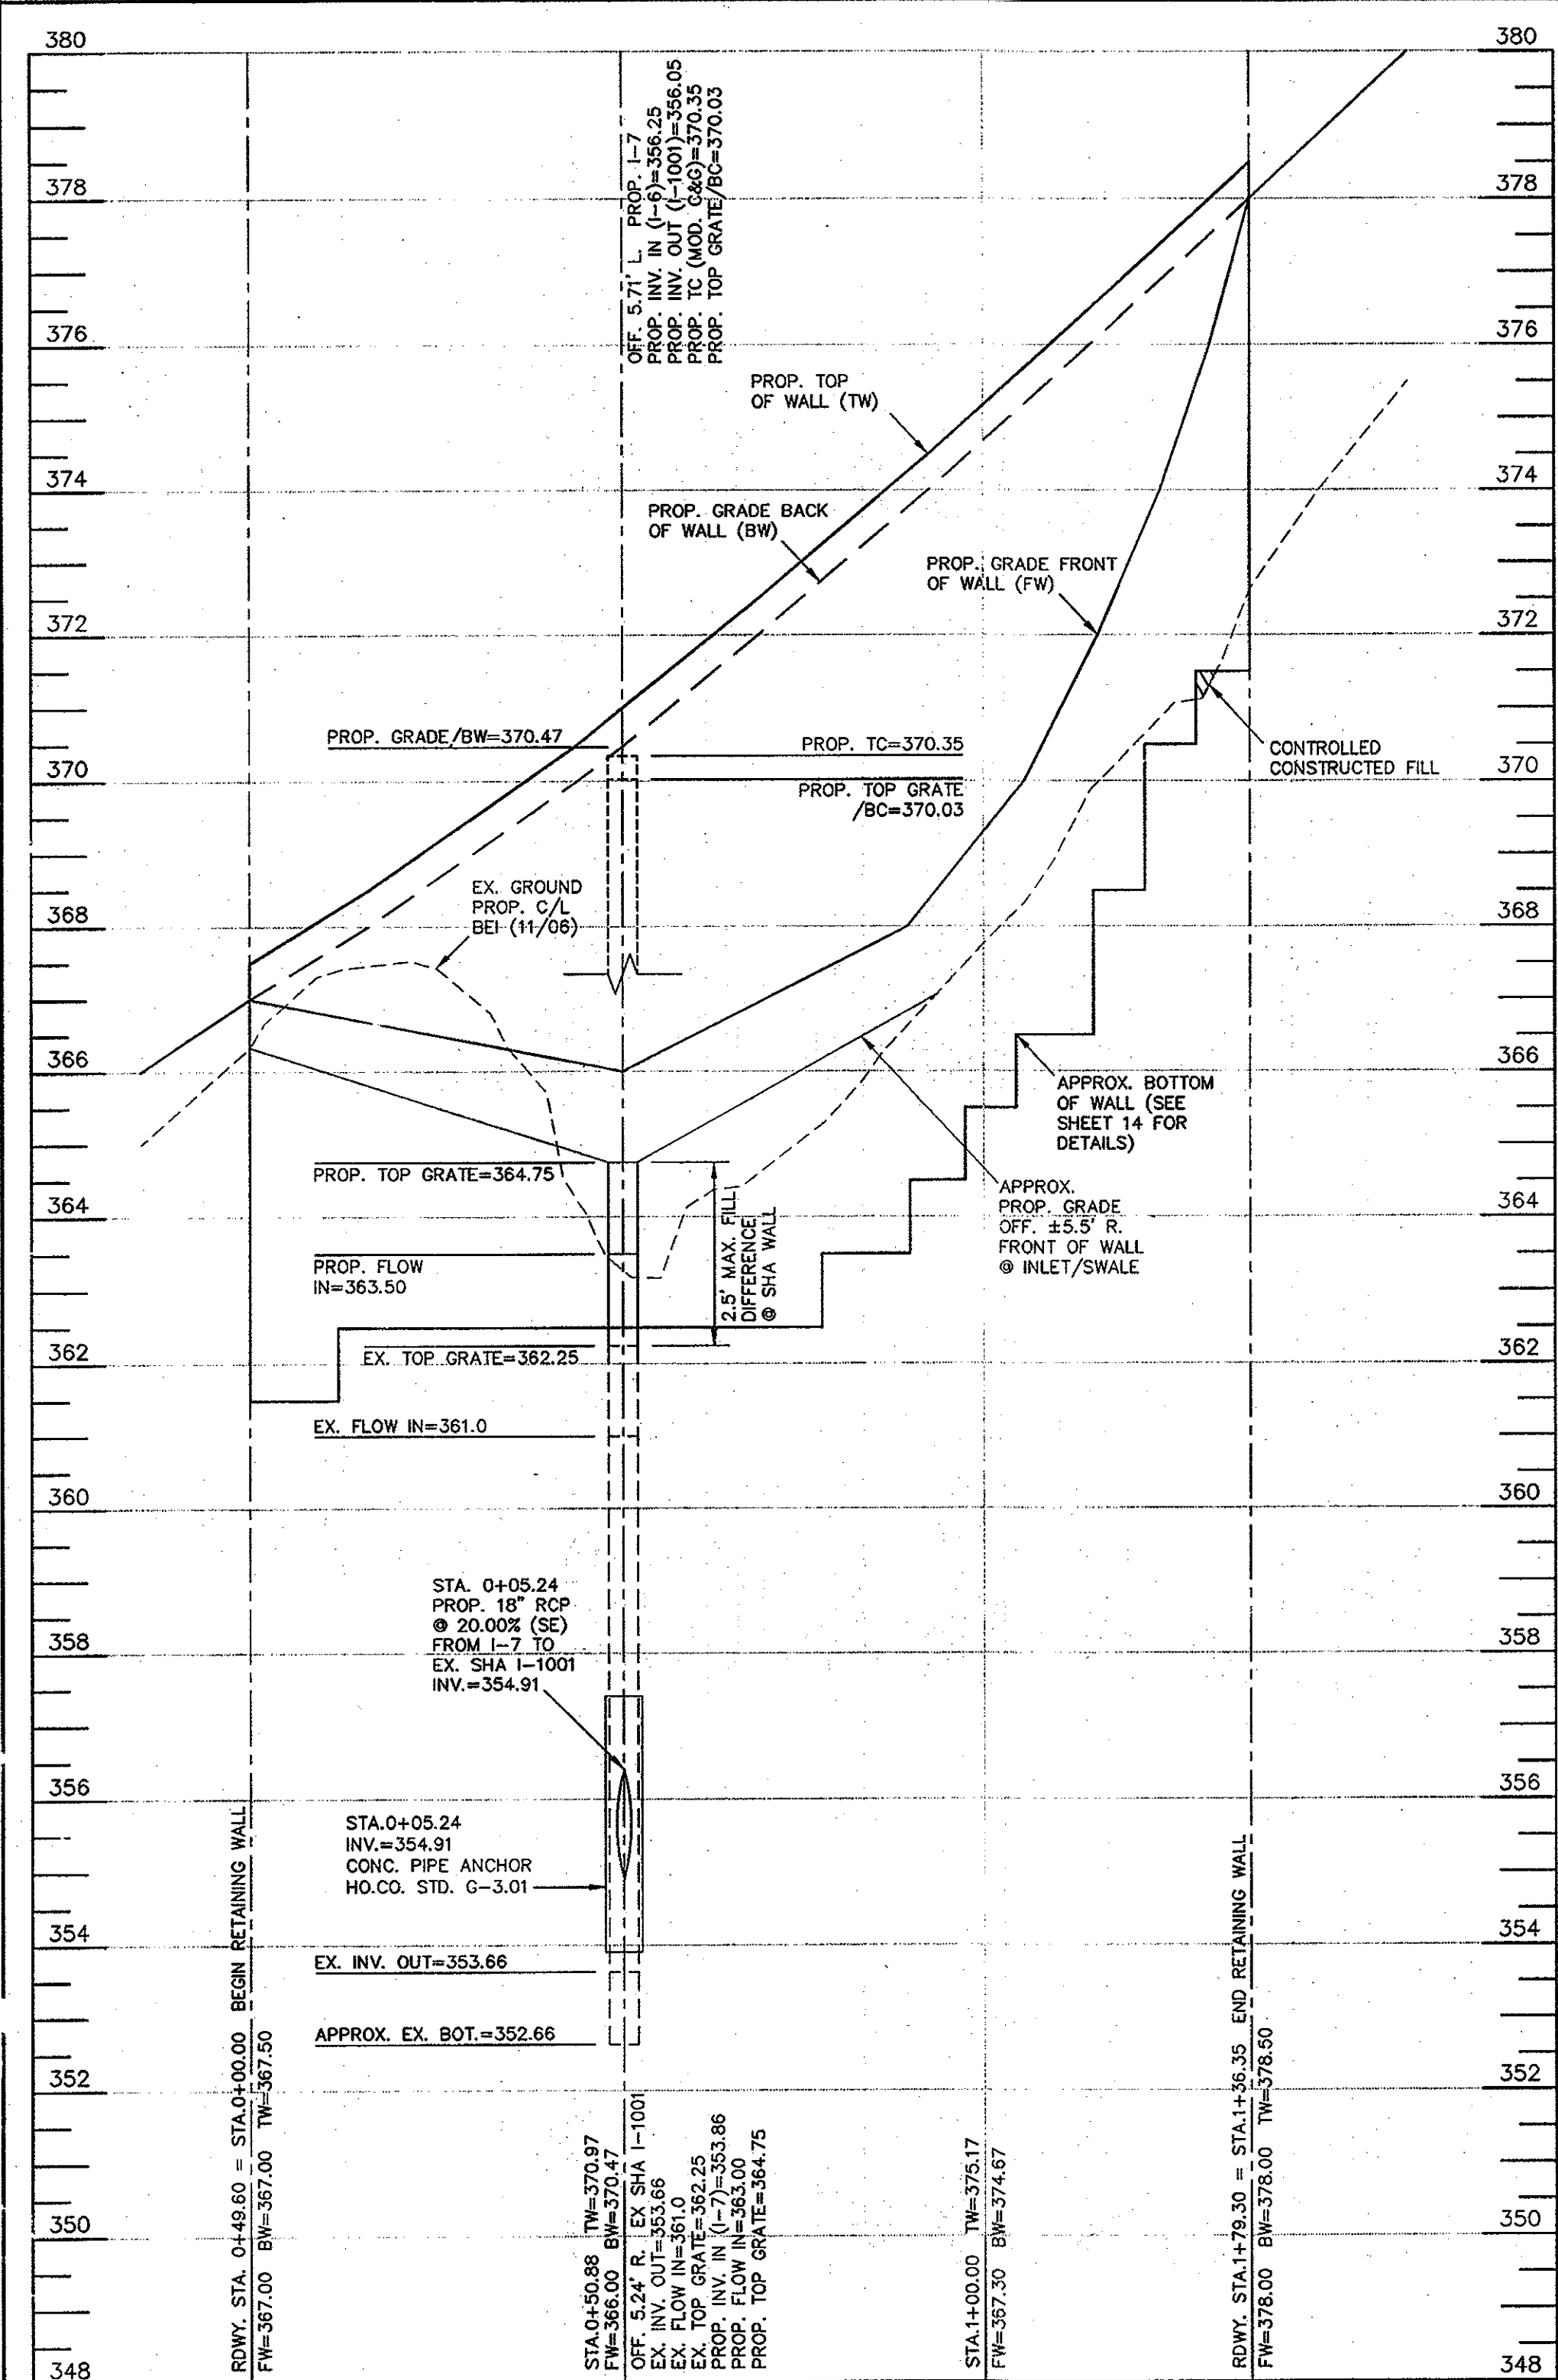


PROFILE - RETAINING WALL
 HORIZONTAL SCALE: 1" = 20'
 VERTICAL SCALE: 1" = 2'

THE HOMEOWNER'S ASSOCIATION SHALL BE RESPONSIBLE FOR REMOVAL OF GRAFFITI FROM THE RETAINING WALLS

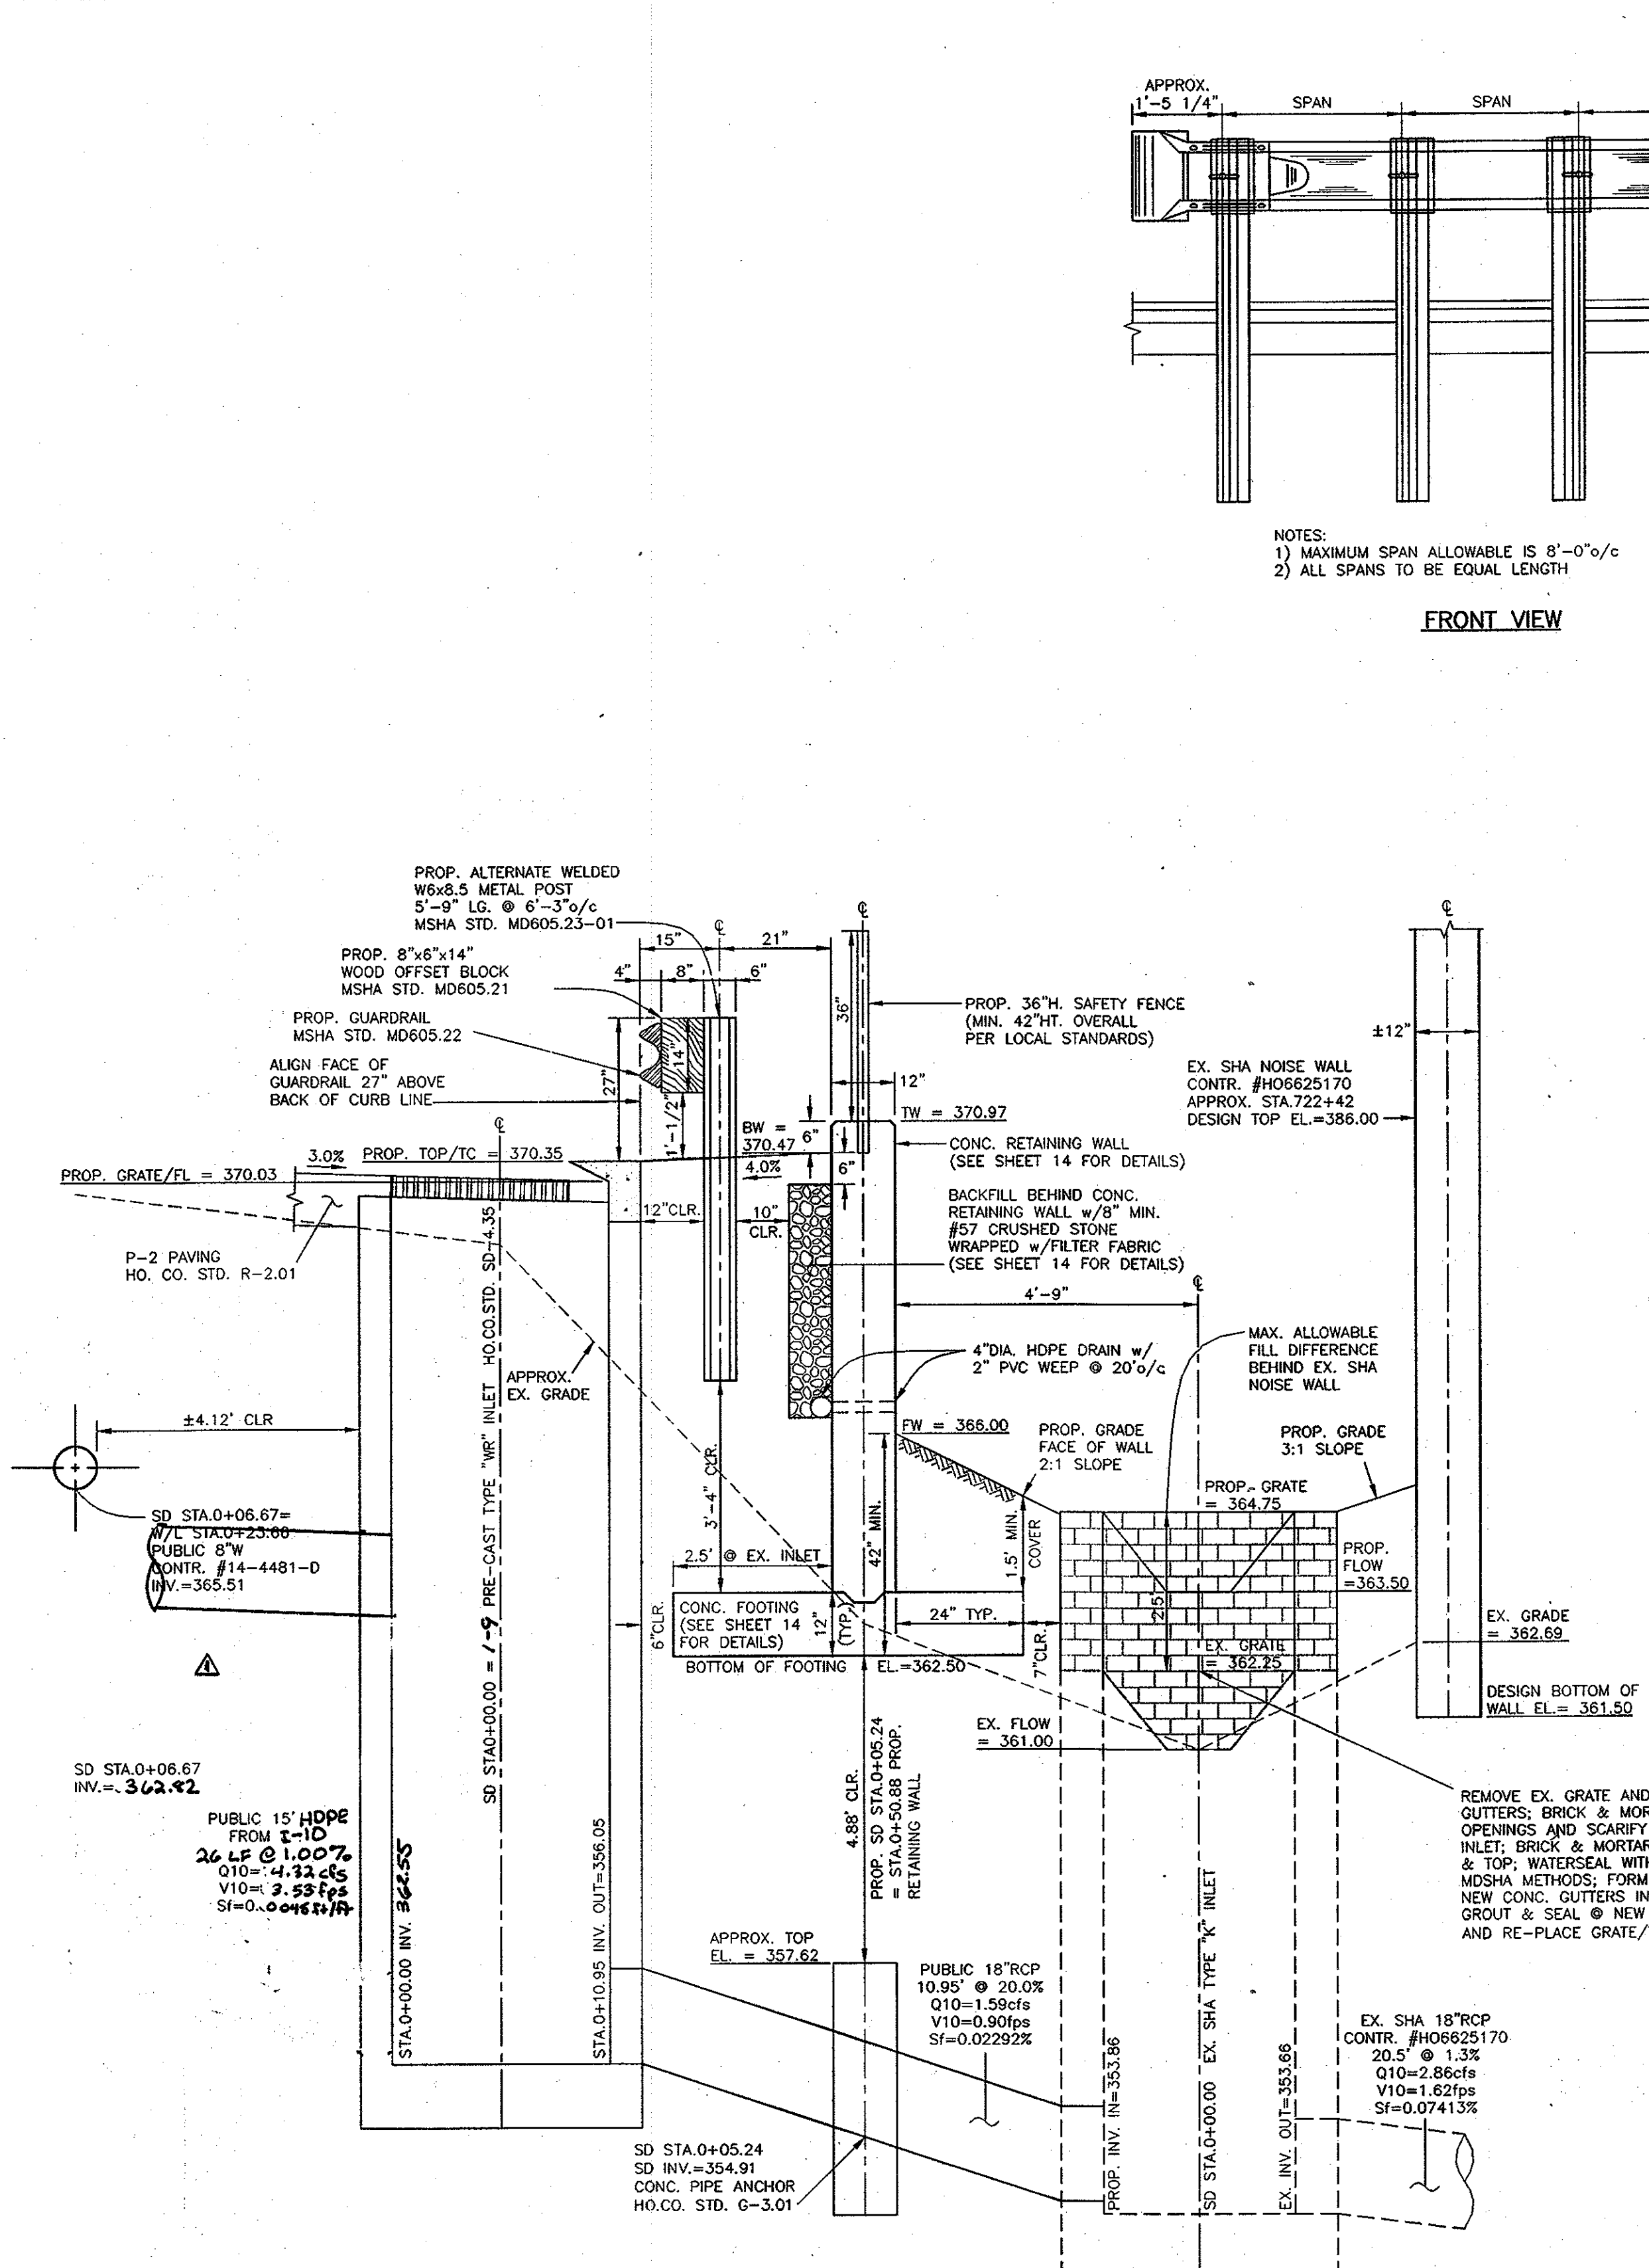


SECTION/DETAIL
 IMPROVEMENTS @ EX. SHA INLET
 SCALE: 1" = 2'

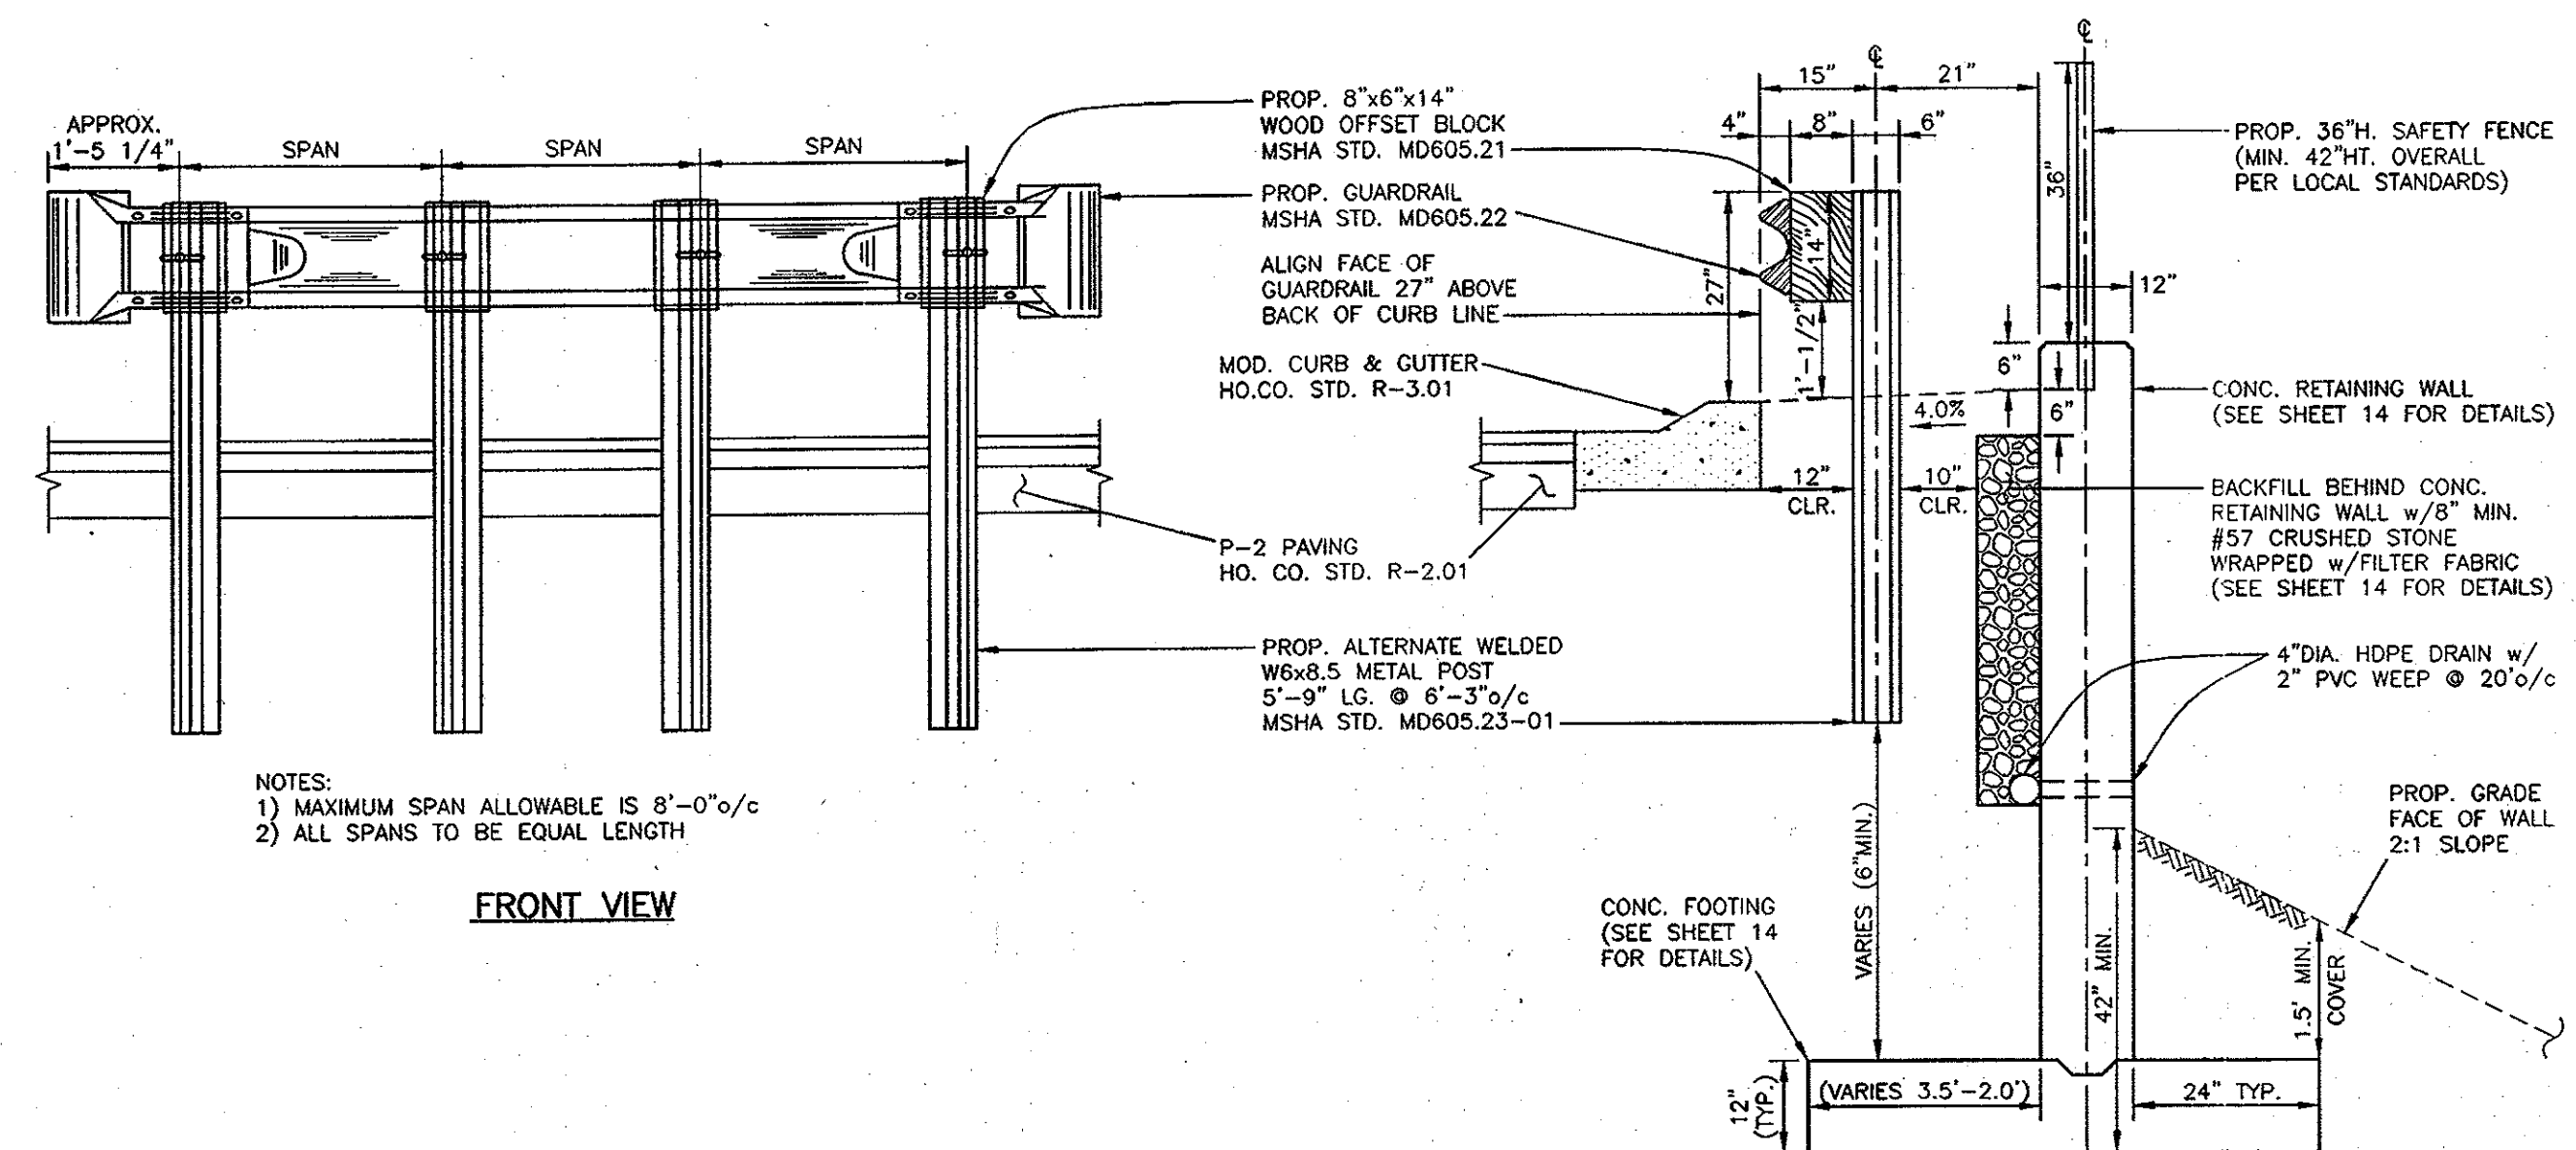

GUARDRAIL DETAIL
 NOT TO SCALE

TYPICAL SECTION

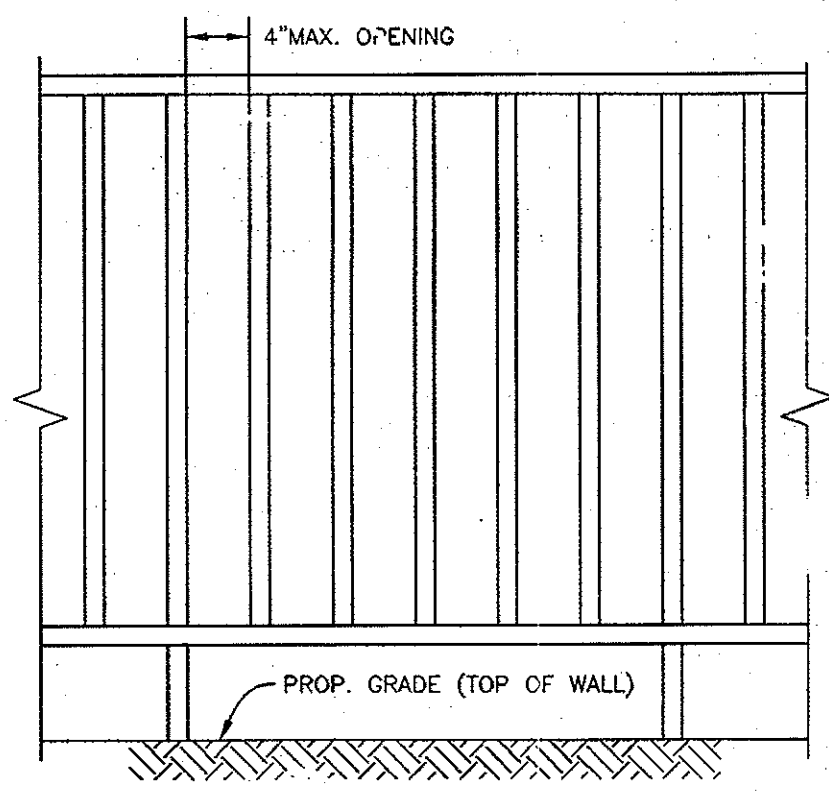

TYPICAL SAFETY FENCE
 NOT TO SCALE

SECTION 1021.0 GUARDS

1021.1 General: Where required by the provisions of Sections 406.5, 408.3.2, 1002.5, 1014.7, 1016.5 and 1825.5, guards shall be designed and constructed in accordance with the requirements of this section and Section 1815.8. A guardrail system is a system of building components located near the open sides of elevated walking surfaces for the purpose of minimizing the possibility of an accidental fall from the walking surface to the lower level.

1021.2 Height: The guards shall be at least 42 inches (1067 mm) in height measured vertically above the leading edge of the tread or adjacent walking surface.

Exceptions:

1. In other than occupancies in Use Group E, guards shall not be less than 34 inches (864 mm) in height above the leading edge of the tread along stairs which are not more than 20 feet (6096 mm) in height or which reverse direction at an intermediate landing with 12 inches (305 mm) or less measured horizontally between successive flights.
2. Guards along open-sided floor areas, mezzanines and landings in occupancies in Use Group R-3 shall not be less than 36 inches (914 mm) in height.

1021.3 Opening Limitations: In occupancies in Use Groups A, B, E, H-4, I, 1, 2, M and R, and in public garages and open material such that a sphere with a diameter of 4 inches (102 mm) cannot pass through any opening. Guards shall not have an ornamental pattern that would provide a ladder effect.

NO.	DATE	REVISION
1	2-28-12	To revise storm drains and storm water management

BENCHMARK ENGINEERING, INC.

8480 BALTIMORE NATIONAL PIKE SUITE 418
 ELLICOTT CITY, MARYLAND 21043
 PHONE: 410-465-6105 FAX: 410-465-6844
 E-MAIL: bei@bei-civilengineering.com

PROFESSIONAL CERTIFICATION:
 I hereby certify that these documents were prepared or approved by me, and that I am a duly licensed professional engineer under the laws of the State of Maryland.
 License No. 21449 Expiration Date: 12-31-2008

3-13-08

DEVELOPER/CONTRACT PURCHASER:	PROJECT:
SECURITY DEVELOPMENT, L.L.C. P.O. BOX 417 ELLICOTT CITY, MARYLAND 21041 PHONE: (410) 465-4244	HAWES PROPERTY SUBDIVISION (RE-SUBDIVISION OF LOT 2) LOTS 1 & 5-10 AND O.S. LOTS 3 & 4
LOCATION:	TITLE:
TAX MAP 24 - GRID 17 PARCEL 253 - ZONE: R-20 2nd ELECTION DISTRICT HOWARD COUNTY, MARYLAND	FINAL/CONSTRUCTION PLAN MISCELLANEOUS SITE PLAN PROFILES, NOTES, AND DETAILS
DATE: DECEMBER 20, 2006 MARCH 14, 2008	PROJECT NO. 1574
SCALE: AS SHOWN	DRAWING 13 OF 16

APPROVED: HOWARD COUNTY DEPARTMENT OF PUBLIC WORKS	DATE: 5-5-08
Walter R. Mink	DATE: 5-5-08
CHIEF, BUREAU OF HIGHWAYS	DATE: 5-5-08
APPROVED: HOWARD COUNTY DEPARTMENT OF PLANNING AND ZONING	DATE: 5-5-08
Cindy Hamer	DATE: 5-5-08
CHIEF, DIVISION OF LAND DEVELOPMENT	DATE: 5-5-08
APPROVED: DEVELOPMENT ENGINEERING DIVISION	DATE: 5-5-08
DATE: 5-5-08	DATE: 5-5-08

OPERATION AND MAINTENANCE SCHEDULE FOR PRIVATELY OWNED AND MAINTAINED DISCONNECTION OF ROOFTOP RUNOFF (N-1), DISCONNECTION OF NON-ROOFTOP RUNOFF (N-2)

- A. MAINTENANCE OF AREAS RECEIVING DISCONNECTED RUNOFF IS GENERALLY NO DIFFERENT THAN THAT REQUIRED FOR OTHER LAWN OR LANDSCAPED AREAS. THE OWNER SHALL ENSURE THE AREAS RECEIVING RUNOFF ARE PROTECTED FROM FUTURE COMPACTION OF DEVELOPMENT OF IMPERVIOUS AREA. IN COMMERCIAL AREAS, FOOT TRAFFIC SHOULD BE DISCOURAGED AS WELL.

OPERATION AND MAINTENANCE SCHEDULE FOR MICRO-BIORETENTION (M-6)


- A. ANNUAL MAINTENANCE OF PLANT MATERIAL, MULCH LAYER AND SOIL LAYER IS REQUIRED. MAINTENANCE OF MULCH AND SOIL IS LIMITED TO CORRECTING AREAS OF EROSION OR WASH OUT. ANY MULCH REPLACEMENT SHALL BE DONE IN THE SPRING. PLANT MATERIAL SHALL BE CHECKED FOR DISEASE AND INSECT INFESTATION AND MAINTENANCE WILL ADDRESS DEAD MATERIAL AND PRUNING. ACCEPTABLE REPLACEMENT PLANT MATERIAL IS LIMITED TO THE FOLLOWING: 2000 MARYLAND STORMWATER DESIGN MANUAL VOLUME II, TABLE A-4.1 AND 2.
- B. SCHEDULE OF PLANT INSPECTION WILL BE TWICE A YEAR IN SPRING AND FALL. THIS INSPECTION WILL INCLUDE REMOVAL OF DEAD AND DISEASED VEGETATION CONSIDERED BEYOND TREATMENT, TREATMENT OF ALL DISEASED TREES AND SHRUBS AND REPLACEMENT OF ALL DEFICIENT STAKES AND WIRES.
- C. MULCH SHALL BE INSPECTED EACH SPRING. REMOVE PREVIOUS MULCH LAYER BEFORE APPLYING NEW LAYER ONCE EVERY 2 TO 3 YEARS.
- D. SOIL EROSION TO BE ADDRESSED ON AN AS NEEDED BASIS, WITH A MINIMUM OF ONCE PER MONTH AND AFTER HEAVY STORM EVENTS.

OPERATION AND MAINTENANCE SCHEDULE FOR PRIVATELY OWNED AND MAINTAINED SURFACE STORMWATER FILTRATION SYSTEMS (F-1)

- A. THE STORMWATER FACILITY SHALL BE INSPECTED ANNUALLY AND AFTER MAJOR STORMS. INSPECTIONS SHALL BE PERFORMED DURING WET WEATHER TO DETERMINE IF THE FACILITY IS FUNCTIONING PROPERLY.
- B. THE TOP AND SIDE SLOPES OF THE EMBANKMENT SHALL BE MOWED A MINIMUM OF ONCE PER YEAR, WHEN VEGETATION REACHES 18" IN HEIGHT OR AS NEEDED.
- C. FILTERS THAT HAVE A GRASS COVER SHALL BE MOWED A MINIMUM OF THREE (3) TIMES PER GROWING SEASON TO MAINTAIN A MAXIMUM GRASS HEIGHT OF LESS THAN 12 INCHES.
- D. DEBRIS AND LITTER SHALL BE REMOVED DURING REGULAR MOWING OPERATIONS AND AS NEEDED.
- E. VISIBLE SIGNS OF EROSION IN THE FACILITY SHALL BE REPAIRED AS SOON AS IT IS NOTICED.
- F. REMOVE SILT WHEN IT EXCEEDS FOUR (4) INCHES DEEP IN THE FOREBAY.
- G. WHEN WATER PONDS ON THE SURFACE OF THE FILTER BED FOR MORE THAN 72 HOURS, THE TOP FEW INCHES OF DISCOLORED MATERIAL SHALL BE REPLACED WITH FRESH MATERIAL. PROPER CLEANING AND DISPOSAL OF THE REMOVED MATERIALS AND LIQUID MUST BE FOLLOWED BY THE OWNER.
- H. A LOG BOOK SHALL BE MAINTAINED TO DETERMINE THE RATE AT WHICH THE FACILITY DRAINS.
- I. THE MAINTENANCE LOG BOOK SHALL BE AVAILABLE TO HOWARD COUNTY FOR INSPECTION TO INSURE COMPLIANCE WITH OPERATION AND MAINTENANCE CRITERIA.
- J. ONCE THE PERFORMANCE CHARACTERISTICS OF THE INFILTRATION SYSTEM HAVE BEEN VERIFIED, THE MONITORING SCHEDULE CAN BE REDUCED TO AN ANNUAL BASIS UNLESS THE PERFORMANCE DATA INDICATES THAT A MORE FREQUENT SCHEDULE IS REQUIRED.


Appendix B.4. Construction Specifications for Environmental Site Design Practices

Material	Specification	Size	Notes
Plantings	see Appendix A, Table A-4	n/a	plantings are site-specific
Planting soil (2' to 4' deep)	loamy sand (60 - 65%) & compost (35 - 40%) or sandy loam (30%), coarse sand (30%) & compost (40%)	n/a	USDA soil types loamy sand or sandy loam; clay content < 5%
Organic content	Min. 10% by dry weight (ASTM D 2974)		
Mulch	shredded hardwood		aged 6 months, minimum; no pine or wood chips
Pea gravel diaphragm	pea gravel: ASTM-D-448	NO. 8 OR NO. 9 (1/8" TO 3/8")	
Curtain drain	ornamental stone: washed cobbles	stone: 2" to 5"	
Geotextile		n/a	PE Type 1 nonwoven
Gravel (underdrains and infiltration berms)	AASHTO M-43	NO. 57 OR NO. 6 AGGREGATE (3/8" to 3/4")	
Underdrain piping	F 758, Type PS 28 or AASHTO M-278	4" to 6" rigid schedule 40 PVC or SDR35	Slotted or perforated pipe; 3/8" perf. @ 6" on center, 4 holes per row; minimum of 3" of gravel over pipes; not necessary underneath pipes. Perforated pipe shall be wrapped with 1/4-inch galvanized hardware cloth
Poured in place concrete (if required)	MSHA Mix No. 3; $f'_c = 3500$ psi @ 28 days, normal weight, air-entrained; reinforcing to meet ASTM-615-60	n/a	on-site testing of poured-in-place concrete required: 28 day strength and slump test; all concrete design (cast-in-place or pre-cast) not using previously approved State or local standards requires design drawings sealed and approved by a professional structural engineer licensed in the State of Maryland - design to include meeting ACI Code 350.8.09; vertical loading (H-10 or H-20); allowable horizontal loading (based on soil pressures); and analysis of potential cracking
Sand	AASHTO-M-6 or ASTM-C-33	0.02" to 0.04"	Sand substitutions such as Diabase and Graystone (AASHTO #10) are not acceptable. No calcium carbonated or dolomitic sand substitutions are acceptable. No "rock dust" can be used for sand.

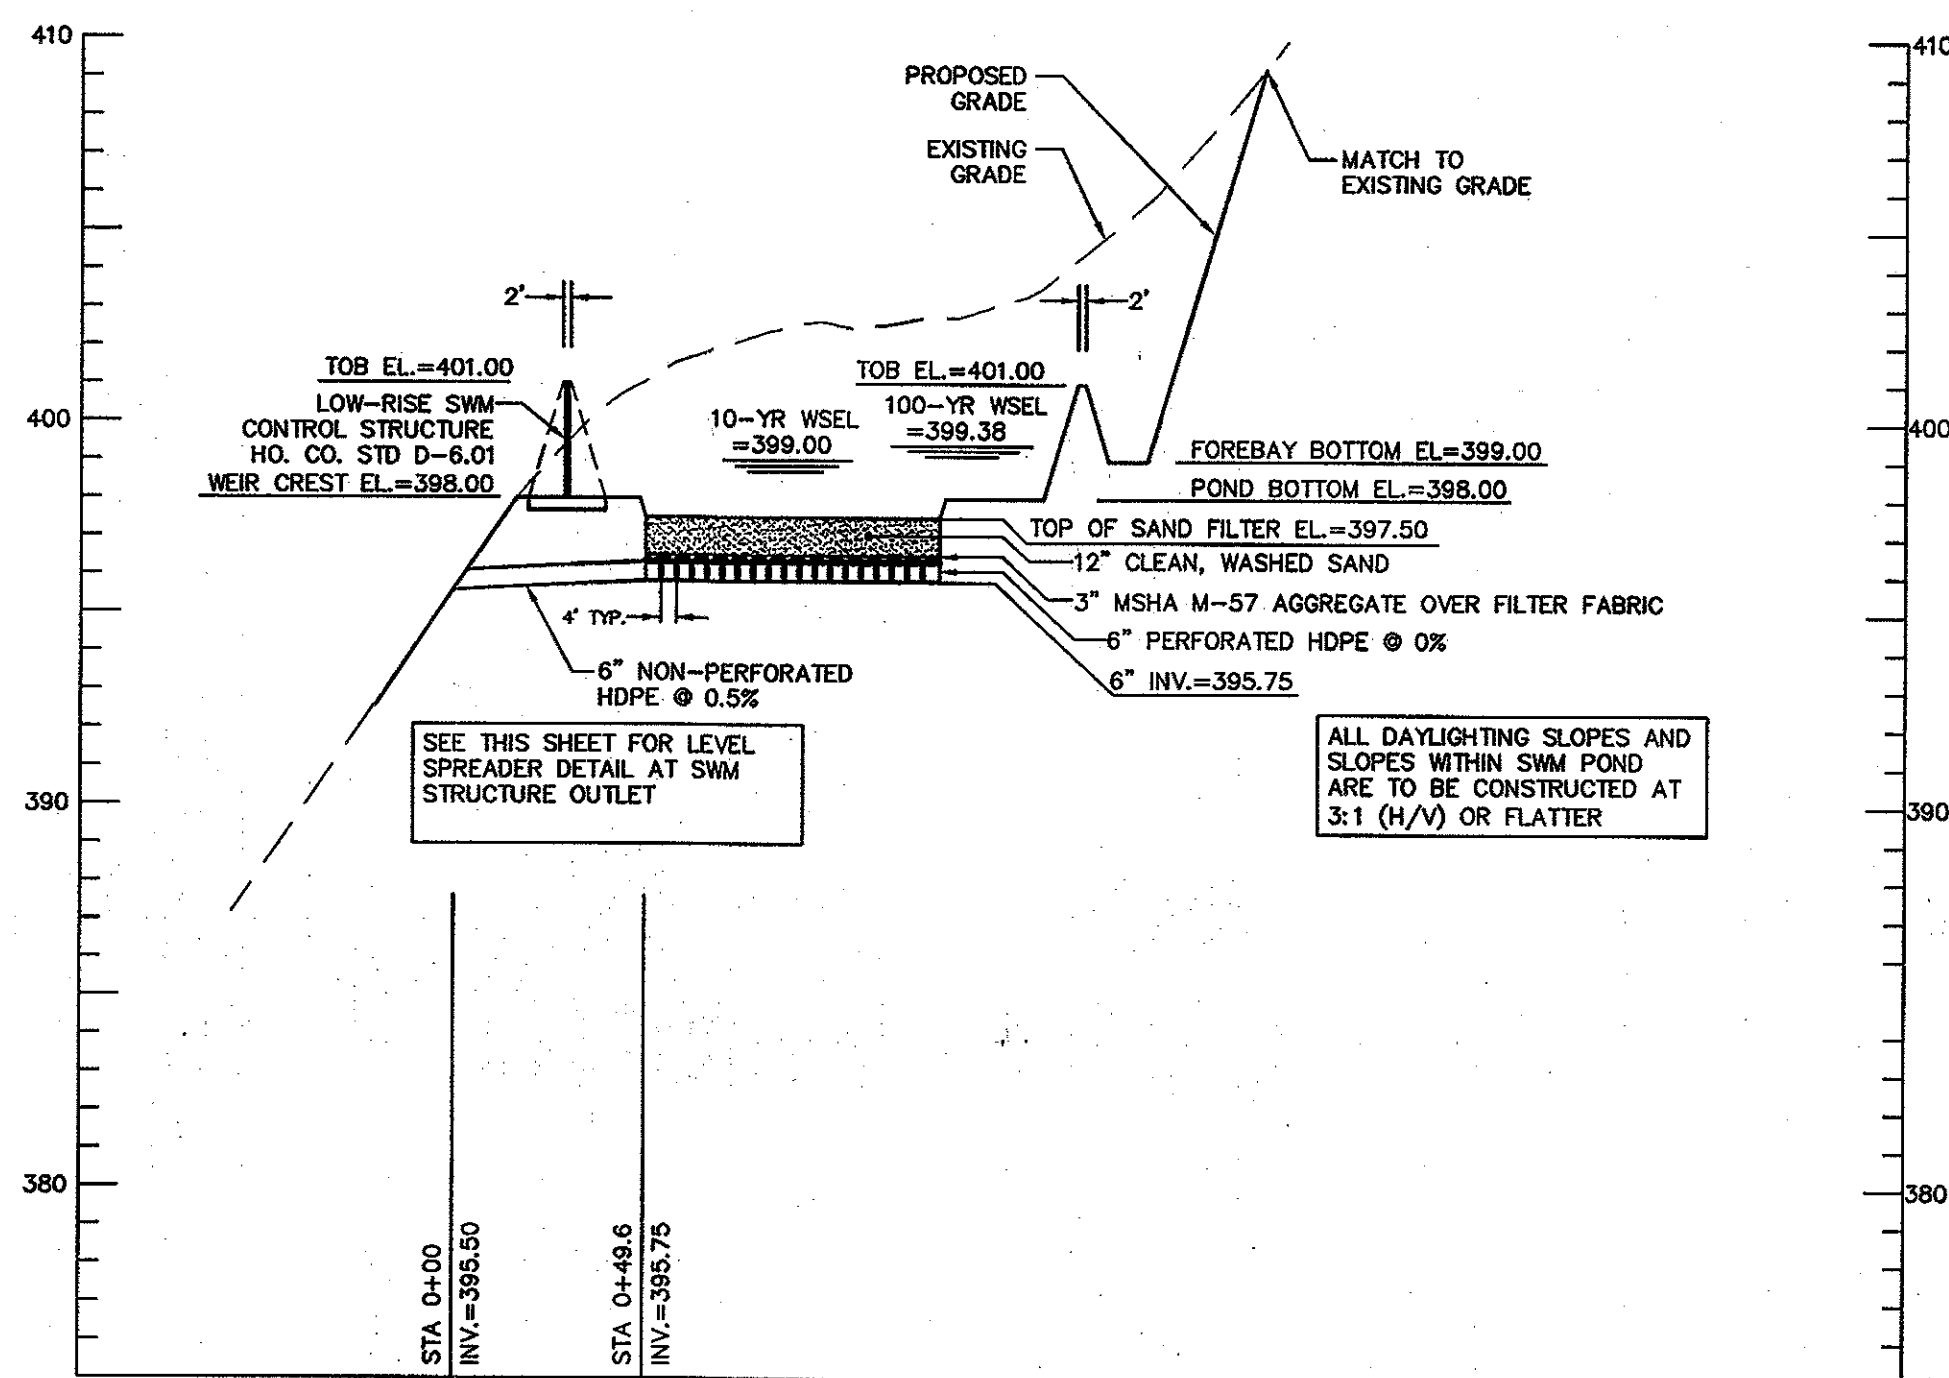

SECTION - SWM POND 2

SCALE: 1"=50' HOR
1"=5' VER

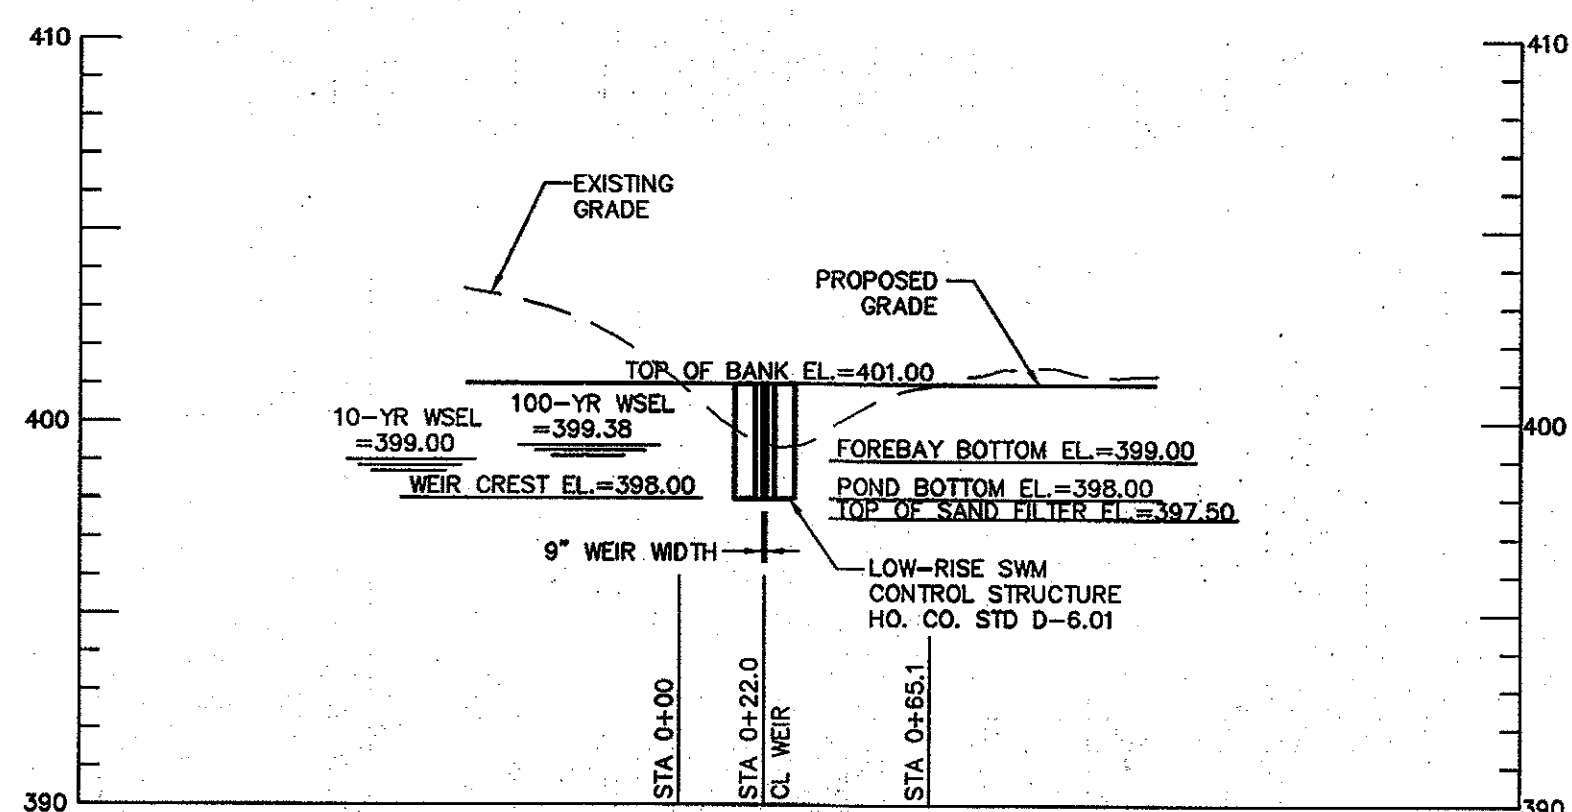


PROFILE - CL EMBANKMENT SWM POND 2

SCALE: 1"=50' HOR
1"=5' VER

POND DATA:

HAZARD CLASSIFICATION: N/A (NON MD-378)
F-1, SAND FILTER
DRAINAGE AREA: 0.93 Ac
PROPOSED RC: 68
PROPOSED TC: 11.5 MINS.
SAND FILTER AREA: 120 SF
10-YR Q: 3.65 CFS
10-YR WSEL: 399.00
100-YR Q: 6.00 CFS
100-YR WSEL: 399.38
WQV + Rev REQUIRED: 3,009 CF
WQV + Rev PROVIDED: 3,274 CF (INCLUDING FOREBAY)
MAINTENANCE: JOINTLY MAINTAINED
OWNERSHIP: PRIVATE

SWM POND AND MICRO-BIORETENTION FACILITY 'MB-2A' ARE TO BE PUBLICLY OWNED AND JOINTLY MAINTAINED. ALL OTHER MICRO-BIORETENTION FACILITIES ARE TO BE PRIVATELY OWNED AND MAINTAINED.

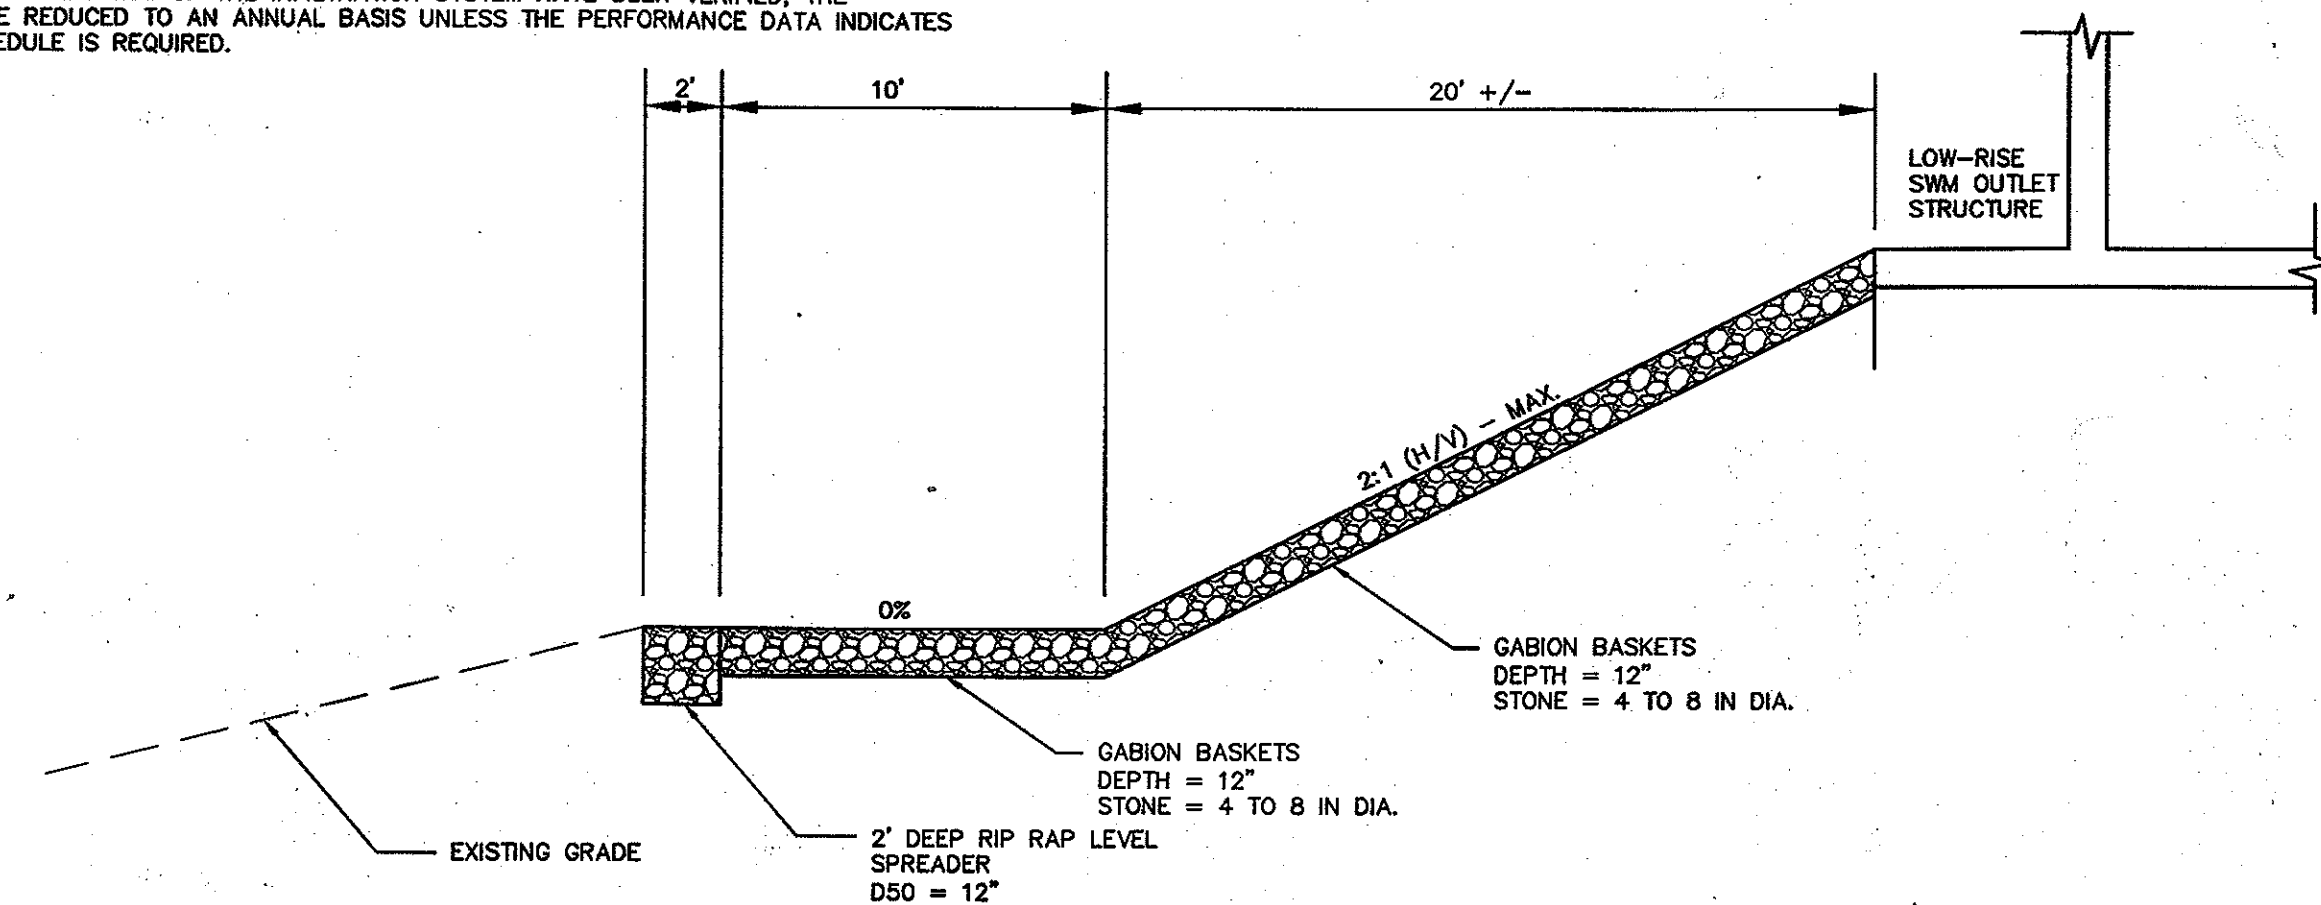

LEVEL SPREADER DETAIL


N.T.S.

PLANT LIST

QUANTITY	SYMBOL	BOTANICAL NAME	COMMON NAME	SIZE
1	○	PLATANUS OCCIDENTALIS	AMERICAN SYCAMORE	2-1/2" - 3" CAL.
1	○	ILEX GLABRA	INK BERRY	2' - 3' HT.
6	○	LOBELIA SPIRULICA	GREAT BLUE LOBELIA	1 GAL. CONTAINER
4	○	ONOCLEA SENSIBILIS	SENSITIVE FERN	1 GAL. CONTAINER
3	○	ASTER NOVAE-ANGIAE	NEW ENGLAND ASTER	1 GAL. CONTAINER


TOTAL: 13 PERENNIALS, 1 SHRUB, 1 TREE (PER EACH FACILITY EXCEPT FOR MB-2A)

FOR MICROBIOTRETENTION FACILITY MB-2A, QUANTITY FOR EACH PERENNIALS IS TO BE DOUBLED FROM WHAT IS SHOWN IN THE CHART

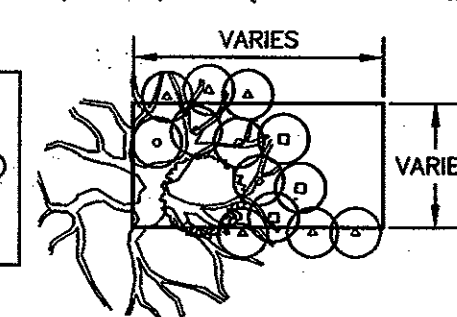


MICRO-BIORETENTION PLANTING DETAIL

N.T.S.

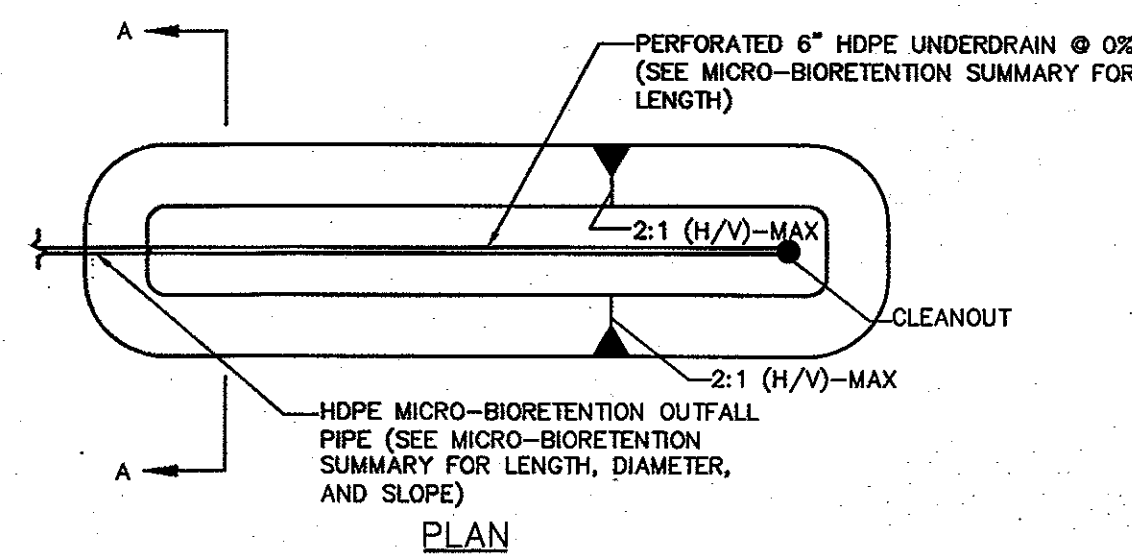


PLAN

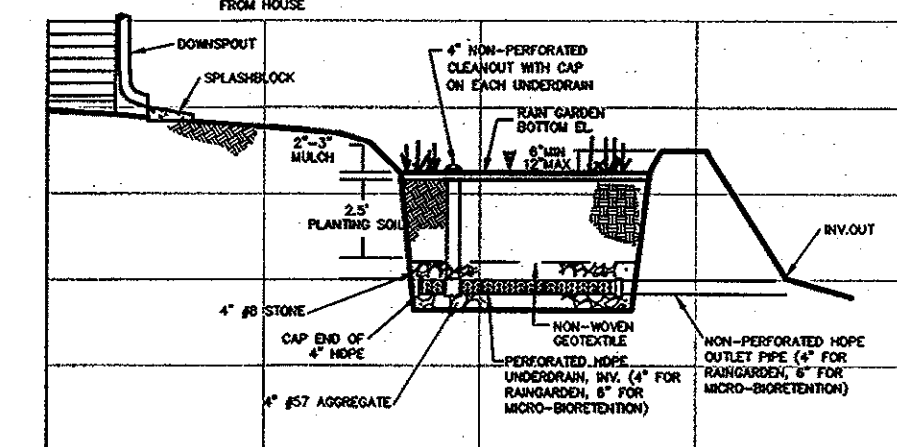

NOT TO SCALE

TYPICAL MICRO-BIORETENTION DETAILS

NOTE: THIS SHEET REPLACES SHEET 6 OF 15 OF THE PREVIOUSLY APPROVED PLANS (F-07-110) BY BENCHMARK ENGINEERING

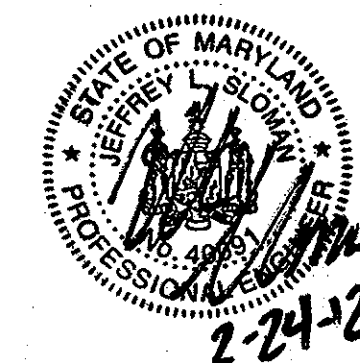

PROFESSIONAL CERTIFICATION

I hereby certify that these documents were prepared or approved by me, and that I am a duly licensed professional engineer under the laws of the State of Maryland, License No. 40091
Expiration Date 2-13-2013

OWNER/DEVELOPER

3304 VIEW TOP, LLC
1055 WEST JOPPA ROAD
ADT, MD
TOWSON, MARYLAND 21204
ATTN: LUYSELL, HAWES

THIS DEVELOPMENT PLAN IS APPROVED FOR SOIL EROSION AND SEDIMENT CONTROL BY THE HOWARD COUNTY CONSERVATION DISTRICT.

HOWARD COUNTY CONSERVATION DISTRICT

APPROVED: HOWARD COUNTY DEPARTMENT OF PUBLIC WORKS

W. J. M. H. 4-16-12
CHIEF, BUREAU OF HIGHWAYS

APPROVED: HOWARD COUNTY DEPARTMENT OF PLANNING AND ZONING

4/27/12
CHIEF, DEVELOPMENT ENGINEERING DIVISION

4/30/12
CHIEF, DIV. ENGINEER

MICRO-BIORETENTION FACILITY SUMMARY

FACILITY	BIORETENTION SURFACE AREA (A1) / DIMENSIONS	TOP OF MULCH EL.	UNDERDRAIN DIA. & OUTFALL PIPE DIA.	UNDERDRAIN INV. EL.	PERFORATED HDPE UNDERDRAIN LENGTH	HDPE MICROBIOTRETENTION OUTFALL LENGTH (TO CONNECTION PIPE OR OUTFALL)	HDPE MICROBIOTRETENTION OUTFALL ELEVATION (CONNECTION PIPE OR OUTFALL)	HDPE MICROBIOTRETENTION OUTFALL SLOPE (TO CONNECTION PIPE OR OUTFALL)	TOP OF BANK EL.
MB-1A	300 SF (15'x10' EACH COMPONENT)	405.00	6"	402.00	14 LF (EACH COMPONENT)	57 LF, 19 LF	398.00, 395.90	10.5%, 32.1%	406.00
MB-1B	300 SF (15'x10' EACH COMPONENT)	400.00	6"	397.00	14 LF (EACH COMPONENT)	111 LF, 41 LF	388.05, 387.40	8.1%, 23.4%	401.00
MB-1C	400 SF (40'x10')	392.00	6"	389.00	39 LF	65 LF	377.70	17.4%	393.00
MB-1D	335 SF (33.5'x10')	374.00	6"	371.00	32 LF	26 LF	370.75	1.0%	375.00
MB-3	300 SF (15'x10' EACH COMPONENT)	398.00	6"	395.00	14 LF (EACH COMPONENT)	65 LF, 94 LF	394.00	1.5%, 1.1%	399.00
MB-4	400 SF (20'x10' EACH COMPONENT)	403.00	6"	400.00	19 LF (EACH COMPONENT)	15 LF, 67 LF	399.80	1.3%, 0.3%	404.00

NOTE: EACH MICRO-BIORETENTION DESIGNATION ("MB-1A, MB-3", ETC.) REPRESENTS THE ONE OR TWO MICRO-BIORETENTION COMPONENTS ON EACH LOT

Project	date	SEP 2011
10-024	illustration	JIS
	scale	JIS
	approval	AS SHOWN

Δ	ADDED NOTE REGARDING FACILITY OWNERSHIP	2/2/2012
Δ	RESPOND TO HOWARD COUNTY COMMENTS	1/19/2012
Δ	RESPOND TO HCSD COMMENTS	12/15/2011
Δ	RESPOND TO HOWARD COUNTY COMMENTS	11/2/2011
no.	description	date

HAWES PROPERTY
LOTS 3 THRU 8, O.S. LOT 9, AND NON-BUILDABLE BULK PARCEL 'A'
TAX MAP 24 GRID 17 PARCEL 253
2nd ELECTION DISTRICT
HOWARD COUNTY, MARYLAND
MICRO-BIORETENTION AND SWM POND SECTIONS AND DETAILS

MILDENBERG, BOENDER & ASSOC., INC.
Engineers Planners Surveyors
6800 Deepwater Road, Suite 150, Ellicott City, Maryland 21075
(410) 997-0286 Fax: (410) 997-0288 Fax