



PRICE: \$17.00 - 21.00 SF/YR

WALL TOWERS | EAST & WEST

201-203 W Wall St, Midland, TX 79701

Stephanie Gauthier

Agent | Transaction Coordinator | Marketing Specialist
214.450.9398
stephanie@moriahgroup.net

Wes Gotcher

Broker | President
432.682.2510
wes@moriahgroup.net

Trey Dennis

Broker
432.236.7500
trey@moriahgroup.net

PRICE: \$17.00 - 21.00 SF/YR

WALL TOWERS | EAST & WEST

201-203 W Wall St, Midland, TX 79701



Property Description

The East Tower built in 1963 consists of 9 stories for a total of 66,000 SF. The West Tower built in 1968 consists of 12 stories for a total of 123,513 SF.

Location Description

Located in Downtown Midland, the two Wall Towers (East and West) are full of history and character. With recent downtown development, these office buildings are within walking distance to the newly built Centennial Park, Pi Social, Opal's Table, and Cancun Bar and Grill.

Offering Summary

Lease Rate:	\$17.00 - 21.00 SF/yr
Available SF:	521 - 5,616 SF
Lot Size:	0.55 Acres
Building Size:	189,216 SF

Stephanie Gauthier

Agent | Transaction Coordinator | Marketing Specialist
214.450.9398
stephanie@moriahgroup.net

Wes Gotcher

Broker | President
432.682.2510
wes@moriahgroup.net

Trey Dennis

Broker
432.236.7500
trey@moriahgroup.net



PRICE: \$17.00 - 21.00 SF/YR

WALL TOWERS | EAST & WEST

201-203 W Wall St, Midland, TX 79701

AVAILABLE SPACES

Suite	Tenant	Size (SF)	Lease Type	Lease Rate
West Tower Suite 309	Available	1,629 SF	Modified Gross	\$19.00 SF/yr
West Tower Suite 330	Available	1,453 SF	Modified Gross	\$18.00 SF/yr
West Tower Suite 524	Available	2,557 SF	Modified Gross	\$19.00 SF/yr
West Tower Suite 601	Available	2,970 SF	Modified Gross	\$18.00 SF/yr
West Tower Suite 808	Available	5,616 SF	Modified Gross	\$20.00 SF/yr
West Tower Suite 920	Available	2,272 SF	Modified Gross	\$18.00 SF/yr
West Tower Suite 1002	Available	1,531 SF	Modified Gross	\$21.00 SF/yr
West Tower Suite 1004	Available	1,056 SF	Modified Gross	\$19.00 SF/yr
West Tower Suite 1006	Available	1,801 SF	Modified Gross	\$19.00 SF/yr
East Tower Suite 345	Available	521 SF	Modified Gross	\$17.00 SF/yr
East Tower Suite 400	Available	1,857 SF	Modified Gross	\$19.00 SF/yr
East Tower Suite 403	Available	3,908 SF	Modified Gross	\$19.75 SF/yr
East Tower Suite 515	Available	810 SF	Modified Gross	\$17.00 SF/yr
East Tower Suite 517	Available	667 SF	Modified Gross	\$17.00 SF/yr
East Tower Suite 530	Available	2,181 SF	Modified Gross	\$18.00 SF/yr
East Tower Suite 804	Available	2,322 SF	Modified Gross	\$20.00 SF/yr

Stephanie Gauthier

Agent | Transaction Coordinator | Marketing Specialist
214.450.9398
stephanie@moriahgroup.net

Wes Gotcher

Broker | President
432.682.2510
wes@moriahgroup.net

Trey Dennis

Broker
432.236.7500
trey@moriahgroup.net



PRICE: \$17.00 - 21.00 SF/YR

WALL TOWERS | EAST & WEST

201-203 W Wall St, Midland, TX 79701



Map data ©2024 Imagery ©2024 Airbus, Maxar Technologies, USDA/FPAC/GEO

Stephanie Gauthier

Agent | Transaction Coordinator | Marketing Specialist
214.450.9398
stephanie@moriahgroup.net

Wes Gotcher

Broker | President
432.682.2510
wes@moriahgroup.net

Trey Dennis


Broker
432.236.7500
trey@moriahgroup.net

MORIAH
BROKERAGE SERVICES, LLC

PRICE: \$17.00 - 21.00 SF/YR

WALL TOWERS | WEST 3RD FLOOR | SUITE 309

201-203 W Wall St, Midland, TX 79701

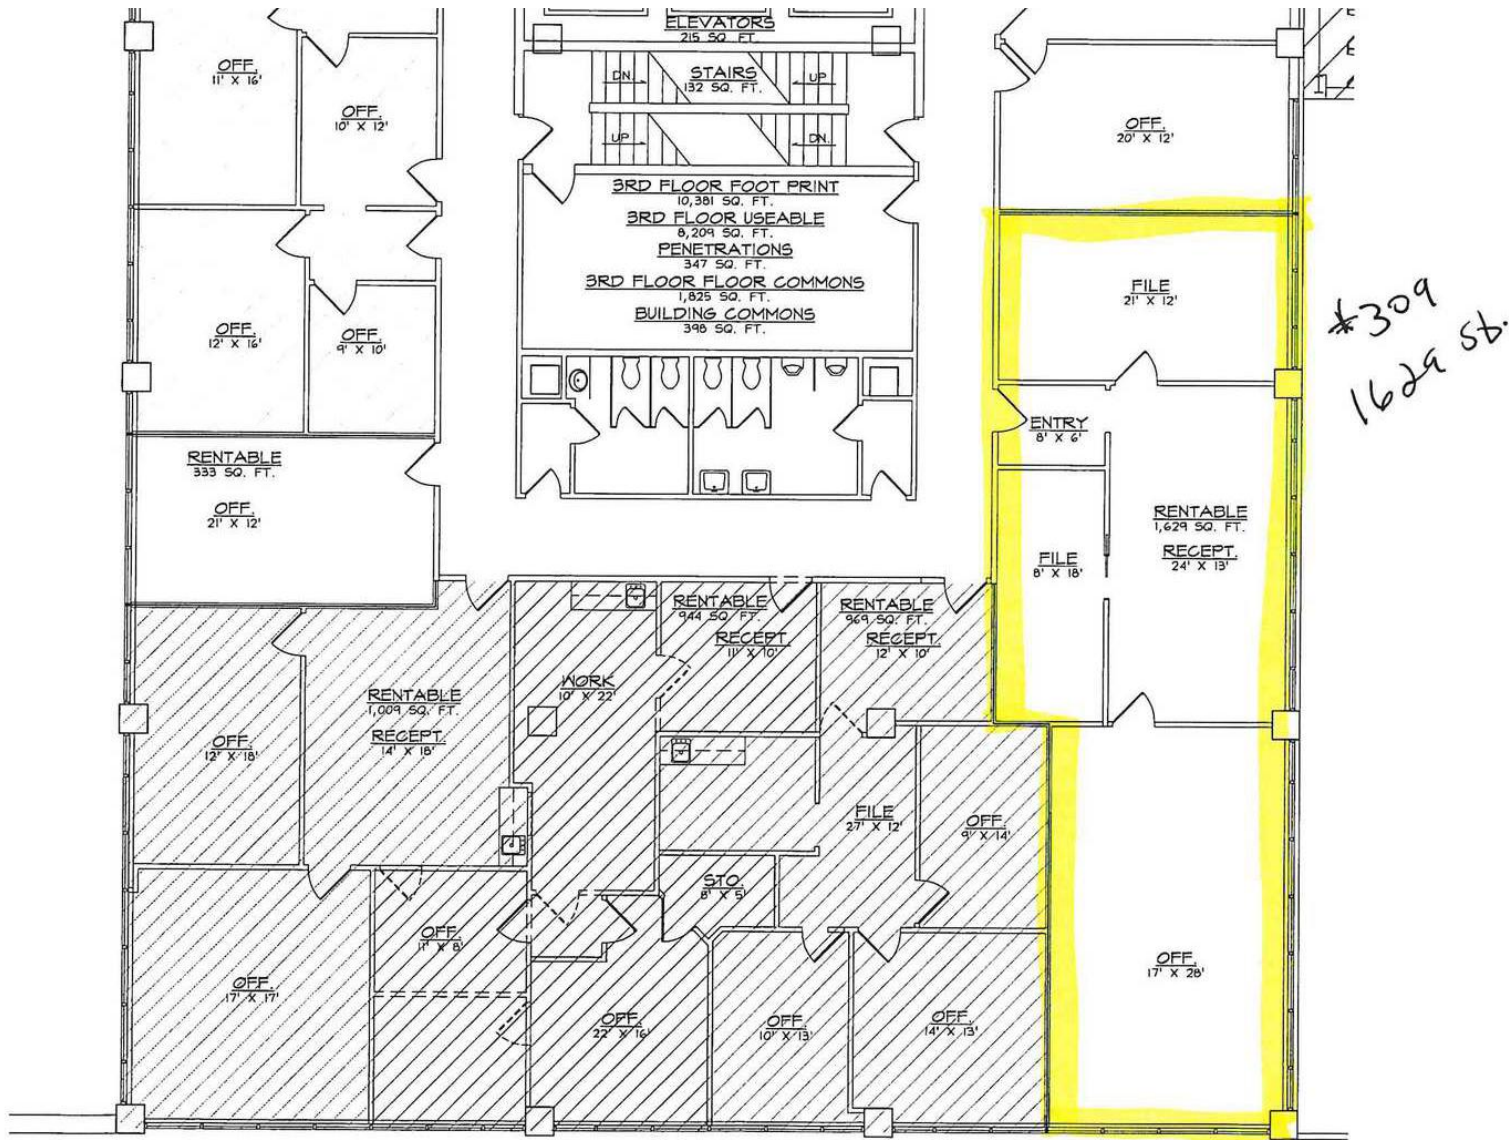

Stephanie Gauthier

Agent | Transaction Coordinator | Marketing Specialist
214.450.9398
stephanie@moriahgroup.net

Wes Gotcher

Broker | President
432.682.2510
wes@moriahgroup.net

Trey Dennis


Broker
432.236.7500
trey@moriahgroup.net

MORIAH
BROKERAGE SERVICES, LLC

PRICE: \$17.00 - 21.00 SF/YR

WALL TOWERS | WEST 3RD FLOOR | SUITE 309 | *BEING REMODELED

201-203 W Wall St, Midland, TX 79701

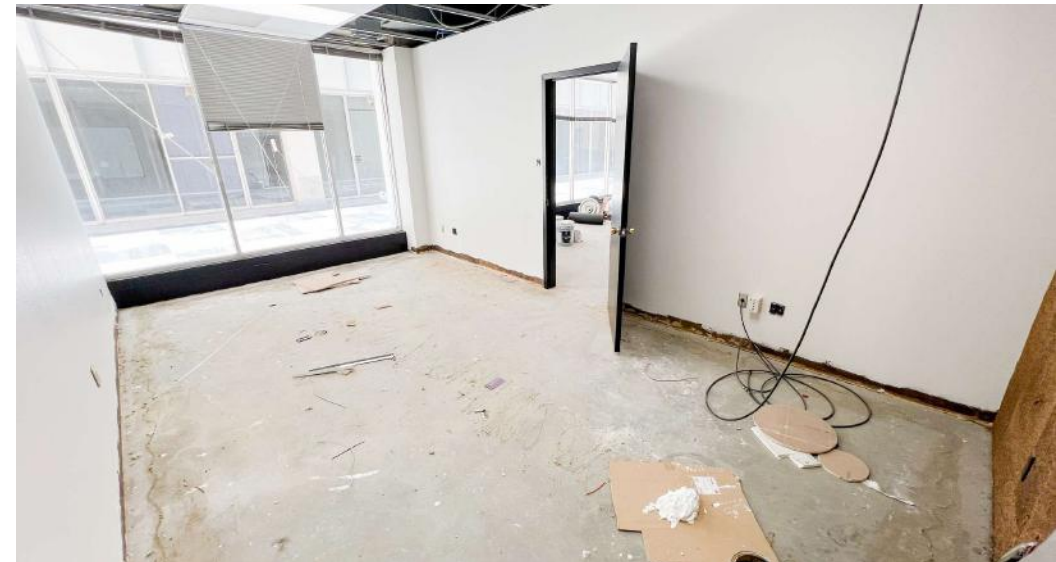

Stephanie Gauthier

Agent | Transaction Coordinator | Marketing Specialist
214.450.9398
stephanie@moriahgroup.net

Wes Gotcher

Broker | President
432.682.2510
wes@moriahgroup.net

Trey Dennis


Broker
432.236.7500
trey@moriahgroup.net

MORIAH
BROKERAGE SERVICES, LLC

PRICE: \$17.00 - 21.00 SF/YR

WALL TOWERS | WEST 3RD FLOOR | SUITE 330

201-203 W Wall St, Midland, TX 79701

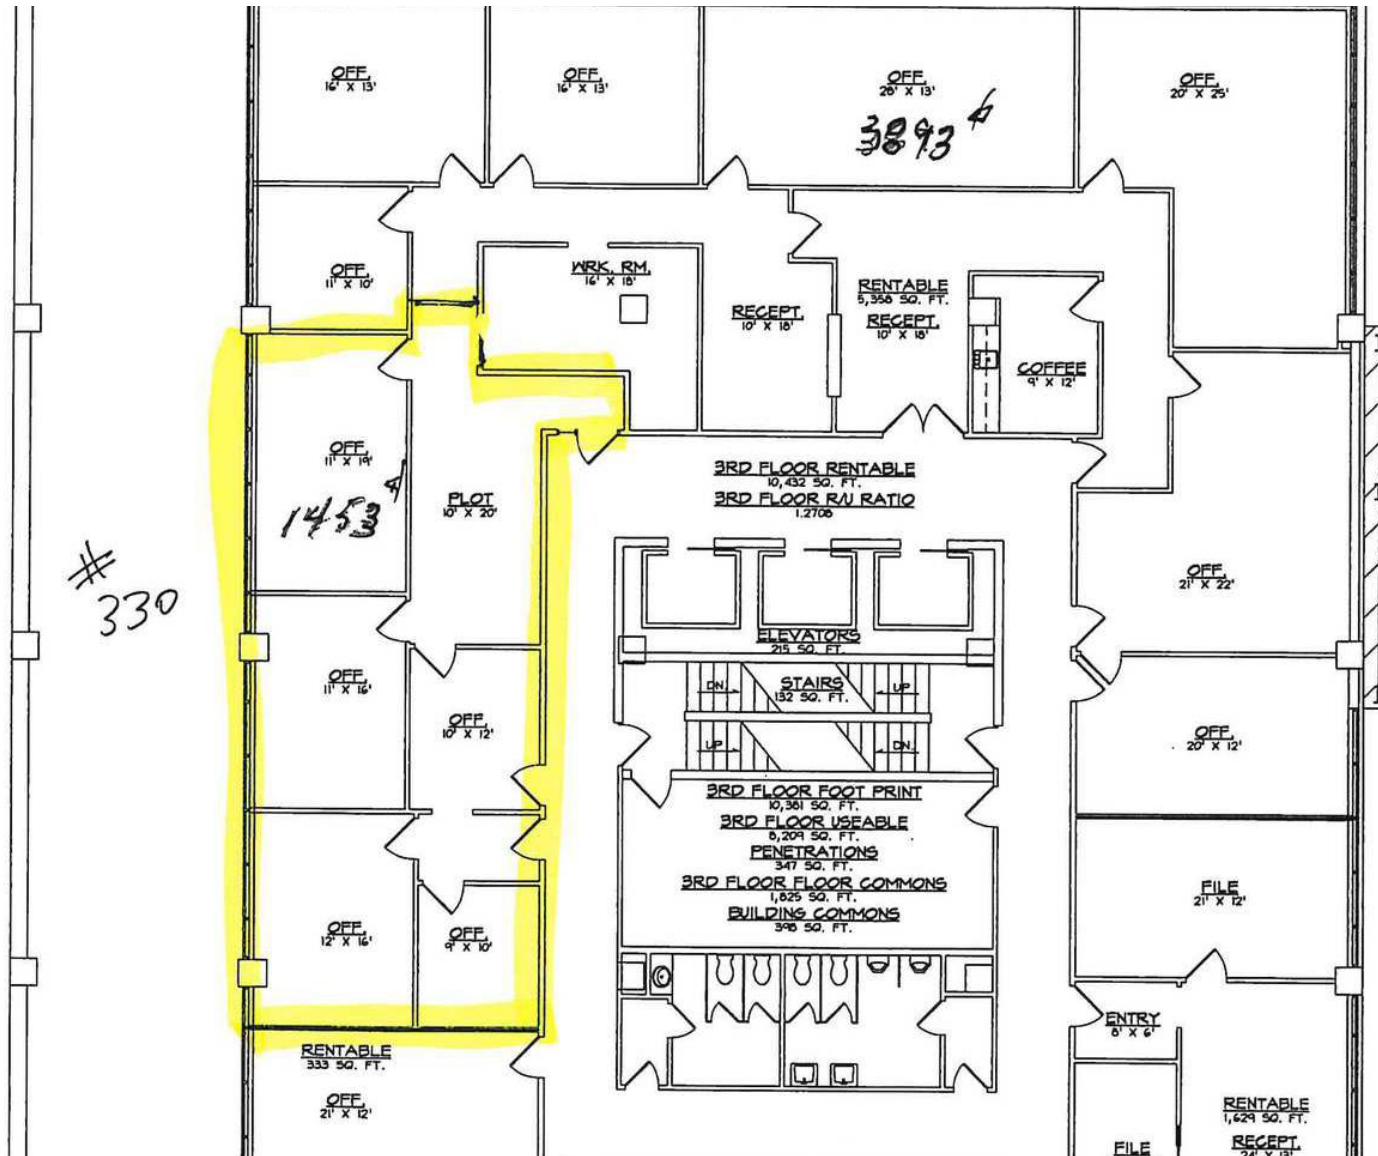

Stephanie Gauthier

Agent | Transaction Coordinator | Marketing Specialist
214.450.9398
stephanie@moriahgroup.net

Wes Gotcher

Broker | President
432.682.2510
wes@moriahgroup.net

Trey Dennis

Broker
432.236.7500
trey@moriahgroup.net

MORIAH
BROKERAGE SERVICES, LLC

PRICE: \$17.00 - 21.00 SF/YR

WALL TOWERS | WEST 3RD FLOOR | SUITE 330

201-203 W Wall St, Midland, TX 79701



Stephanie Gauthier

Agent | Transaction Coordinator | Marketing Specialist
214.450.9398
stephanie@moriahgroup.net

Wes Gotcher

Broker | President
432.682.2510
wes@moriahgroup.net

Trey Dennis


Broker
432.236.7500
trey@moriahgroup.net




PRICE: \$17.00 - 21.00 SF/YR

WALL TOWERS | WEST 5TH FLOOR | SUITE 524

201-203 W Wall St, Midland, TX 79701

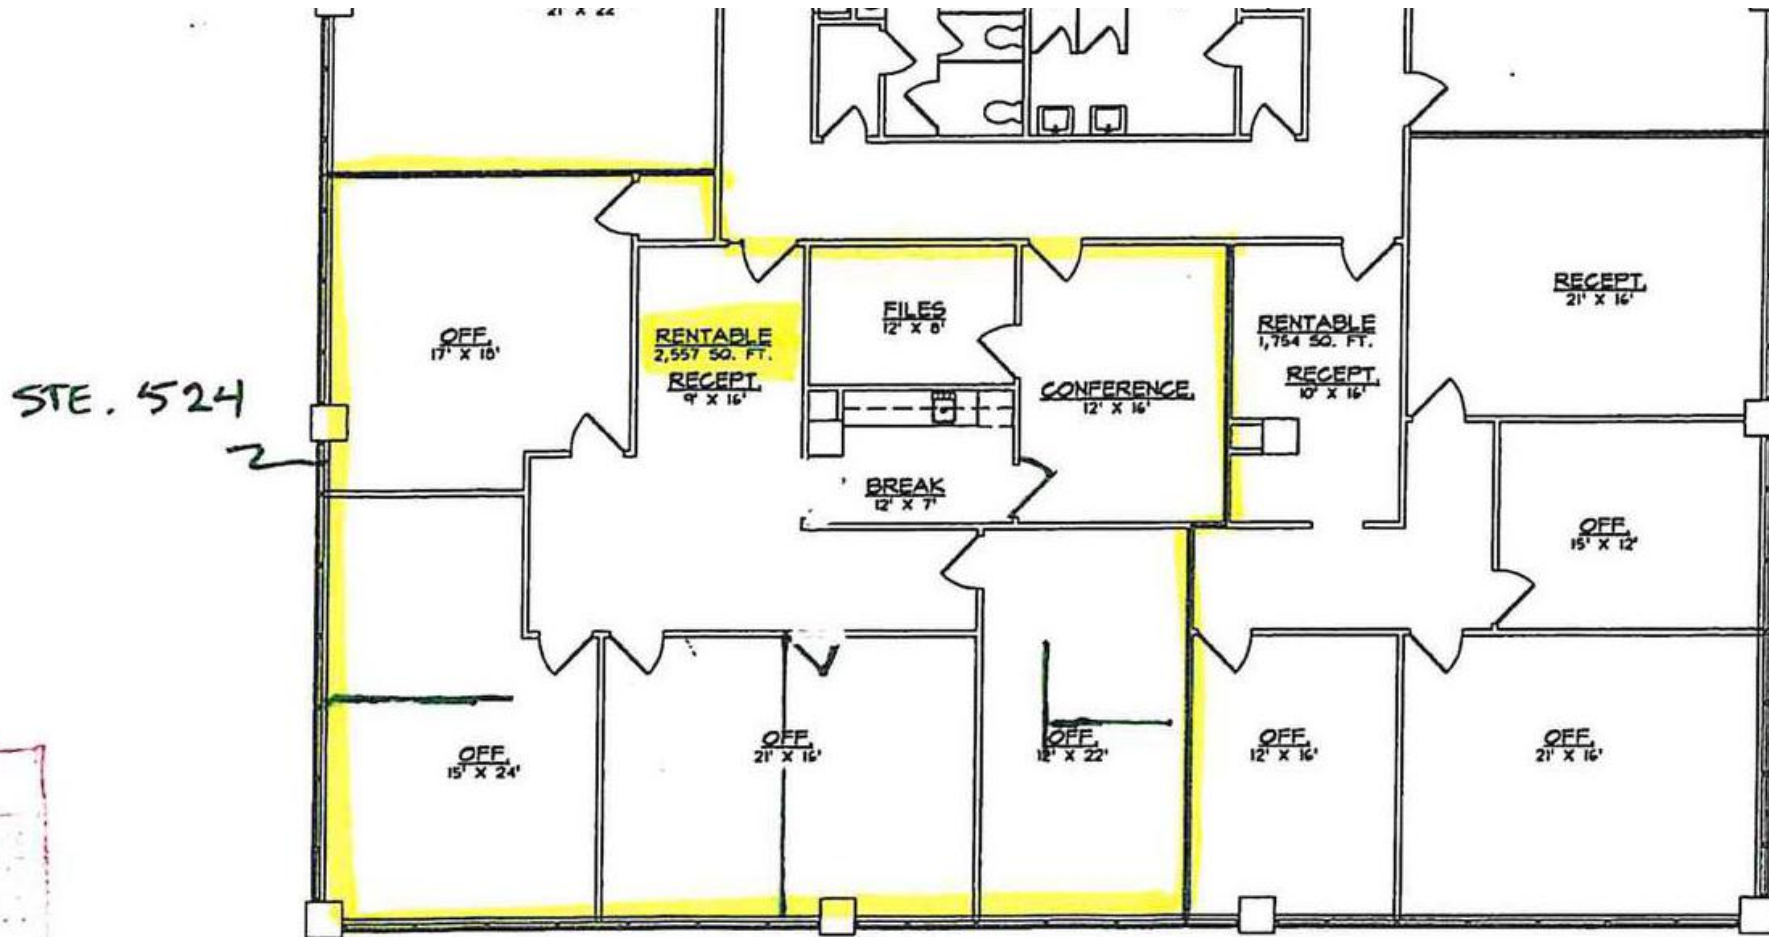

(A) AS-BUILT FLOOR PLAN
5TH FLOOR
N. T. S.

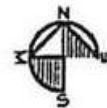

PREPARED BY:

J M DRAFTING & DESIGN

© COPYRIGHT, J M DRAFTING & DESIGN
2017 FEDERAL COPYRIGHT PRO-
TECTION, EXTENDING TO DERIVATIVE

Stephanie Gauthier

Agent | Transaction Coordinator | Marketing Specialist
214.450.9398
stephanie@moriahgroup.net

Wes Gotcher

Broker | President
432.682.2510
wes@moriahgroup.net

Trey Dennis

Broker
432.236.7500
trey@moriahgroup.net

MORIAH
BROKERAGE SERVICES, LLC

PRICE: \$17.00 - 21.00 SF/YR

WALL TOWERS | WEST 5TH FLOOR | SUITE 524

201-203 W Wall St, Midland, TX 79701



Stephanie Gauthier

Agent | Transaction Coordinator | Marketing Specialist
214.450.9398
stephanie@moriahgroup.net

Wes Gotcher

Broker | President
432.682.2510
wes@moriahgroup.net

Trey Dennis


Broker
432.236.7500
trey@moriahgroup.net



PRICE: \$17.00 - 21.00 SF/YR

WALL TOWERS | WEST 6TH FLOOR | SUITE 601

201-203 W Wall St, Midland, TX 79701

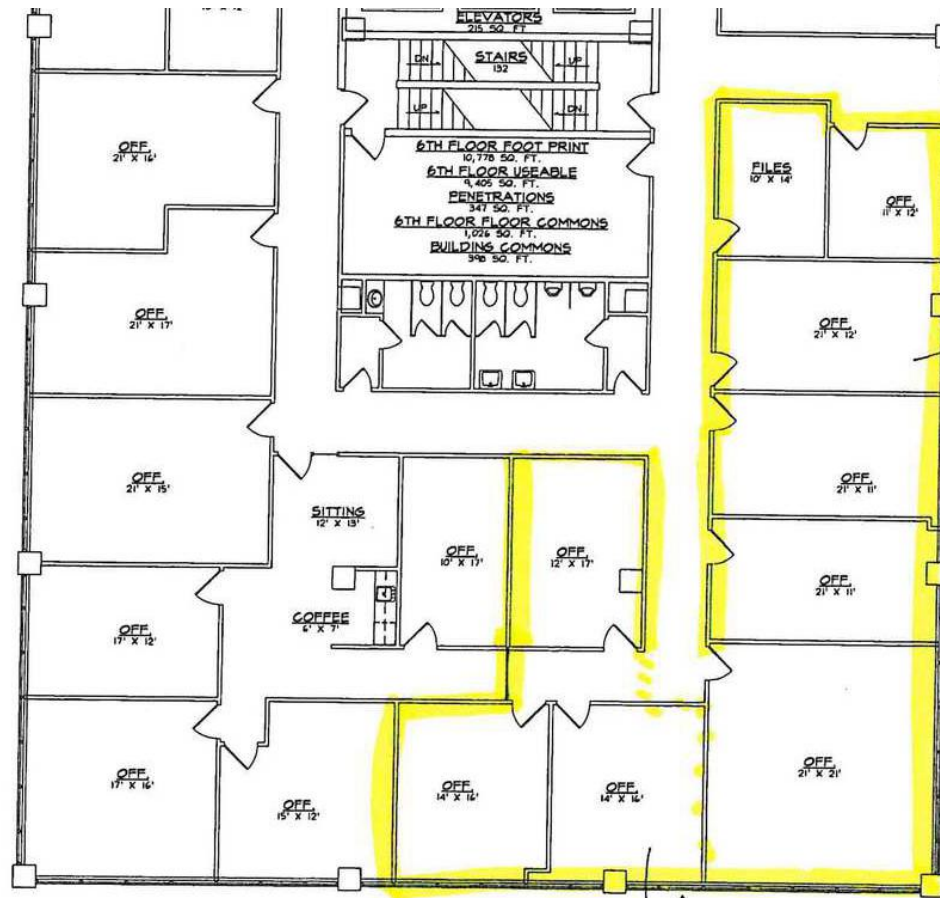

(A) AS-BUILT FLOOR PLAN
6TH FLOOR N. T. S.

PREPARED BY:
J M DRAFTING & DESIGN
NEW BUILDING FOR:
WALL TOWERS WEST
203 WALL STREET
MIDLAND TEXAS

© COPYRIGHT, J M DRAFTING & DESIGN
2017 FEDERAL COPYRIGHT PROTECTION EXTENDING TO DERIVATIVE PLANS, IS APPLICABLE TO INTENTIONAL AND UNINTENTIONAL INFRINGEMENTS AND PROVIDES FOR SPECIFIC STATUTORY DAMAGES BOTH CIVIL AND CRIMINAL. UNAUTHORIZED REPRODUCTION IN ANY FORM IS STRICTLY PROHIBITED AND FORBIDDEN.

DATE: MARCH 10, 2017
JOB = JM16056

1,223.6'

Stephanie Gauthier
Agent | Transaction Coordinator | Marketing Specialist
214.450.9398
stephanie@moriahgroup.net

Wes Gotcher
Broker | President
432.682.2510
wes@moriahgroup.net

Trey Dennis
Broker
432.236.7500
trey@moriahgroup.net



PRICE: \$17.00 - 21.00 SF/YR

WALL TOWERS | WEST 6TH FLOOR | SUITE 601

201-203 W Wall St, Midland, TX 79701



Stephanie Gauthier

Agent | Transaction Coordinator | Marketing Specialist
214.450.9398
stephanie@moriahgroup.net

Wes Gotcher

Broker | President
432.682.2510
wes@moriahgroup.net

Trey Dennis


Broker
432.236.7500
trey@moriahgroup.net

MORIAH
BROKERAGE SERVICES, LLC

PRICE: \$17.00 - 21.00 SF/YR

WALL TOWERS | WEST 8TH FLOOR | SUITE 808

201-203 W Wall St, Midland, TX 79701

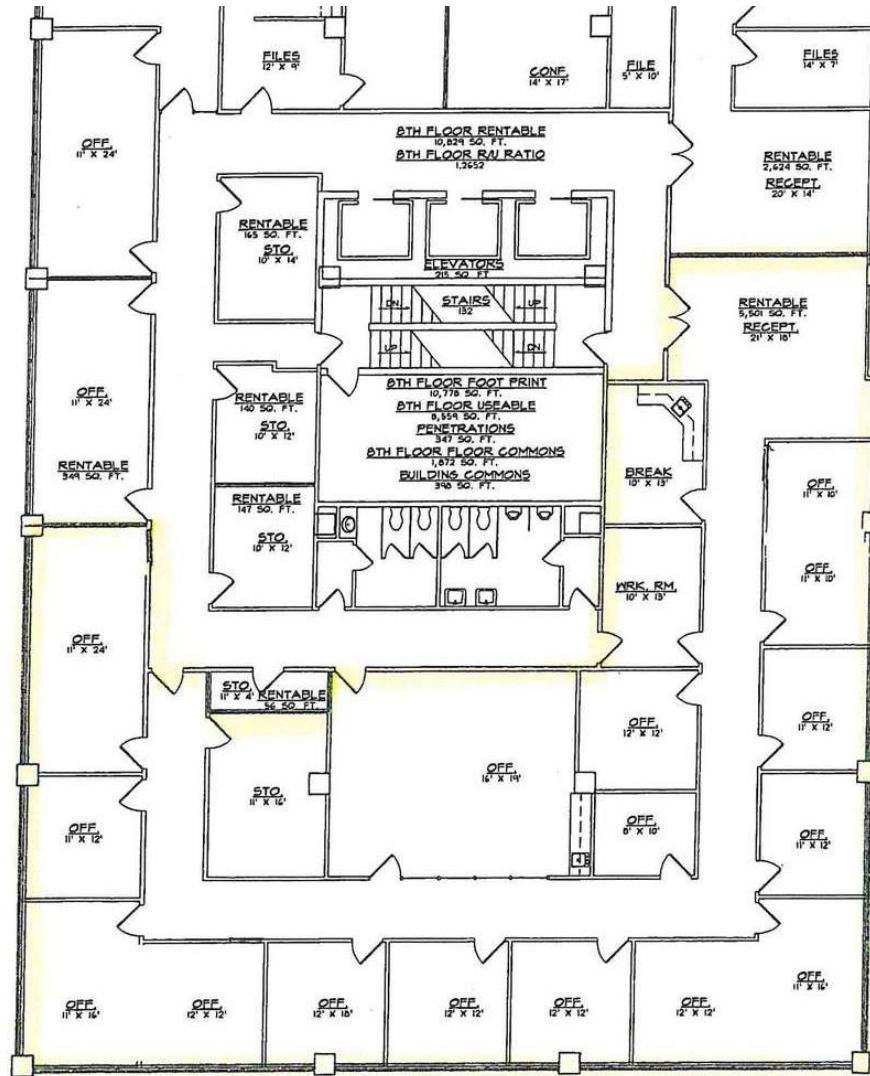

Suite
808

(A) AS-BUILT FLOOR PLAN
8TH FLOOR
N. T. S.

Stephanie Gauthier

Agent | Transaction Coordinator | Marketing Specialist
214.450.9398
stephanie@moriahgroup.net

Wes Gotcher

Broker | President
432.682.2510
wes@moriahgroup.net



Trey Dennis

Broker
432.236.7500
trey@moriahgroup.net

PRICE: \$17.00 - 21.00 SF/YR

WALL TOWERS | WEST 8TH FLOOR | SUITE 808

201-203 W Wall St, Midland, TX 79701

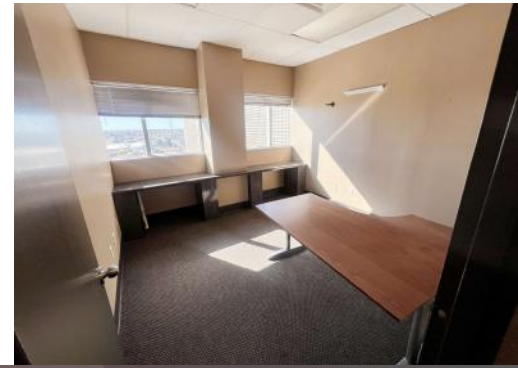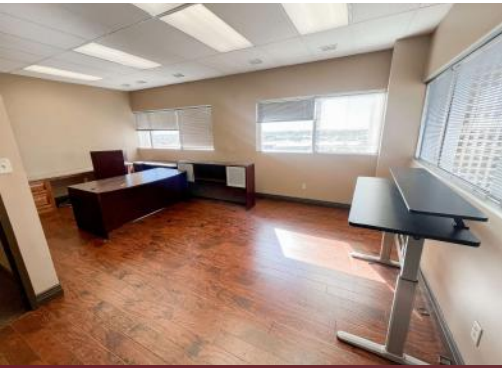

Stephanie Gauthier

Agent | Transaction Coordinator | Marketing Specialist
214.450.9398
stephanie@moriahgroup.net

Wes Gotcher

Broker | President
432.682.2510
wes@moriahgroup.net

Trey Dennis


Broker
432.236.7500
trey@moriahgroup.net



PRICE: \$17.00 - 21.00 SF/YR

WALL TOWERS | WEST 9TH FLOOR | SUITE 920

201-203 W Wall St, Midland, TX 79701

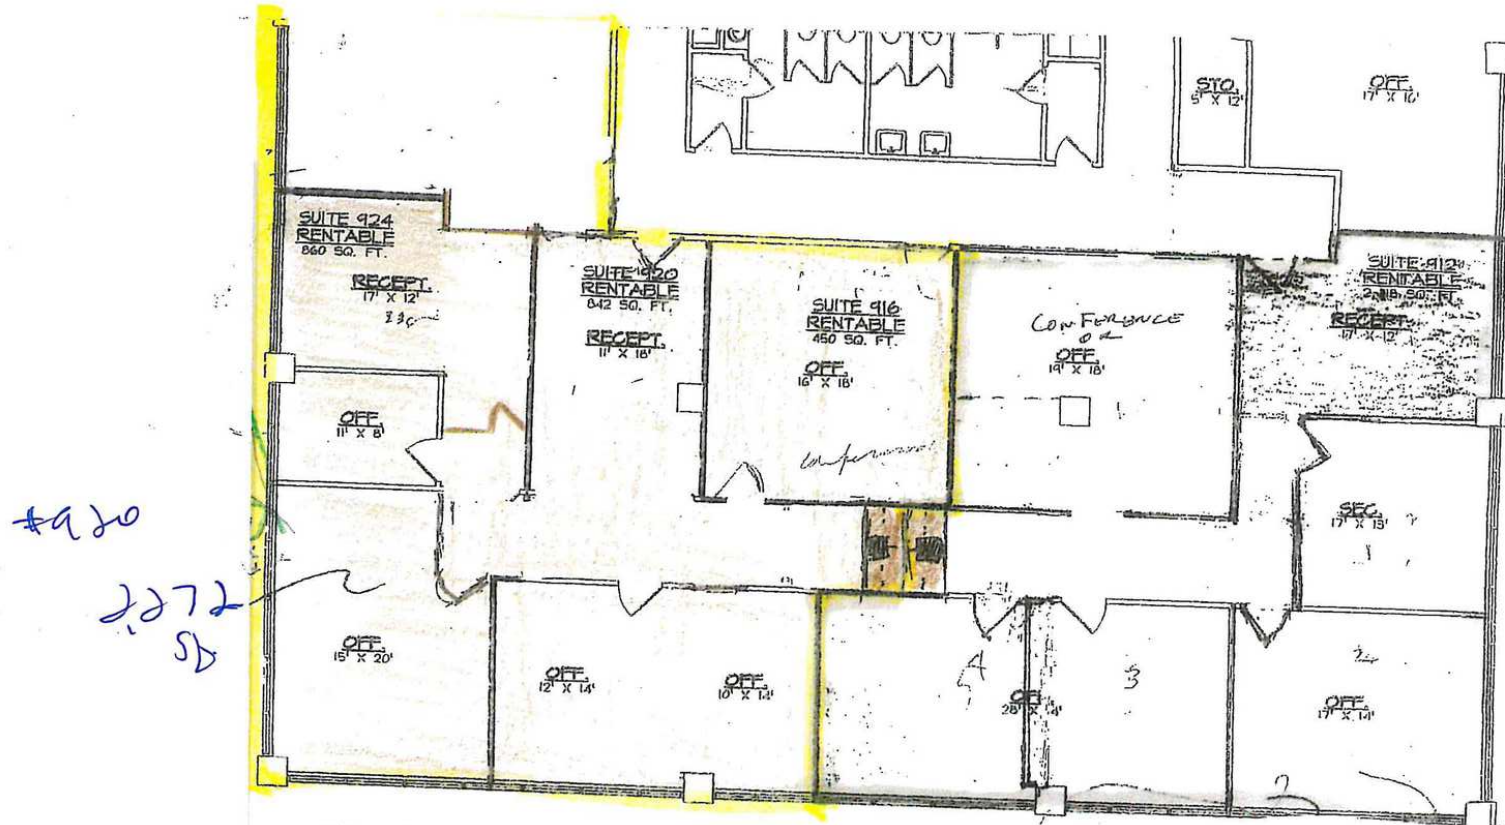

Ⓐ AS-BUILT FLOOR PLAN
9TH FLOOR - SE CORNER
N. T. S.



PREPARED BY:
JM DRAFTING & DESIGN
NEW BUILDING FOR:
WALL TOWERS WEST
203 WALL STREET
MIDLAND TEXAS

© COPYRIGHT, J M DRAFTING & DESIGN
2011 FEDERAL COPYRIGHT PROTECTION EXTENDING TO DERIVATIVE PLANS, IS APPLICABLE TO INTENTIONAL AND UNINTENTIONAL INFRINGEMENTS AND PROVIDES FOR SPECIFIC STATUTORY DAMAGES BOTH CIVIL AND CRIMINAL. UNAUTHORIZED REPRODUCTION IN ANY FORM IS STRICTLY PROHIBITED AND FORBIDDEN.

DATE:
AUG. 10, 2011
G:\SERVICES\MIDLAND\DESIGN\920\920
JOB # JM11011

Stephanie Gauthier
Agent | Transaction Coordinator | Marketing Specialist
214.450.9398
stephanie@moriahgroup.net

Wes Gotcher
Broker | President
432.682.2510
wes@moriahgroup.net

Trey Dennis
Broker
432.236.7500
trey@moriahgroup.net

MORIAH
BROKERAGE SERVICES, LLC

PRICE: \$17.00 - 21.00 SF/YR

WALL TOWERS | WEST 9TH FLOOR | SUITE 920

201-203 W Wall St, Midland, TX 79701



Stephanie Gauthier

Agent | Transaction Coordinator | Marketing Specialist
214.450.9398
stephanie@moriahgroup.net

Wes Gotcher

Broker | President
432.682.2510
wes@moriahgroup.net


Trey Dennis

Broker
432.236.7500
trey@moriahgroup.net

PRICE: \$17.00 - 21.00 SF/YR

WALL TOWERS | WEST 10TH FLOOR | SUITE 1002

201-203 W Wall St, Midland, TX 79701

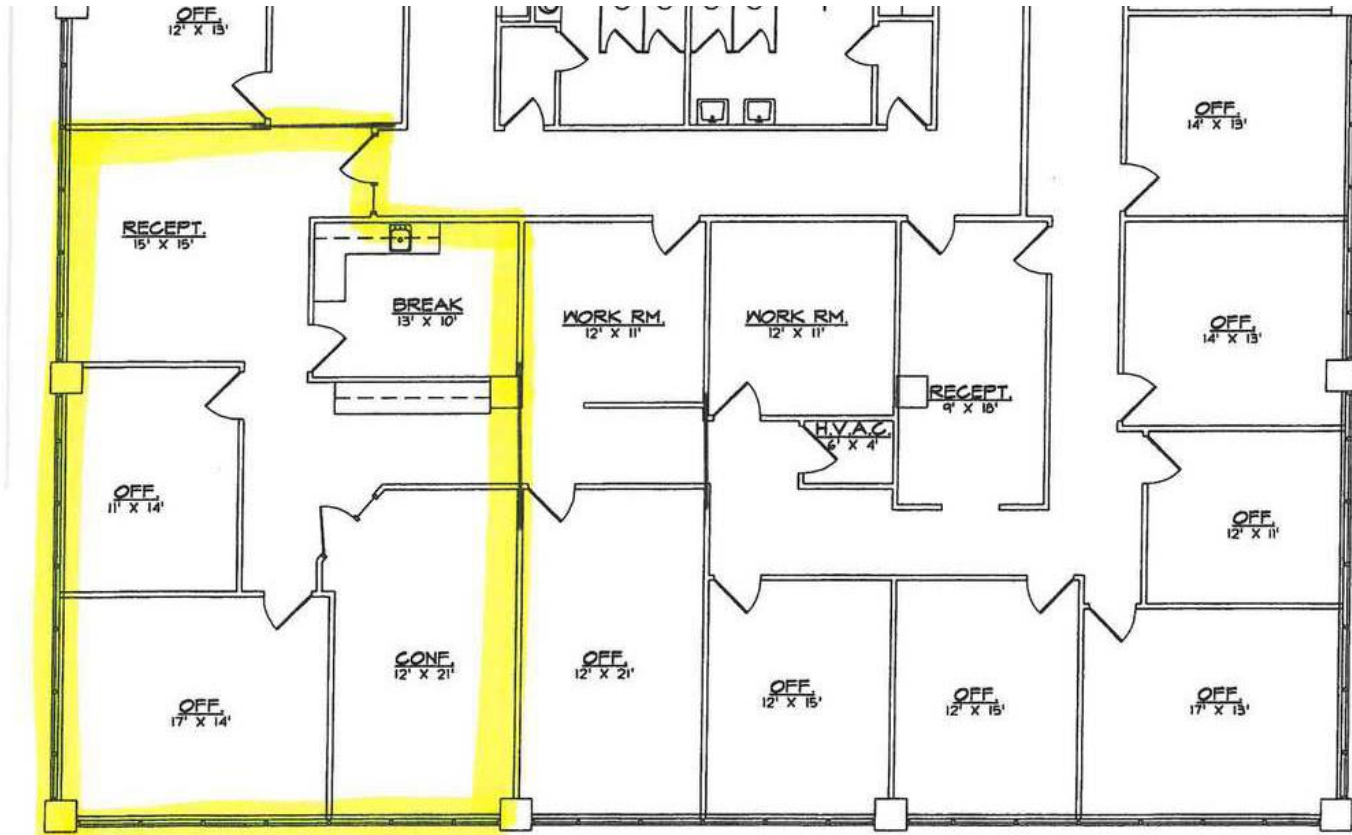

(A) AS-BUILT FLOOR PLAN
10TH FLOOR N. T. S.



PREPARED BY:
J M DRAFTING & DESIGN
NEW BUILDING FOR:
WALL TOWERS WEST
203 WALL STREET
MIDLAND TEXAS

© COPYRIGHT, J M DRAFTING & DESIGN
2017 FEDERAL COPYRIGHT PRO-
TECTION EXTENDING TO DERIVATIVE
PLANS, IS APPLICABLE TO INTEN-
TIONAL AND UNINTENTIONAL INFRINGE-
MENTS AND PROVIDES FOR SPECIFIC
STATUTORY DAMAGES BOTH CIVIL
AND CRIMINAL. UNAUTHORIZED REPRO-
DUCTION IN ANY FORM IS STRICTLY
PROHIBITED AND FORBIDDEN.

DATE:
MARCH 10, 2017
D:\2017\KeyComm\Wall Towers West-4
JOB # JM16055

Stephanie Gauthier
Agent | Transaction Coordinator | Marketing Specialist
214.450.9398
stephanie@moriahgroup.net

Wes Gotcher
Broker | President
432.682.2510
wes@moriahgroup.net


Trey Dennis
Broker
432.236.7500
trey@moriahgroup.net

MORIAH
BROKERAGE SERVICES, LLC

PRICE: \$17.00 - 21.00 SF/YR

WALL TOWERS | WEST 10TH FLOOR | SUITE 1004

201-203 W Wall St, Midland, TX 79701

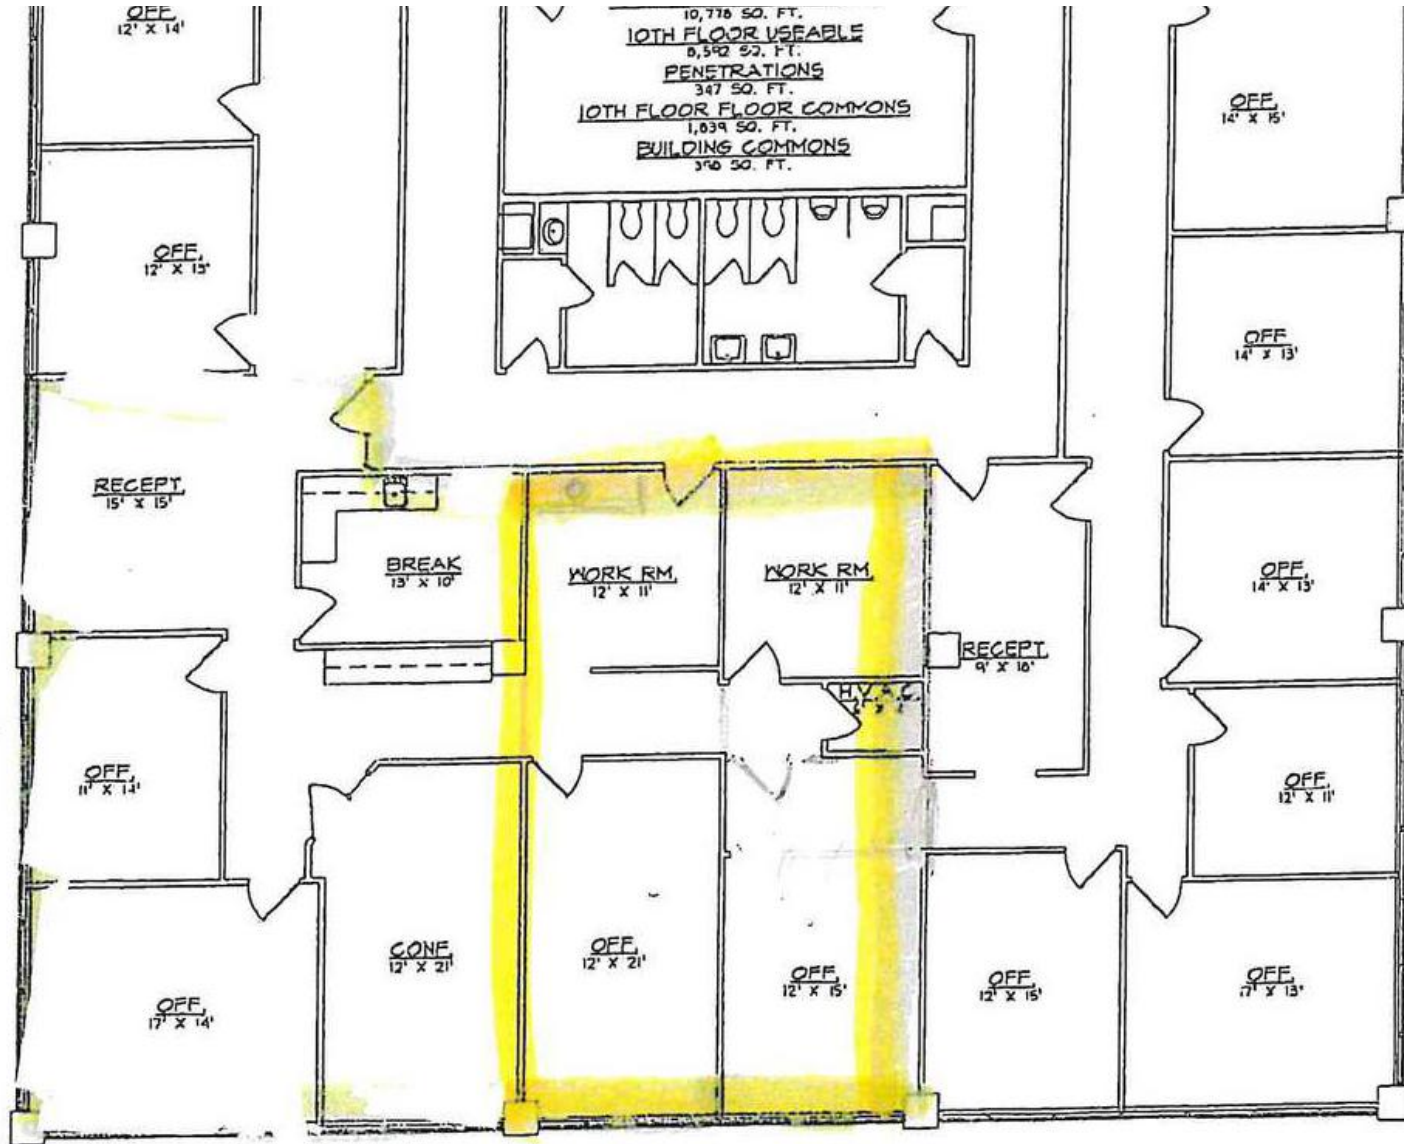

*10th floor
1004
1056 sq. ft.*

Stephanie Gauthier

Agent | Transaction Coordinator | Marketing Specialist
214.450.9398
stephanie@moriahgroup.net

Wes Gotcher

Broker | President
432.682.2510
wes@moriahgroup.net

Trey Dennis

Broker
432.236.7500
trey@moriahgroup.net

MORIAH
BROKERAGE SERVICES, LLC

PRICE: \$17.00 - 21.00 SF/YR

WALL TOWERS | WEST 10TH FLOOR | SUITE 1004

201-203 W Wall St, Midland, TX 79701



Stephanie Gauthier

Agent | Transaction Coordinator | Marketing Specialist
214.450.9398
stephanie@moriahgroup.net

Wes Gotcher

Broker | President
432.682.2510
wes@moriahgroup.net

Trey Dennis


Broker
432.236.7500
trey@moriahgroup.net



PRICE: \$17.00 - 21.00 SF/YR

WALL TOWERS | WEST 10TH FLOOR | SUITE 1006

201-203 W Wall St, Midland, TX 79701

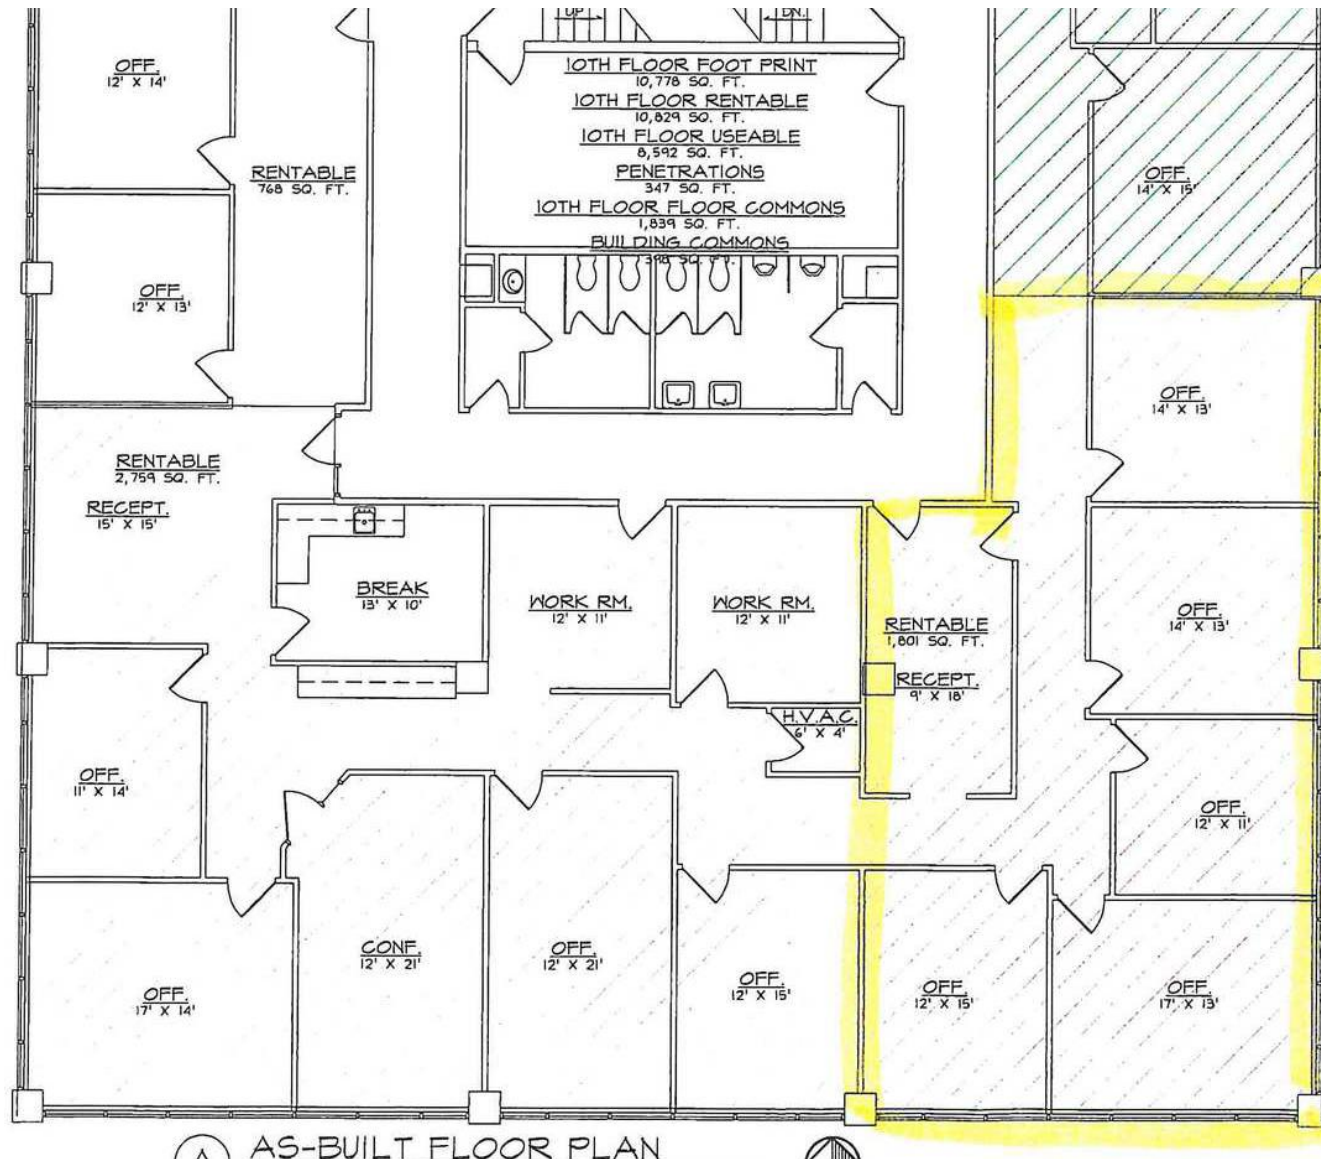

AS-BUILT FLOOR PLAN

Stephanie Gauthier

Agent | Transaction Coordinator | Marketing Specialist
214.450.9398
stephanie@moriahgroup.net

Wes Gotcher

Broker | President
432.682.2510
wes@moriahgroup.net

Trey Dennis

Broker
432.236.7500
trey@moriahgroup.net

MORIAH
BROKERAGE SERVICES, LLC

PRICE: \$17.00 - 21.00 SF/YR

WALL TOWERS | WEST 10TH FLOOR | SUITE 1006

201-203 W Wall St, Midland, TX 79701



Stephanie Gauthier

Agent | Transaction Coordinator | Marketing Specialist
214.450.9398
stephanie@moriahgroup.net

Wes Gotcher

Broker | President
432.682.2510
wes@moriahgroup.net

Trey Dennis


Broker
432.236.7500
trey@moriahgroup.net



PRICE: \$17.00 - 21.00 SF/YR

WALL TOWERS | EAST 3RD FLOOR | SUITE 345

201-203 W Wall St, Midland, TX 79701

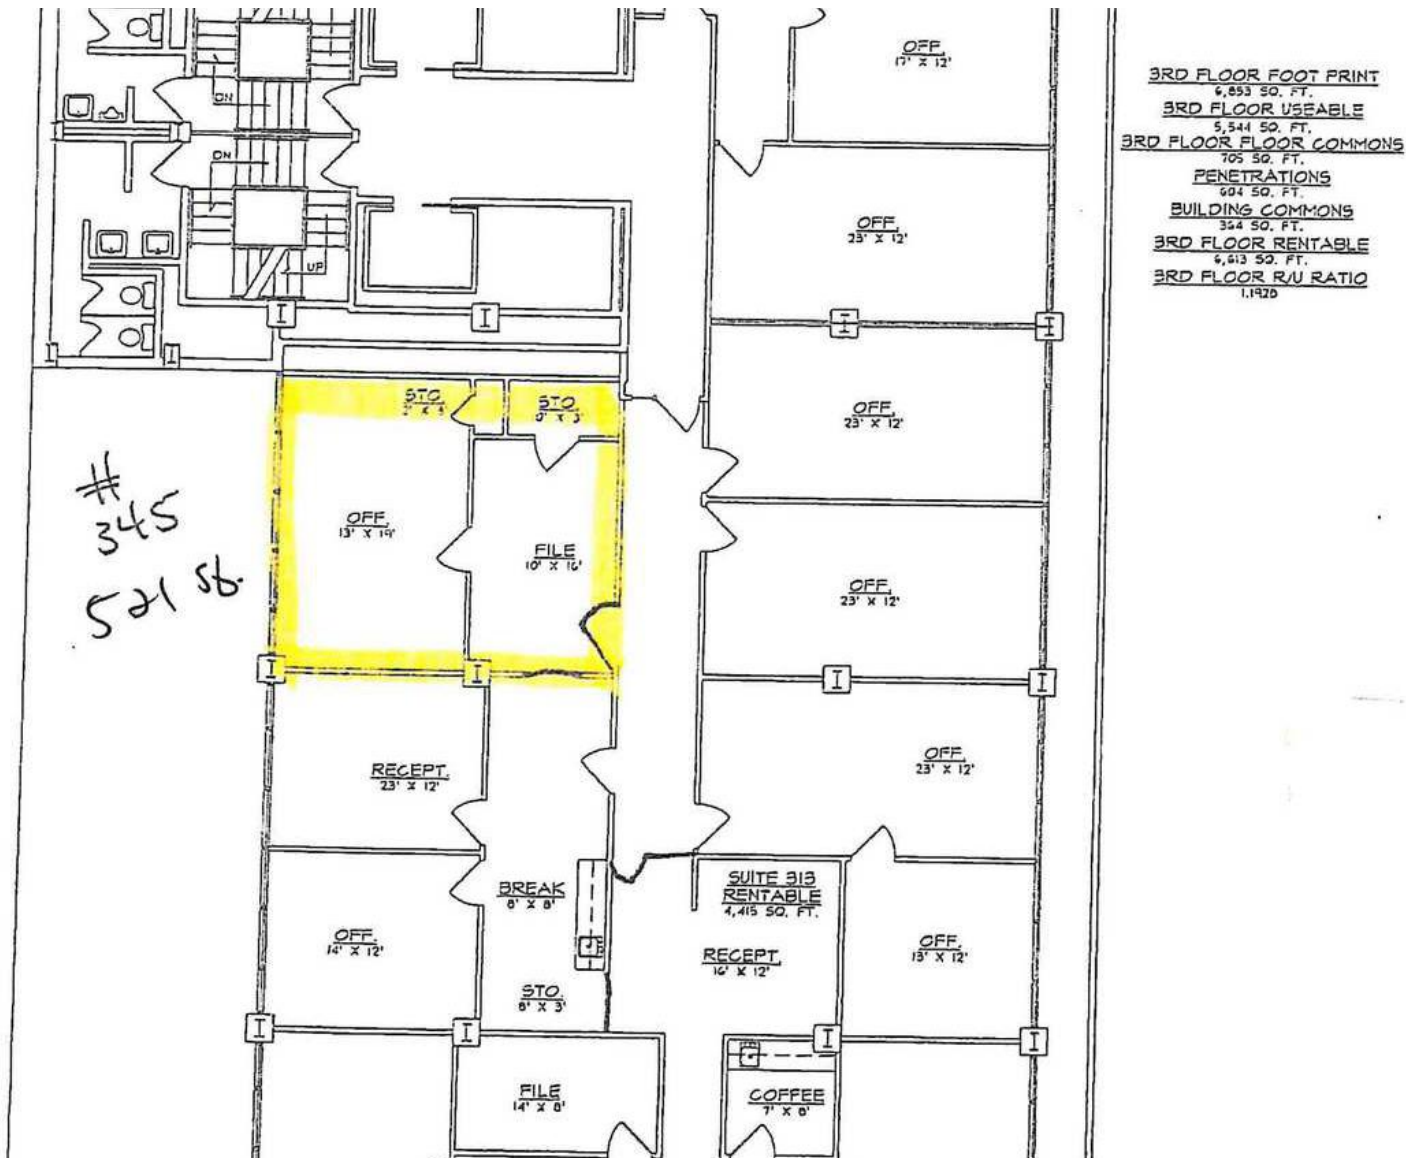

Stephanie Gauthier

Agent | Transaction Coordinator | Marketing Specialist
214.450.9398
stephanie@moriahgroup.net

Wes Gotcher

Broker | President
432.682.2510
wes@moriahgroup.net

Trey Dennis

Broker
432.236.7500
trey@moriahgroup.net

MORIAH
BROKERAGE SERVICES, LLC

PRICE: \$17.00 - 21.00 SF/YR

WALL TOWERS | EAST 3RD FLOOR | SUITE 345

201-203 W Wall St, Midland, TX 79701



Stephanie Gauthier

Agent | Transaction Coordinator | Marketing Specialist
214.450.9398
stephanie@moriahgroup.net

Wes Gotcher

Broker | President
432.682.2510
wes@moriahgroup.net

Trey Dennis

Broker
432.236.7500
trey@moriahgroup.net




PRICE: \$17.00 - 21.00 SF/YR

WALL TOWERS | EAST 4TH FLOOR | SUITE 400

201-203 W Wall St, Midland, TX 79701

S-BUILT FLOOR PLAN

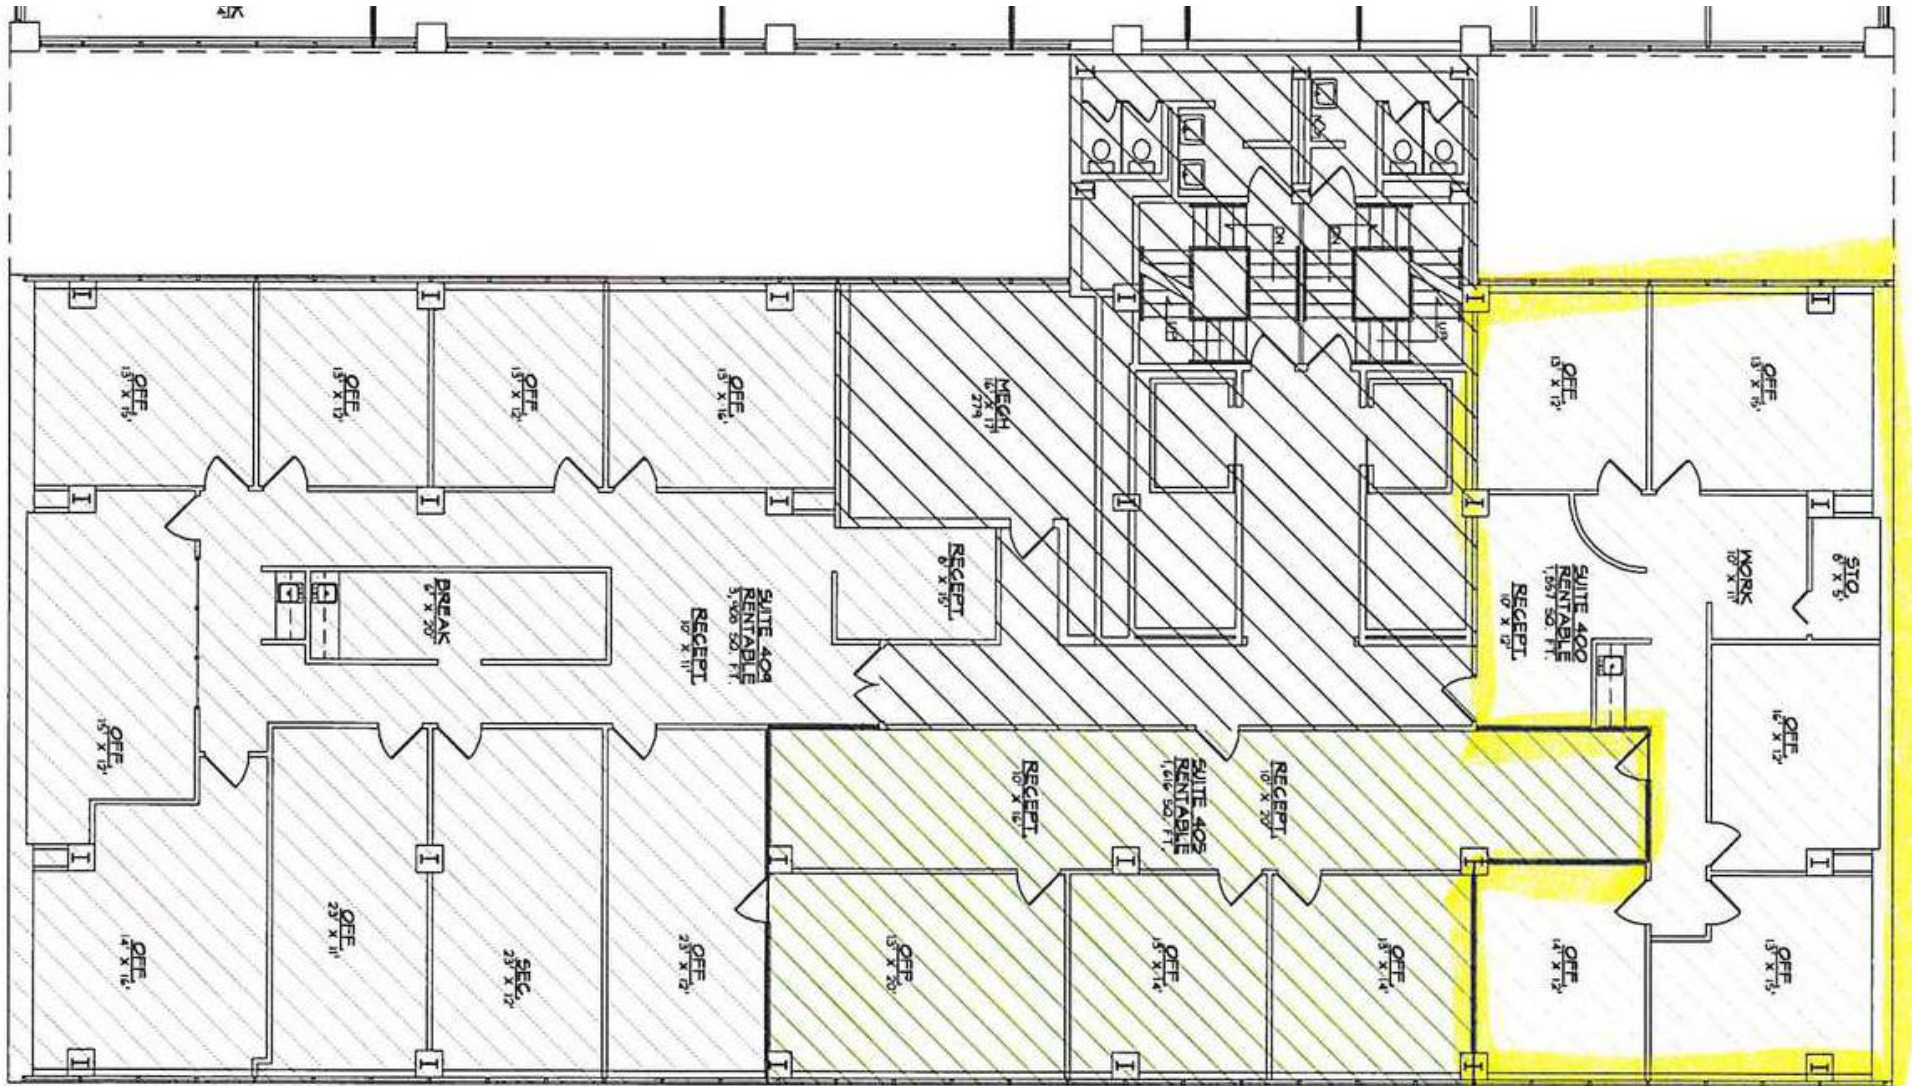

Stephanie Gauthier

Agent | Transaction Coordinator | Marketing Specialist
214.450.9398
stephanie@moriahgroup.net

Wes Gotcher

Broker | President
432.682.2510
wes@moriahgroup.net

Trey Dennis

Broker
432.236.7500
trey@moriahgroup.net

MORIAH
BROKERAGE SERVICES, LLC

PRICE: \$17.00 - 21.00 SF/YR

WALL TOWERS | EAST 4TH FLOOR | SUITE 400

201-203 W Wall St, Midland, TX 79701



Stephanie Gauthier

Agent | Transaction Coordinator | Marketing Specialist
214.450.9398
stephanie@moriahgroup.net

Wes Gotcher

Broker | President
432.682.2510
wes@moriahgroup.net

Trey Dennis

Broker
432.236.7500
trey@moriahgroup.net



PRICE: \$17.00 - 21.00 SF/YR

WALL TOWERS | EAST 4TH FLOOR | SUITE 403


201-203 W Wall St, Midland, TX 79701

PREPARED BY
DRAFTING & DESIGN
HIGH BUILDING FOR:
WALL TOWERS EAST & WEST
203 WALL STREET
TEXAS
MIDLAND

A AS-BUILT FLOOR PLAN
4TH FLOOR - EAST
N.T.S.

© COPYRIGHT, J.H. DRAFTING & DESIGN
THIS FEDERAL COPYRIGHT PROTECTED
DRAWING, IS APPLICABLE TO ALL
RENTALS, AND PROVIDED FOR SPECIFIC
AND/OR GENERAL LIMITED RIGHTS OF
REPRODUCTION IN ANY MANNER.
RENTAL IN ANY MANNER.

DATE: 04.2019
DRAWN BY: JH11021

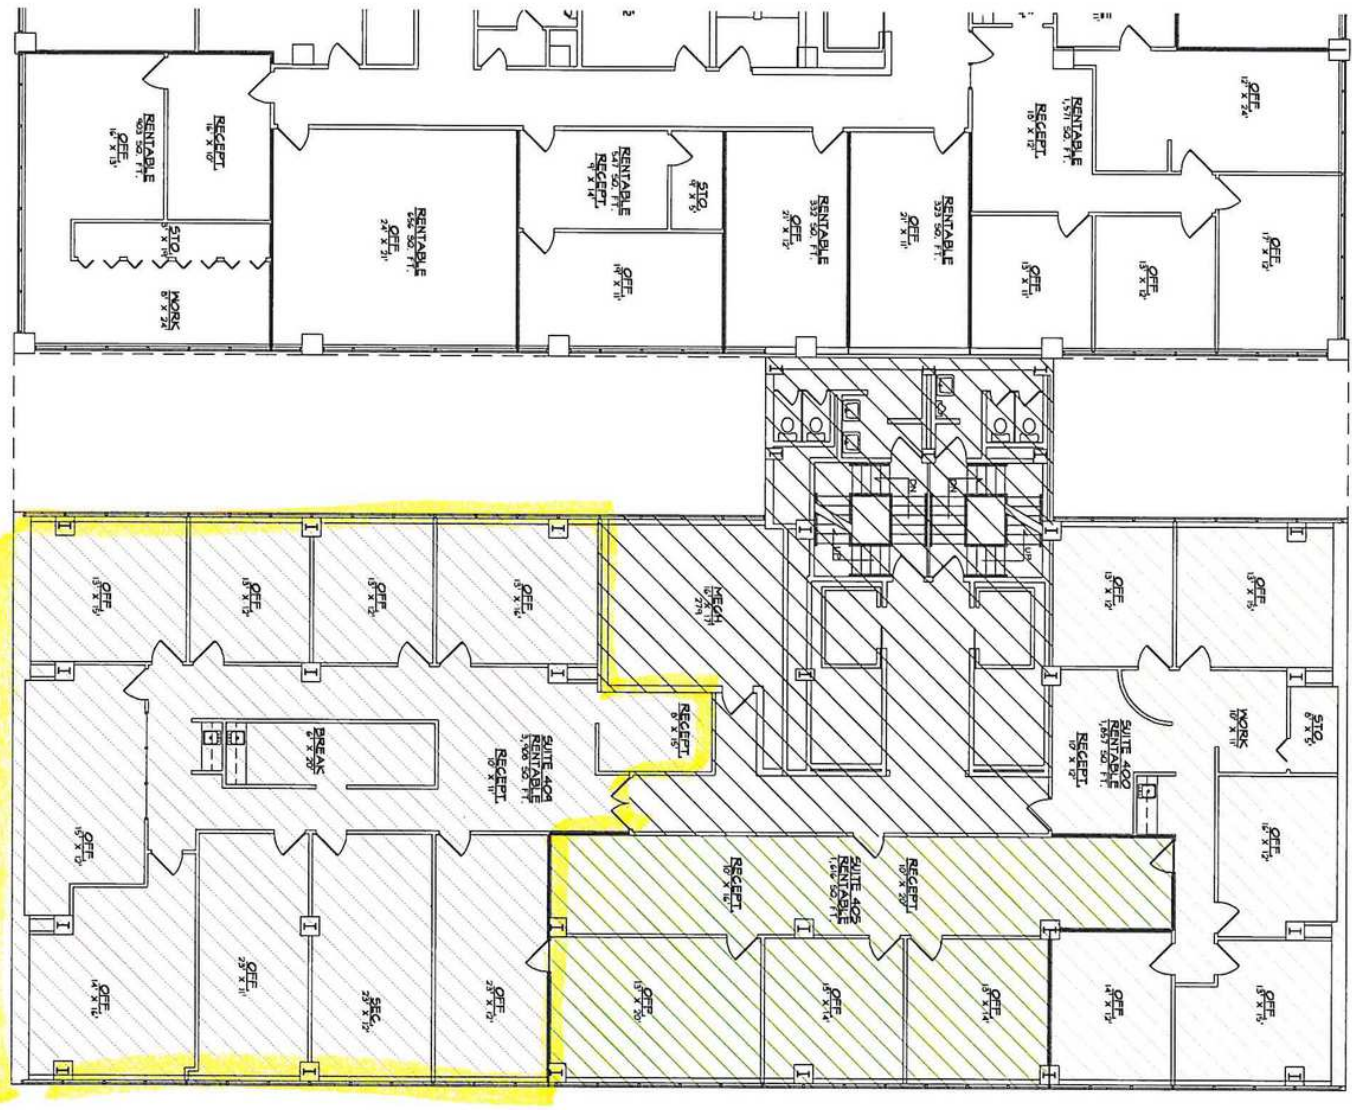

Stephanie Gauthier
Agent | Transaction Coordinator | Marketing Specialist
214.450.9398
stephanie@moriahgroup.net

Wes Gotcher
Broker | President
432.682.2510
wes@moriahgroup.net

Trey Dennis
Broker
432.236.7500
trey@moriahgroup.net



PRICE: \$17.00 - 21.00 SF/YR

WALL TOWERS | EAST 4TH FLOOR | SUITE 403

201-203 W Wall St, Midland, TX 79701



Stephanie Gauthier

Agent | Transaction Coordinator | Marketing Specialist
214.450.9398
stephanie@moriahgroup.net

Wes Gotcher

Broker | President
432.682.2510
wes@moriahgroup.net

Trey Dennis

Broker
432.236.7500
trey@moriahgroup.net



PRICE: \$17.00 - 21.00 SF/YR

WALL TOWERS | EAST 5TH FLOOR | SUITE 515

201-203 W Wall St, Midland, TX 79701



Stephanie Gauthier

Agent | Transaction Coordinator | Marketing Specialist
214.450.9398
stephanie@moriahgroup.net

Wes Gotcher

Broker | President
432.682.2510
wes@moriahgroup.net

Trey Dennis


Broker
432.236.7500
trey@moriahgroup.net



PRICE: \$17.00 - 21.00 SF/YR

WALL TOWERS | EAST 5TH FLOOR | SUITE 517

201-203 W Wall St, Midland, TX 79701

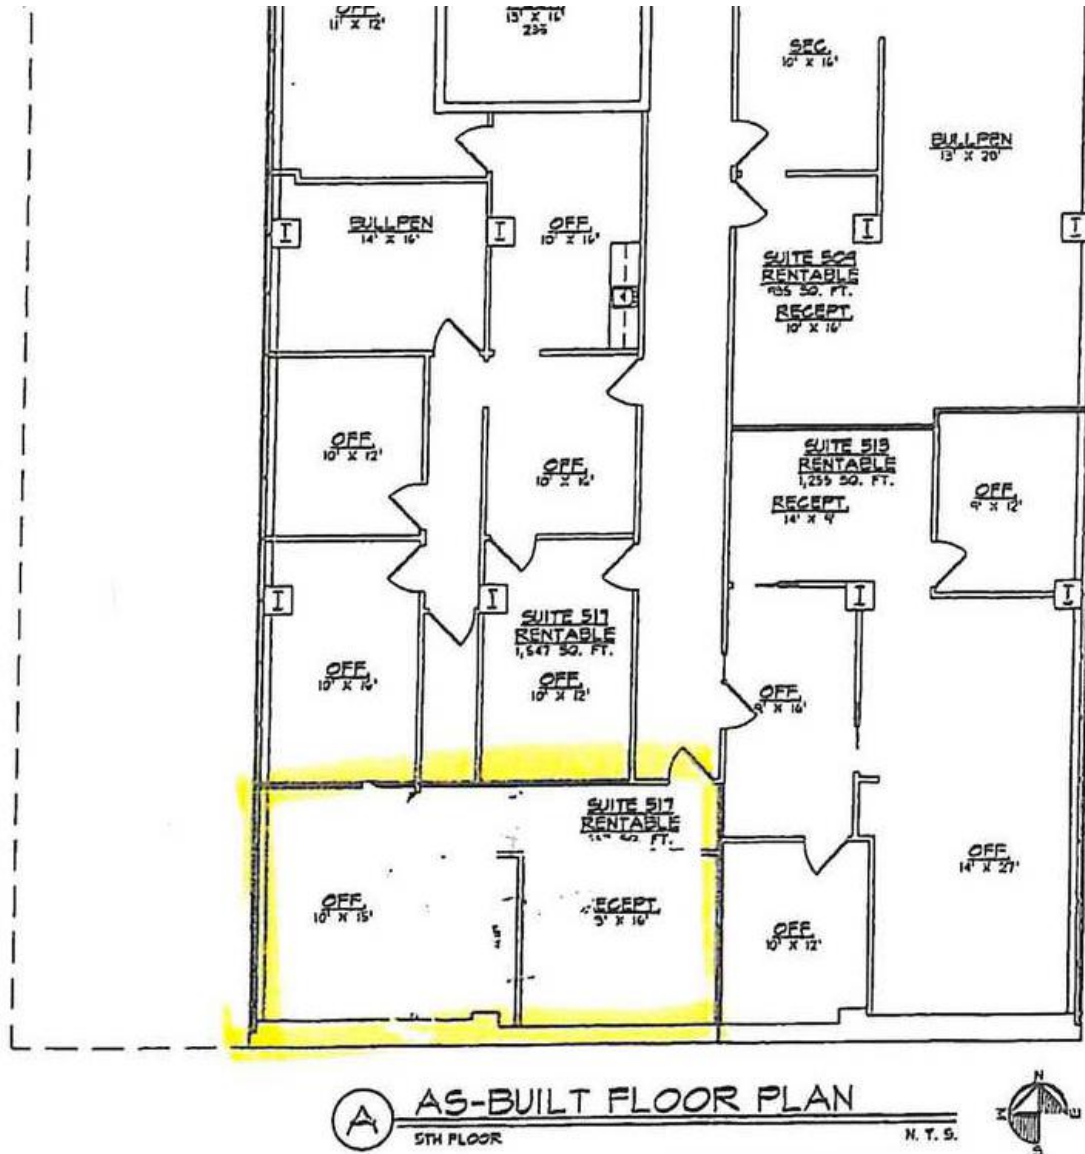

Stephanie Gauthier

Agent | Transaction Coordinator | Marketing Specialist
214.450.9398
stephanie@moriahgroup.net

Wes Gotcher

Broker | President
432.682.2510
wes@moriahgroup.net

Trey Dennis

Broker
432.236.7500
trey@moriahgroup.net

MORIAH
BROKERAGE SERVICES, LLC

PRICE: \$17.00 - 21.00 SF/YR

WALL TOWERS | EAST 5TH FLOOR | SUITE 517

201-203 W Wall St, Midland, TX 79701



Stephanie Gauthier

Agent | Transaction Coordinator | Marketing Specialist
214.450.9398
stephanie@moriahgroup.net

Wes Gotcher

Broker | President
432.682.2510
wes@moriahgroup.net

Trey Dennis


Broker
432.236.7500
trey@moriahgroup.net



PRICE: \$17.00 - 21.00 SF/YR

WALL TOWERS | EAST 5TH FLOOR | SUITE 530

201-203 W Wall St, Midland, TX 79701

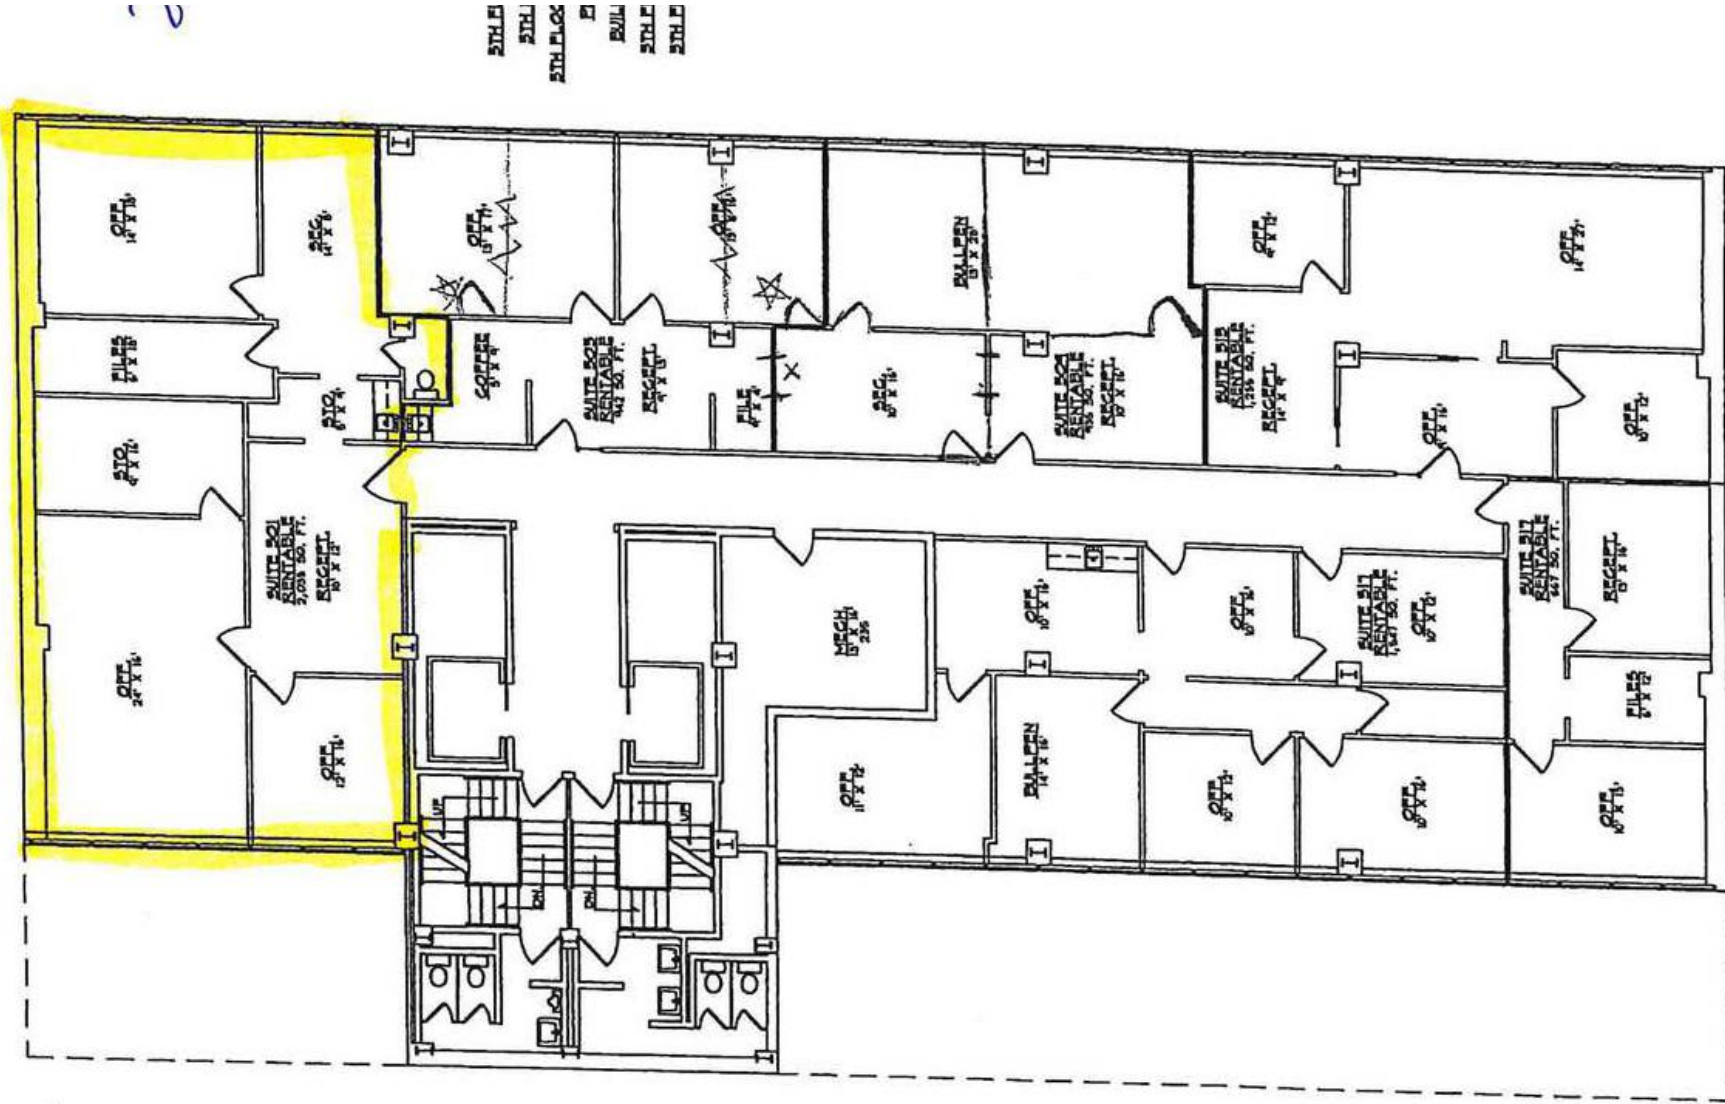

5TH FLOOR
 5TH FLOOR
A AS-BUILT FLOOR PLAN
 5TH FLOOR
 N.T.S.

© COPYRIGHT, J. R. DRAFTING & DESIGN
 2017 FEDERAL COPYRIGHT PROTECTION
 THIS PLAN IS THE PROPERTY OF J. R. DRAFTING & DESIGN
 AND IS NOT TO BE REPRODUCED, COPIED, OR
 TRANSMITTED IN ANY FORM OR BY ANY MEANS
 WITHOUT THE WRITTEN PERMISSION OF J. R. DRAFTING & DESIGN
 ANY UNAUTHORIZED REPRODUCTION IS STRICTLY
 PROHIBITED AND FORFEITS ALL RIGHTS AND
 REMEDIES.

DATE: MARCH 10, 2017
 DRAWN BY: JIM JONES

PREPARED BY:
JR DRAFTING & DESIGN
 NEW BUILDING FOR:
WALL TOWERS EAST
 203 WALL STREET
 MIDLAND TEXAS

Stephanie Gauthier
 Agent | Transaction Coordinator | Marketing Specialist
 214.450.9398
 stephanie@moriahgroup.net

Wes Gotcher
 Broker | President
 432.682.2510
 wes@moriahgroup.net

Trey Dennis
 Broker
 432.236.7500
 trey@moriahgroup.net



PRICE: \$17.00 - 21.00 SF/YR

WALL TOWERS | EAST 5TH FLOOR | SUITE 530

201-203 W Wall St, Midland, TX 79701



Stephanie Gauthier

Agent | Transaction Coordinator | Marketing Specialist
214.450.9398
stephanie@moriahgroup.net

Wes Gotcher

Broker | President
432.682.2510
wes@moriahgroup.net

Trey Dennis

Broker
432.236.7500
trey@moriahgroup.net




PRICE: \$17.00 - 21.00 SF/YR

WALL TOWERS | EAST 8TH FLOOR | SUITE 804

201-203 W Wall St, Midland, TX 79701

#804
23rd st

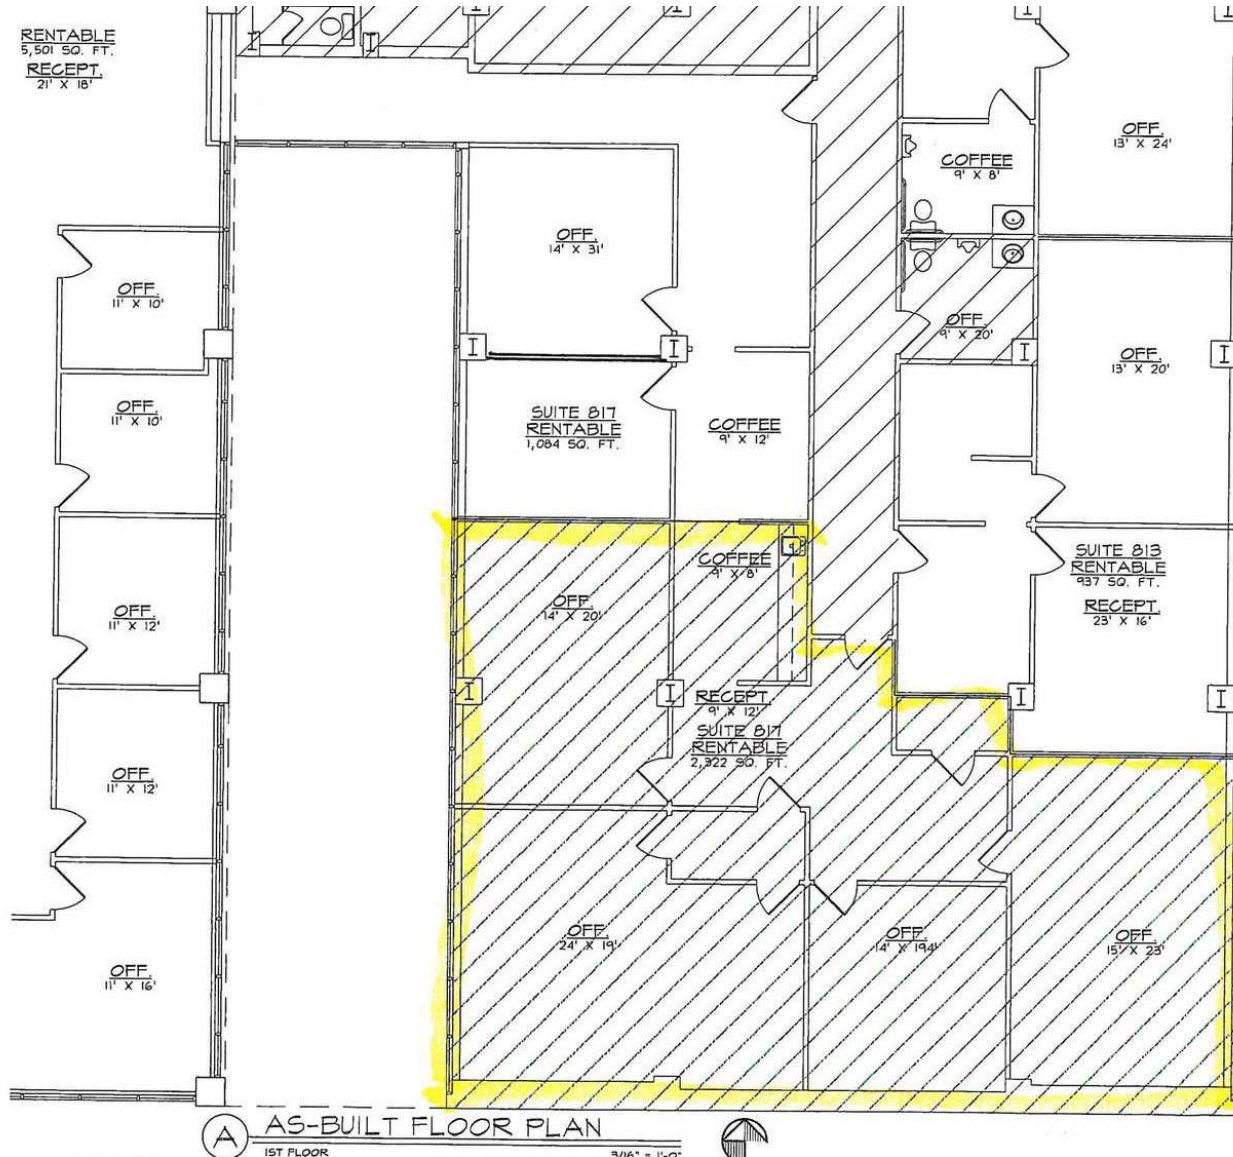

Stephanie Gauthier

Agent | Transaction Coordinator | Marketing Specialist
214.450.9398
stephanie@moriahgroup.net

Wes Gotcher

Broker | President
432.682.2510
wes@moriahgroup.net

Trey Dennis


Broker
432.236.7500
trey@moriahgroup.net

MORIAH
BROKERAGE SERVICES, LLC

PRICE: \$17.00 - 21.00 SF/YR

WALL TOWERS | EAST 8TH FLOOR | SUITE 804

201-203 W Wall St, Midland, TX 79701

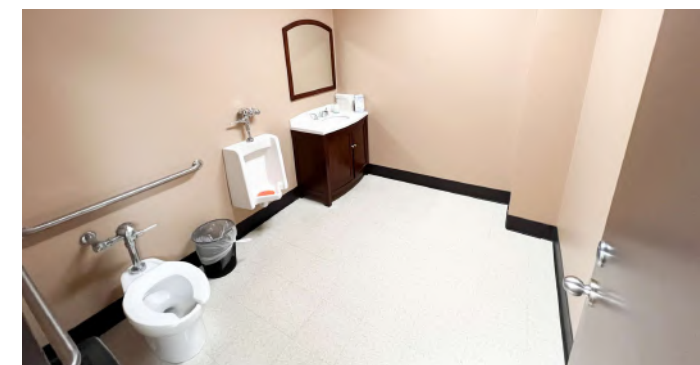

Stephanie Gauthier

Agent | Transaction Coordinator | Marketing Specialist
214.450.9398
stephanie@moriahgroup.net

Wes Gotcher

Broker | President
432.682.2510
wes@moriahgroup.net

Trey Dennis

Broker
432.236.7500
trey@moriahgroup.net



WALL TOWERS | EAST & WEST

201-203 W Wall St, Midland, TX 79701

Contact Brokers:

Stephanie Gauthier

Agent | Transaction Coordinator | Marketing Specialist
214.450.9398
stephanie@moriahgroup.net

Wes Gotcher

Broker | President
432.682.2510
wes@moriahgroup.net

Trey Dennis

Broker
432.236.7500
trey@moriahgroup.net



303 West Wall Street, Midland, TX 79701
432.682.2510 | moriahbrokerageservices.com