


NO.	DATE	DESCRIPTION
1	5-20-19	CITY REVIEW COMMENTS
2	8-6-19	6" FIRE LINE REDUCED TO 4"
3	10-8-19	CITY REVIEW COMMENTS
4	2-10-20	REV. TO CONNECT TO 20" WM


ZEPHYR ENGINEERING
 WILFORD ZEPHYR, P.E.
 HOLLYWOOD, FL
 (786) 302-7693
 wzephyr@gmail.com
 CA#: 31158

PLANET FITNESS
FIRE MAIN
 900 NE 125th STREET
 NORTH MIAMI, FL


P.E.#: 76036
 DATE: 4-4-19
 SCALE: 1"=20'
 SHEET NO.: **C1**
 1 OF 2
 PROJECT NO.: 19-09

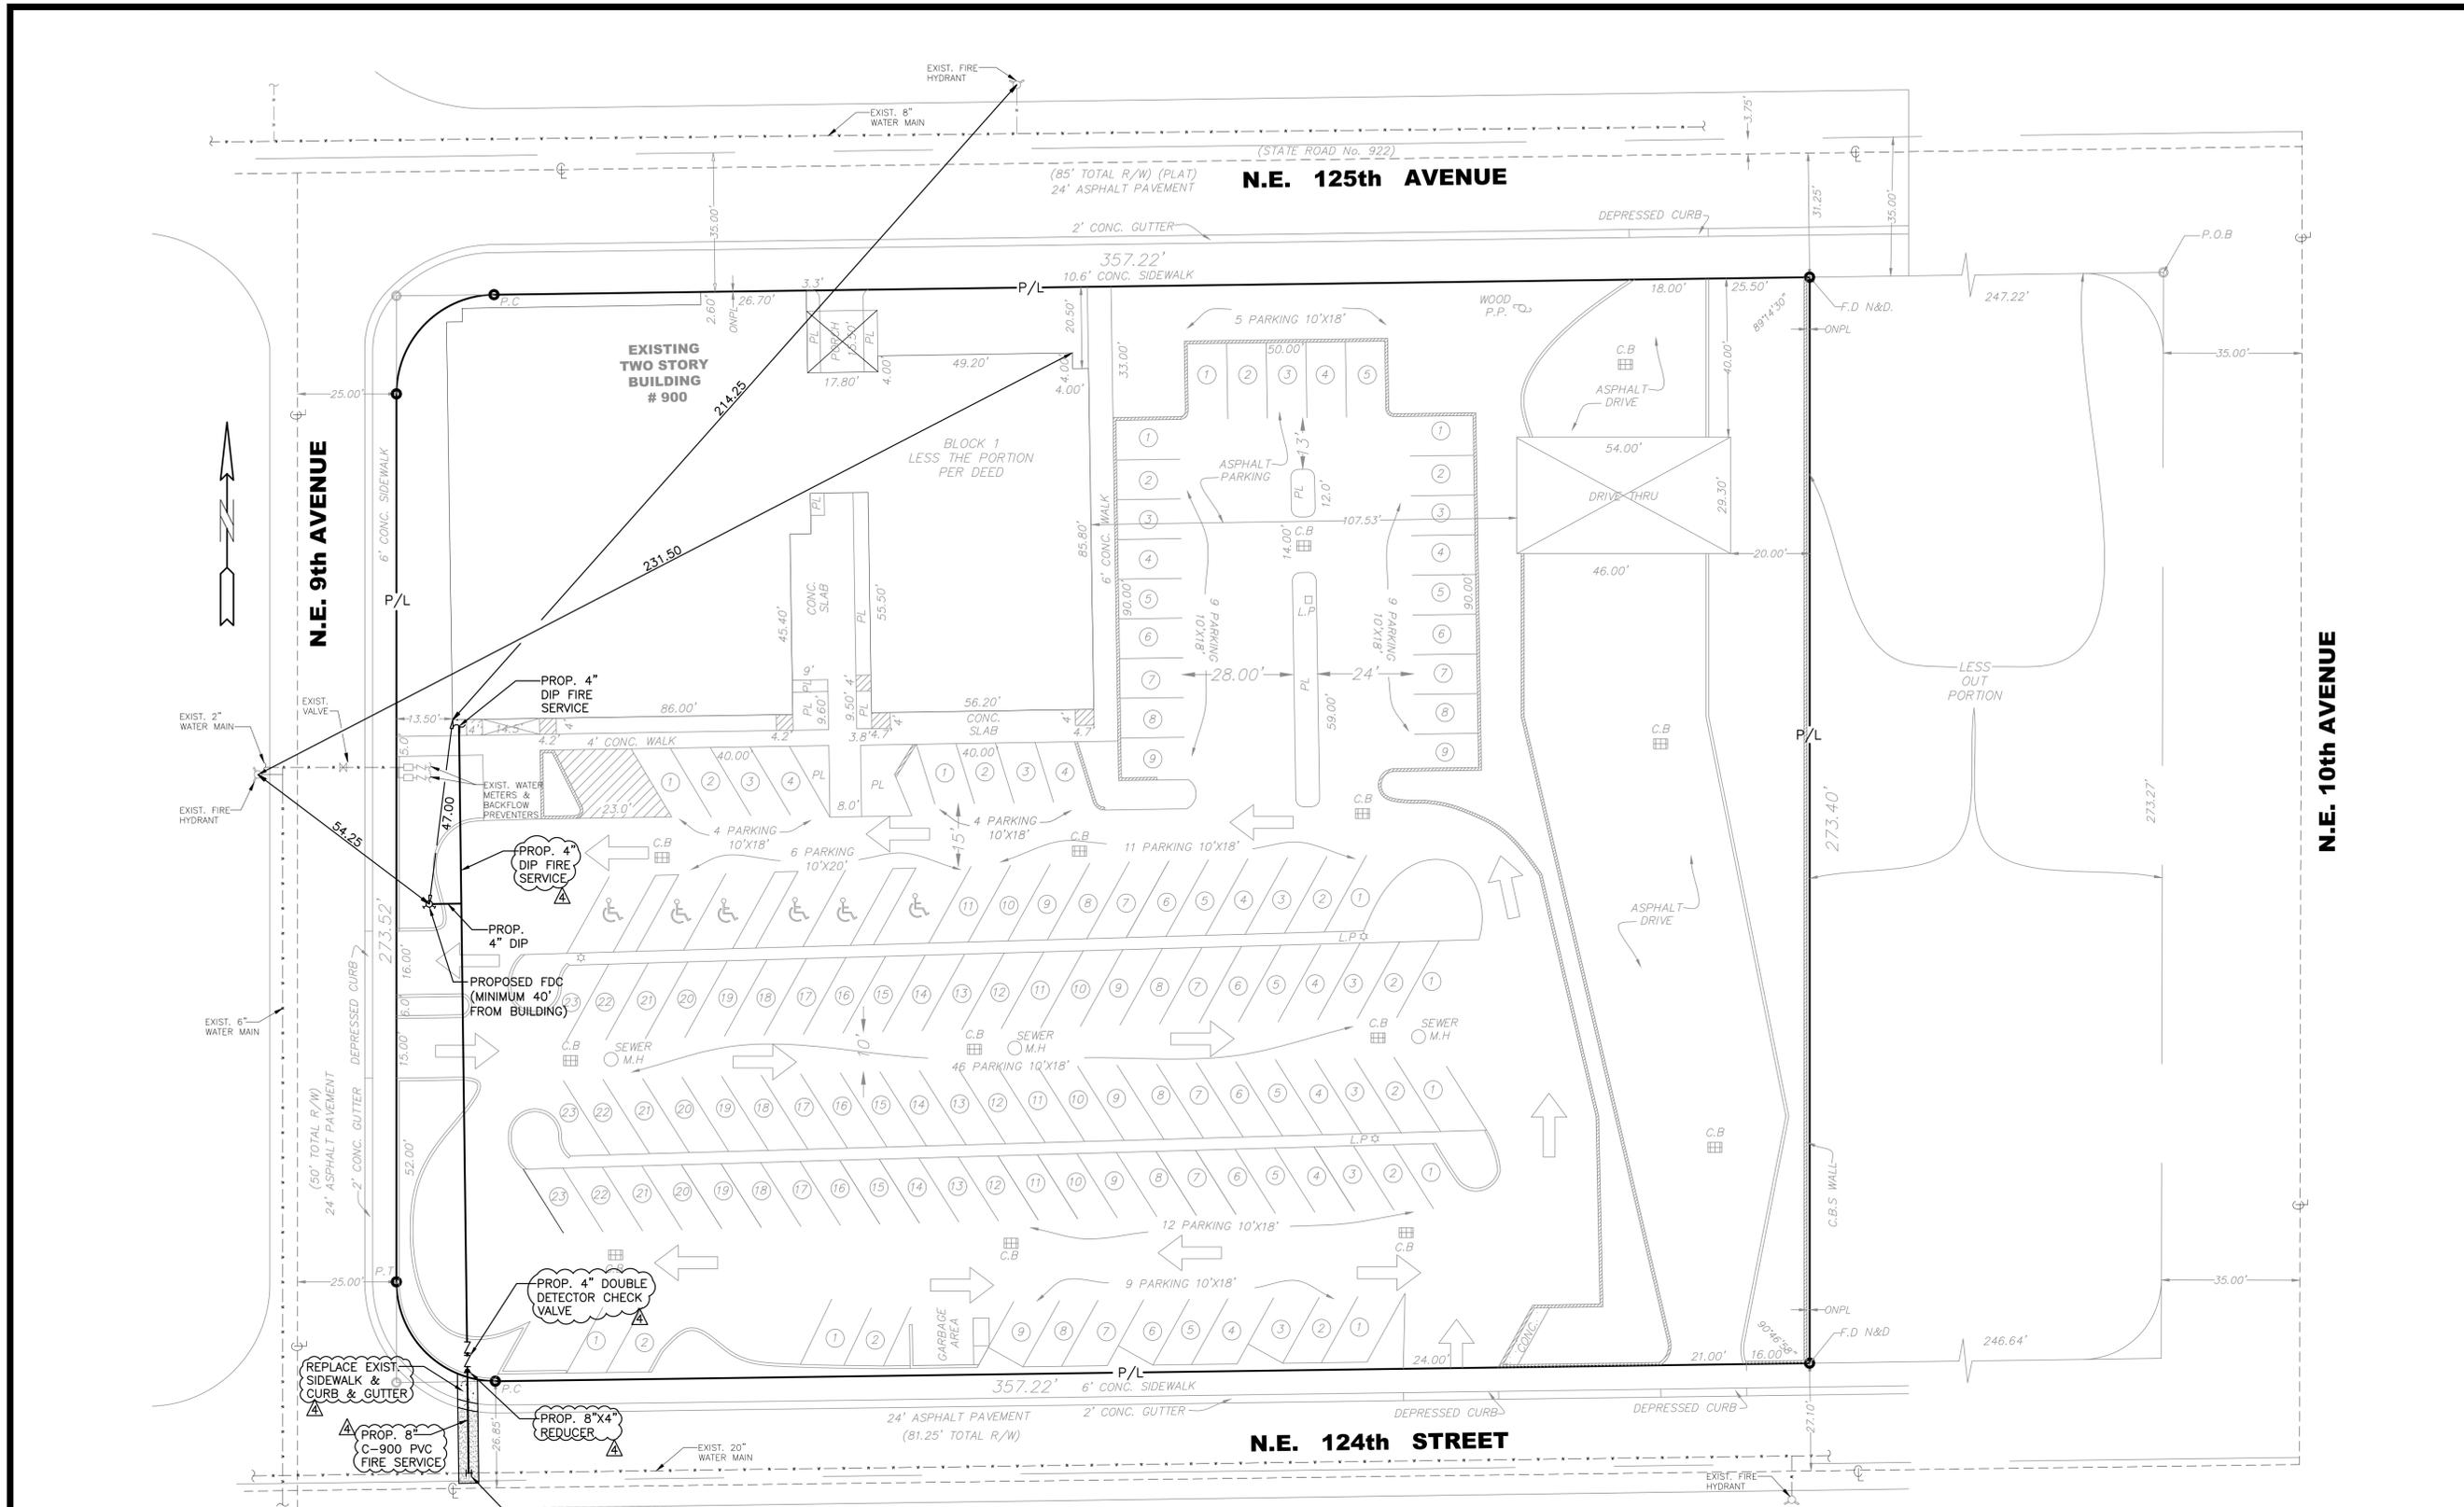

- LEGEND**
- EXISTING FIRE HYDRANT
 - EXISTING VALVE
 - PROPOSED DDCV
 - PROPOSED FDC
 - PROPOSED CONCRETE
 - PROPOSED ASPHALT

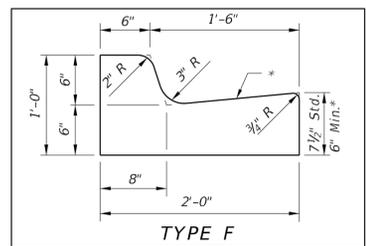

THIS ITEM HAS BEEN DIGITALLY SIGNED AND SEALED BY WILFORD ZEPHYR ON THE DATE ADJACENT TO THE SEAL.
 PRINTED COPIES OF THIS DOCUMENT ARE NOT CONSIDERED SIGNED AND SEALED AND THE SIGNATURE MUST BE VERIFIED ON ANY ELECTRONIC COPIES.

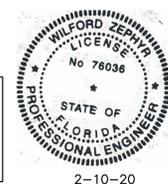

FIRE MAIN PLAN

SCALE: 1"=20'

2-10-20