


CONSTRUCTION NOTES:

- 1) CONTRACTOR TO VERIFY ALL EXISTING CONDITIONS AND DIMENSIONS PRIOR TO CONSTRUCTION.
- 2) CONTRACTOR TO HIRE MECHANICAL, ELECTRICAL, AND PLUMBING CONTRACTORS TO CAP OFF, REROUTE, OR TERMINATE ANY EXISTING CONNECTIONS IN THE AREAS TO BE RENOVATED.
- 3) CONTRACTOR RESPONSIBLE FOR VERIFYING ALL STRUCTURE ONCE EXPOSED.
- 4) CONTRACTOR RESPONSIBLE FOR SUPPORTING ALL STRUCTURAL SYSTEMS BEING MODIFIED DURING CONSTRUCTION.
- 5) CONTRACTOR RESPONSIBLE FOR MAINTAINING A DRY, CLEAN, AND SAFE ENVIRONMENT DURING CONSTRUCTION.
- 6) REFER TO GENERAL NOTES FOR ADDITIONAL NOTES AND INFORMATION.
- 7) ALL SITE INFORMATION TO BE PROVIDED BY OWNER
- 8) ANDERSEN 2000 SERIES WINDOW SIZES USED IN RENOVATION 4 ADDITION (U.N.O.)
- 9) CONTRACTOR SHALL NOTIFY ARCHITECT OF ANY DISCREPANCIES, STRUCTURAL PROBLEMS, OR ANY OTHER DEFECT ONCE THE EXISTING DRYWALL IS REMOVED

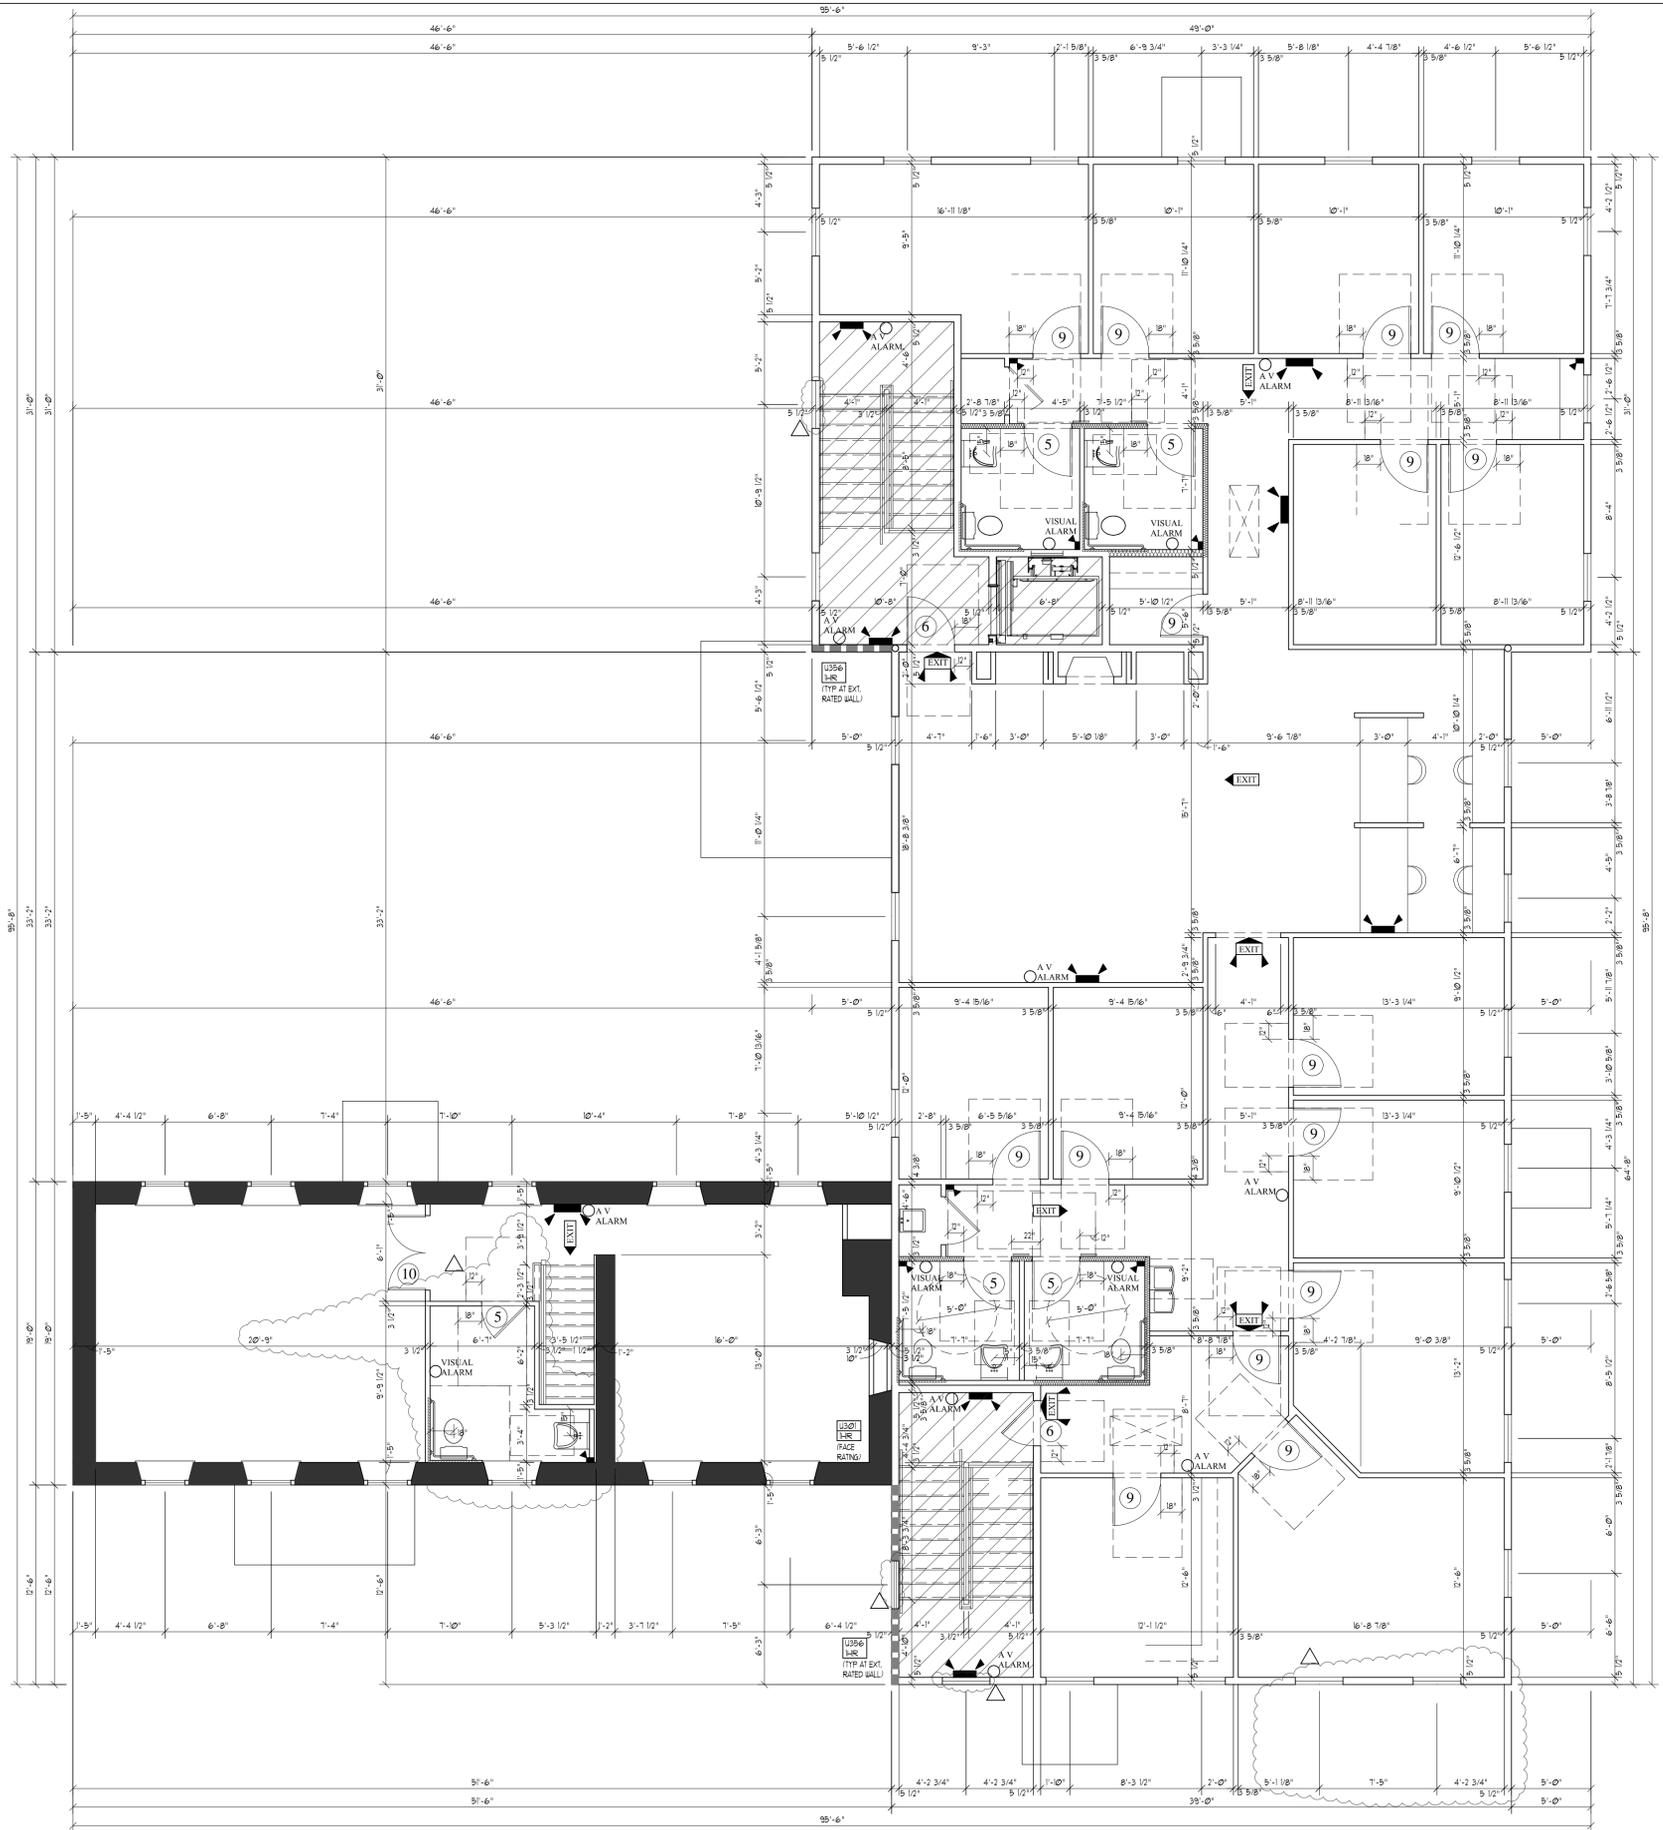

SECOND FLOOR PLAN

- NOTE:
- DENOTES EXISTING FRAME WALL
 - DENOTES NEW FIRE RATED FRAME WALL
 - DENOTES NEW BEARING WALL
 - DENOTES NEW FRAME WALL

Christopher J. Luce, AIA
 PA RA015179
 NJ 21A101673300
 67 Byberry Road, Hatboro, PA 19040
 Phone: 215-674-5950 • Fax: 215-674-5952
 WWW.LUCEARCHITECTS.COM

Wrightstown Medical Center
 Second Street Pike
 WRIGHTSTOWN TOWNSHIP, BUCKS COUNTY, PA

NO.	DATE	REVISIONS
3	6/16/16	BASEMENT WINDOWS & EGRESS WELLS
4	6/23/16	BASEMENT WINDOWS & EGRESS WELLS
5	6/25/16	SECOND FLOOR PLAN
6	7/8/16	CLIENT REVISIONS
7	9/5/16	CLIENT REVISIONS
8	6/24/16	AS BUILT

ONLY PLANS HAVING A RAISED OR RED COLORED PROFESSIONAL SEAL ARE CONSIDERED TO BE ORIGINAL AND RELIED UPON BY THE USER. THIS PLAN HAS BEEN PREPARED SPECIALLY FOR THE CLIENT AND PROJECT DESIGNATED HEREON. NO ALTERATIONS, REPRODUCTIONS OR USE OF ANY PART OF CONTENTS MAY BE MADE WITHOUT THE EXPRESSED WRITTEN PERMISSION OF THE AUTHOR. BUJICE ARCHITECTS, 2014 ALL RIGHTS RESERVED.

SECOND FLOOR PLAN
 SHEET NO. 13
 DATE: 2/20/16 DRAWN: WAS
 SCALE: 1/8" = 1'-0" DESIGNED: CAL