
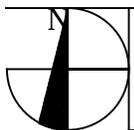


4144 North 44th Street

Phoenix . AZ

Suite 3

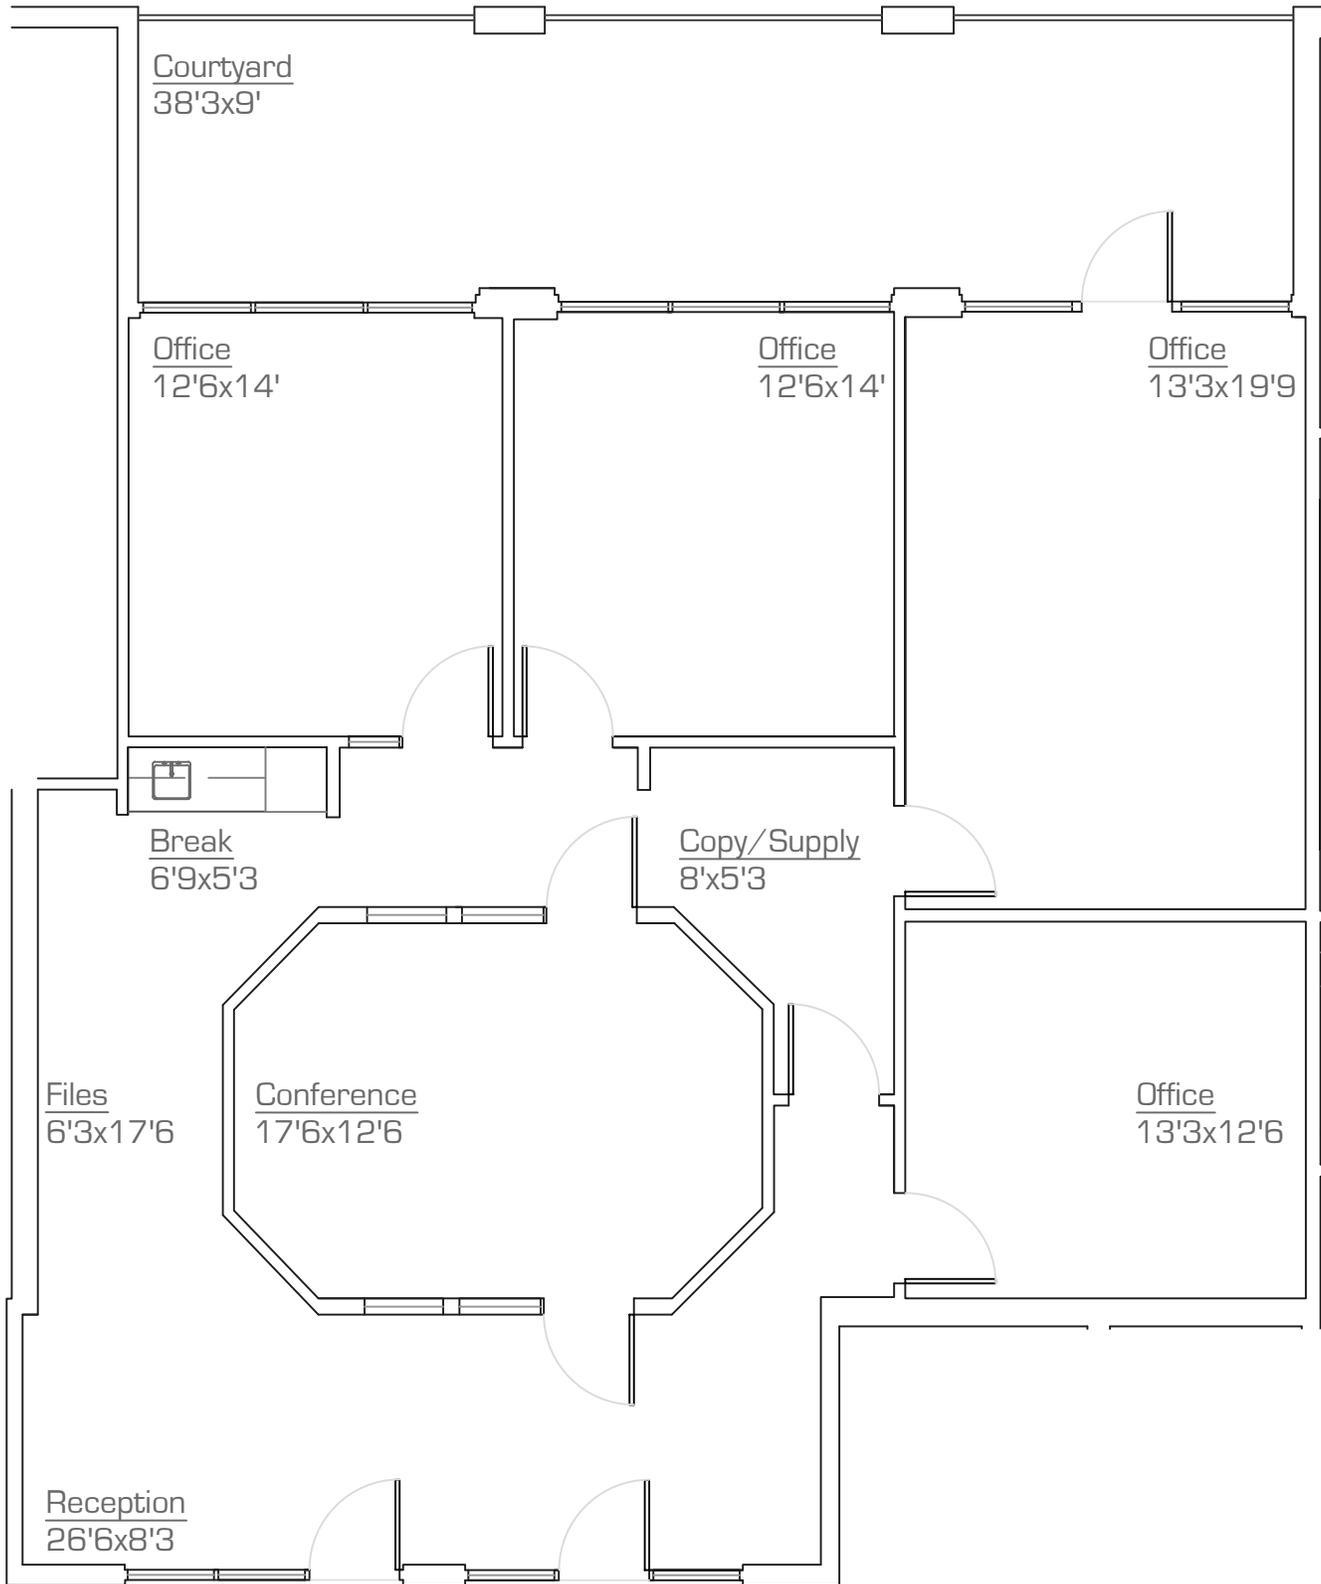

As-Built - Floor Plan

scale: nts

4.June.2025

*All dimensions are approximate at ± 3"

*All information is of general nature

precisionDIMENSIONS

as-built & survey
602.790.6412

