

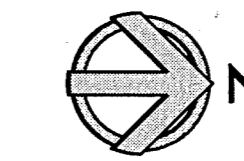



Z:\CAD\DrawCAD\2024 Files\24-050\Task Gerhart\Drawing Files\24-050 10 ASI Site Plan.dwg D5-4 1/11/2024 11:04

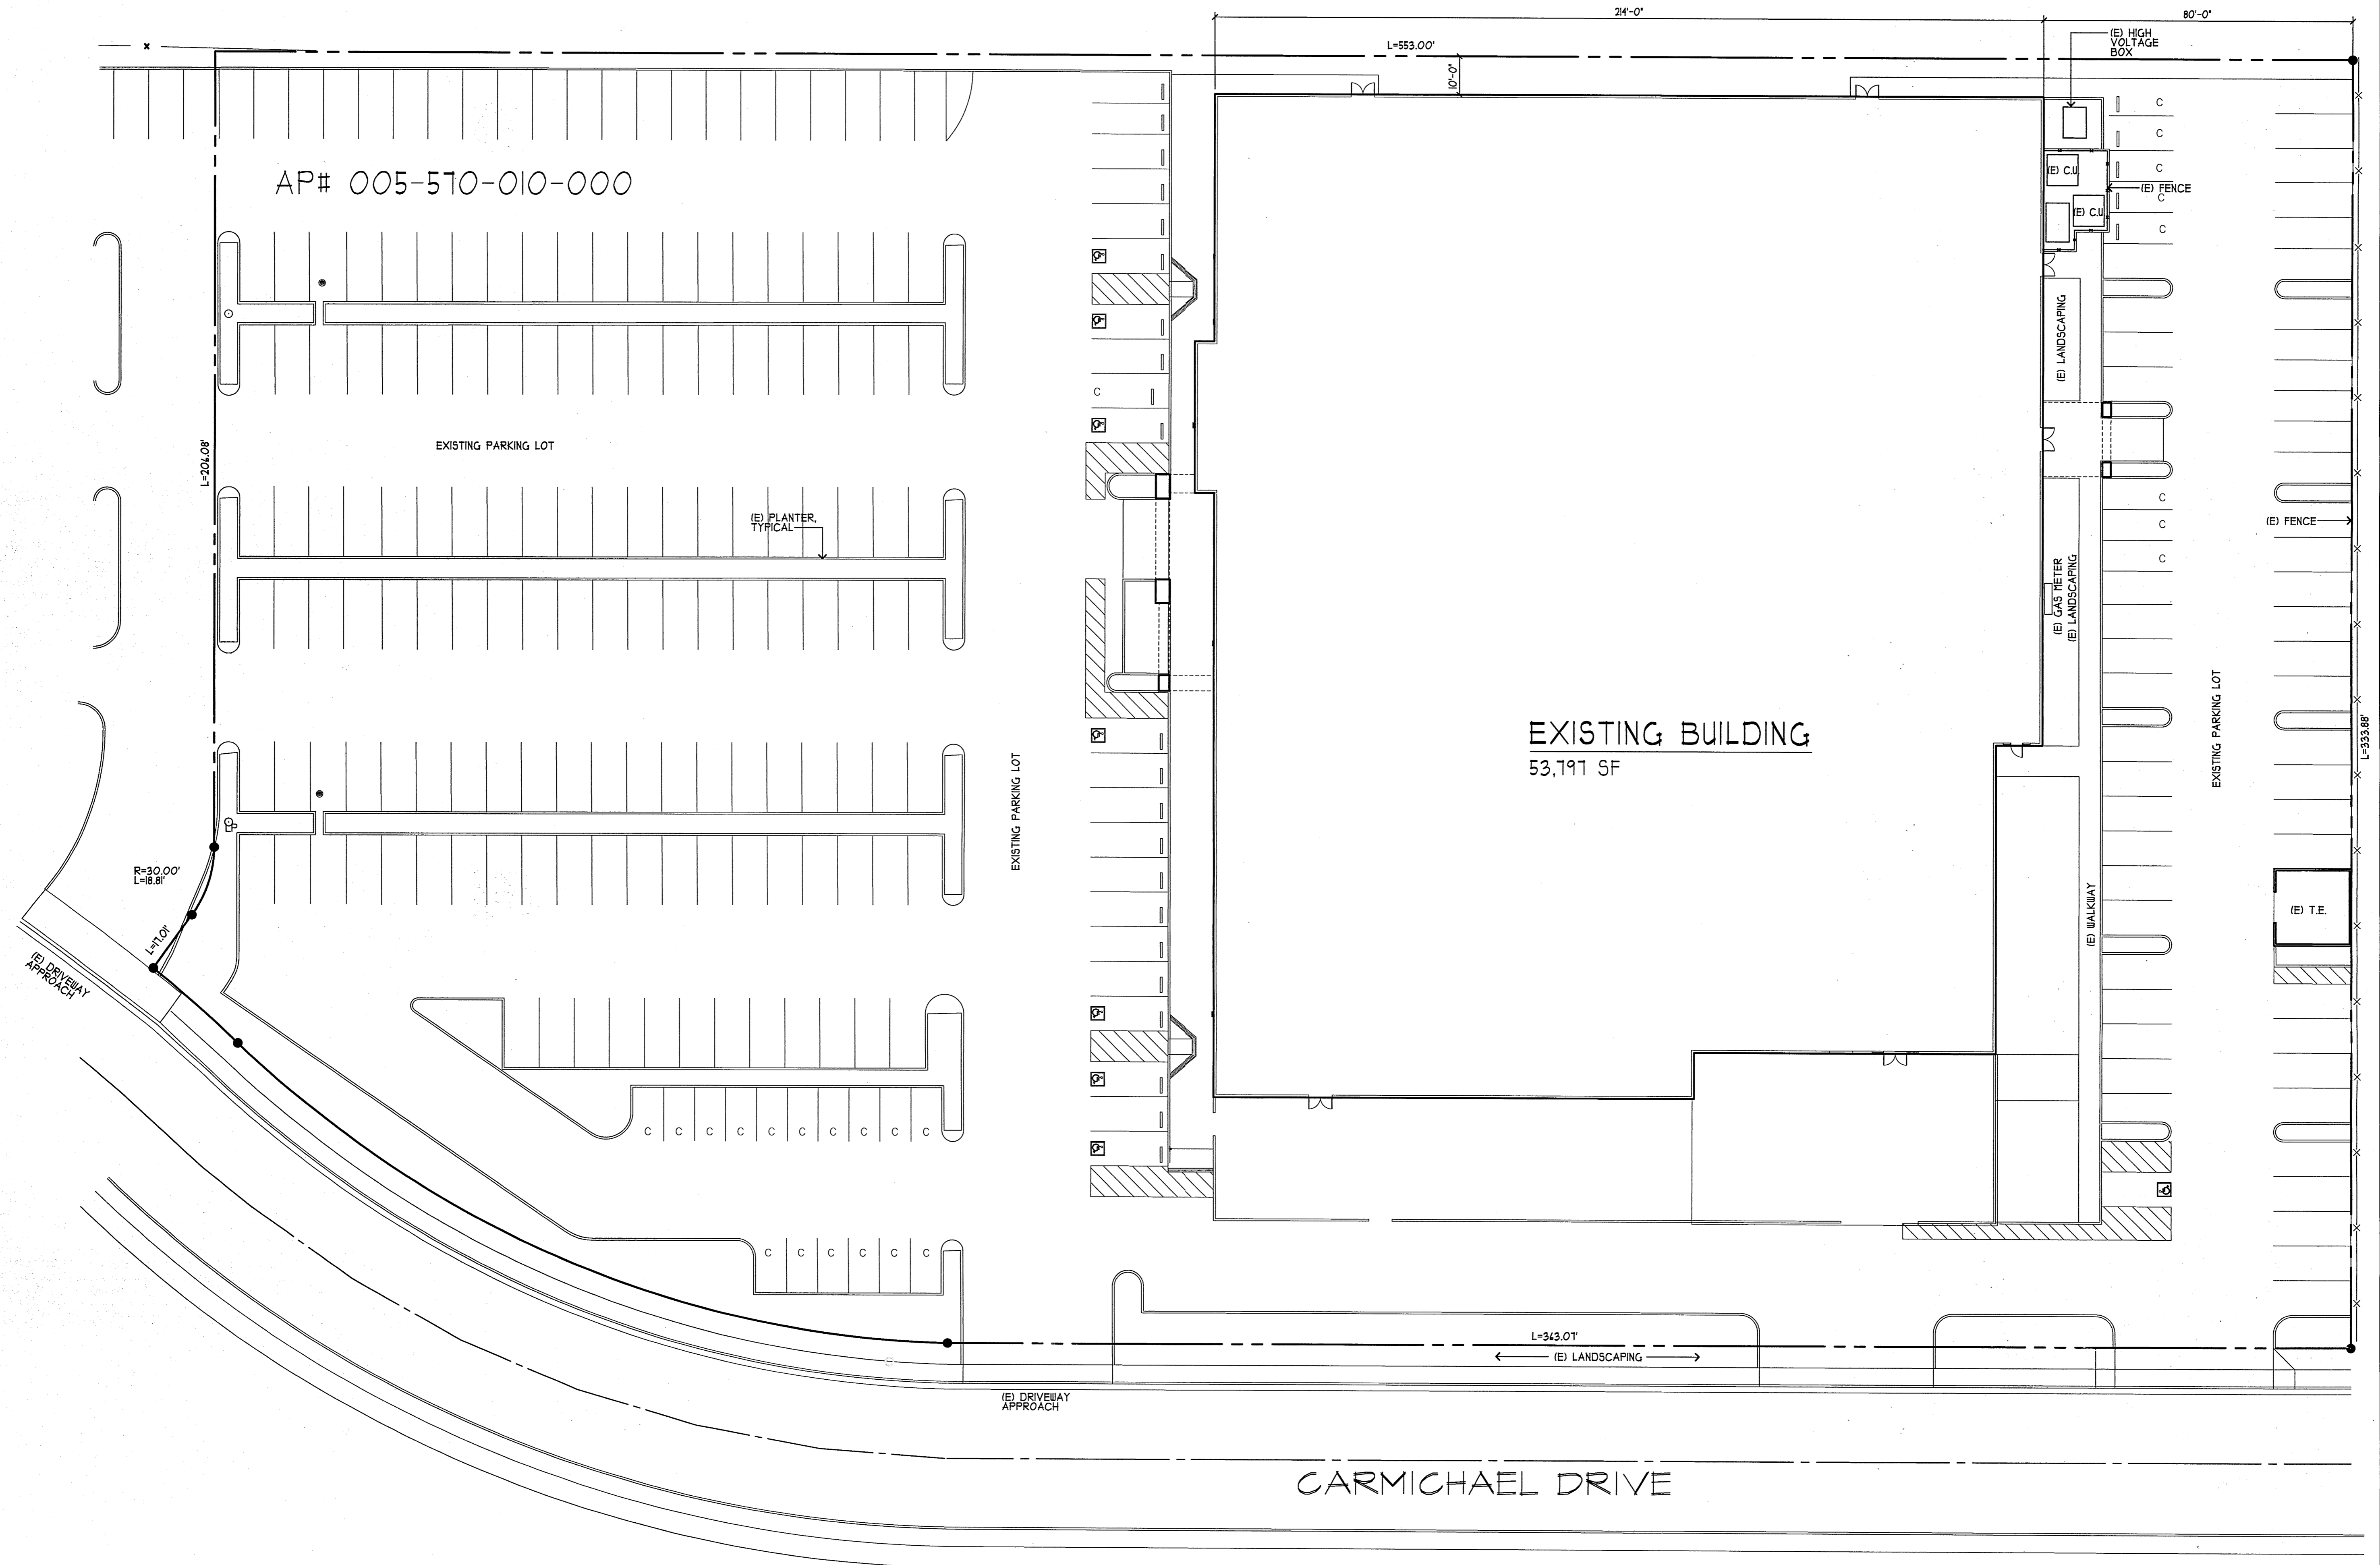

**SITE PLAN - IMPROVEMENTS**  
 SCALE: 1"=20'-0"

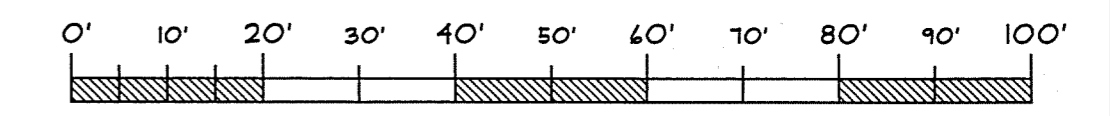

Revisions:  
 Plot Date: 1/11/2024

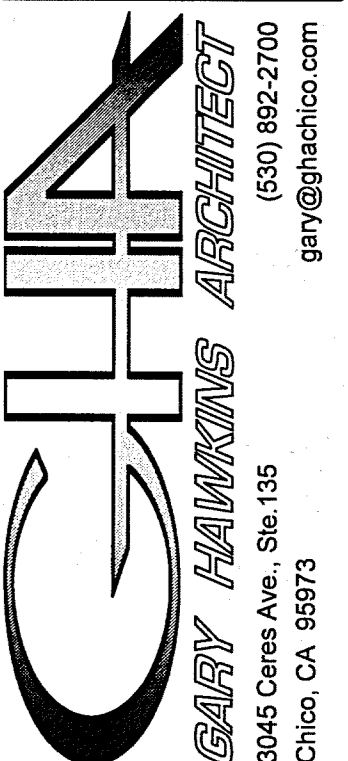

Commercial Infill for: APN: 005-570-010-000  
**GECCo Development, LLC**  
 2445 Carmichael Dr. Chico, Ca.

Date: 1-2024  
 Drawn: G.C  
 Job No: 24-050  
 SHEET NAME:  
 AS BUILT PARTIAL SITE PLAN

SHEET NUMBER:  
**AS1.2**  
 of: