
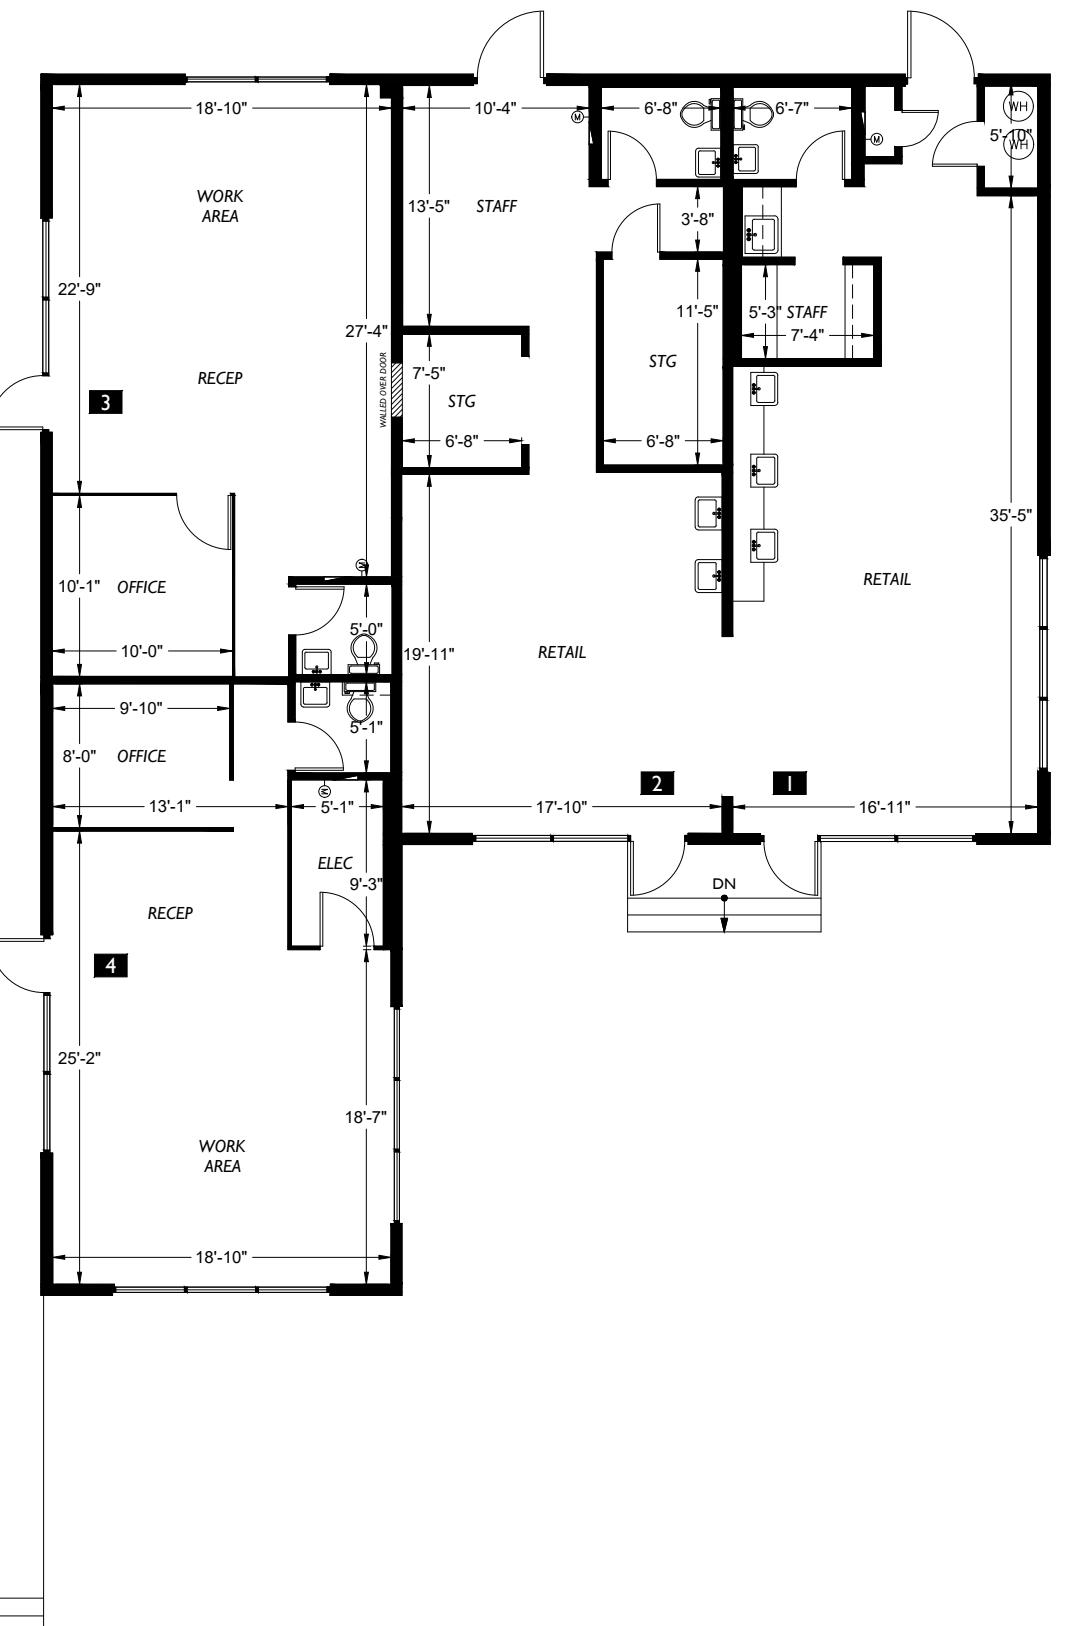


Lightrail Parking Lot

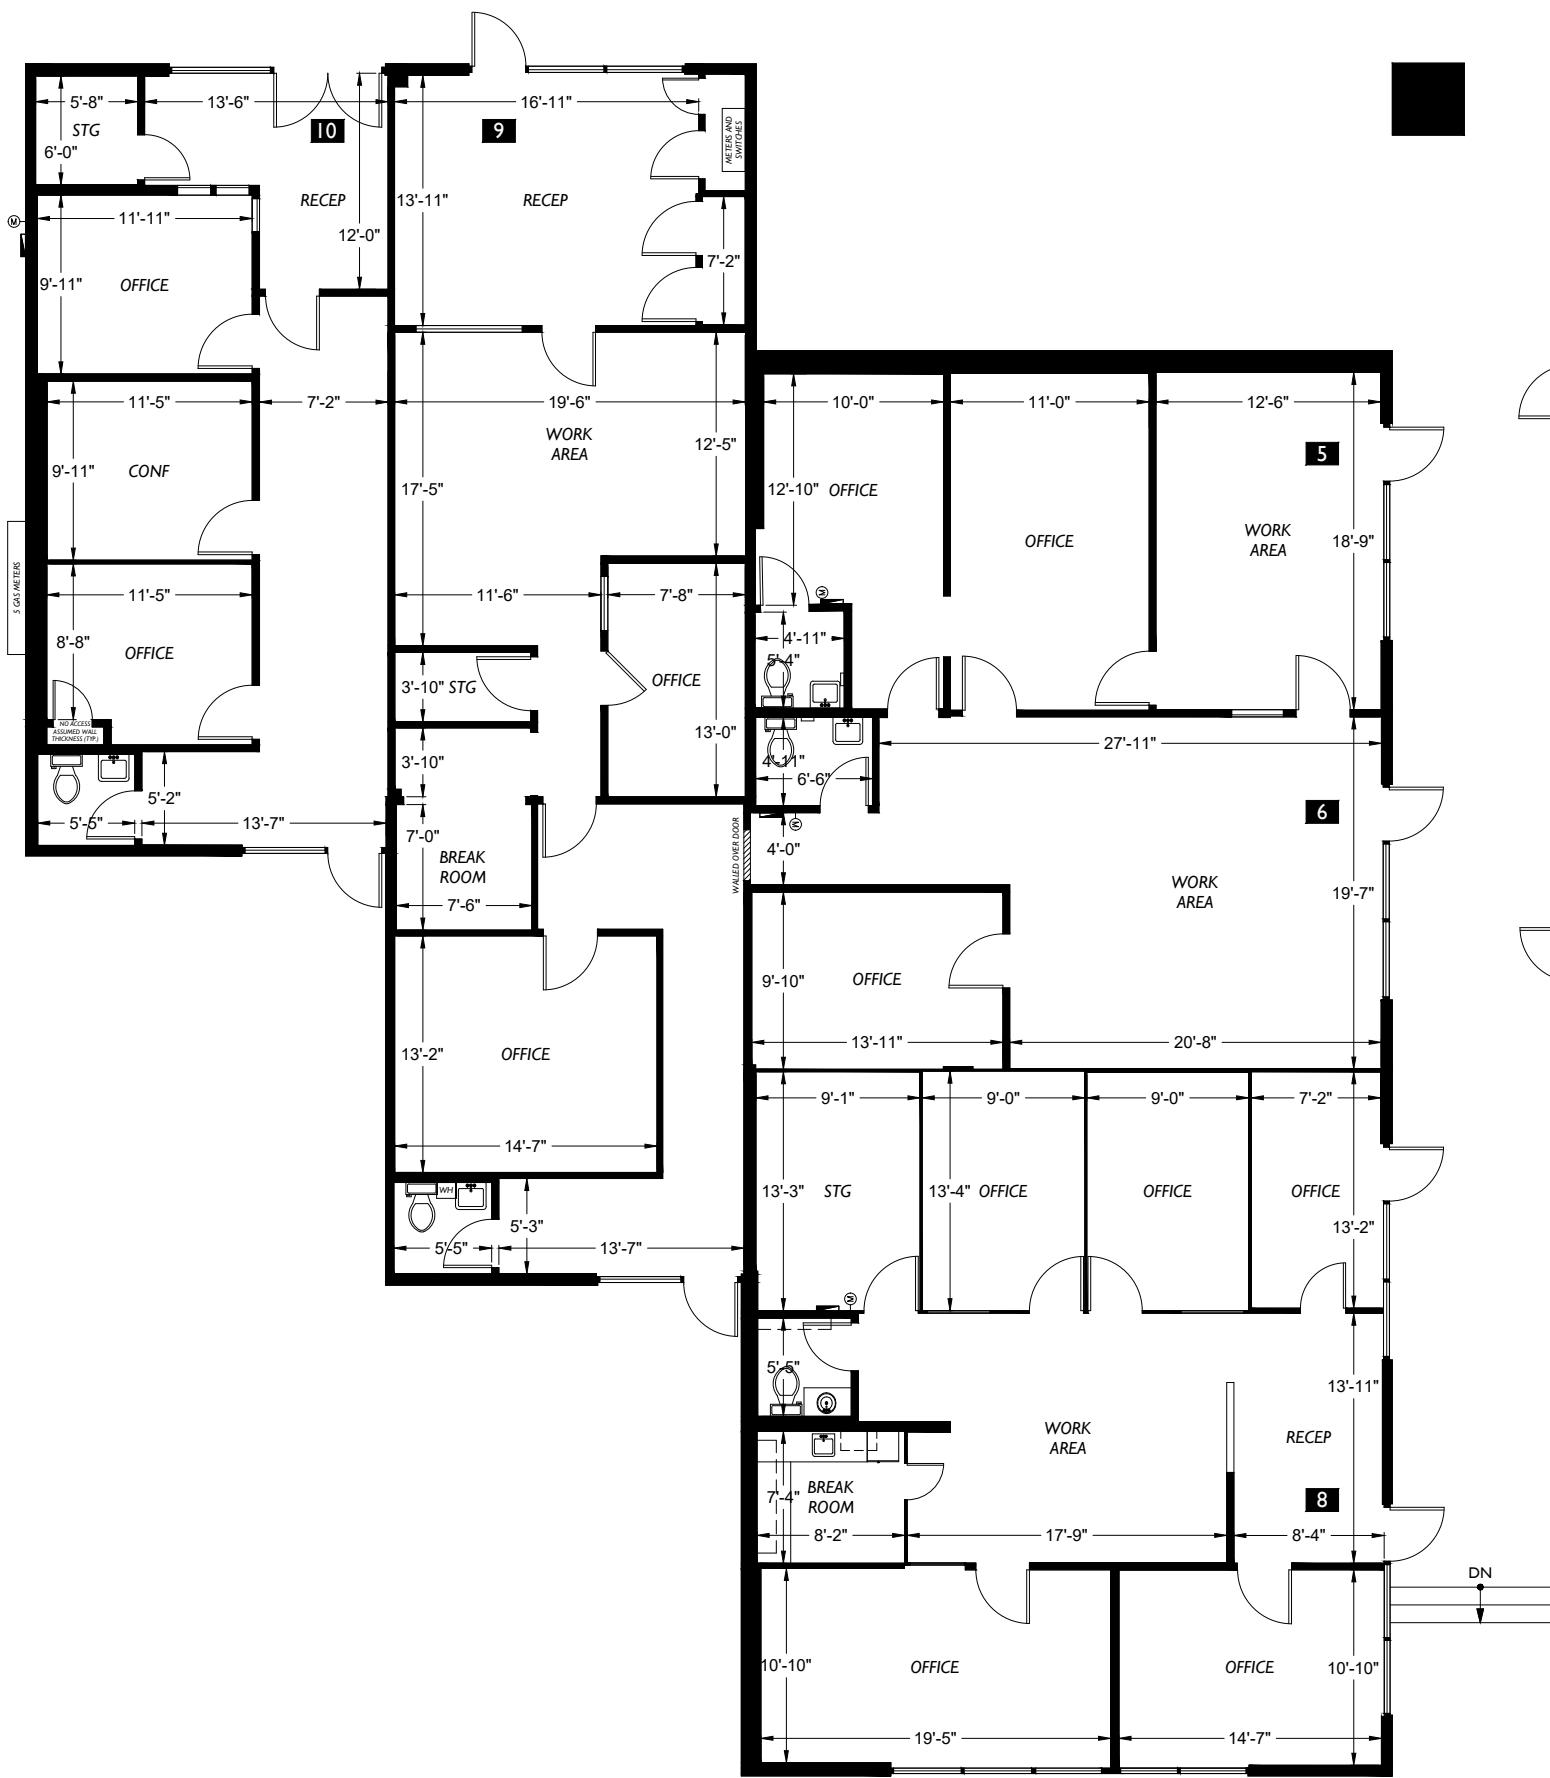

2-D AS-BUILT FLOOR PLANS

2DFLOORPLANS.COM

**600 NW Gilman Blvd. Suite E
Issaquah, WA 98027
425-677-7511**

This drawing is an instrument of service and is the sole property of 2-D As-Built Floor Plans, Inc. Any use of this drawing without written consent by 2-D As-Built Floor Plans, Inc. is prohibited.

Drawing scale and dimensions are provided for reference only. Refer to CAD files for exact measurements.


©2010 2-D As-Built Floor Plans, Inc.
All Rights Reserved.

Project: C3I 69


Date	Action
Project	
7/1/2021	Initial Measurement
C21-697	

Client:
Bureau Veritas
10461 Mill Run Circle, Suite 100
Owings Mills, MD 21117

Site:
Commercial Building
157 East Huntington Drive
Arcadia, CA 91006

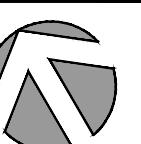

Floor Plan

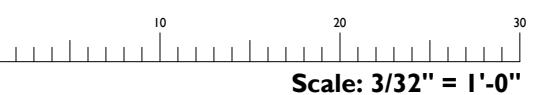

scale: 3/32" = 1'-0"

Floor