


THIS DRAWING IS THE PROPERTY OF THE ARCHITECT. IT IS TO BE USED ONLY FOR THE PROJECT AND SITE SPECIFICALLY IDENTIFIED HEREON. IT IS NOT TO BE REPRODUCED, COPIED, REPRODUCED, OR TRANSMITTED IN ANY FORM OR BY ANY MEANS, ELECTRONIC OR MECHANICAL, INCLUDING PHOTOCOPYING, RECORDING, OR BY ANY INFORMATION STORAGE AND RETRIEVAL SYSTEM, WITHOUT THE WRITTEN PERMISSION OF THE ARCHITECT.

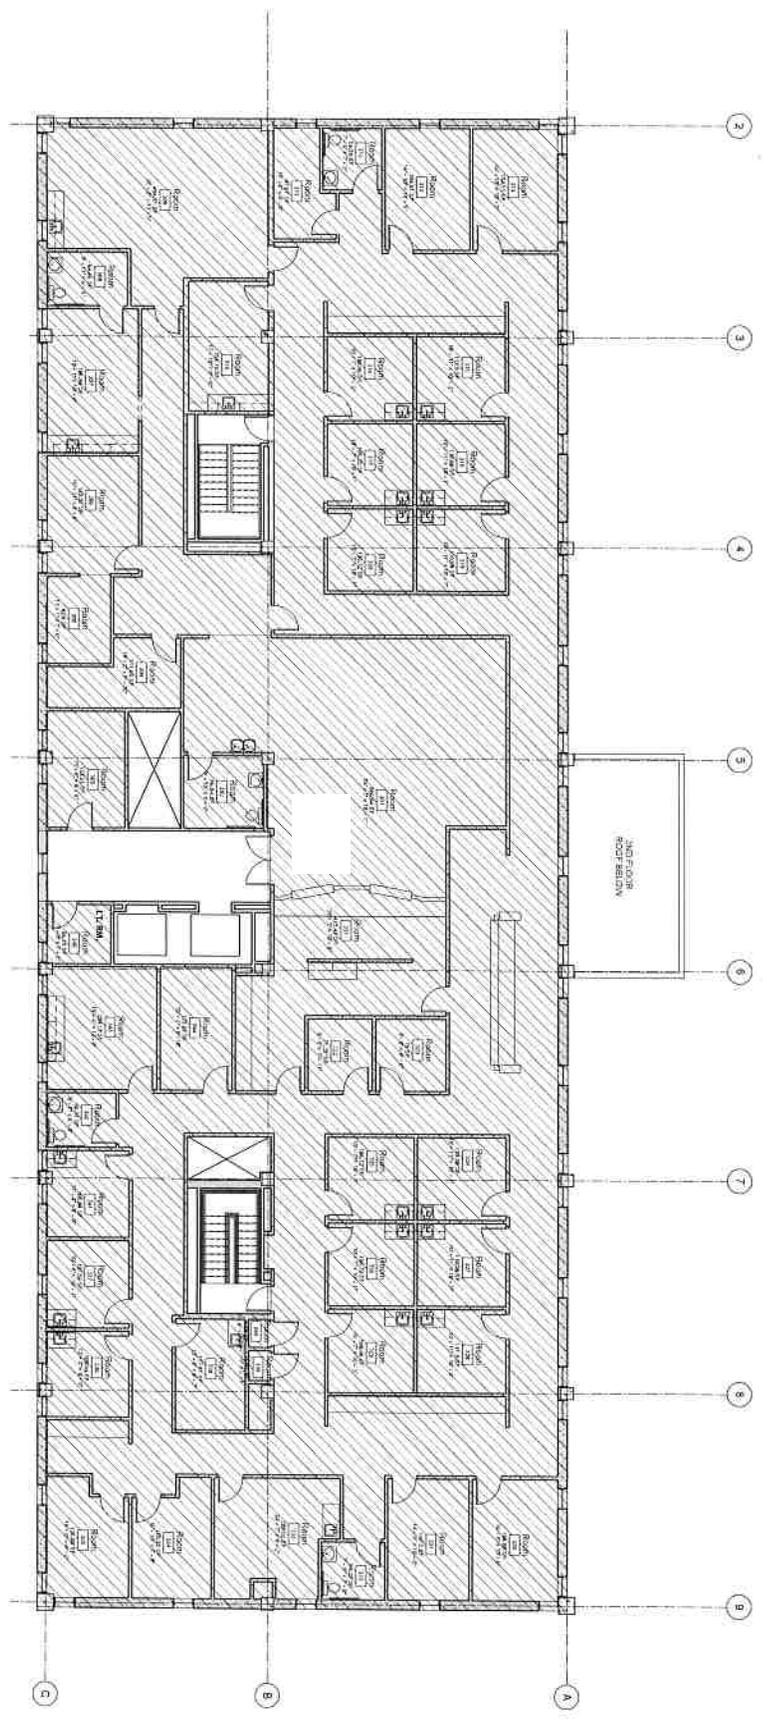

THIRD LEVEL FLOOR PLAN
SCALE 1/8" = 1'-0"

RECORD DRAWINGS

SHEET A1.4
OF

3RD LEVEL FLOOR PLAN

COMMISSION No. 20-012
DATE: 05/09/20

www.psrbb.com
www.draftinginc.com

1810 MURCHISON

1810 MURCHISON