

TENANT A  
800 G.S.F.

TENANT B  
800 G.S.F.

TENANT C  
1600 G.S.F.

**AS-BUILT FLOOR PLAN**


SCALE: 1/4" = 1'-0"



REVISION	DATE
--	--

PROJECT  
2021/4

AS-BUILT FLOOR PLAN  
4301 APPLETON AVENUE NW  
ROANOKE, VIRGINIA

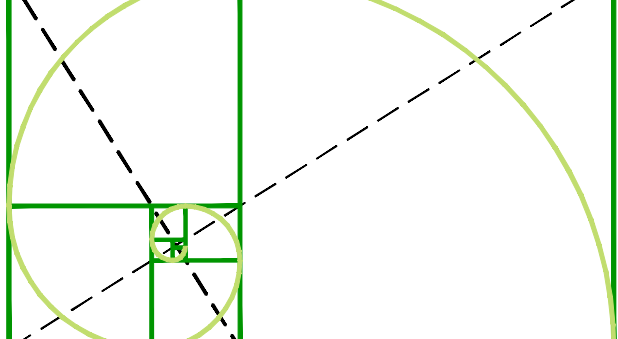

**Degen Architects**  
Post Office Box 4036  
Roanoke VA 24015-0036  
Telephone 540/772-0800  
degenarch@gmail.com

DRAWING  
AS-BUILT  
FLOOR PLAN

DATE  
26 AUGUST 2021

SHEET NUMBER:  
**A101**