

ASSUMED AS-BUILT FLOOR PLAN - GROUND LEVEL

SCALE: 3/32" = 1'-0"

GENERAL NOTE:

VERIFY DIMENSIONS & CONDITIONS IN THE FIELD PRIOR
TO CONSTRUCTION OF THE INFORMATION SHOWN ON THIS DRAWING,
\$ NOTIFY THE GETSLOFF DESIGN GROUP OF ANY DISCREPANCIES BETWEEN
ACTUAL CONDITIONS AND THESE DRAWINGS.

THESE DOCUMENTS ARE TO BE USED FOR INTERIOR BUILD-OUT ONLY, GETSLOFF DESIGN GROUP IS NOT RESPONSIBLE OR LIABLE FOR ANY STRUCTURAL, MECHANICAL, ELECTRICAL OR PLUMBING DESIGN/ENGINEERING, REFER TO ARCHITECT'S CODE COMPLIANT DRAWINGS FOR ANY ISSUES RELATING TO ADA OR LIFE-SAFTEY WHICH MAY BE REQUIRED BY LOCAL OR STATE JURISDICTION.

NOTE: FIELD MEASURE BEFORE BEGINNING CONSTRUCTION DRAWINGS

APPROVED: TENANT______ DATE: ______

LANDLORD: DATE:



Getsloff Design Group, Inc. 15 Fishers Road, Suite 205 Pittsford NY, 14534 Tel: (585) 425-0932 www.getsloffdesigngroup.com



DRAWING
ALTERATION

IT IS A VIOLATION FOR ANY PERSON TO
ALTER ANY ITEM ON THIS DOCUMENT
IN ANY WAY WITHOUT THE WRITTEN
RELEASE FROM GETSLOFF DESIGN

THESE DRAWINGS ARE THE PROPERTY OF GETSLOFF DESIGN GROUP AND ARE NOT TO BE USED, COPIED OR APPLIED WITHOUT WRITTEN CONSENT.

THE GETSLOFF DESIGN GROUP IS A FIRM OFFERING SERVICES IN SPACE PLANNING, PROJECT MANAGEMENT AND INTERIOR DESIGN, AND DOES NOT PRACTICE ARCHITECTURE OR ENGINEERING SERVICES. IT IS RECOMMENDED THAT A PROFESSIONAL, LICENSED INDIVIDUAL BE CONSULTED IN THE ABOVE AREAS AS REQUIRED BY LAW.

REVISIONS

NO DATE DESCRIPTION

ISSUED FOR PERMIT
ISSUED FOR CONST.

PROJECT

300 CANAL VIEW

LOCATION

300 CANAL VIEW
ROCHESTER, NEW YORK

DRAWING TITLE

ASSUMED

AS-BUILT GROUND LEVEL

SHEET NO.

DRAWN BY:

JYT


CHECKED BY:

MCG

DATE:

| 1/8/23

DRAWING:

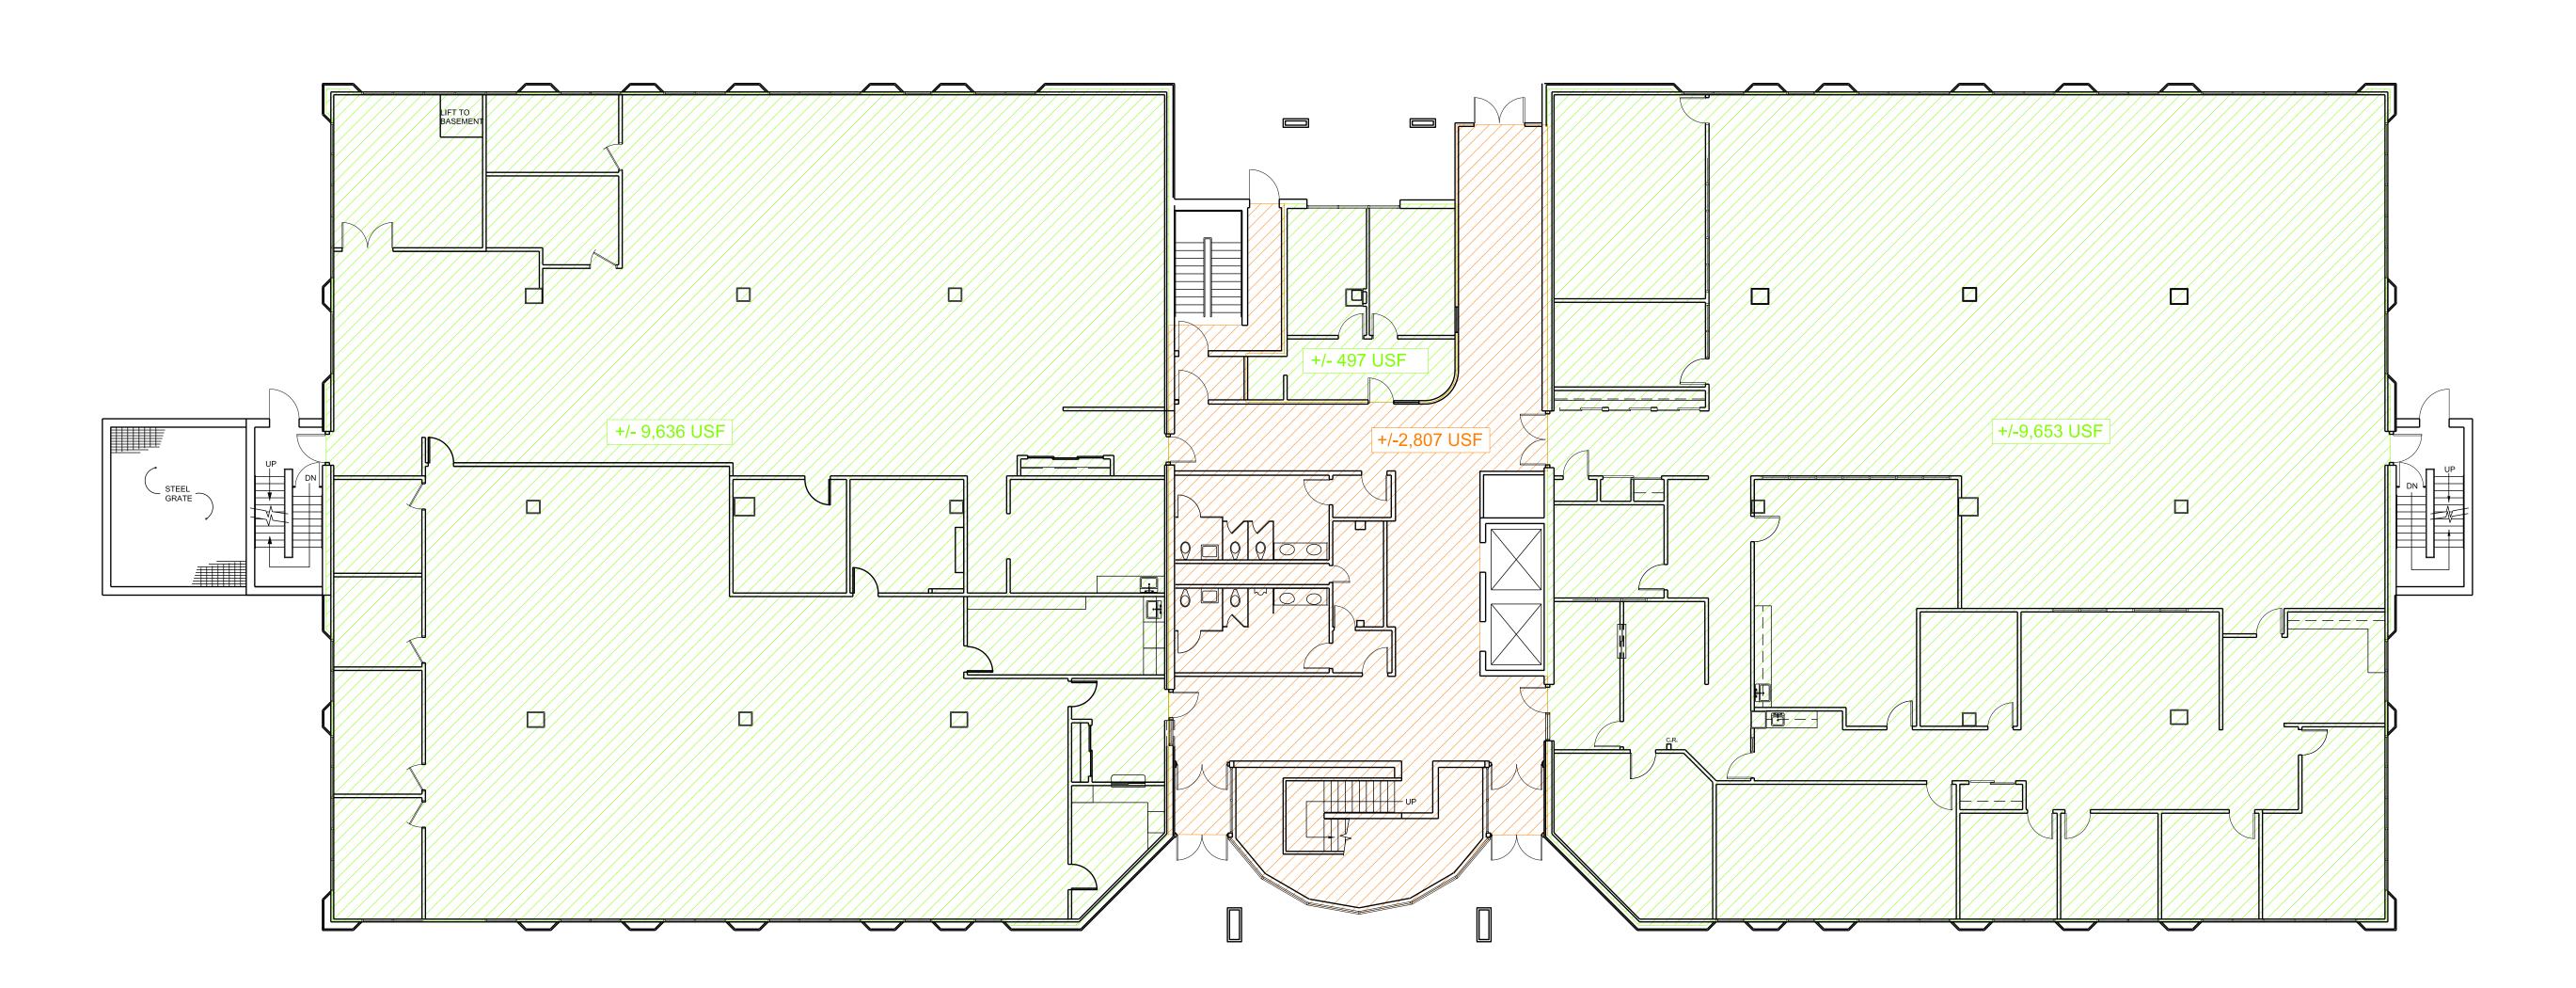

ASSUMED AS-BUILT FLOOR PLAN - GROUND LEVEL

SCALE: 3/32" = 1'-0"

GENERAL NOTE:

VERIFY DIMENSIONS & CONDITIONS IN THE FIELD PRIOR
TO CONSTRUCTION OF THE INFORMATION SHOWN ON THIS DRAWING,
\$ NOTIFY THE GETSLOFF DESIGN GROUP OF ANY DISCREPANCIES BETWEEN
ACTUAL CONDITIONS AND THESE DRAWINGS.

THESE DOCUMENTS ARE TO BE USED FOR INTERIOR BUILD-OUT ONLY, GETSLOFF DESIGN GROUP IS NOT RESPONSIBLE OR LIABLE FOR ANY STRUCTURAL, MECHANICAL, ELECTRICAL OR PLUMBING DESIGN/ENGINEERING, REFER TO ARCHITECT'S CODE COMPLIANT DRAWINGS FOR ANY ISSUES RELATING TO ADA OR LIFE-SAFTEY WHICH MAY BE REQUIRED BY LOCAL OR STATE JURISDICTION.

NOTE: FIELD MEASURE BEFORE BEGINNING CONSTRUCTION DRAWINGS

APPROVED: TENANT______ DATE: ______

LANDLORD: DATE:



Getsloff Design Group, Inc. 15 Fishers Road, Suite 205 Pittsford NY, 14534 Tel: (585) 425-0932 www.getsloffdesigngroup.com



DRAWING ALTERATION

IT IS A VIOLATION FOR ANY PERSON TO ALTER ANY ITEM ON THIS DOCUMENT IN ANY WAY WITHOUT THE WRITTEN RELEASE FROM GETSLOFF DESIGN

THESE DRAWINGS ARE THE PROPERTY OF GETSLOFF DESIGN GROUP AND ARE NOT TO BE USED, COPIED OR APPLIED WITHOUT WRITTEN CONSENT.

THE GETSLOFF DESIGN GROUP IS A FIRM OFFERING SERVICES IN SPACE PLANNING, PROJECT MANAGEMENT AND INTERIOR DESIGN, AND DOES NOT PRACTICE ARCHITECTURE OR ENGINEERING SERVICES. IT IS RECOMMENDED THAT A PROFESSIONAL, LICENSED INDIVIDUAL BE CONSULTED IN THE ABOVE AREAS AS REQUIRED BY LAW.

NO DATE DESCRIPTION

REVISIONS

ISSUED FOR PERMIT

ISSUED FOR CONST.

PROJECT

300 CANAL VIEW

LOCATION

300 CANAL VIEW
ROCHESTER, NEW YORK

DRAWING TITLE

ASSUMED
AS-BUILT GROUND LEVEL

SHEET NO.

SCALE:

AS


DRAWN BY:

JYI

CHECKED BY

MC

DATE:

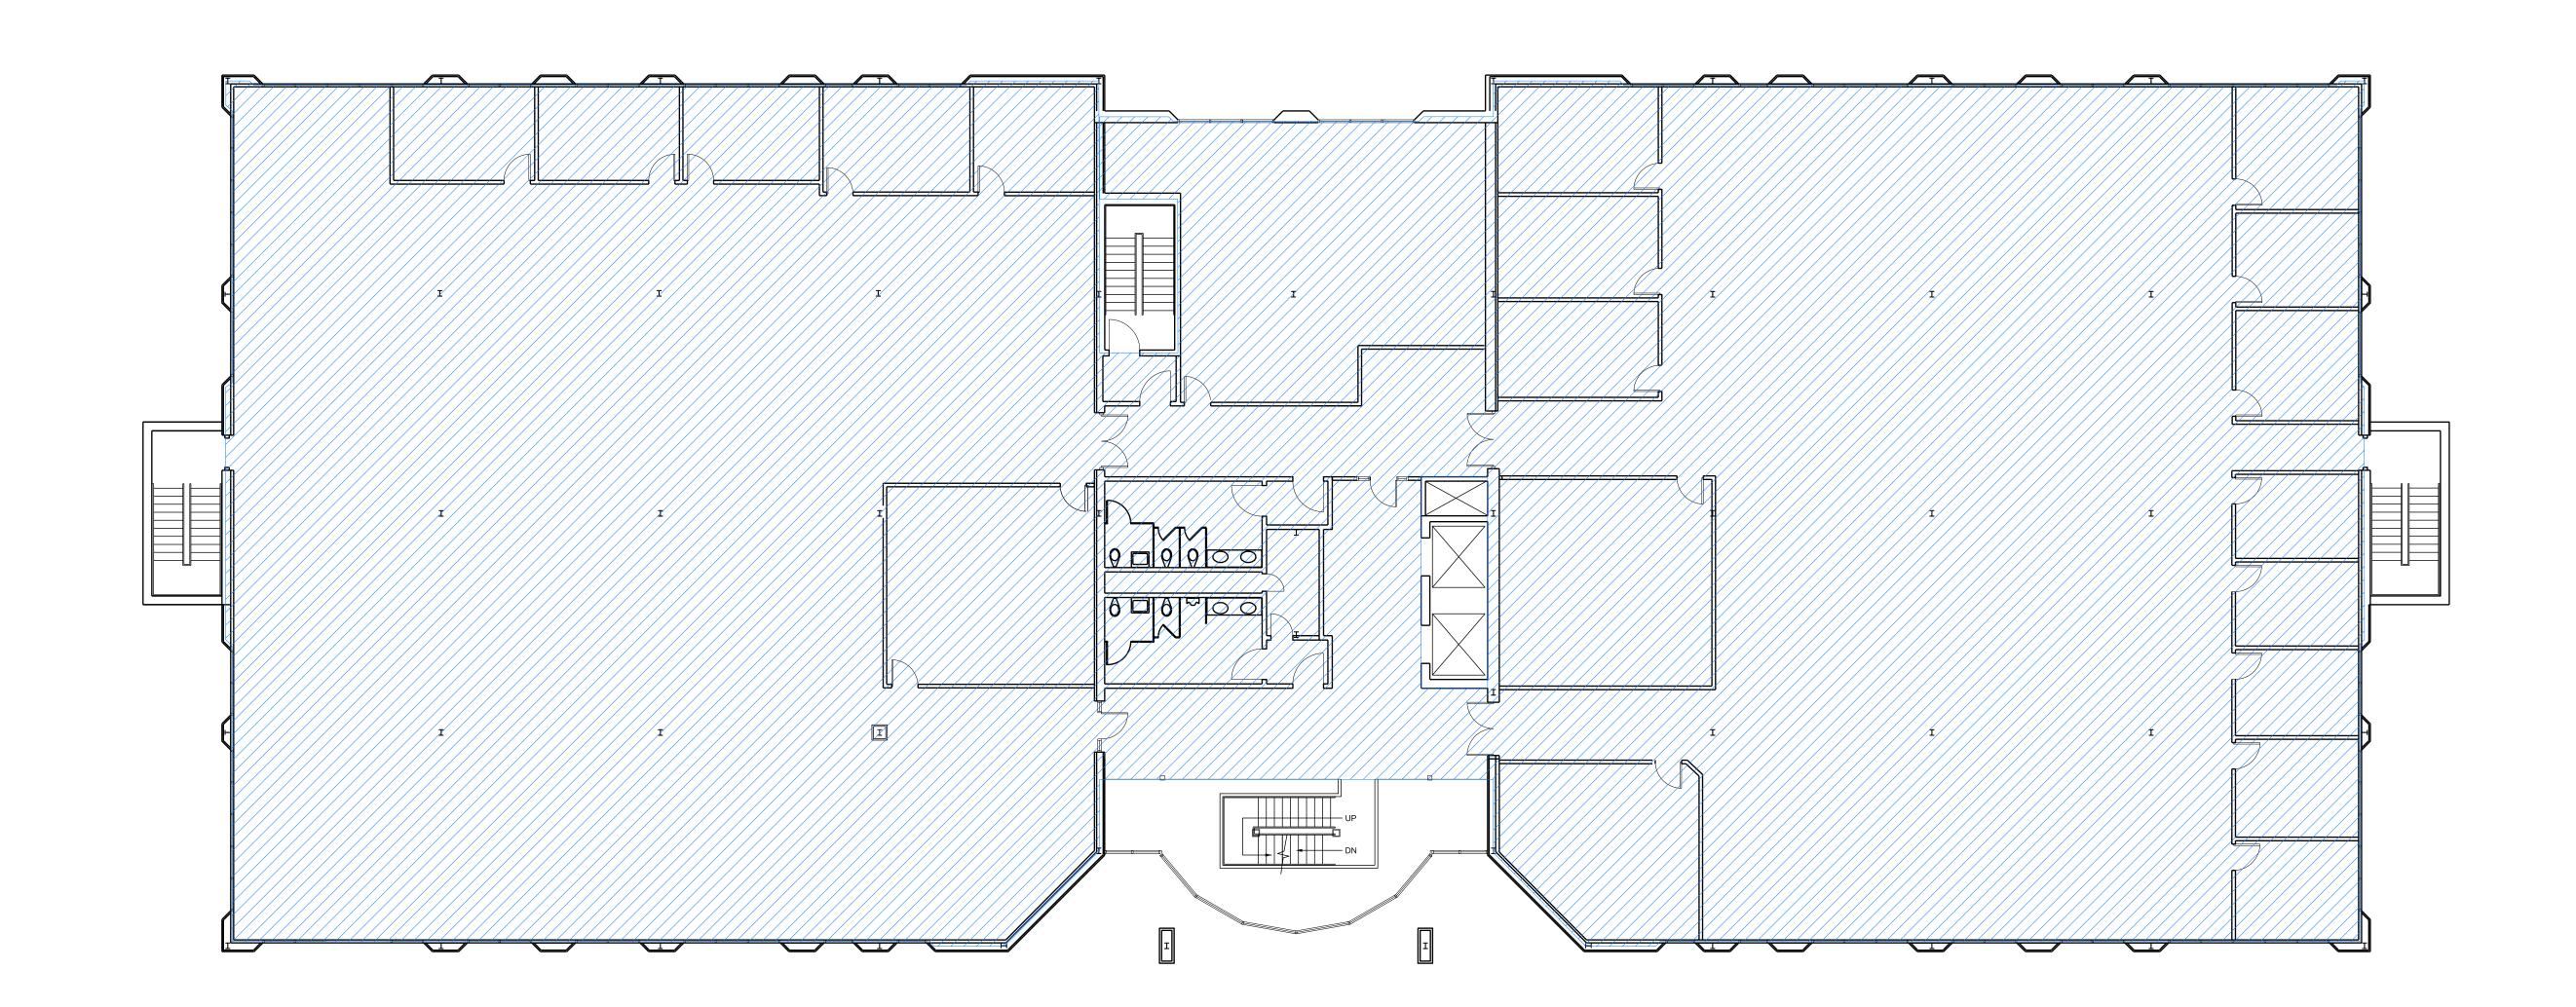

ASSUMED AS-BUILT FLOOR PLAN - SECOND LEVEL SCALE: 3/32" = 1'-0"

GENERAL NOTE:

VERIFY DIMENSIONS & CONDITIONS IN THE FIELD PRIOR TO CONSTRUCTION OF THE INFORMATION SHOWN ON THIS DRAWING, & NOTIFY THE GETSLOFF DESIGN GROUP OF ANY DISCREPANCIES BETWEEN ACTUAL CONDITIONS AND THESE DRAWINGS.

THESE DOCUMENTS ARE TO BE USED FOR INTERIOR BUILD-OUT ONLY, GETSLOFF DESIGN GROUP IS NOT RESPONSIBLE OR LIABLE FOR ANY STRUCTURAL, MECHANICAL, ELECTRICAL OR PLUMBING DESIGN/ENGINEERING, REFER TO ARCHITECT'S CODE COMPLIANT DRAWINGS FOR ANY ISSUES RELATING TO ADA OR LIFE-SAFTEY WHICH MAY BE REQUIRED BY LOCAL OR STATE JURISDICTION.

NOTE: FIELD MEASURE BEFORE BEGINNING CONSTRUCTION DRAWINGS

APPROVED: TENANT______ DATE: ______

LANDLORD: DATE:



Getsloff Design Group, Inc.
15 Fishers Road, Suite 205
Pittsford NY, 14534
Tel: (585) 425-0932
www.getsloffdesigngroup.com



DRAWING
ALTERATION

IT IS A VIOLATION FOR ANY PERSON TO
ALTER ANY ITEM ON THIS DOCUMENT
IN ANY WAY WITHOUT THE WRITTEN
RELEASE FROM GETSLOFF DESIGN

THESE DRAWINGS ARE THE PROPERTY OF GETSLOFF DESIGN GROUP AND ARE NOT TO BE USED, COPIED OR APPLIED WITHOUT WRITTEN CONSENT.

THE GETSLOFF DESIGN GROUP IS A FIRM OFFERING SERVICES IN SPACE PLANNING, PROJECT MANAGEMENT AND INTERIOR DESIGN, AND DOES NOT PRACTICE ARCHITECTURE OR ENGINEERING SERVICES. IT IS RECOMMENDED THAT A PROFESSIONAL, LICENSED INDIVIDUAL BE CONSULTED IN THE ABOVE AREAS AS REQUIRED BY LAW.

NO DATE DESCRIPTION

REVISIONS

ISSUED FOR PERMIT

ISSUED FOR CONST.

PROJECT

300 CANAL VIEW

LOCATION

300 CANAL VIEW
ROCHESTER, NEW YORK

DRAWING TITLE
ASSUMED
AS-BUILT SECOND LEVEL

SHEET NO.

DRAWN BY:

JYT


CHECKED BY:

MCG

DATE:

1 1/8/23

DRAWING:

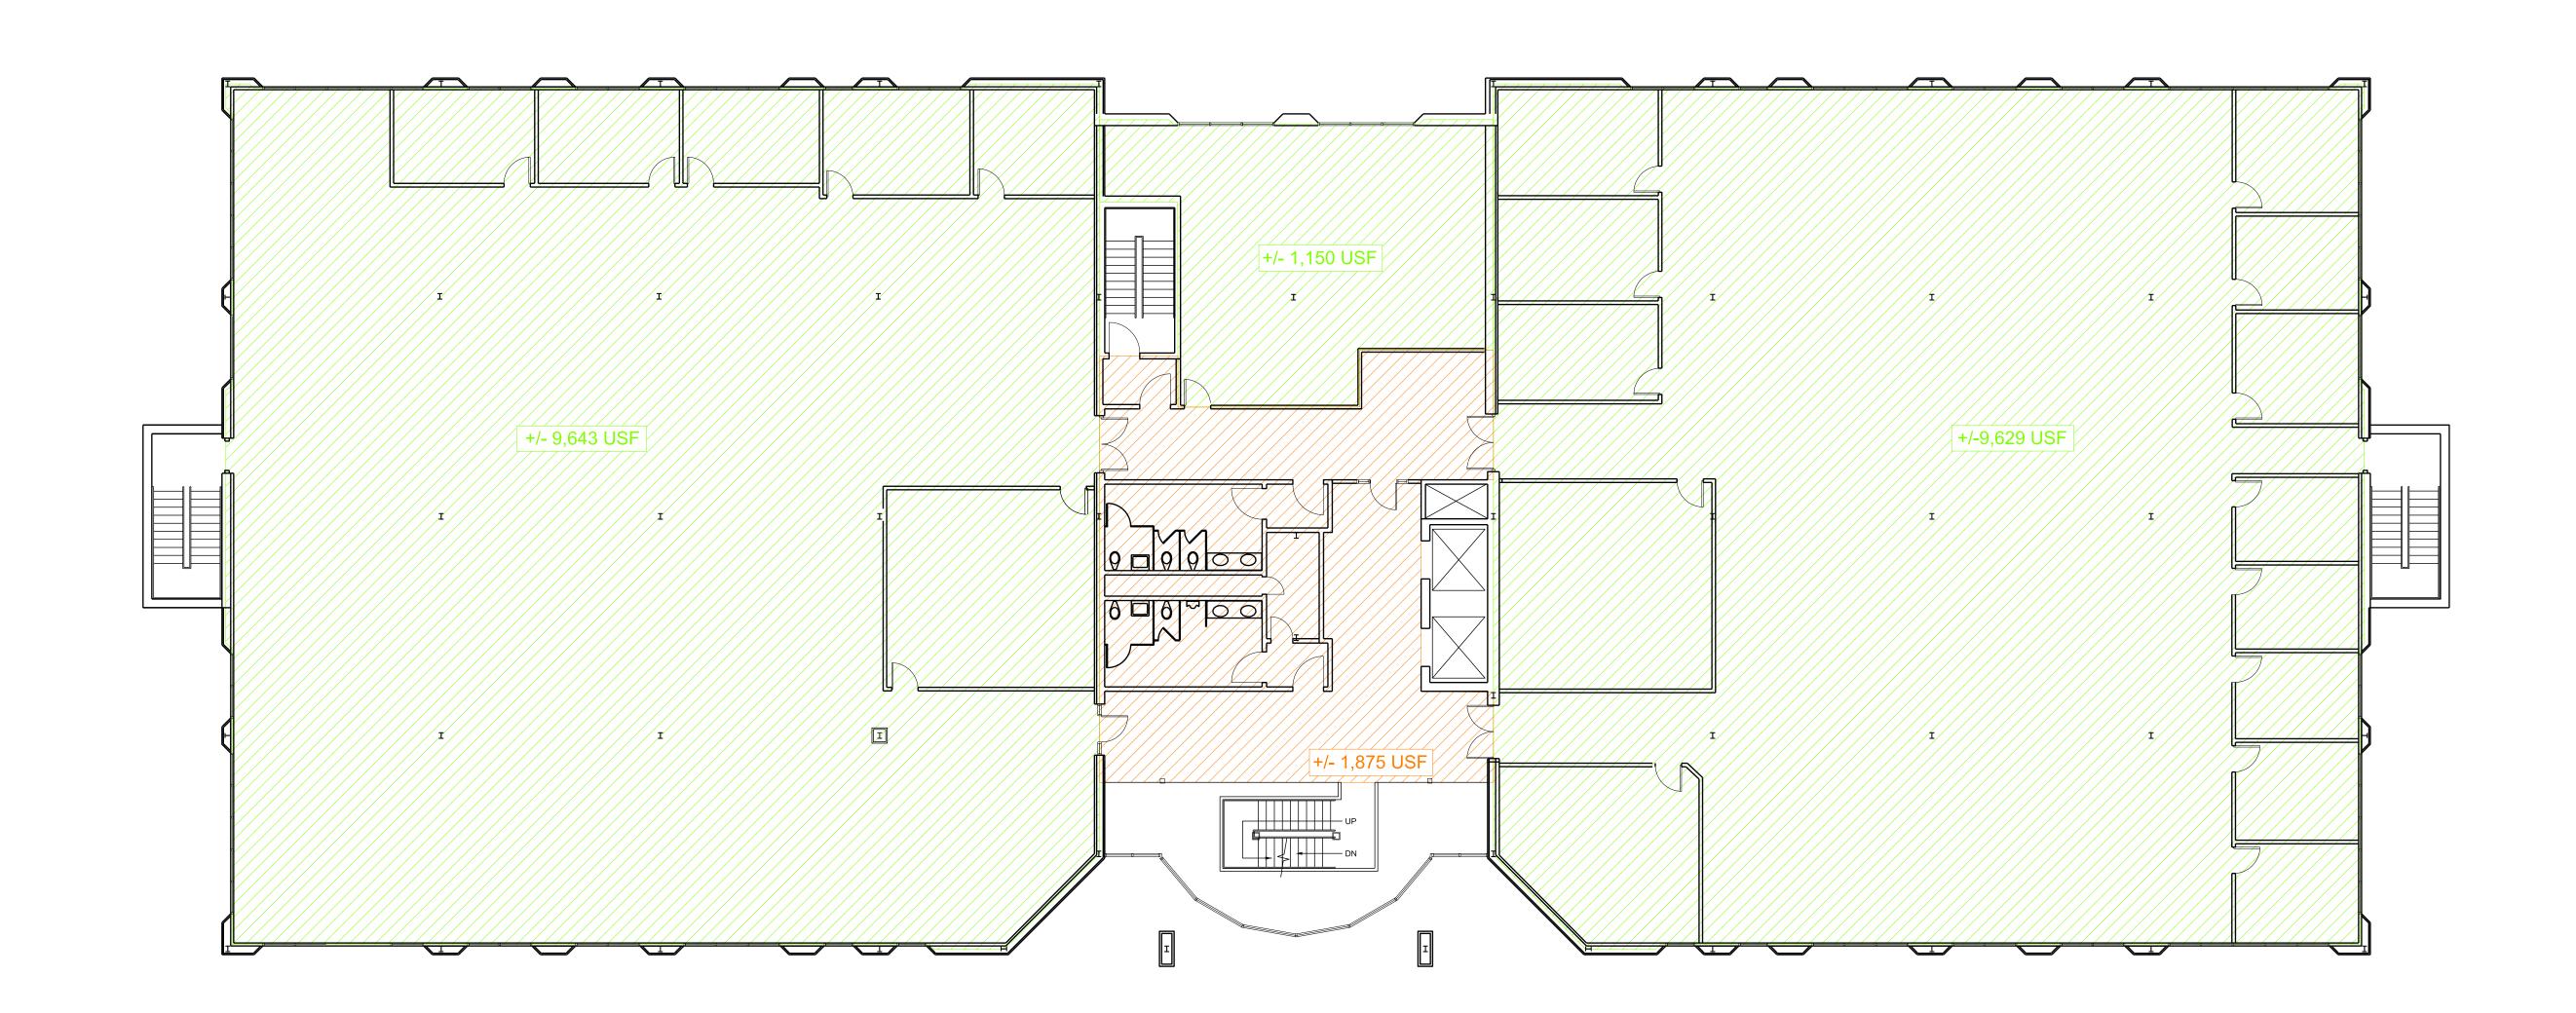

ASSUMED AS-BUILT FLOOR PLAN - SECOND LEVEL SCALE: 3/32" = 1'-0"

GENERAL NOTE:

VERIFY DIMENSIONS & CONDITIONS IN THE FIELD PRIOR
TO CONSTRUCTION OF THE INFORMATION SHOWN ON THIS DRAWING,
& NOTIFY THE GETSLOFF DESIGN GROUP OF ANY DISCREPANCIES BETWEEN
ACTUAL CONDITIONS AND THESE DRAWINGS.

THESE DOCUMENTS ARE TO BE USED FOR INTERIOR BUILD-OUT ONLY, GETSLOFF DESIGN GROUP IS NOT RESPONSIBLE OR LIABLE FOR ANY STRUCTURAL, MECHANICAL, ELECTRICAL OR PLUMBING DESIGN/ENGINEERING, REFER TO ARCHITECT'S CODE COMPLIANT DRAWINGS FOR ANY ISSUES RELATING TO ADA OR LIFE-SAFTEY WHICH MAY BE REQUIRED BY LOCAL OR STATE JURISDICTION.

NOTE: FIELD MEASURE BEFORE BEGINNING CONSTRUCTION DRAWINGS

APPROVED: TENANT______ DATE: ______

LANDLORD: DATE:



Getsloff Design Group, Inc.
15 Fishers Road, Suite 205
Pittsford NY, 14534
Tel: (585) 425-0932
www.getsloffdesigngroup.com



DRAWING ALTERATION

IT IS A VIOLATION FOR ANY PERSON TO ALTER ANY ITEM ON THIS DOCUMENT IN ANY WAY WITHOUT THE WRITTEN RELEASE FROM GETSLOFF DESIGN

THESE DRAWINGS ARE THE PROPERTY OF GETSLOFF DESIGN GROUP AND ARE NOT TO BE USED, COPIED OR APPLIED WITHOUT WRITTEN CONSENT.

THE GETSLOFF DESIGN GROUP IS A FIRM OFFERING SERVICES IN SPACE PLANNING, PROJECT MANAGEMENT AND INTERIOR DESIGN, AND DOES NOT PRACTICE ARCHITECTURE OR ENGINEERING SERVICES. IT IS RECOMMENDED THAT A PROFESSIONAL, LICENSED INDIVIDUAL BE CONSULTED IN THE ABOVE AREAS AS REQUIRED BY LAW.

REVISIONS

NO DATE DESCRIPTION

ISSUED FOR PERMIT
ISSUED FOR CONST.

PROJECT

300 CANAL VIEW

LOCATION

300 CANAL VIEW
ROCHESTER, NEW YORK

DRAWING TITLE
ASSUMED
AS-BUILT SECOND LEVEL


SHEET NO.

CHECKED BY:

MCG

DATE:

| 1 | /8/23

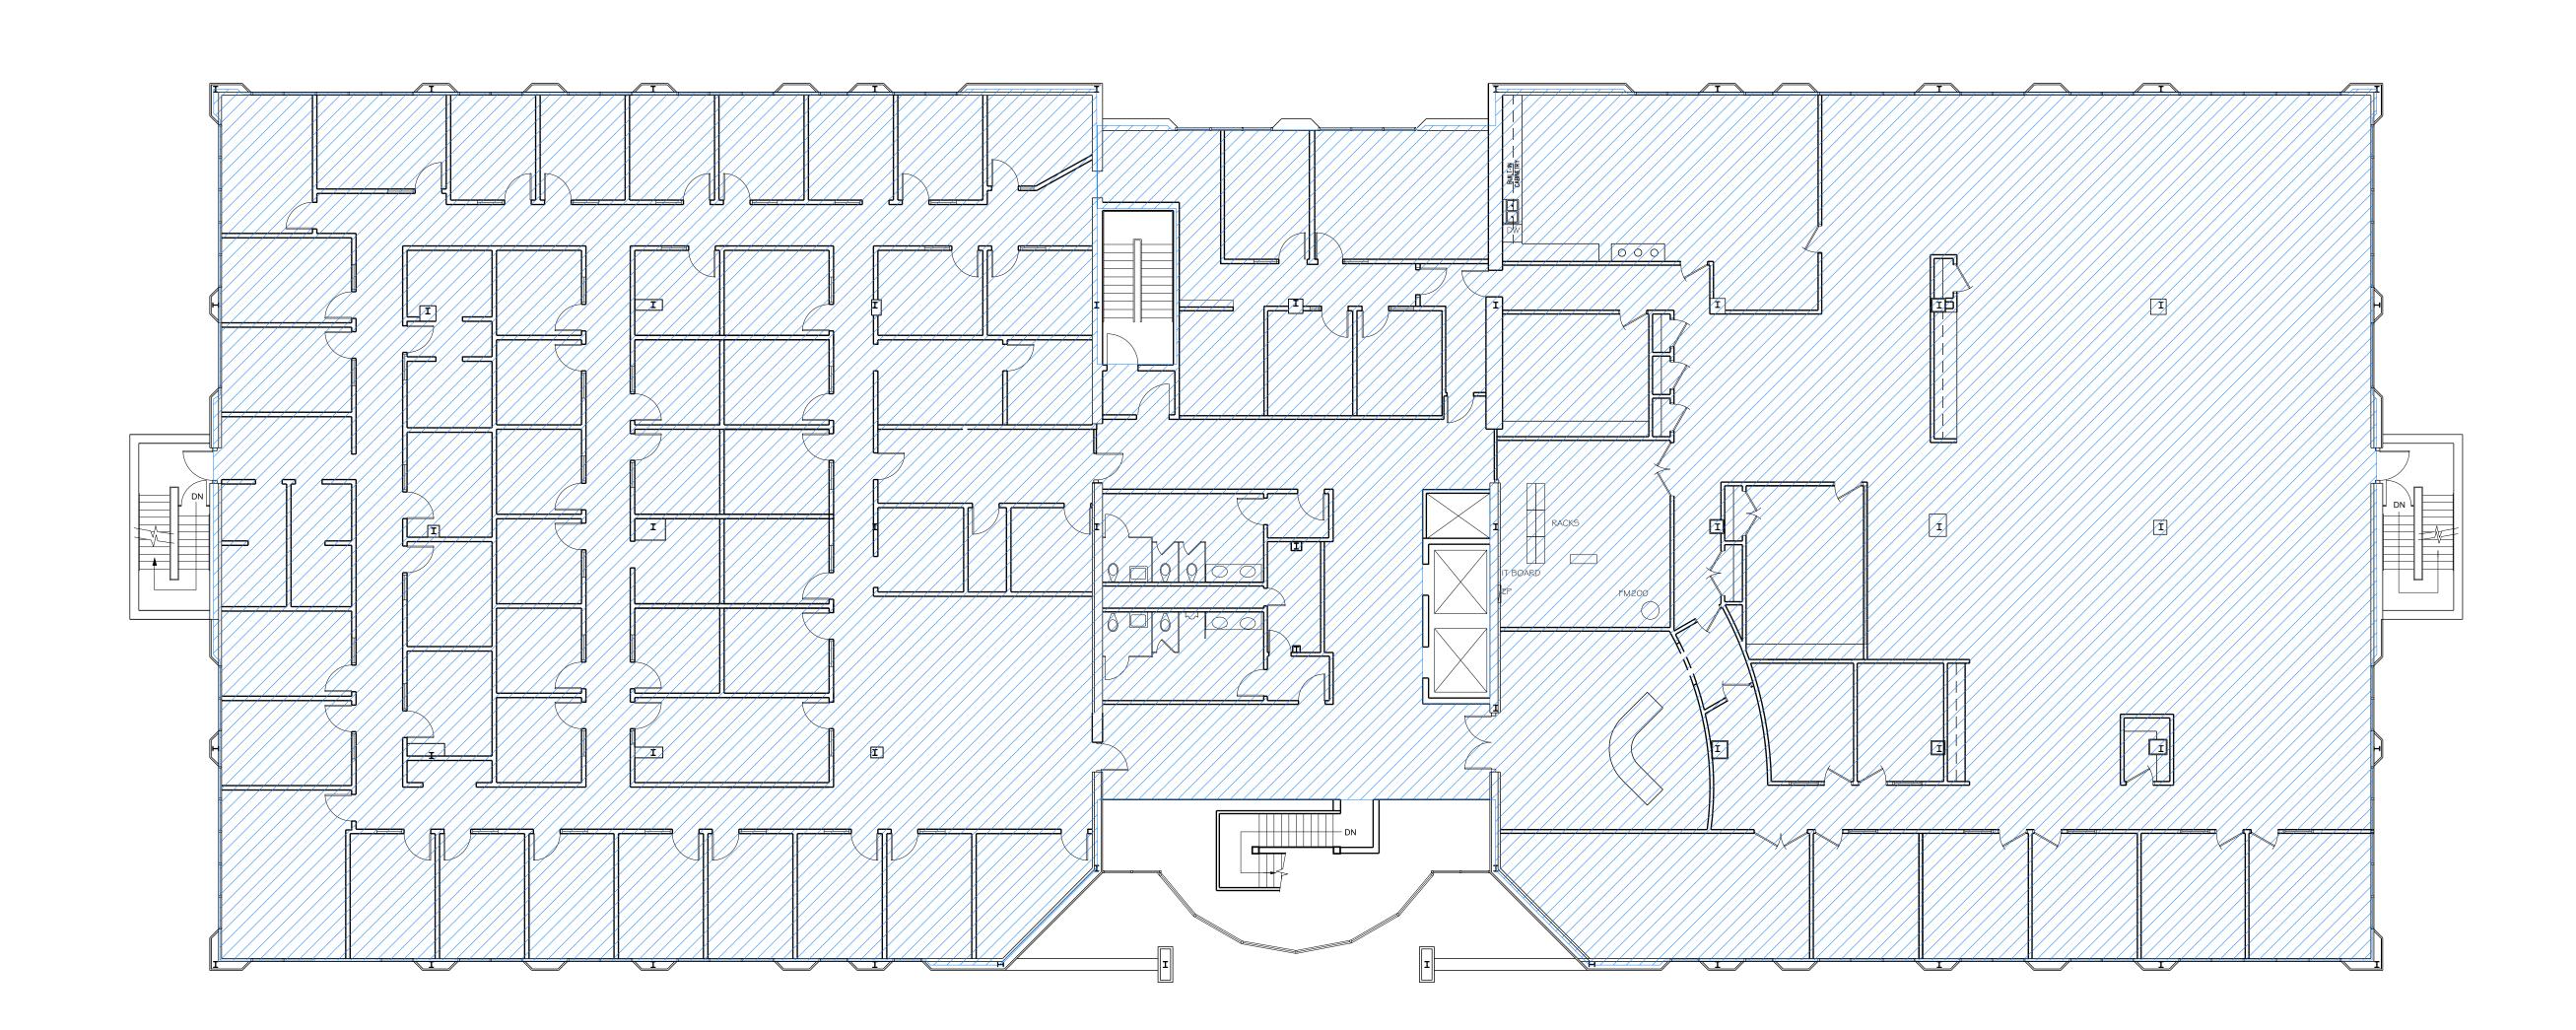

ASSUMED AS-BUILT FLOOR PLAN - THIRD LEVEL

SCALE: 3/32" = 1'-0"

GENERAL NOTE:

VERIFY DIMENSIONS & CONDITIONS IN THE FIELD PRIOR TO CONSTRUCTION OF THE INFORMATION SHOWN ON THIS DRAWING, & NOTIFY THE GETSLOFF DESIGN GROUP OF ANY DISCREPANCIES BETWEEN ACTUAL CONDITIONS AND THESE DRAWINGS.

THESE DOCUMENTS ARE TO BE USED FOR INTERIOR BUILD-OUT ONLY, GETSLOFF DESIGN GROUP IS NOT RESPONSIBLE OR LIABLE FOR ANY STRUCTURAL, MECHANICAL, ELECTRICAL OR PLUMBING DESIGN/ENGINEERING, REFER TO ARCHITECT'S CODE COMPLIANT DRAWINGS FOR ANY ISSUES RELATING TO ADA OR LIFE-SAFTEY WHICH MAY BE REQUIRED BY LOCAL OR STATE JURISDICTION.

NOTE: FIELD MEASURE BEFORE BEGINNING CONSTRUCTION DRAWINGS

APPROVED: TENANT______ DATE: ______

LANDLORD: DATE:



Getsloff Design Group, Inc. 15 Fishers Road, Suite 205 Pittsford NY, 14534 Tel: (585) 425-0932 www.getsloffdesigngroup.com



DRAWING ALTERATION

IT IS A VIOLATION FOR ANY PERSON TO
ALTER ANY ITEM ON THIS DOCUMENT
IN ANY WAY WITHOUT THE WRITTEN
RELEASE FROM GETSLOFF DESIGN

THESE DRAWINGS ARE THE PROPERTY OF GETSLOFF DESIGN GROUP AND ARE NOT TO BE USED, COPIED OR APPLIED WITHOUT WRITTEN CONSENT.

THE GETSLOFF DESIGN GROUP IS A FIRM OFFERING SERVICES IN SPACE PLANNING, PROJECT MANAGEMENT AND INTERIOR DESIGN, AND DOES NOT PRACTICE ARCHITECTURE OR ENGINEERING SERVICES. IT IS RECOMMENDED THAT A PROFESSIONAL, LICENSED INDIVIDUAL BE CONSULTED IN THE ABOVE AREAS AS REQUIRED BY LAW.

REVISIONS

NO DATE DESCRIPTION

ISSUED FOR PERMIT

ISSUED FOR CONST.

PROJECT

300 CANAL VIEW

LOCATION

300 CANAL VIEW
ROCHESTER, NEW YORK

DRAWING TITLE

ASSUMED

AS-BUILT THIRD LEVEL


SHEET NO.

DRAWN BY:
JYT

CHECKED BY:
MCG

DATE:
| 1 1/8/23

DRAWING:

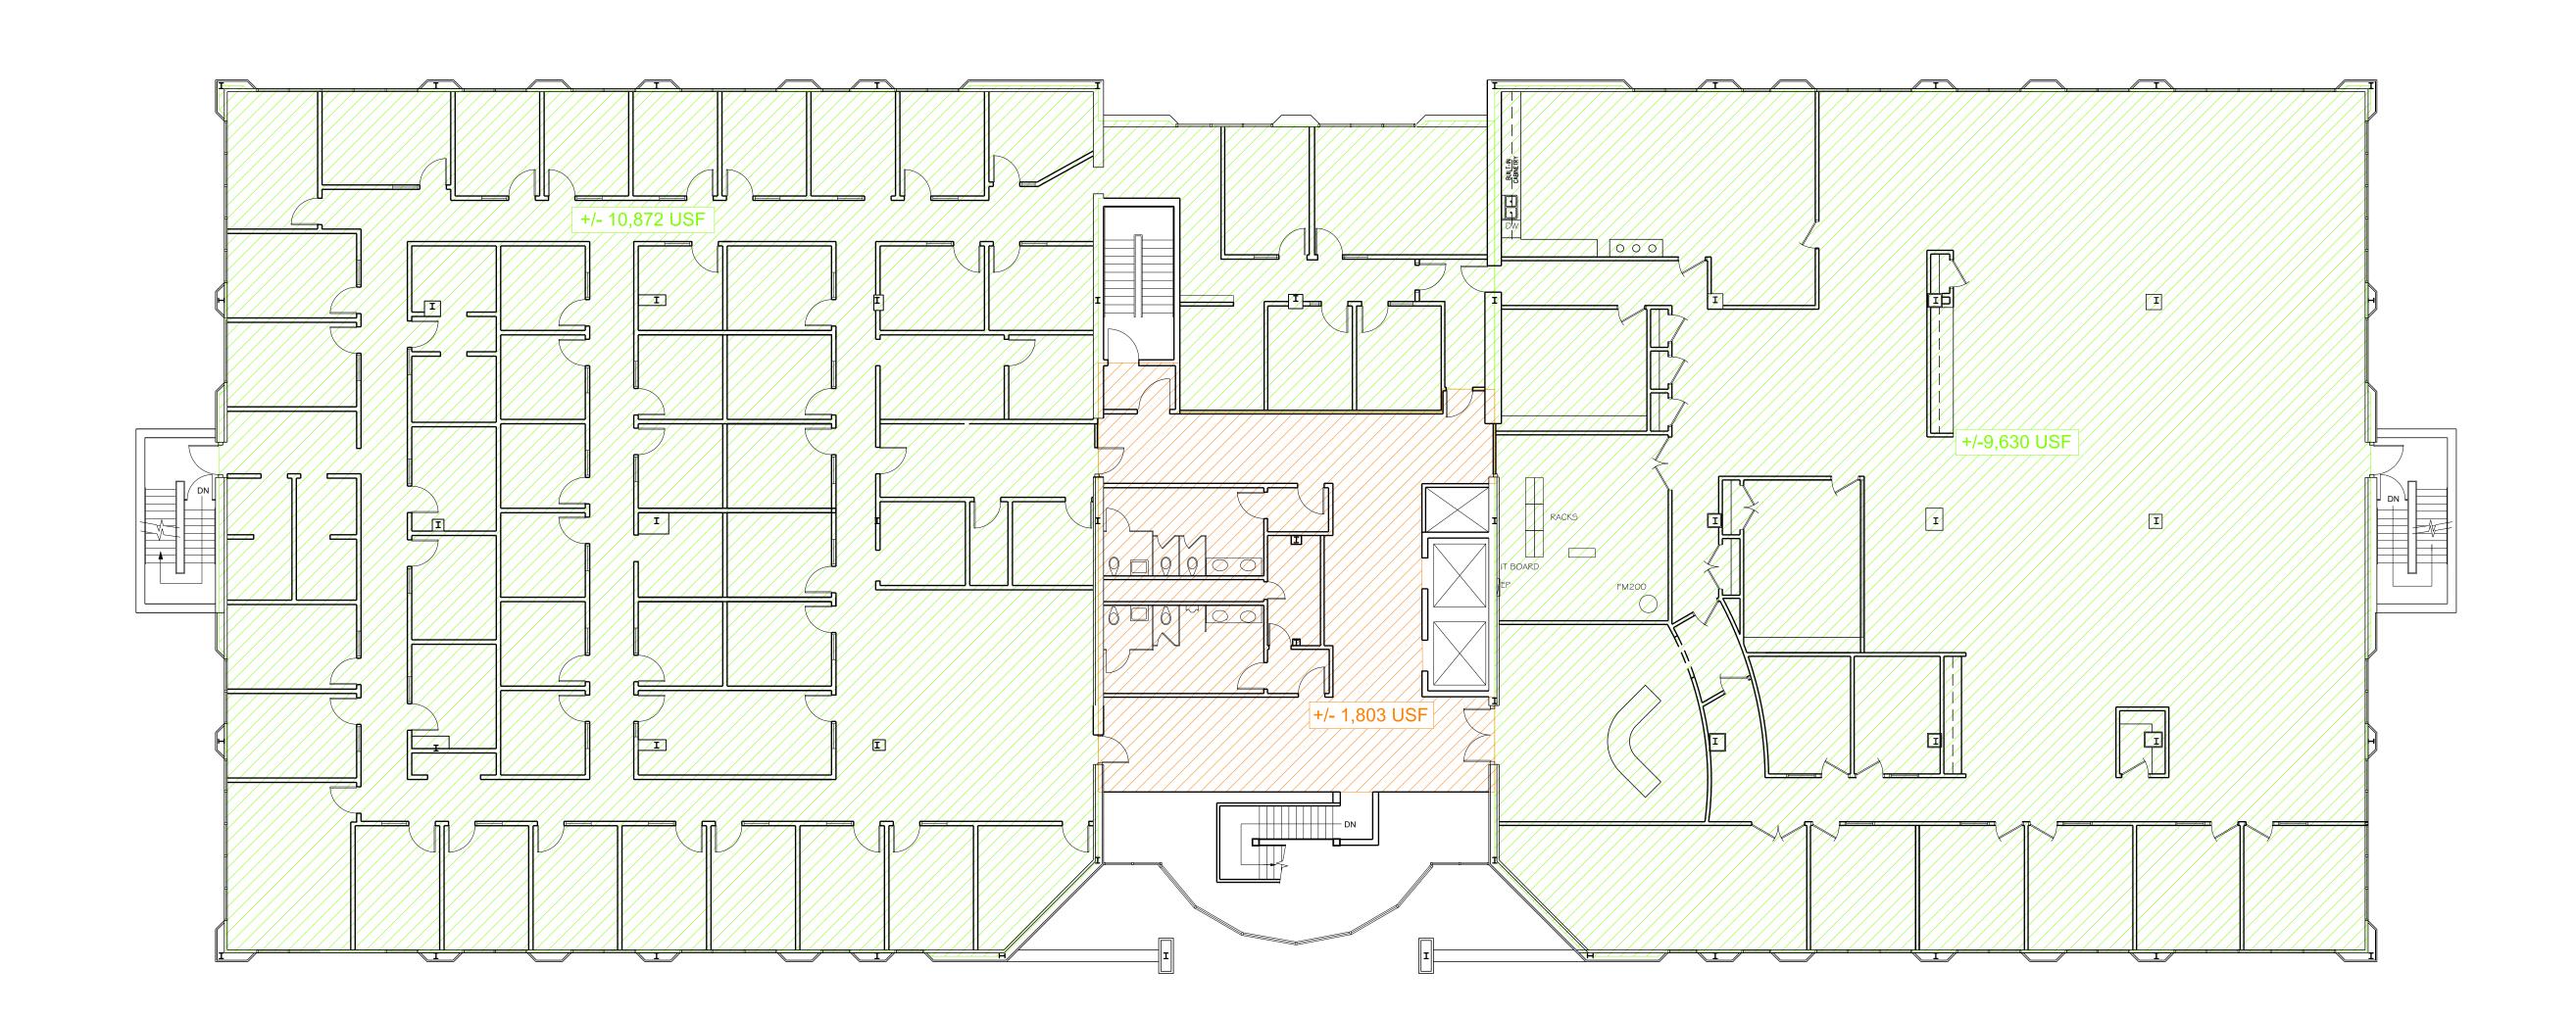

ASSUMED AS-BUILT FLOOR PLAN - THIRD LEVEL

SCALE: 3/32" = 1'-0"

GENERAL NOTE:

VERIFY DIMENSIONS & CONDITIONS IN THE FIELD PRIOR
TO CONSTRUCTION OF THE INFORMATION SHOWN ON THIS DRAWING,
& NOTIFY THE GETSLOFF DESIGN GROUP OF ANY DISCREPANCIES BETWEEN
ACTUAL CONDITIONS AND THESE DRAWINGS.

THESE DOCUMENTS ARE TO BE USED FOR INTERIOR BUILD-OUT ONLY, GETSLOFF DESIGN GROUP IS NOT RESPONSIBLE OR LIABLE FOR ANY STRUCTURAL, MECHANICAL, ELECTRICAL OR PLUMBING DESIGN/ENGINEERING, REFER TO ARCHITECT'S CODE COMPLIANT DRAWINGS FOR ANY ISSUES RELATING TO ADA OR LIFE-SAFTEY WHICH MAY BE REQUIRED BY LOCAL OR STATE JURISDICTION.

NOTE: FIELD MEASURE BEFORE BEGINNING CONSTRUCTION DRAWINGS

APPROVED: TENANT______ DATE: ______

LANDLORD: DATE:



Getsloff Design Group, Inc. 15 Fishers Road, Suite 205 Pittsford NY, 14534 Tel: (585) 425-0932 www.getsloffdesigngroup.com



DRAWING
ALTERATION

IT IS A VIOLATION FOR ANY PERSON TO
ALTER ANY ITEM ON THIS DOCUMENT
IN ANY WAY WITHOUT THE WRITTEN
RELEASE FROM GETSLOFF DESIGN

THESE DRAWINGS ARE THE PROPERTY OF GETSLOFF DESIGN GROUP AND ARE NOT TO BE USED, COPIED OR APPLIED WITHOUT WRITTEN CONSENT.

THE GETSLOFF DESIGN GROUP IS A FIRM OFFERING SERVICES IN SPACE PLANNING, PROJECT MANAGEMENT AND INTERIOR DESIGN, AND DOES NOT PRACTICE ARCHITECTURE OR ENGINEERING SERVICES. IT IS RECOMMENDED THAT A PROFESSIONAL, LICENSED INDIVIDUAL BE CONSULTED IN THE ABOVE AREAS AS REQUIRED BY LAW.

REVISIONS

NO DATE DESCRIPTION

ISSUED FOR PERMIT
ISSUED FOR CONST.

PROJECT

300 CANAL VIEW

LOCATION

300 CANAL VIEW
ROCHESTER, NEW YORK

DRAWING TITLE ASSUMED AS-BUILT THIRD LEVEL

SHEET NO.


CHECKED BY:

MCG

DATE:

| 1/8/23

DRAWING:

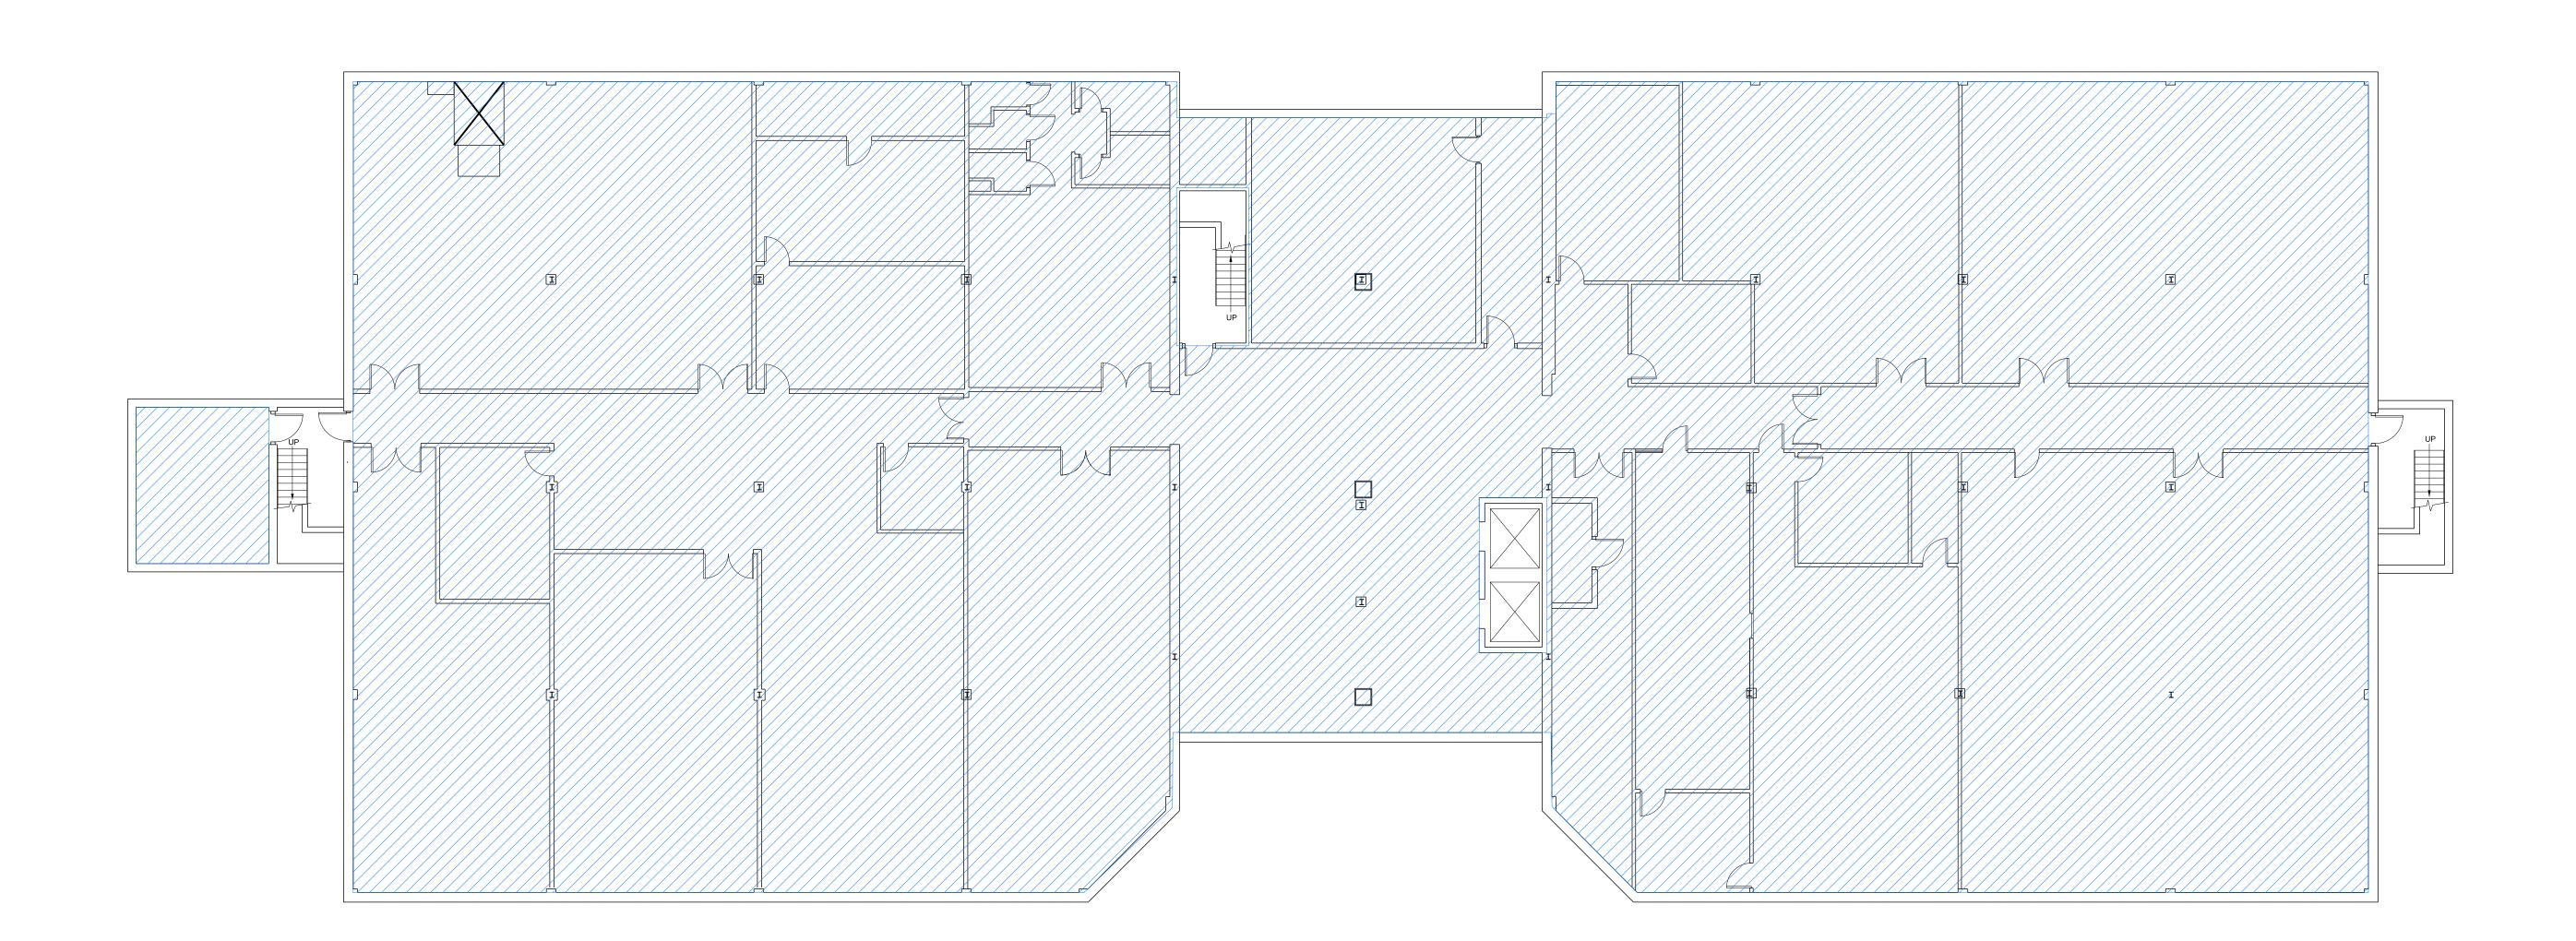

ASSUMED AS-BUILT FLOOR PLAN - LOWER LEVEL

SCALE: 3/32" = 1'-0"

GENERAL NOTE:

VERIFY DIMENSIONS & CONDITIONS IN THE FIELD PRIOR TO CONSTRUCTION OF THE INFORMATION SHOWN ON THIS DRAWING, & NOTIFY THE GETSLOFF DESIGN GROUP OF ANY DISCREPANCIES BETWEEN ACTUAL CONDITIONS AND THESE DRAWINGS.

THESE DOCUMENTS ARE TO BE USED FOR INTERIOR BUILD-OUT ONLY, GETSLOFF DESIGN GROUP IS NOT RESPONSIBLE OR LIABLE FOR ANY STRUCTURAL, MECHANICAL, ELECTRICAL OR PLUMBING DESIGN/ENGINEERING, REFER TO ARCHITECT'S CODE COMPLIANT DRAWINGS FOR ANY ISSUES RELATING TO ADA OR LIFE-SAFTEY WHICH MAY BE REQUIRED BY LOCAL OR STATE JURISDICTION.

NOTE: FIELD MEASURE BEFORE BEGINNING CONSTRUCTION DRAWINGS

APPROVED: TENANT______ DATE: ______

LANDLORD: DATE:



Getsloff Design Group, Inc. 15 Fishers Road, Suite 205 Pittsford NY, 14534 Tel: (585) 425-0932 www.getsloffdesigngroup.com



DRAWING
ALTERATION

IT IS A VIOLATION FOR ANY PERSON TO
ALTER ANY ITEM ON THIS DOCUMENT
IN ANY WAY WITHOUT THE WRITTEN
RELEASE FROM GETSLOFF DESIGN

THESE DRAWINGS ARE THE PROPERTY OF GETSLOFF DESIGN GROUP AND ARE NOT TO BE USED, COPIED OR APPLIED WITHOUT WRITTEN CONSENT.

THE GETSLOFF DESIGN GROUP IS A FIRM OFFERING SERVICES IN SPACE PLANNING, PROJECT MANAGEMENT AND INTERIOR DESIGN, AND DOES NOT PRACTICE ARCHITECTURE OR ENGINEERING SERVICES. IT IS RECOMMENDED THAT A PROFESSIONAL, LICENSED INDIVIDUAL BE CONSULTED IN THE ABOVE AREAS AS REQUIRED BY LAW.

NO DATE DESCRIPTION

REVISIONS

ISSUED FOR PERMIT
ISSUED FOR CONST.

PROJECT

300 CANAL VIEW

LOCATION

300 CANAL VIEW
ROCHESTER, NEW YORK

DRAWING TITLE
ASSUMED
AS-BUILT LOWER LEVEL

SHEET NO.

DRAWN BY:

JYT


CHECKED BY:

MCG

DATE:

| 1/8/23

DRAWING:

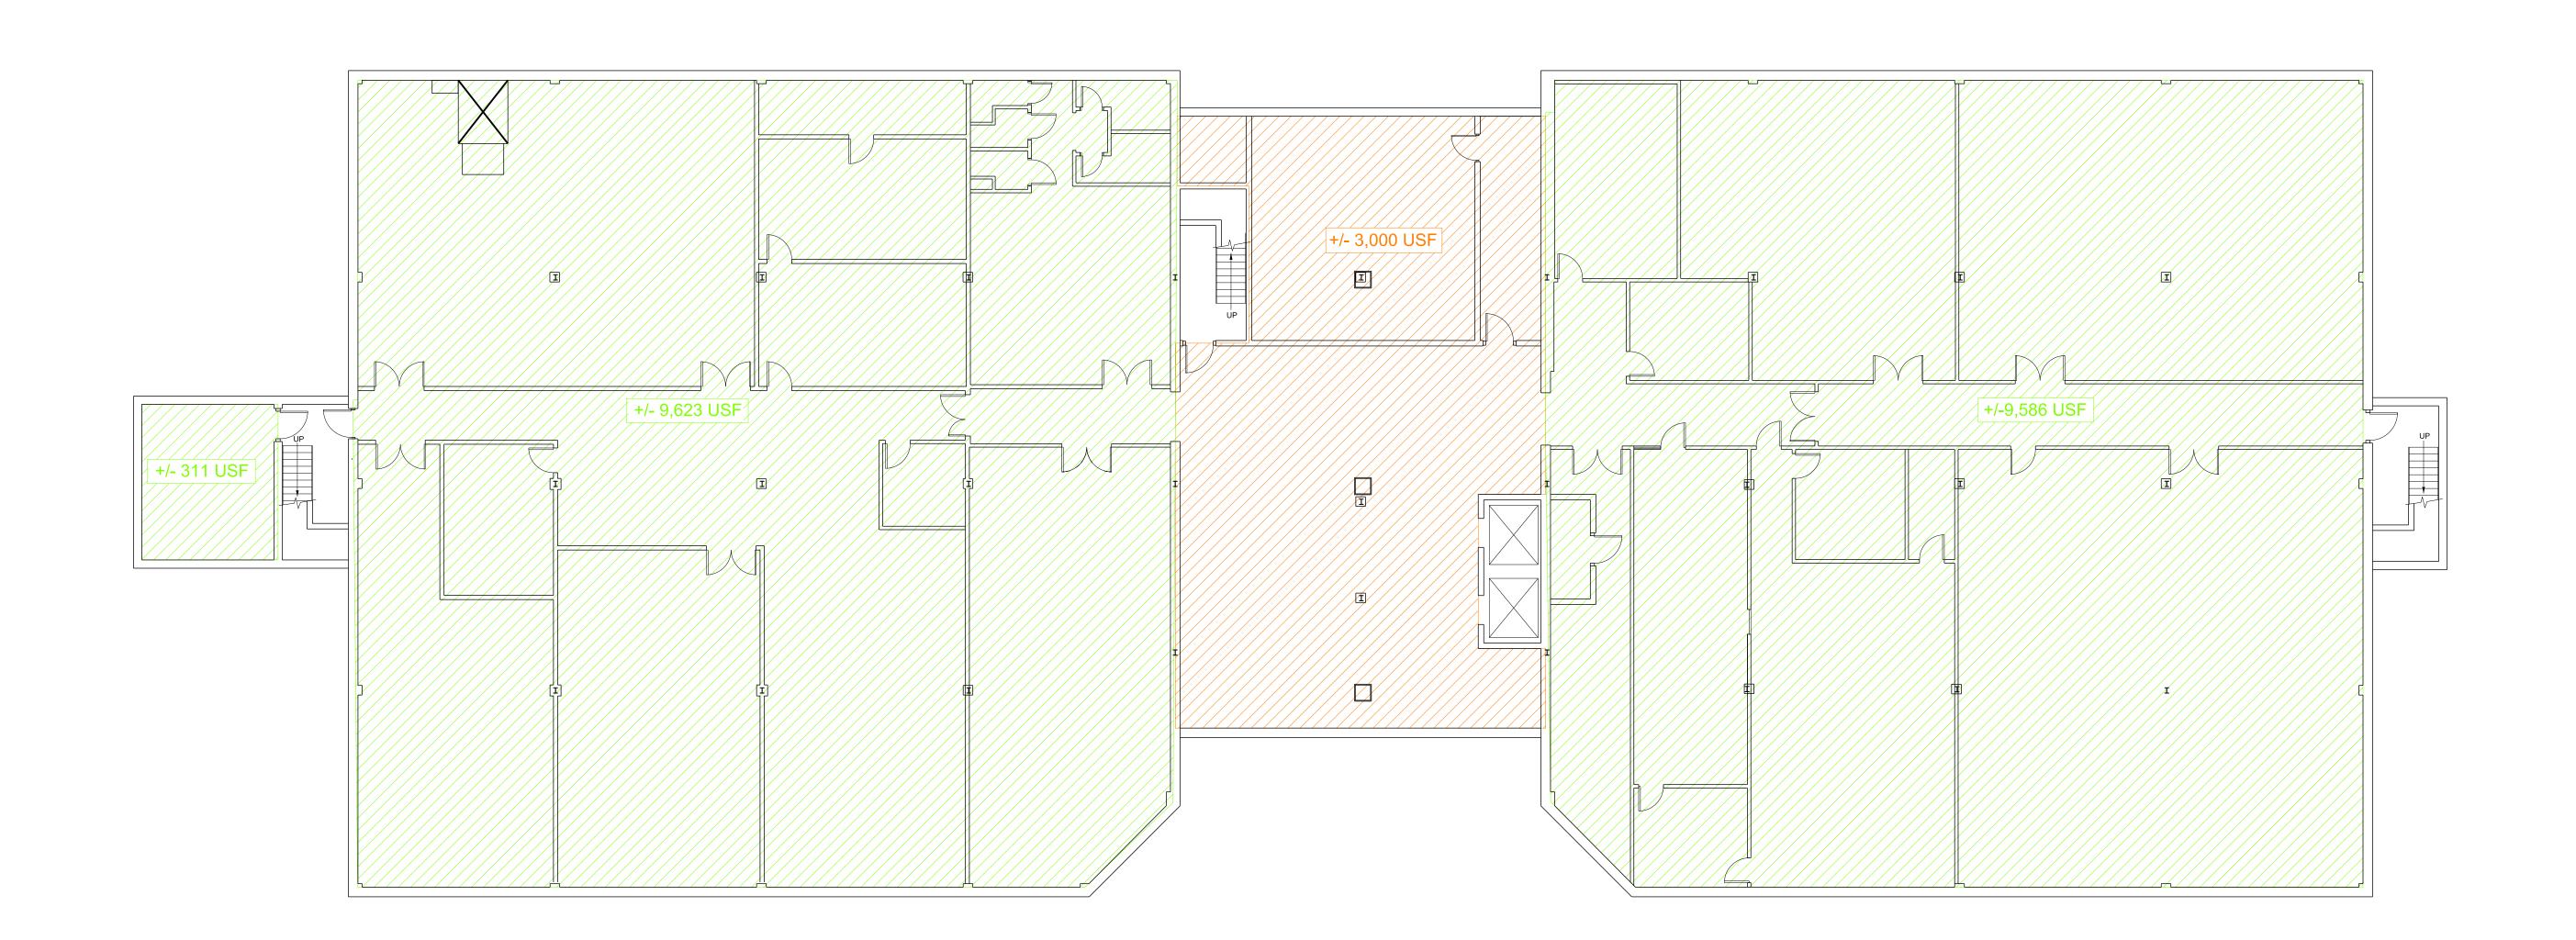

ASSUMED AS-BUILT FLOOR PLAN - LOWER LEVEL

SCALE: 3/32" = 1'-0"

GENERAL NOTE:

VERIFY DIMENSIONS & CONDITIONS IN THE FIELD PRIOR
TO CONSTRUCTION OF THE INFORMATION SHOWN ON THIS DRAWING,
& NOTIFY THE GETSLOFF DESIGN GROUP OF ANY DISCREPANCIES BETWEEN
ACTUAL CONDITIONS AND THESE DRAWINGS.

THESE DOCUMENTS ARE TO BE USED FOR INTERIOR BUILD-OUT ONLY, GETSLOFF DESIGN GROUP IS NOT RESPONSIBLE OR LIABLE FOR ANY STRUCTURAL, MECHANICAL, ELECTRICAL OR PLUMBING DESIGN/ENGINEERING, REFER TO ARCHITECT'S CODE COMPLIANT DRAWINGS FOR ANY ISSUES RELATING TO ADA OR LIFE-SAFTEY WHICH MAY BE REQUIRED BY LOCAL OR STATE JURISDICTION.

NOTE: FIELD MEASURE BEFORE BEGINNING CONSTRUCTION DRAWINGS

APPROVED: TENANT______ DATE: ______

LANDLORD: DATE:



Getsloff Design Group, Inc.
15 Fishers Road, Suite 205
Pittsford NY, 14534
Tel: (585) 425-0932
www.getsloffdesigngroup.com



DRAWING
ALTERATION

IT IS A VIOLATION FOR ANY PERSON TO
ALTER ANY ITEM ON THIS DOCUMENT
IN ANY WAY WITHOUT THE WRITTEN
RELEASE FROM GETSLOFF DESIGN
GROUP.

THESE DRAWINGS ARE THE PROPERTY OF GETSLOFF DESIGN GROUP AND ARE NOT TO BE USED, COPIED OR APPLIED WITHOUT WRITTEN CONSENT.

THE GETSLOFF DESIGN GROUP IS A FIRM OFFERING SERVICES IN SPACE PLANNING, PROJECT MANAGEMENT AND INTERIOR DESIGN, AND DOES NOT PRACTICE ARCHITECTURE OR ENGINEERING SERVICES. IT IS RECOMMENDED THAT A PROFESSIONAL, LICENSED INDIVIDUAL BE CONSULTED IN THE ABOVE AREAS AS REQUIRED BY LAW.

NO DATE DESCRIPTION

REVISIONS

ISSUED FOR PERMIT
ISSUED FOR CONST.

PROJECT

300 CANAL VIEW

LOCATION

300 CANAL VIEW
ROCHESTER, NEW YORK

DRAWING TITLE ASSUMED AS-BUILT LOWER LEVEL

SHEET NO.

DRAWN BY:

JYT

CHECKED BY:

MCG

DATE:

11/8/23

DRAWING: