


Corporate

Interior

Design

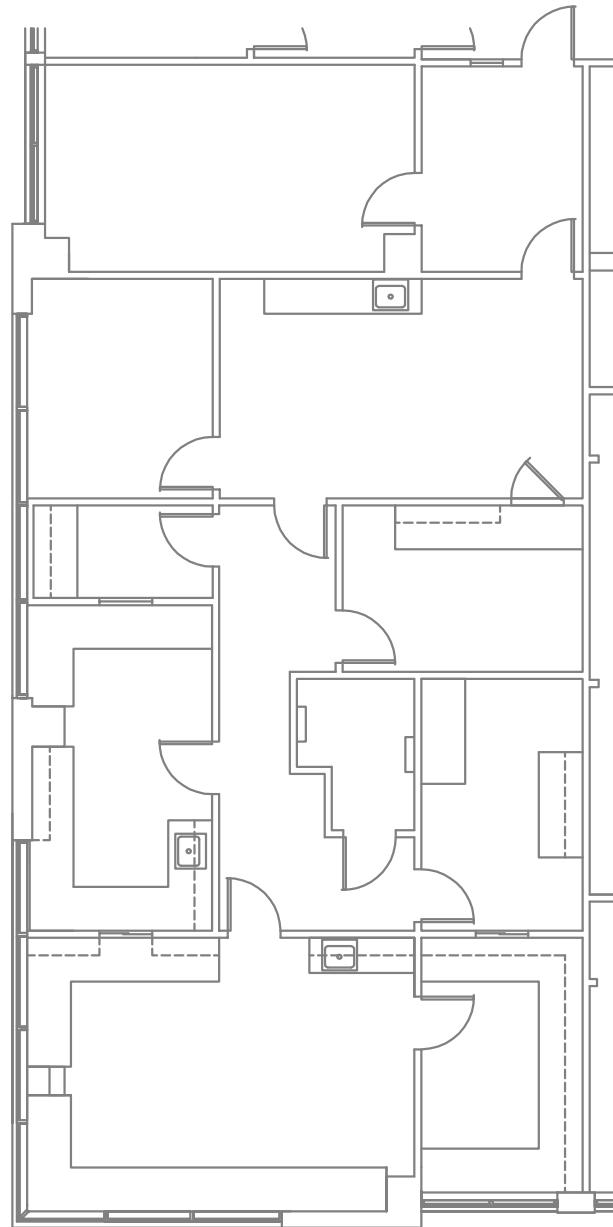

2115 Eighth Avenue South
Nashville, Tennessee
37204

PH:(615) 726-1141
FAX: (615) 726-1098

PROJECT: APSEN GROVE MEDICAL CENTER/ SUITE 200 LOCATION: 125 COOL SPRINGS BLVD., FRANKLIN, TN	DATE: 2/15/2022
RE: AS-BUILT FLOOR PLAN SCALE: NOT TO SCALE	SHEET: 1 OF 1 JOB #: 11526-000