

GILBERT  
HEALTH  
CENTER


## Floor 01

Suite 120

AS-BUILT

1,059 SF

AVAILABLE

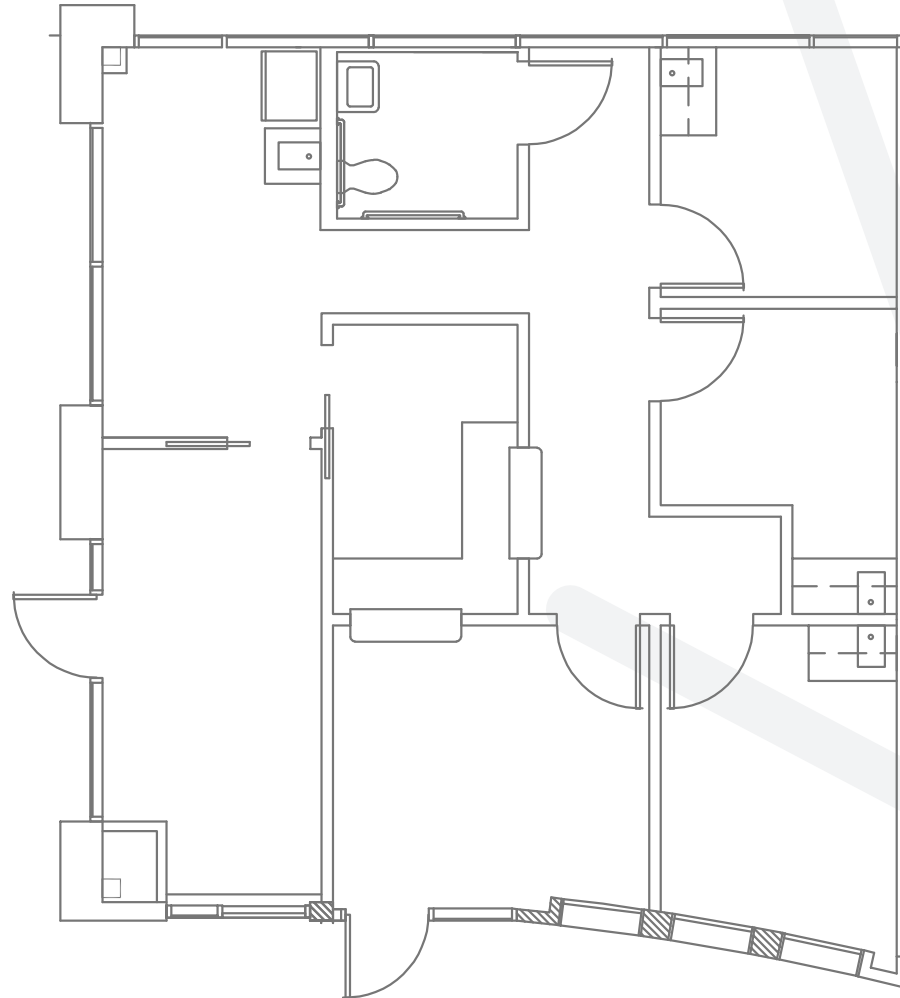

**RACHAEL THOMPSON**  
Senior Vice President  
602.513.5122  
rachael.thompson@kidder.com

**PERRY GABUZZI, CCIM**  
Executive Vice President  
602.513.5116  
perry.gabuzzi@kidder.com

GILBERT  
HEALTH  
CENTER


## Floor 02

Suite 207

AS-BUILT

1,668 SF

AVAILABLE

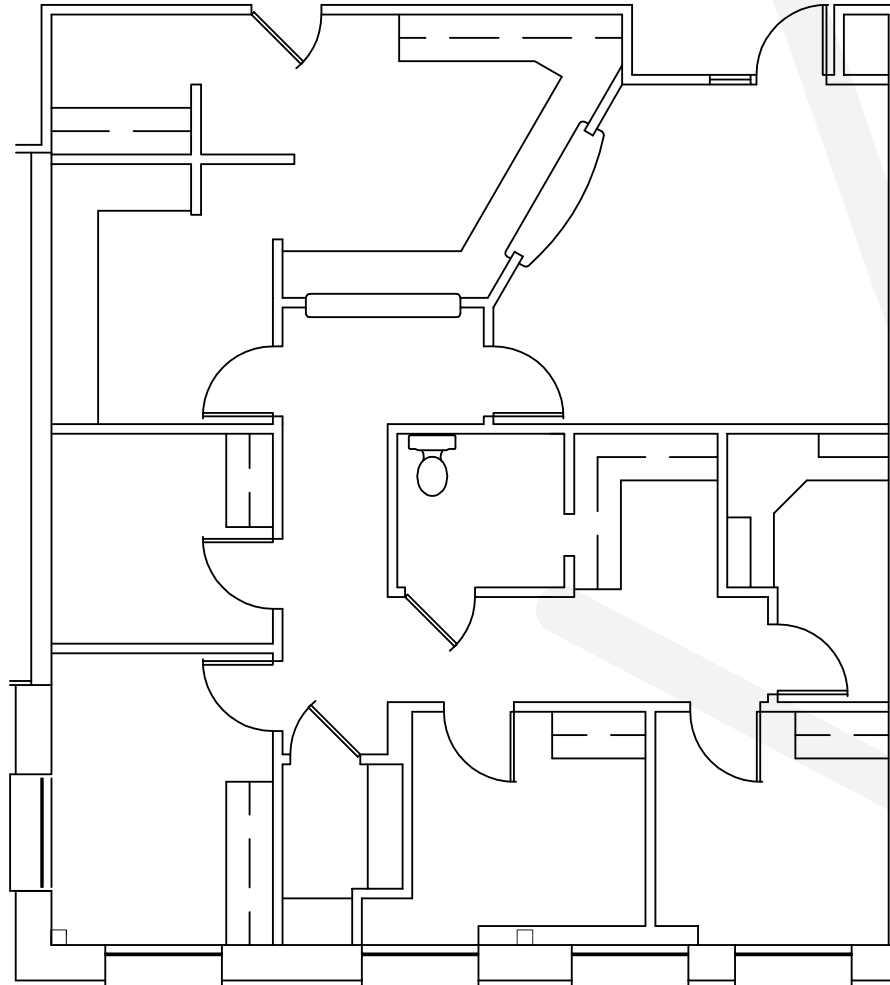

**RACHAEL THOMPSON**  
Senior Vice President  
602.513.5122  
rachael.thompson@kidder.com

**PERRY GABUZZI, CCIM**  
Executive Vice President  
602.513.5116  
perry.gabuzzi@kidder.com