



plans approved by city and submitted to contractors
 015
 type K Fire Extinguishers

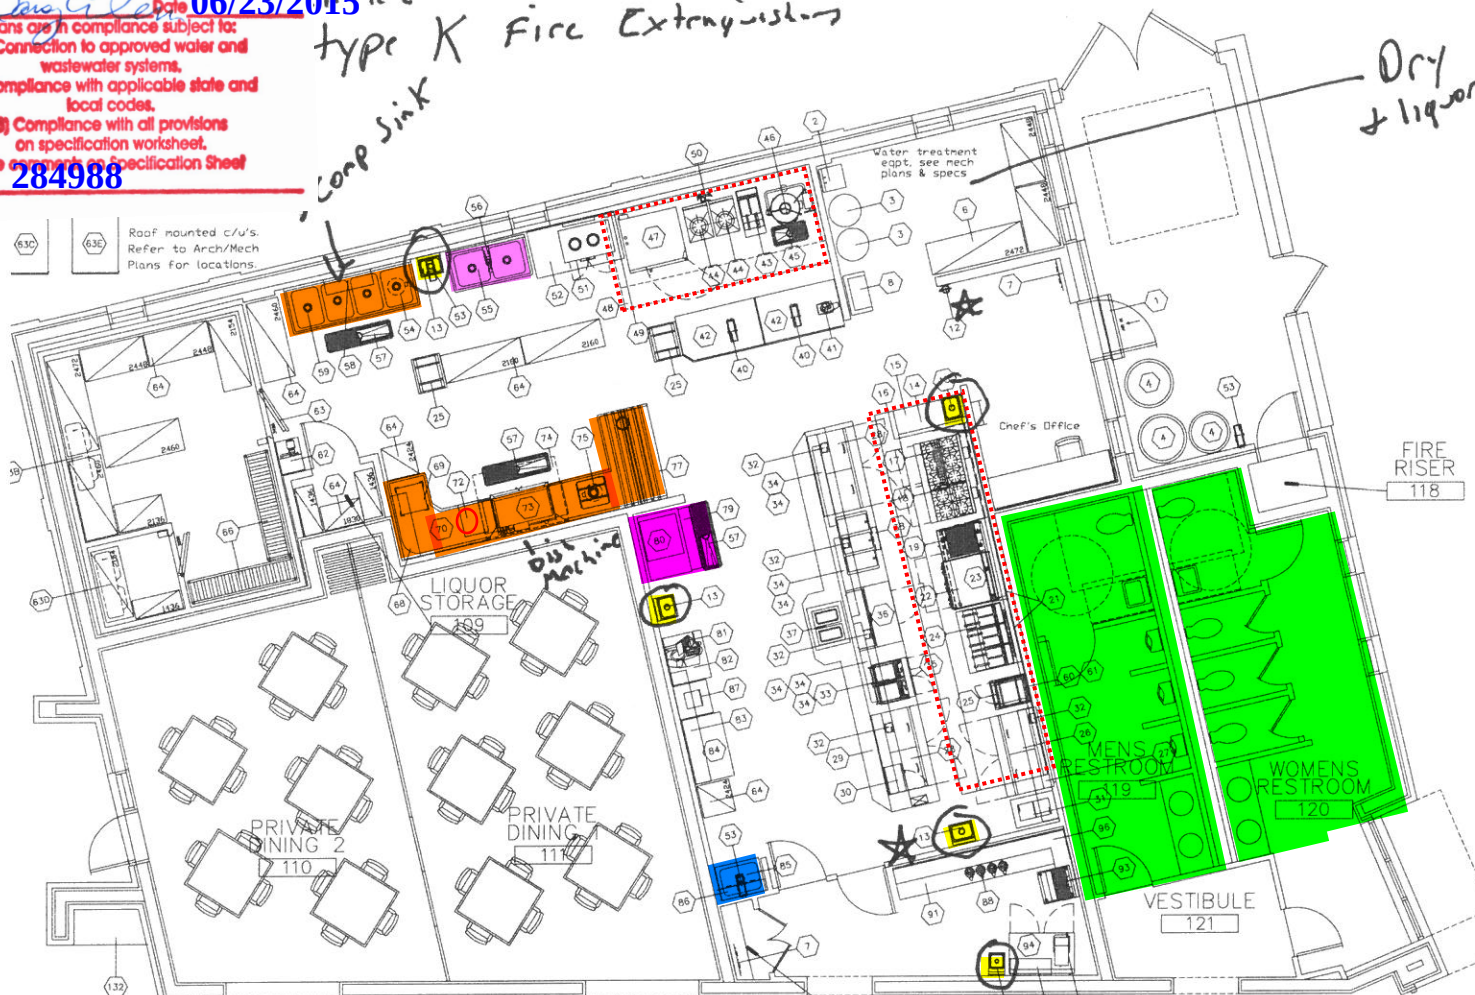

EQUIPMENT SCHEDULE	
ITEM NO	ITEM/EQUIPMENT CATEGORY
1	1 AIR CURTAIN, UNHEATED
2	1 WALL MTD NITROGEN GEN
3	1 FLOZ TANK - VENDOR
4	1 LOT OIL RECOVERY SYSTEM-BY VENDORS
5	10 FLY LIGHTS, NOT SHOWN - BY GC/MECH
6	10 SHIELDING, WIRE
7	2 BROOK & GUSTAFSON HANGER
8	10 LAG-INS-A-BOX TRACK
9	1 OPEN NUMBER
10	1 OPEN NUMBER
11	1 OPEN NUMBER
12	1 FIRE EXTINGUISHER - BY GC
13	10000 GPM SINK, MOUNT
14	1 FUME SUPPRESSOR - BY MECH
15	10 DOWHAIST SYSTEM - BY MECH
16	10 SLY WALL FLASHING - BY MECH
17	1 SAAMANOIR BROWLER, GAS
18	1 NUCLEAR, RADIANT, GAS
19	1 CHAF BROWLER, HEAVY DUTY, GAS
20	1 OPEN NUMBER
21	10 DOUBLE WALL SHELVES
22	1 EQUIPMENT STAND, REF BASE
23	10000 GPM SINK
24	1 FLYER BATTERY, GAS W/UTER
25	3 RACK, PAN
26	1 REFRIGERATOR, SANOWMCH UNIT
27	3 SHELF, WALL MOUNT
28	2 REFRIGERATOR, SANOWMCH UNIT
29	10 SHELF, WALL MOUNT
30	1 OVEN, MICROWAVE
31	1 ICE CREAM FRIER W/OPS/WELL-PRINTER
32	5 DIPS PENDING - BY VENDOR
33	1 CRODLE, DOUBLE-SIDED, ELECTRIC
34	1 KITCHEN, FISH, HORNHEAD
35	1 CABLE, WARMING & HOLDING
36	1 REFRIGERATOR, PIZZA PREP
37	1 GROP-IN, GOLD PAN
38	2 DROP-IN, HOT WELLS
39	10000 GPM SINK
40	1 ELEC CORO REEL - BY GC/MECH
41	1 FOOD PROCESSOR
42	2 MOBILE WORKTABSLS
43	1 PRYER, GAS W/UTER & SIDSPLASH
44	2 STOCK POT, HOT
45	1 TROUGH, TROUGH
46	1 KETTLE, STEAM JACKETED
47	1 DOUBBLE COMB, OVEN, ELECTRIC
48	10 DOWHAIST SYSTEM - BY MECH
49	10 SLY WALL FLASHING - BY MECH
50	1 JELLY, KETTLE & POT
51	1 ROTISSERIE, ELECTRIC
52	1 TABLE, WORK, W/ UNDERSHLF
53	2 HOSE REEL WITH GUN
54	1 DISPOSER, GARBAGE
55	1 PREP SINK
56	1 FRY CUTTER
57	3 PLORY CLOTH
58	1 SHELF, WALL MOUNT
59	4 COMPARTMENT SINK
60	1 OVEN, MICROWAVE/CONVECTION, COMB
61	1 SHELF, MICROWAVE
62	1 BEER SYSTEM W/WALLSHELF
63	1 WALK-IN COOLER/FREEZER
64	1 COOLER EVAPORATOR
65	1 REFRIGERATOR
66	1 FREEZER EVAPORATOR
67	1 FREEZER REMOTE COMPRESSOR
68	10 SHIELDING, WIRE
69	1 OPEN NUMBER
70	2 KETTLES, REEF
71	1 OPEN NUMBER
72	1 SHELF, WALL MOUNT
73	1 DISHLY, DISHWASH
74	1 DISHLY, SHAP, 14 GAUGE
75	1 OPEN NUMBER
76	1 WATER HEATER, BOOSTER, ELECTRIC
77	1 HIGH TEMP DISHWASHER - BY VENDOR
78	1 DISHWASHER DOWHAIST - BY MECH
79	1 DISPOSER, GARBAGE
80	1 OPEN NUMBER
81	1 DISHABLE, 1/2 SHAP, 14 GAUGE
82	1 BIN, ICE
83	1 ICE MAKER W/O BIN
84	1 SLEED, FOOD
85	1 TABLE, WORK, W/ UNDERSHLF
86	1 SHELF, WALL MOUNT
87	1 SINK, MOD - BY GC/MECH
88	1 SHELF, W/UTER HANGER
89	1 VACUUM SEALER
90	10 LOT/COT PRESSPOSTS - BY VENDOR
91	1 HAND SINK, WALL MOUNT
92	1 OPEN NUMBER
93	1 WILLOW, SERVICE COUNTER
94	1 MOLD/PLATE TANK - BY VENDOR
95	1 SODA DISPENSER - BY VENDOR
96	1 REFRIGERATOR, WORKTOP
97	1 OPEN NUMBER
98	2 SHELF, WALL - M/LWORK BY GC
99	1 OPEN NUMBER
100	1 OPEN NUMBER

**SEE PAGE 2
FOR NEW
DINING
ROOM AND
PATIO
LAYOUTS**

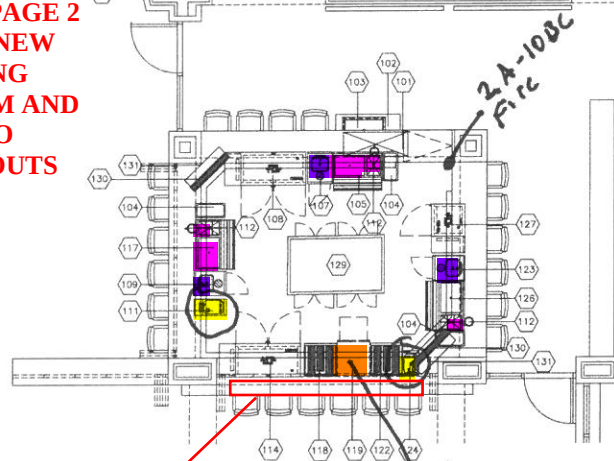

EQUIPMENT SCHEDULE	
ITEM NO	QTY EQUIPMENT CATEGORY
100	1 SPIN HUB
101	1 SPINNING LINE DRY CONTAINER
103	1 WALK-IN ICE CHEST W/400L/PLATE
104	3 SLAM IN TRAYS CAR
105	1 UNDERSTAND COMB ICE BIN
108	1 SPIN HUB
109	1 SPINNING LINE W/400L CONTAINER
110	1 SPIN HUB
111	1 SPIN HUB
112	3 SPINWHEELS
113	1 SPIN HUB
114	1 SPIN HUB
115	1 SPIN HUB
116	1 SPIN HUB
117	1 UNDERSTAND COMB ICE BIN
118	1 SPIN HUB
119	1 UNDERSTAND GLASS STORAGE
121	1 WALKER/SLAM, HIGH TEMP-EXT VENDOR
126	1 SPIN HUB
127	1 SPIN HUB
128	1 UNDERSTAND GLASS STORAGE
129	1 SPIN HUB
130	1 SPIN HUB
131	1 UNDERSTAND HARBOR
132	1 SPIN HUB
133	1 UNDERSTAND COMB ICE BIN
134	1 SPIN HUB
135	1 SPIN HUB
136	1 WALKING COUNTER (24 IN)
137	2 SPIN, PLAN, TOP MOUNTED-BY VENDOR
138	1 SPIN HUB
139	1 WALKING SERVICE COUNTER
140	1 SPIN HUB
141	1 SPIN HUB
air curtain

Dish machine

FURNITURE NOTES:
1. FURNITURE SHOWN FOR INFORMATION, QUANTITY AND APPROXIMATE LAYOUT LOCATION.
2. SPECIFICATIONS TO BE DETERMINED BY OWNER AND PROVIDED TO CONTRACTOR ON A SEPARATE SUBMITTAL.
3. FURNITURE DELIVERY TO BE SCHEDULED AND COORDINATED WITH THE OWNER BY THE GENERAL CONTRACTOR.

FOOD SERVICE PLAN REVIEW

Reviewer Andrea Reese Date 04/12/2021


Plans are in compliance subject to:

1) Compliance with applicable state and local codes.

2) Compliance with all provisos on specification worksheet.

See Comments on Specification Sheet

File# 334606

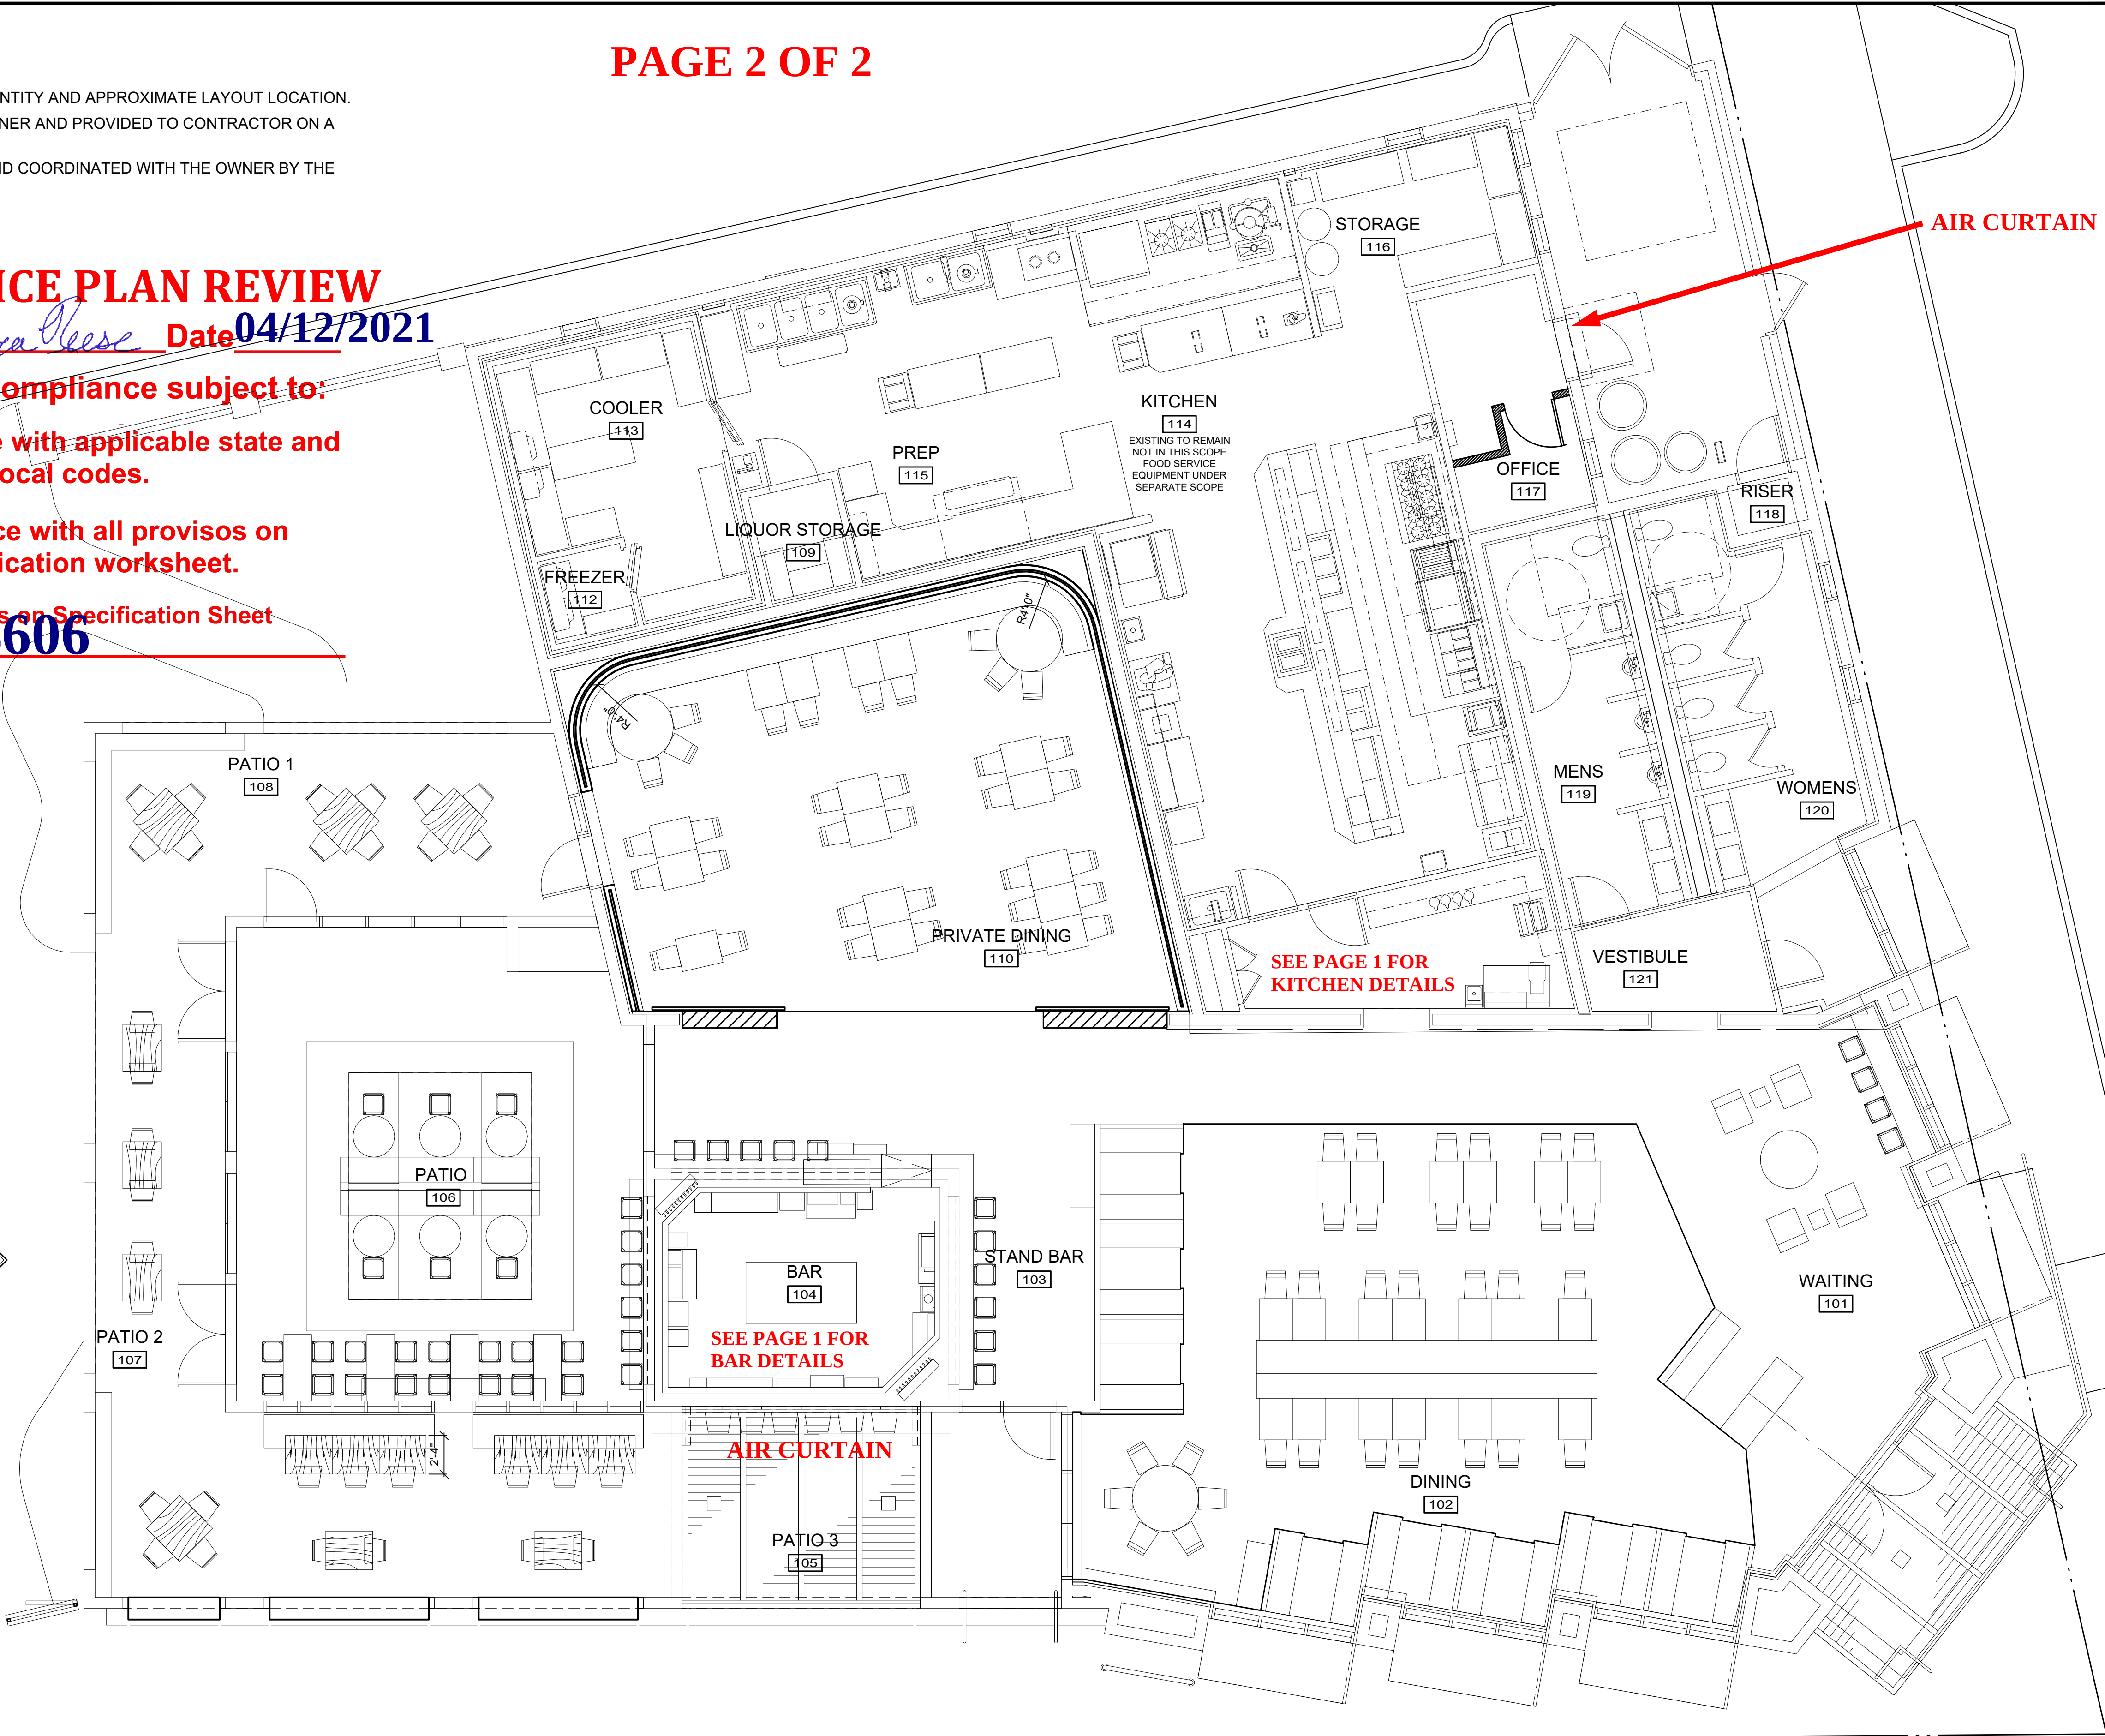

PROJECT DIRECTOR:

FORM SPACE, INC

200 FIRST STREET SUITE 205
NEPTUNE BEACH, FLORIDA 32266
design@200firststreet.com
904-535-0270 ph 904-246-8402 fax

ARCHITECT:

Julianne N. Overby, RA
Architectural and Interior Design

Julianne N. Overby, R.A.
2452 Pullian Street
Jacksonville Beach, Florida 32250
904-704-8628
Email: jno@jloverby.com
FL AR-0017060 • FL ID-4621



IGUANA ON PARK
3638 PARK STREET
JACKSONVILLE, FL 32205

PROJECT NUMBER: 20106

DATE ISSUED: MARCH 4, 2021

REVISIONS:


SHEET TITLE

FURNITURE
LAYOUT
PLAN

SHEET NUMBER

A-104

CONSTRUCTION
SET

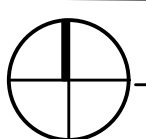

FURNITURE PLAN

SCALE: 3/16" = 1'-0"