Off-Market Opportunity

FOR SALE 0.67± Acres

Multi-Family Residential Site



West Hillhurst

2401 - 2417 5th Avenue NW | Calgary, Alberta

LOCATION HIGHLIGHTS


- Prime Location: Fronting onto Grand Trunk Park, minutes from the University of Calgary, Alberta Children's Hospital, Foothills Medical Centre, and Bow River pathways. It is bounded by Memorial Drive to the south, 19th Street NW to the west, and Crowchild Trail to the east.
- Development Potential: Rezone this half-block to Mixed-Use (MU-1F4.0H16) to match adjacent properties, ideal for high-density development.
- Jobal Site: Flat land, free of power poles, perfect for streamlined construction and development.
- » Rental Income: Six houses currently generating income while planning your development.

PROPERTY DETAILS

Address 2401 - 2417
5th Avenue NW
Site Size 0.67± Acres
Current Land Zoning R-CG
Proposed Land Zoning MU-1F4.0H16


Price \$ 5,500,000 Contact Omed Mehri




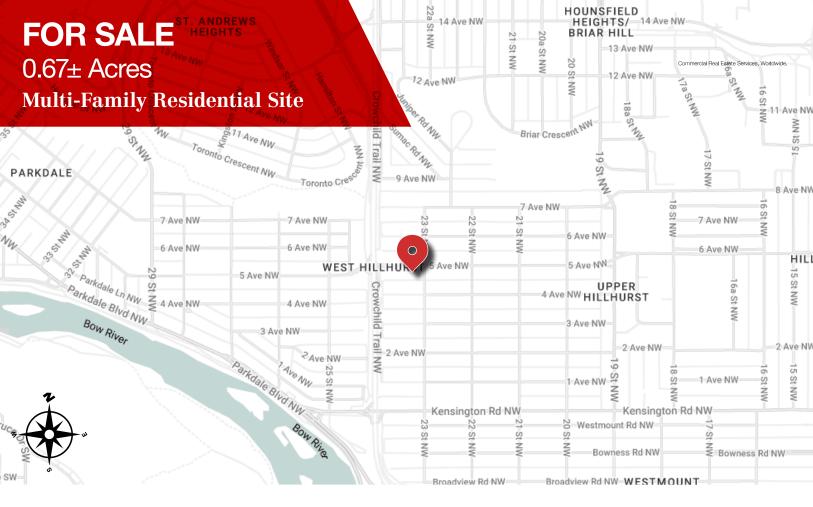



DETAILS FOR 2401 - 2417 5 Avenue NW


Address	Lot Frontage FT	Year Built	Lot Area SF	Property Tax Amount (2023)	Zoning	Possession Type
2401 5 AVE NW	50	1947	6500	\$3,699.92	R-CG	TENANT
2405 5 AVE NW	28.35	1980	3685.5	\$2,793.02	R-CG	TENANT
2407 5 AVE NW	34.28	1931	4456.4	\$2,954.03	R-CG	VACANT
2411 5 AVE NW	37.37	1911	4858.1	\$3,236.61	R-CG	TENANT
2413 5 AVE NW	25	1941	3250	\$2,257.42	R-CG	VACANT
2417 5 AVE NW	50	1911	6500	\$3,466.63	MU-1F4.0H16	VACANT
Totals	225	N/A	29250	\$18,407.63	N/A	N/A

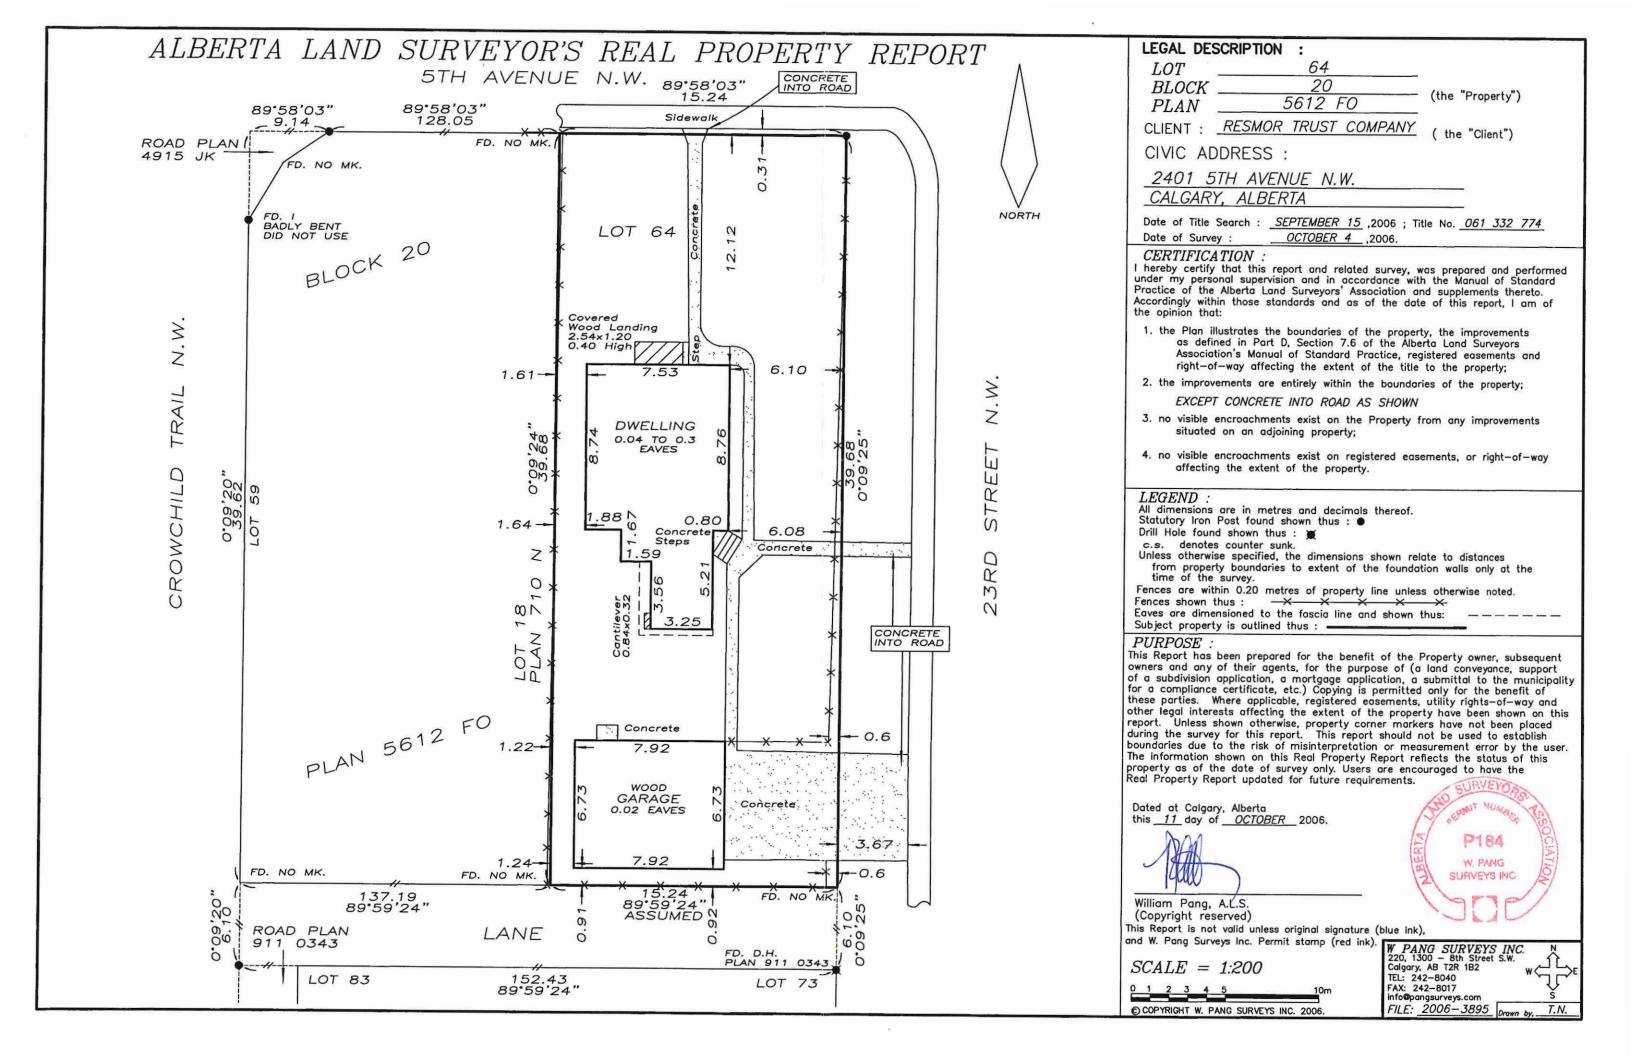


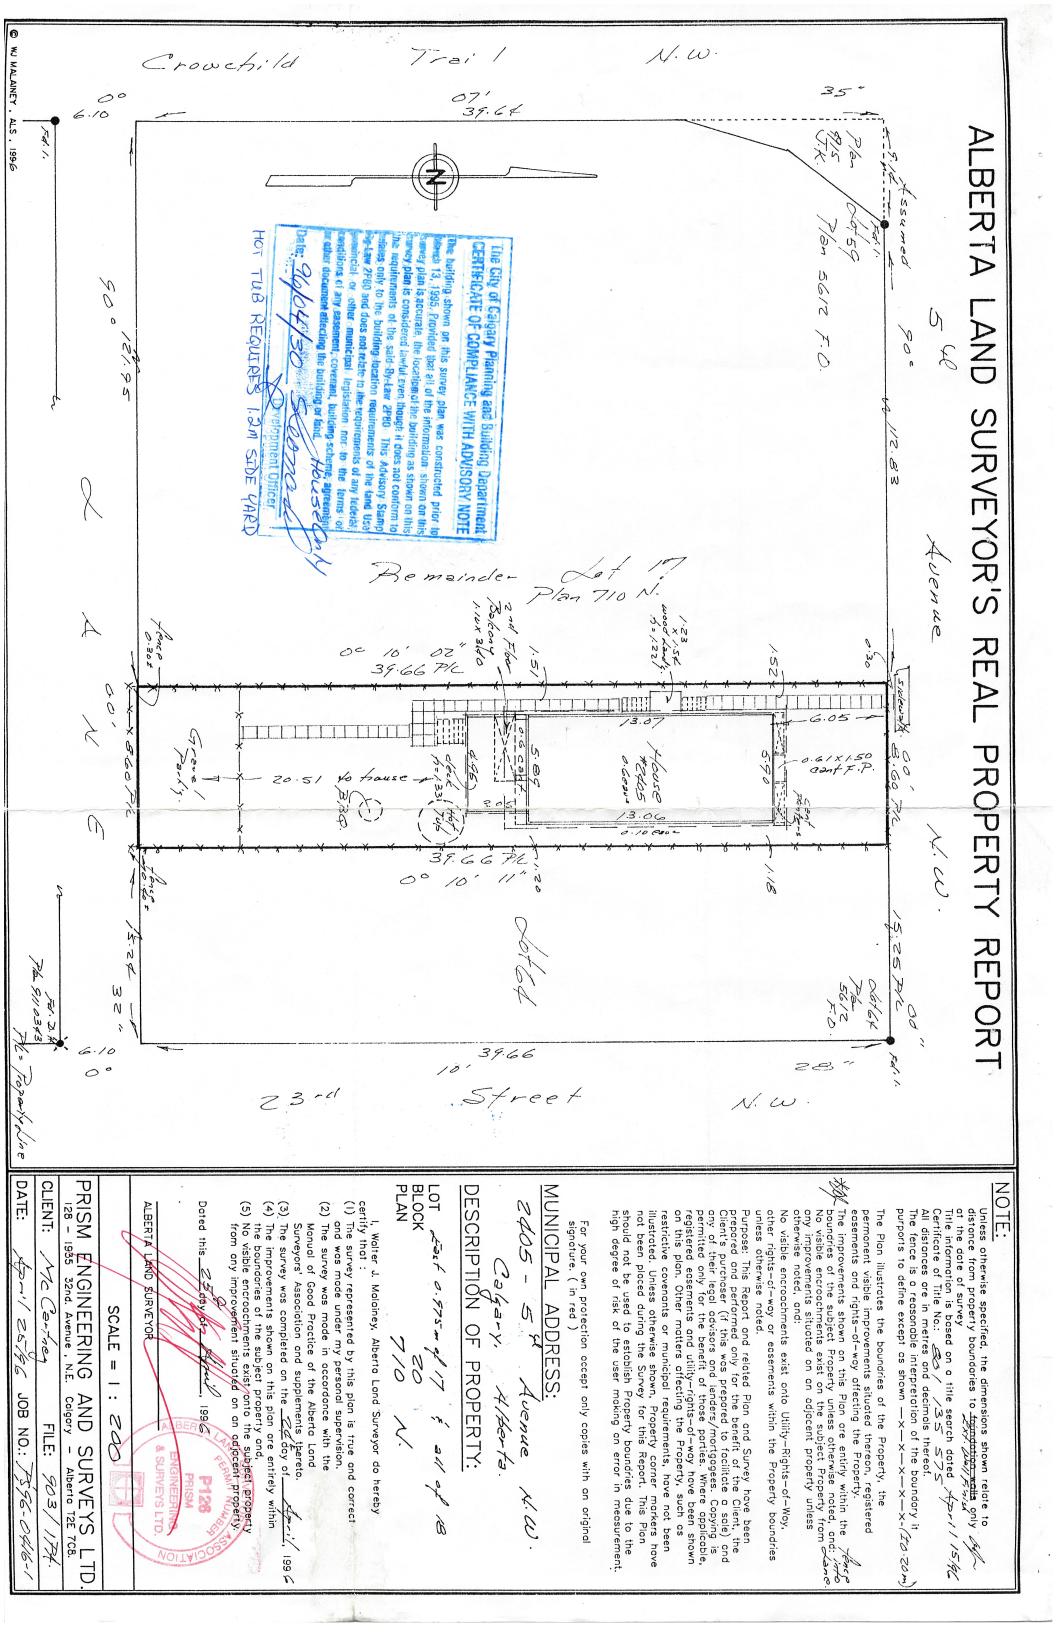

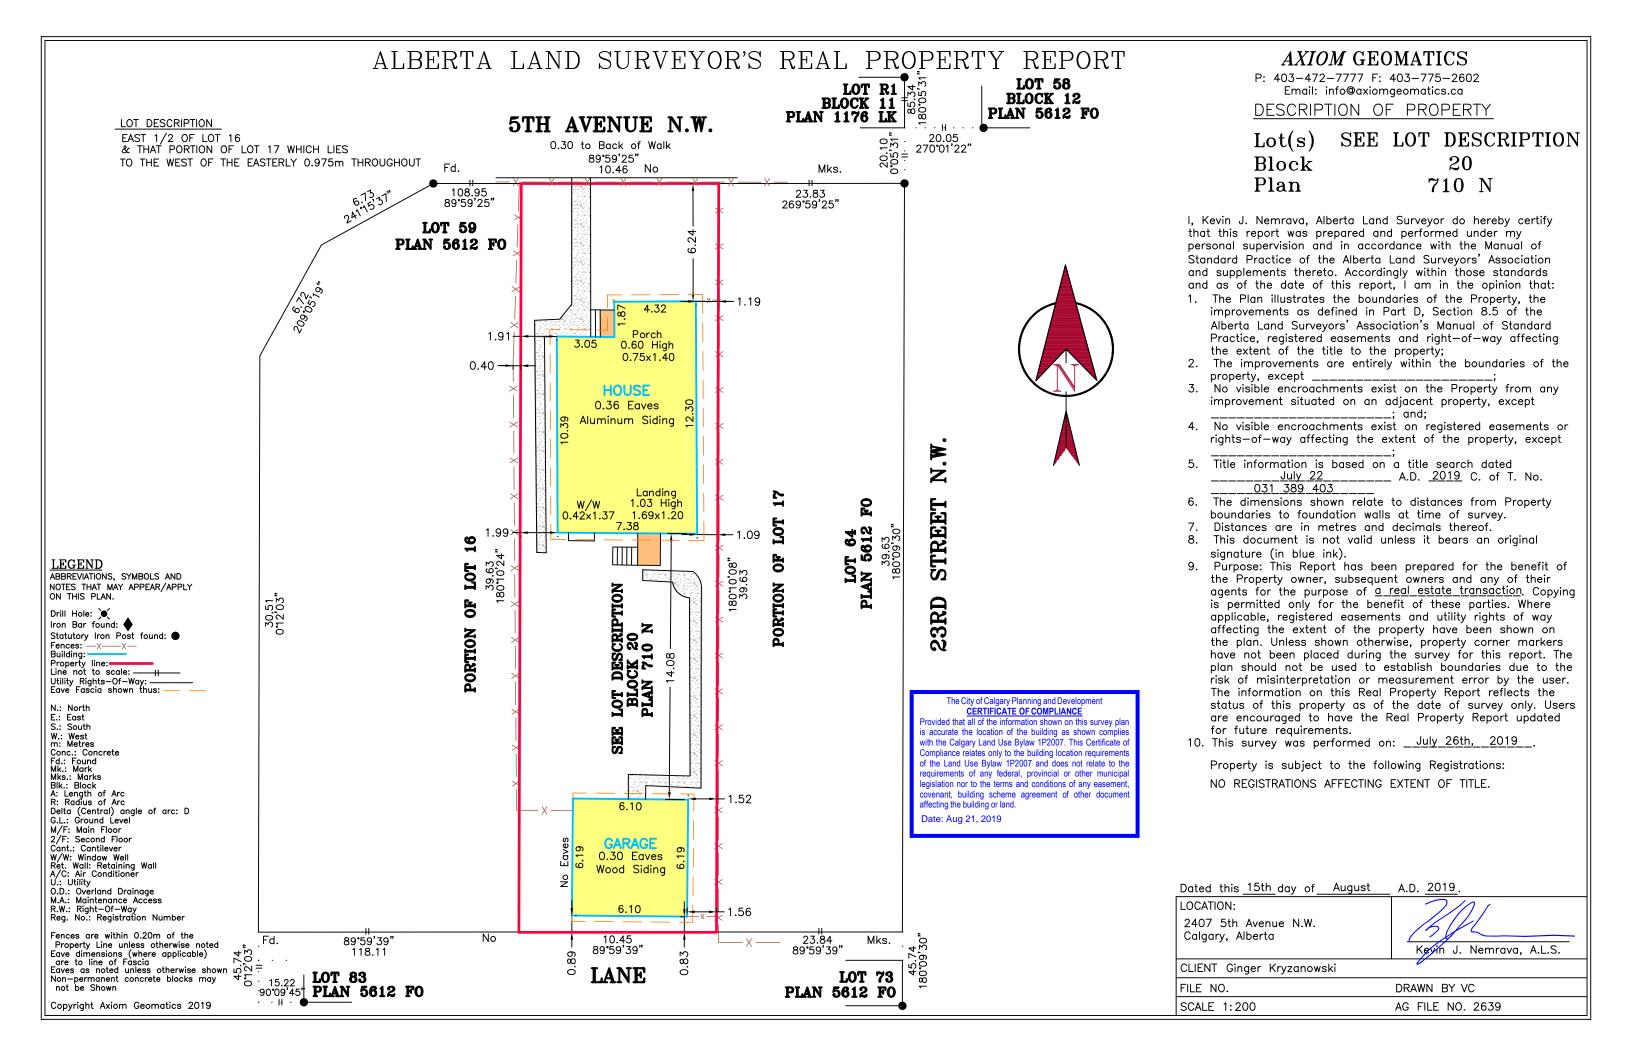

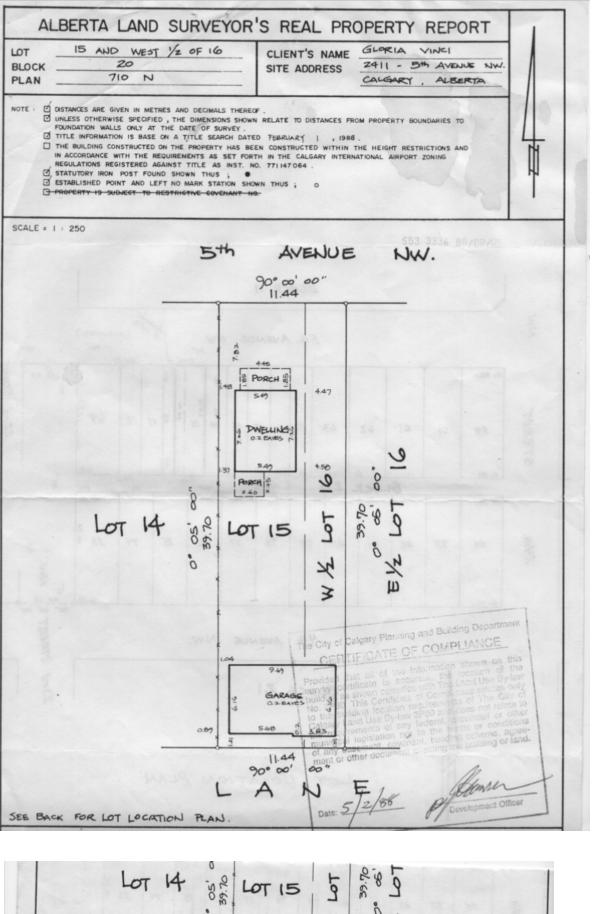

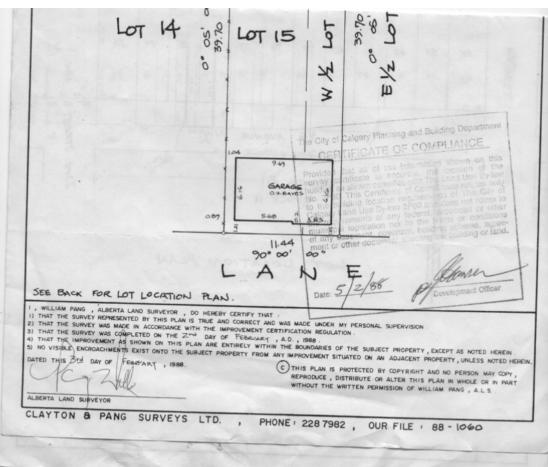

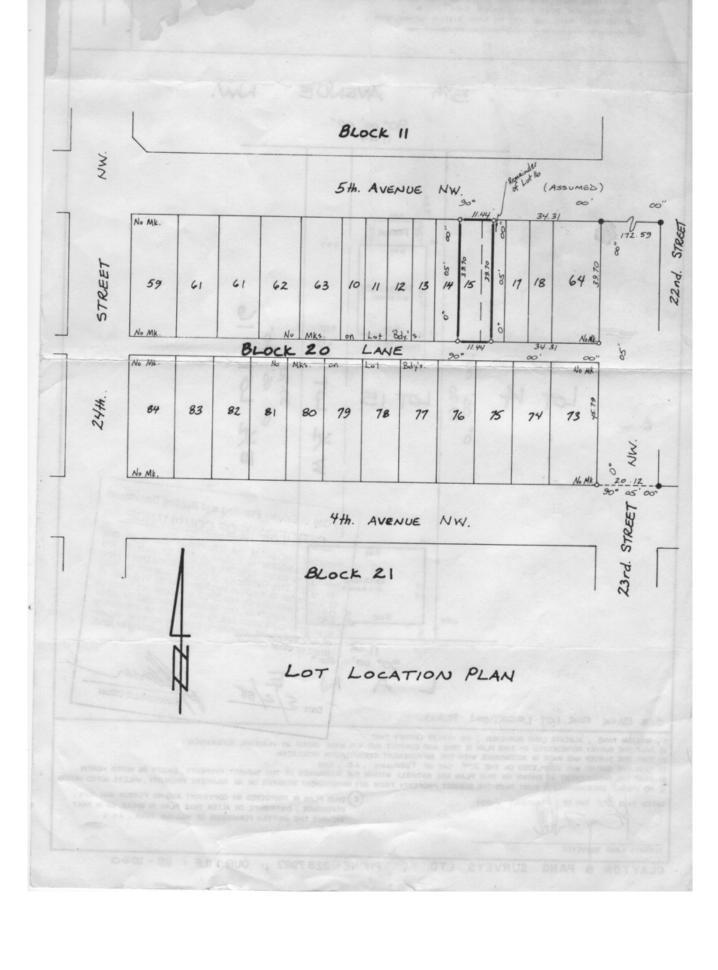

PRISM ENGINEERING & SURVEYS LTD.

0.73

termakatan titabah phemioromoromopap ay a tinangan adalah Palikan Kabada ay Songa daran dara men

128, 1935 - 32 nd Ave. N.E. Calgary, Alberta 726 708

Ph: 291 5534

BUILDING LOCATION CERTIFICATE Lot(s)Plan 710 N. Block10 20 2913 Address: N.W. Avenue This is to curtify that: The survey represented by this plan was done under my superintendence , that all dimensions are as shown and were obtained in accordance with good survey practices, that the survey was completed on the 27" day of August, 1887, that the building is is situated on totis!

14. Black 200 Flan 7/0 // in the City of Calgary is/ara antiraly within the boundaries of the said lands and there are no visible encroachments thereon by the adjacent buildings. N.W. Avenue 7.67 K The City of Calgary Planning and Building Department ADVISORY STAMP The building shown on this survey plan was constructed affor to the enectment of the Land Use By-taw 2P80 provided that all of the information shown on this survey plan is accurate, the location of the building as shown on this survey plan is considered fawfur even though it due. not conform to the requirements of the sair Gy-Law 2010 This Advisory Stamp relates only to the numbing recamrequirements of the Land Use By-Law 2080 and and not not retate to the requirements of any receral provincias of 0.76 other municipal regislation not to the ferms or conditions. of any easement, covenant, building scheme agreement or other document affecting the building or Jant John William Lot 13 Lot 15 0.78 dock 0.80 1

> PRISM ENGINEERING & SURVEYS LTD.

> > Br To

