

GID

INDUSTRIAL


211 Perimeter Center Pkwy NE, Suite 900,
Atlanta, GA 30346

BUILDING INFORMATION:

TOTAL BUILDING:	62,036 SF
SUITE AREA:	8,263 SF
WAREHOUSE AREA:	6,849 SF
OFFICE AREA:	766 SF
MIN. CLEAR HEIGHT:	18'-6"
MAX. CLEAR HEIGHT:	20'-1"
TYP. COLUMN SPACING:	35' x 30'2"
SPRINKLERED:	YES

SYMBOL LEGEND:

-  DOCK DOORS
-  DOCK DOORS W/ LEVELERS
-  DRIVE IN DOORS
-  ELECTRICAL PANELS

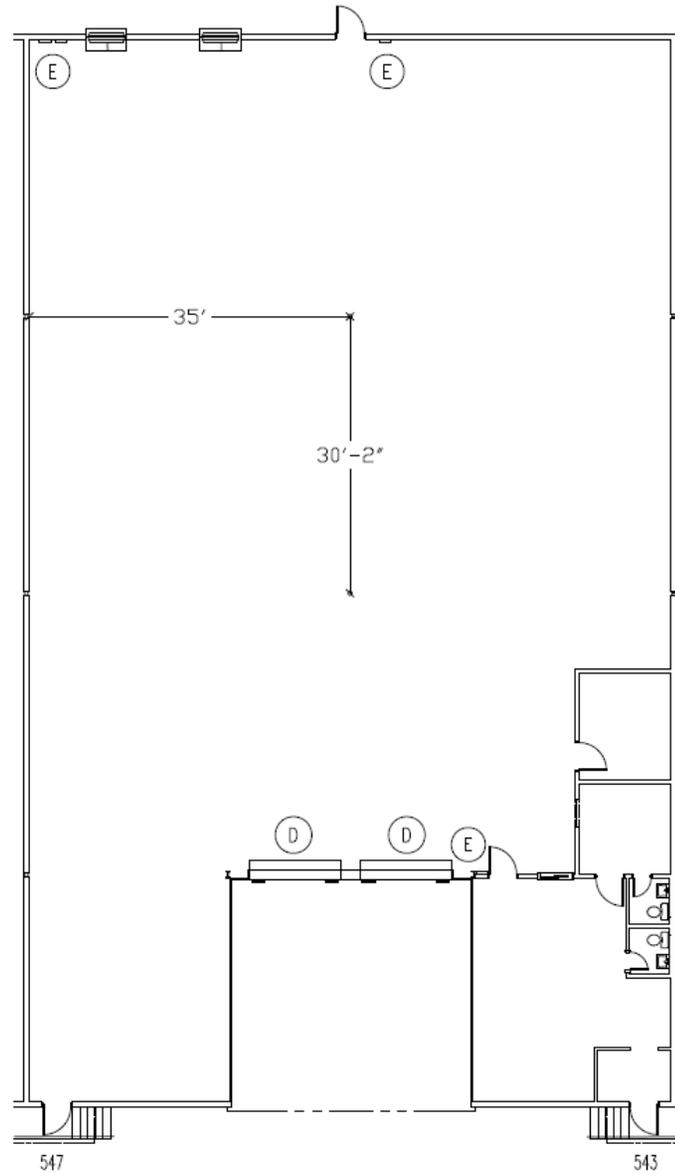


KEY PLAN



NOTE: THIS CONCEPTUAL PLAN IS FOR MARKETING PURPOSES ONLY AND HAS BEEN PREPARED BASED ON PRELIMINARY AVAILABLE SITE INFORMATION DEEMED RELIABLE. ALL DIMENSION AREA CALCULATIONS ARE SUBJECT TO VERIFICATION BY A PROFESSIONAL ENGINEER FOR COMPLIANCE WITH ALL FEDERAL, STATE, AND LOCAL REGULATIONS.

As-Built Plan

SCALE: Not to Scale

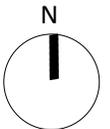

GID

Suite 547-543
523 W. Grant St., Orlando, FL 32806

CADCOM

892023019
08/11/24

GID

INDUSTRIAL


211 Perimeter Center Pkwy NE, Suite 900,
Atlanta, GA 30346

BUILDING INFORMATION:

TOTAL BUILDING:	62,036 SF
SUITE AREA:	8,263 SF
WAREHOUSE AREA:	6,849 SF
OFFICE AREA:	766 SF
MIN. CLEAR HEIGHT:	18'-6"
MAX. CLEAR HEIGHT:	20'-1"
TYP. COLUMN SPACING:	35' x 30'2"
SPRINKLERED:	YES

SYMBOL LEGEND:

-  DOCK DOORS
-  DOCK DOORS W/ LEVELERS
-  DRIVE IN DOORS
-  ELECTRICAL PANELS

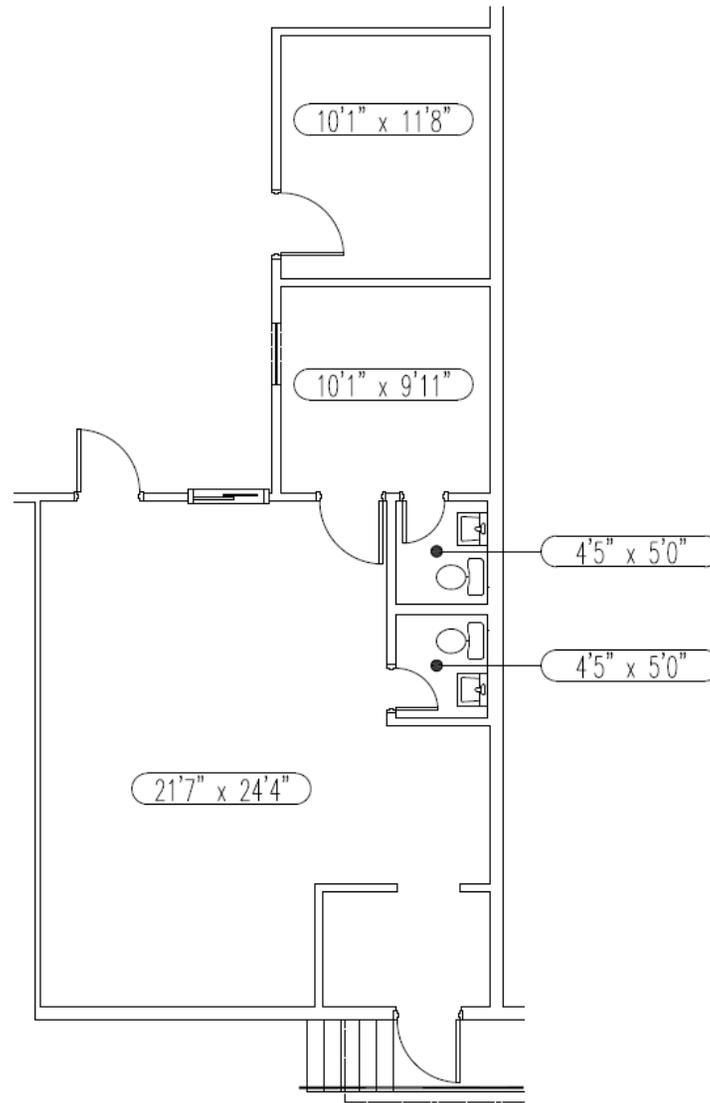


KEY PLAN



As-Built Plan

SCALE: Not to Scale

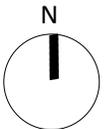

NOTE: THIS CONCEPTUAL PLAN IS FOR MARKETING PURPOSES ONLY AND HAS BEEN PREPARED BASED ON PRELIMINARY AVAILABLE SITE INFORMATION DEEMED RELIABLE. ALL DIMENSION AREA CALCULATIONS ARE SUBJECT TO VERIFICATION BY A PROFESSIONAL ENGINEER FOR COMPLIANCE WITH ALL FEDERAL, STATE, AND LOCAL REGULATIONS.

GID

Suite 547-543_Office
523 W. Grant St., Orlando, FL 32806

CADCOM

892023019
08/11/24