



**EXHIBIT A**  
**FLOOR PLAN OF PREMISES**

01 SK SUITE C250  
04/28/2021

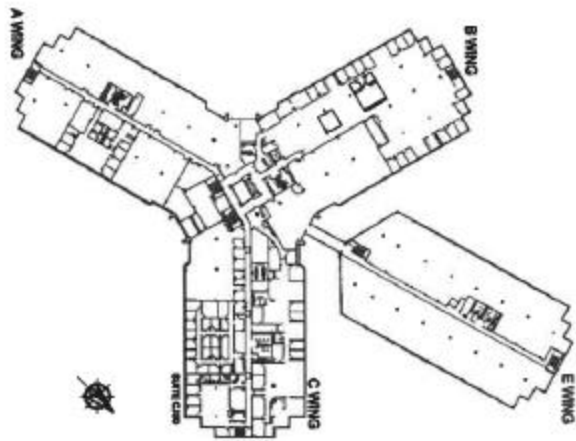

RECORD PLAN

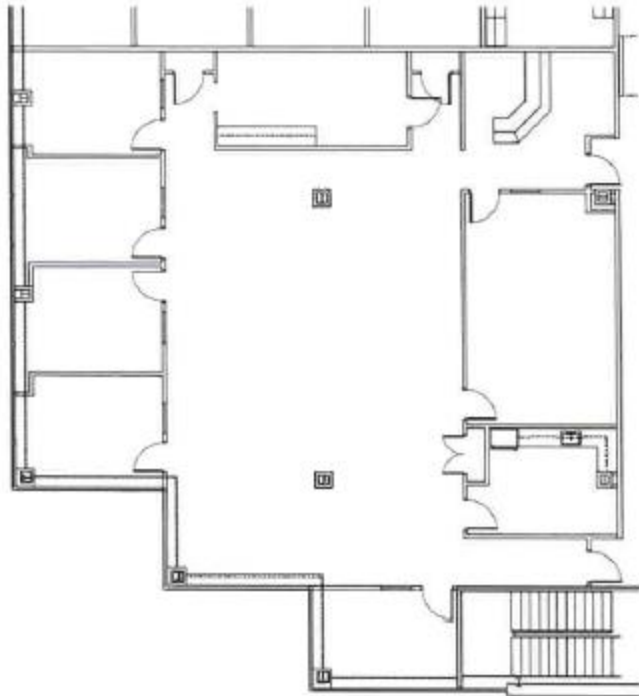

WESTVIEW CORPORATE CENTER  
5750 Corporate Drive  
Frederick, MD