

Bldg-Alter/Repair
Commercial
Plan Check


City of Los Angeles - Department of Building and Safety

Plan Check #: B20LA01341
Initiating Office: METRO
Printed on: 01/24/20 11:31:47

PLOT PLAN ATTACHMENT

98080403026201901

(DO NOT DRAW, WRITE, OR PASTE ATTACHMENTS OUTSIDE BORDER)

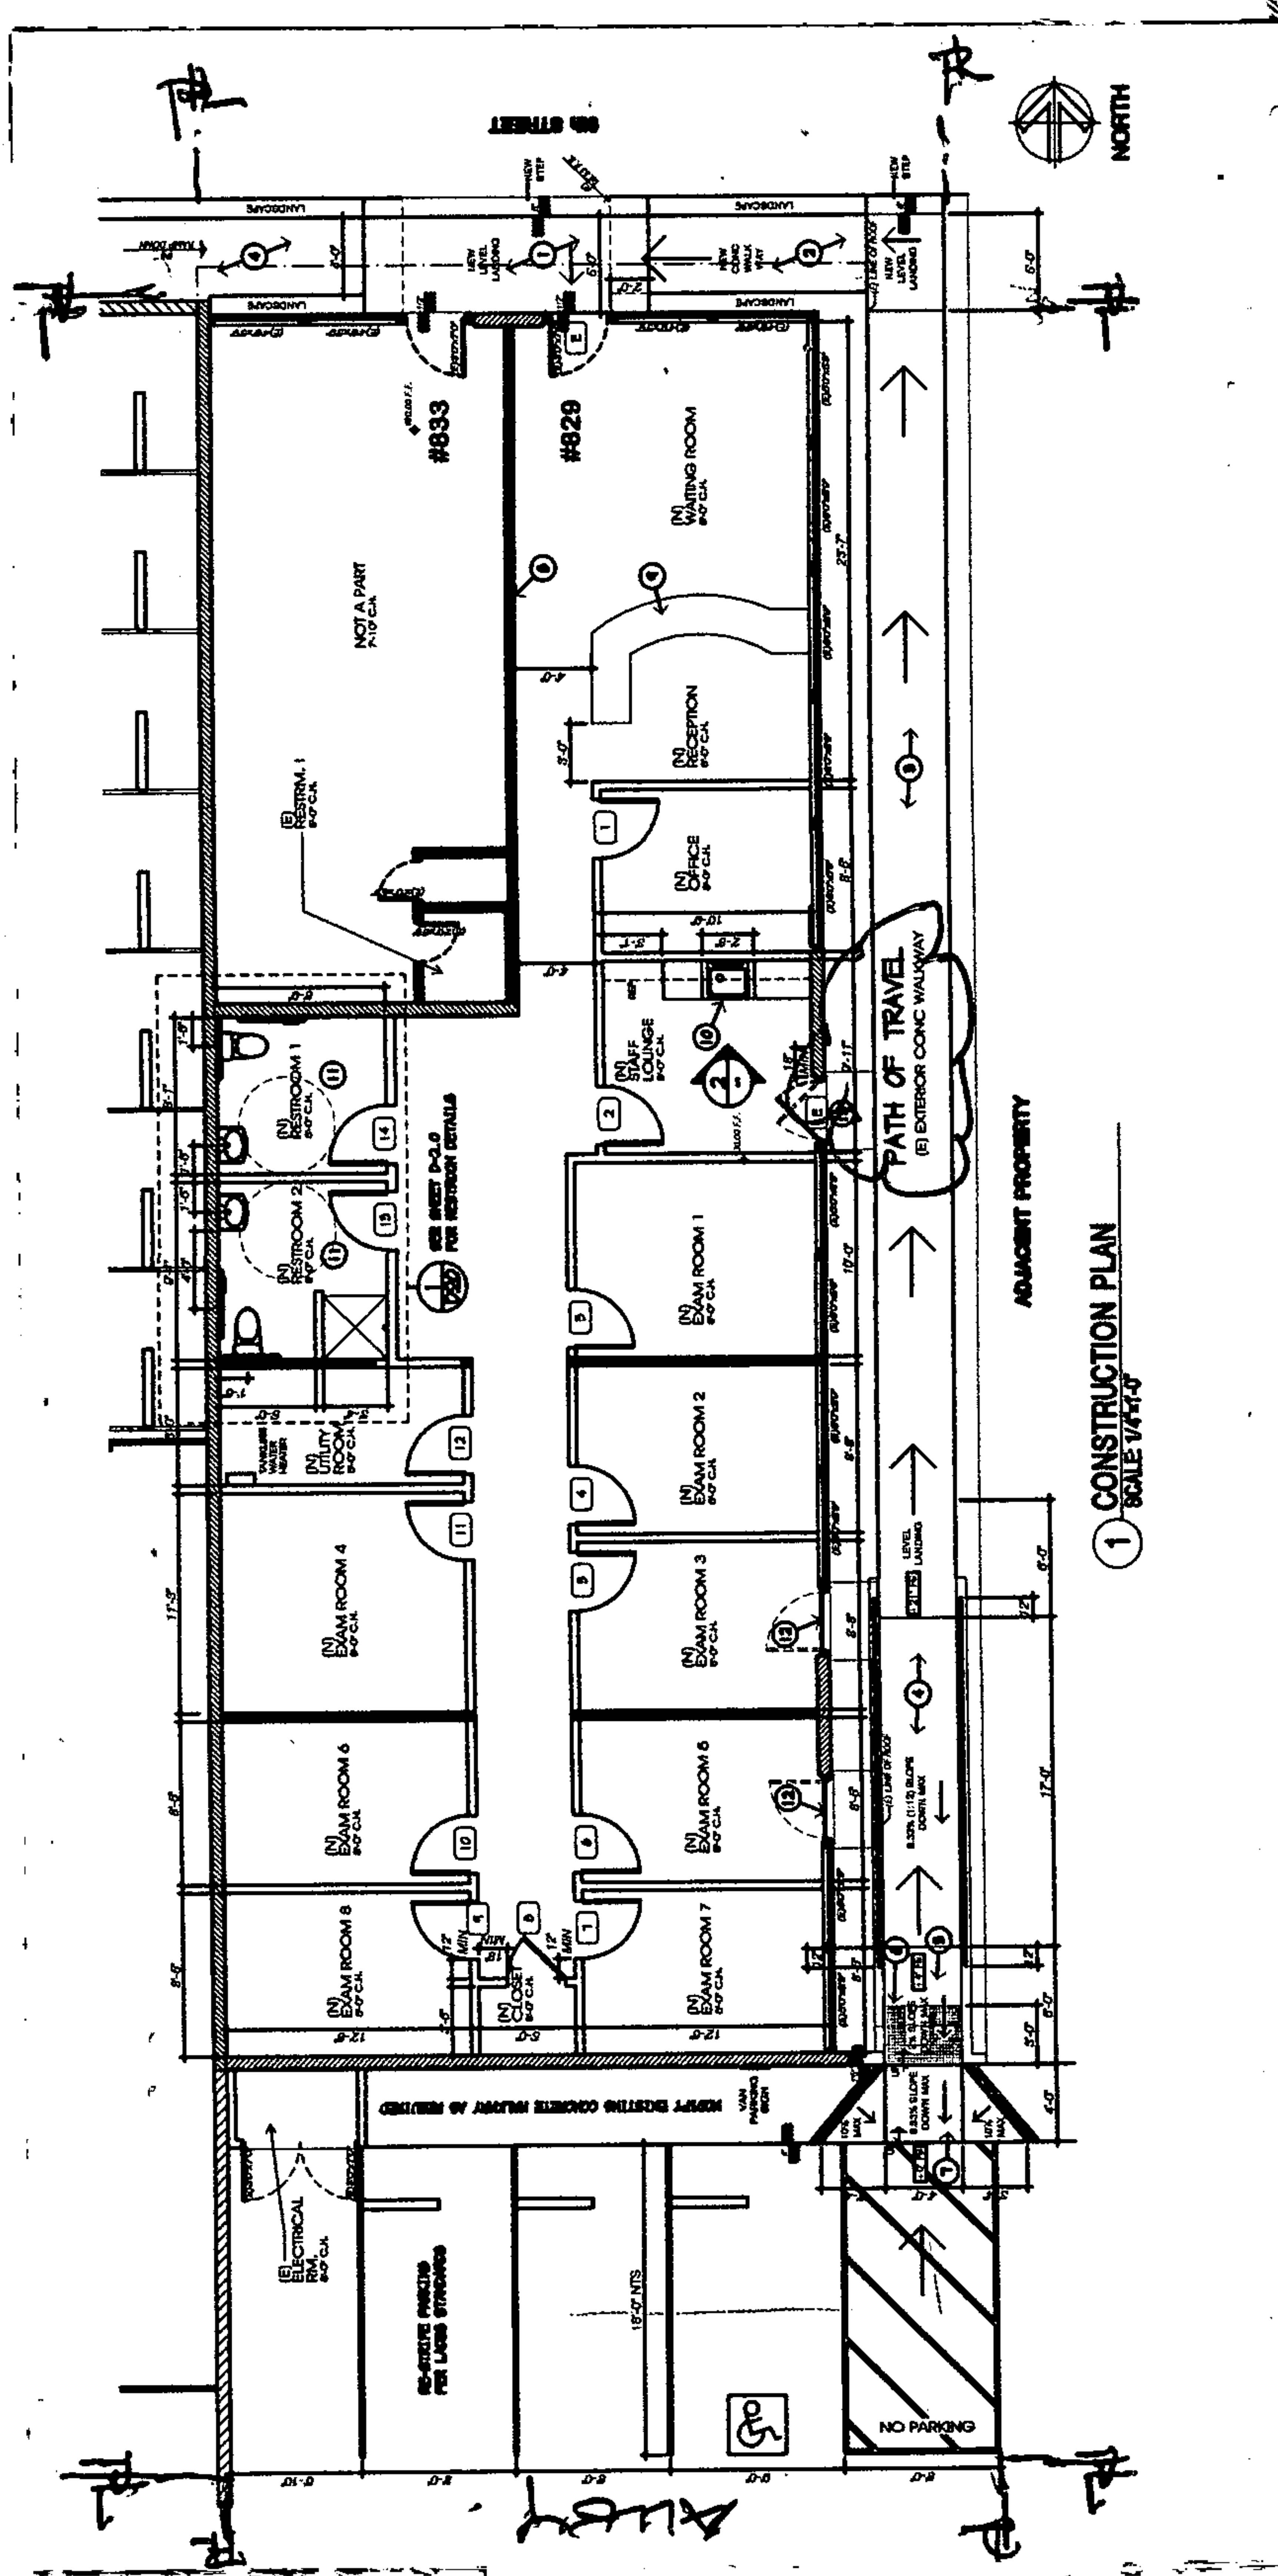

1 CONSTRUCTION PLAN
SCALE 1/4"=1'-0"

READY TO ISSUE
BY JASON ANGADA
JAN 30 2020
Signature