


UNIT 1


UNIT 2

UNIT 3

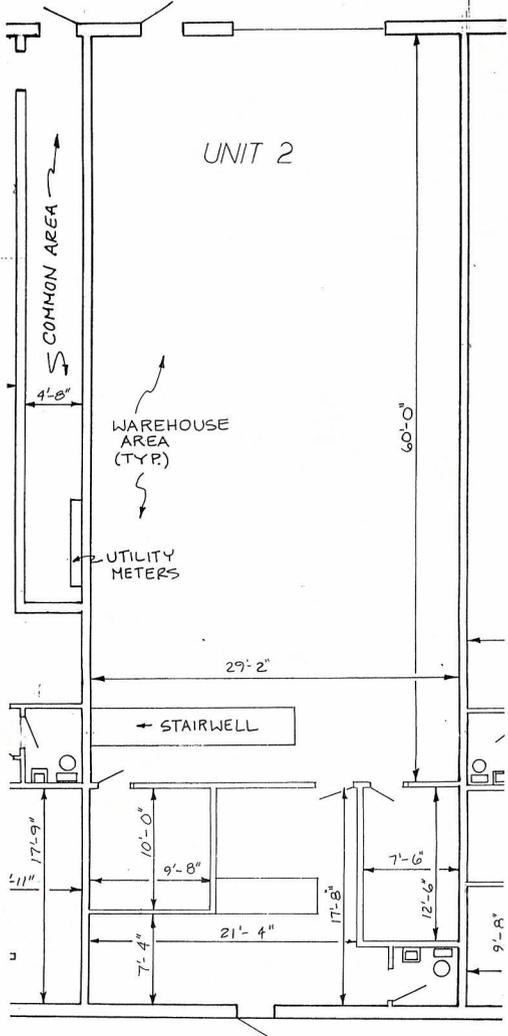

PREPARED BY  
 MICHAEL J. KOSKA & ASSOC.  
 P.O. BOX 30087  
 ACUSHNET, MA 02743

AS-BUILT UNIT DEED PLAN  
 FOR  
 D&P CONDOMINIUM ASSOCIATION  
 BEDFORD PARK IN;  
 BRIDGEWATER, PLYMOUTH CO MA  
 OWNED BY  
 D&P CONDOMINIUM ASSOCIATION  
 P.O. BOX 725  
 BRIDGEWATER, MA

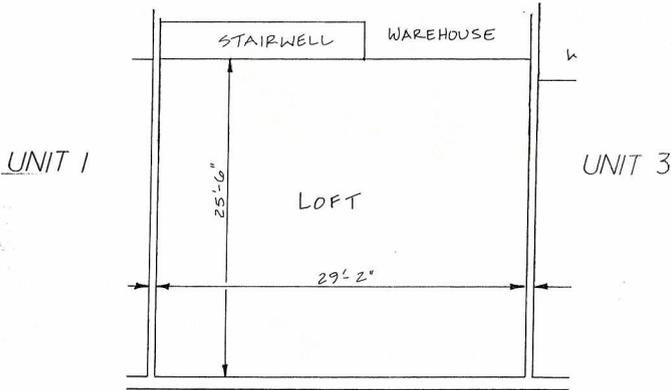


LOFT PLAN  
SCALE: 1/4" = 1'-0"

CERTIFICATIONS:  
I HEREBY STATE THAT THIS AS-BUILT SURVEY WAS MADE ON THE GROUND FOR THE PURPOSE OF CONDOMINIUM DOCUMENTS IN MASSACHUSETTS BETWEEN THE DATES OF 12-27-92 AND 1-23-93.

I CERTIFY THAT THIS PLAN SHOWS UNIT BEING CONVEYED WITH ITS IMMEDIATE ADJOINING UNITS AND THAT IT FULLY AND ACCURATELY DEPICTS THE LAYOUT OF THE UNIT, ITS DIMENSIONS, LOCATION APPROXIMATE AREA, MAIN ENTRANCE AND IMMEDIATE COMMON AREAS TO WHICH IT HAS ACCESS, AS BUILT.



*Michael J. Koska*  
10/22/93

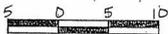

AS-BUILT UNIT DEED PLAN  
FOR

D&P CONDOMINIUM ASSOCIATION  
BEDFORD PARK IN;  
BRIDGEWATER, PLYMOUTH CO MA  
OWNED BY  
D&P CONDOMINIUM ASSOCIATION  
P.O. BOX 725  
BRIDGEWATER, MA

PREPARED BY  
MICHAEL J. KOSKA & ASSOC.  
P.O. BOX 30087  
ACUSHNET, MA 02743