


SECOND FLOOR PLAN



FIRST FLOOR PLAN

AS-BUILT FLOOR PLANS

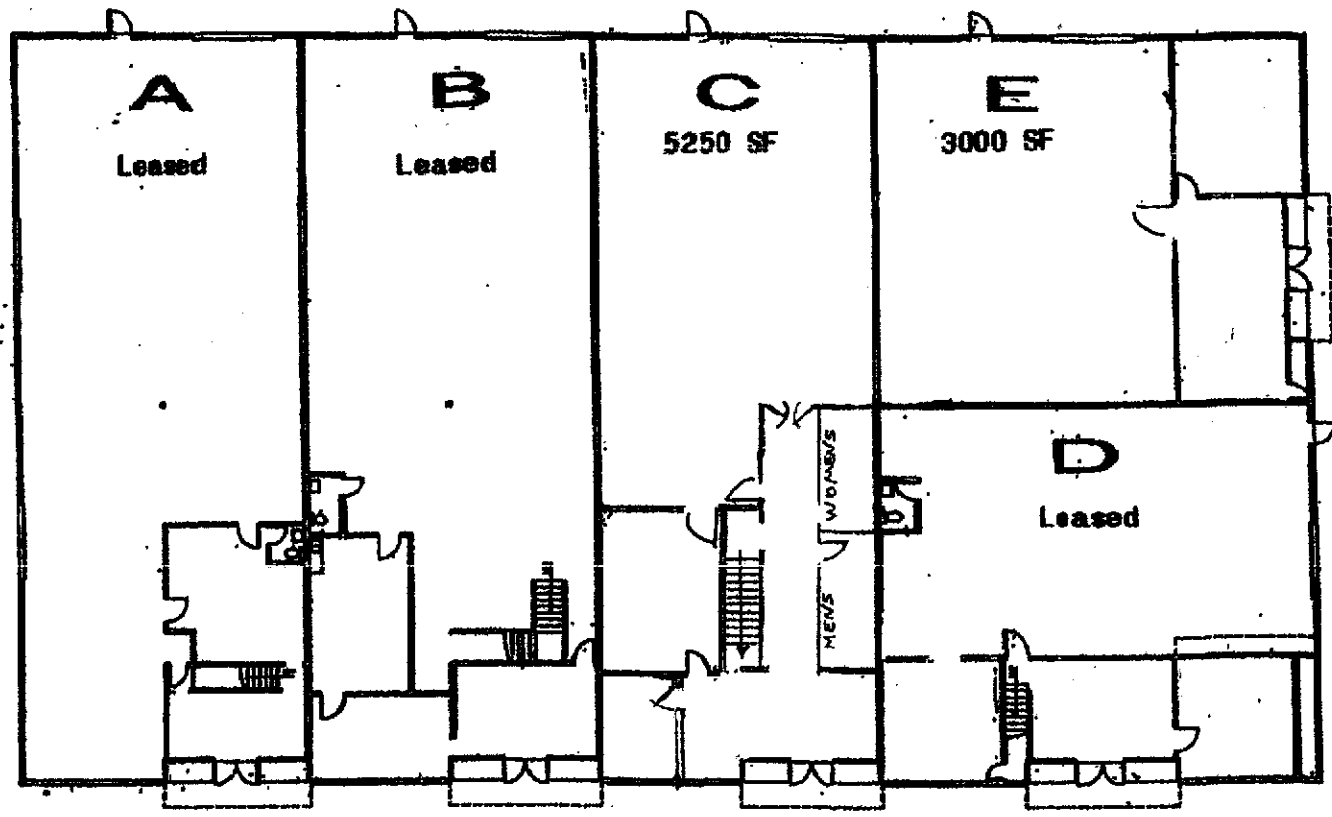

Ocean Ridge Properties
 Lytt Wagner 650-367-8862

149 GROBRIC CT.
 FAIRFIELD CA 94534