


KEY
BOD = BOTTOM OF DECK
BOC = BOTTOM OF CEILING
BOJ = BOTTOM OF JOIST
BOB = BOTTOM OF BEAM

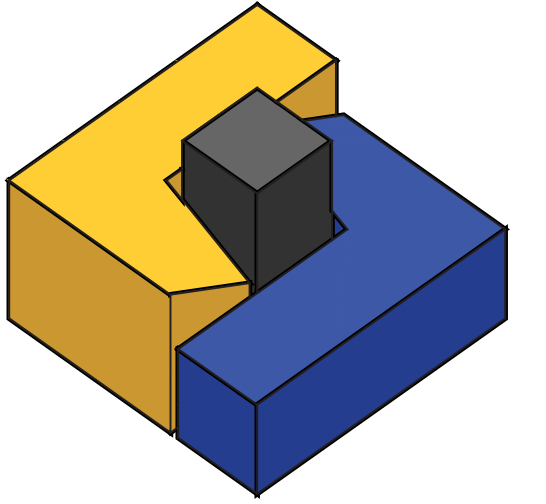


**SURE
MEASURE**
SURE START. SURE END.


SURE MEASURE, LLC
244 Fifth Avenue, Suite N285
New York, NY 10001
646.937.9974
info@suremeasure.com

Building Documentation Specialists
Architectural as-built Documentation
2D CAD Drawings, 3D BIM Models
3D Laser Scanning, Point Cloud Model
Virtual Reality Walkthrough Tours

NOTE: THIS DRAWING IS PROVIDED FOR INFORMATIONAL PURPOSES ONLY. ALL DRAWINGS ARE PROVIDED TO OUR CLIENTS BASED UPON INFORMATION TAKEN AT EXISTING BUILDING AND DRAWN IN ACCORDANCE WITH COMMON BUILDING PRACTICES. ALL DIMENSIONS AND SPECIFICATIONS SHOULD BE VERIFIED BY CLIENT AND/OR CONTRACTOR. IF DIMENSIONS AND SPECIFICATIONS ARE NOT VERIFIED BY CLIENT AND/OR CONTRACTOR SURE MEASURE WILL BE HELD HARMLESS. SURE MEASURE ASSUMES NO LIABILITY FOR CHANGES AND/OR REVISIONS MADE TO PLANS BY CLIENT AND/OR CONTRACTOR.

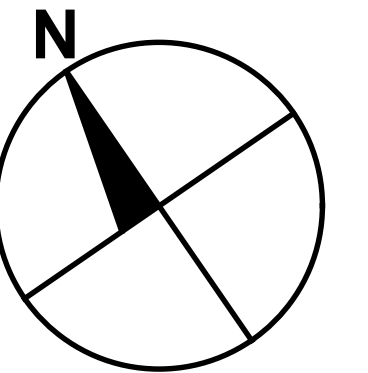

B FIRST FLOOR

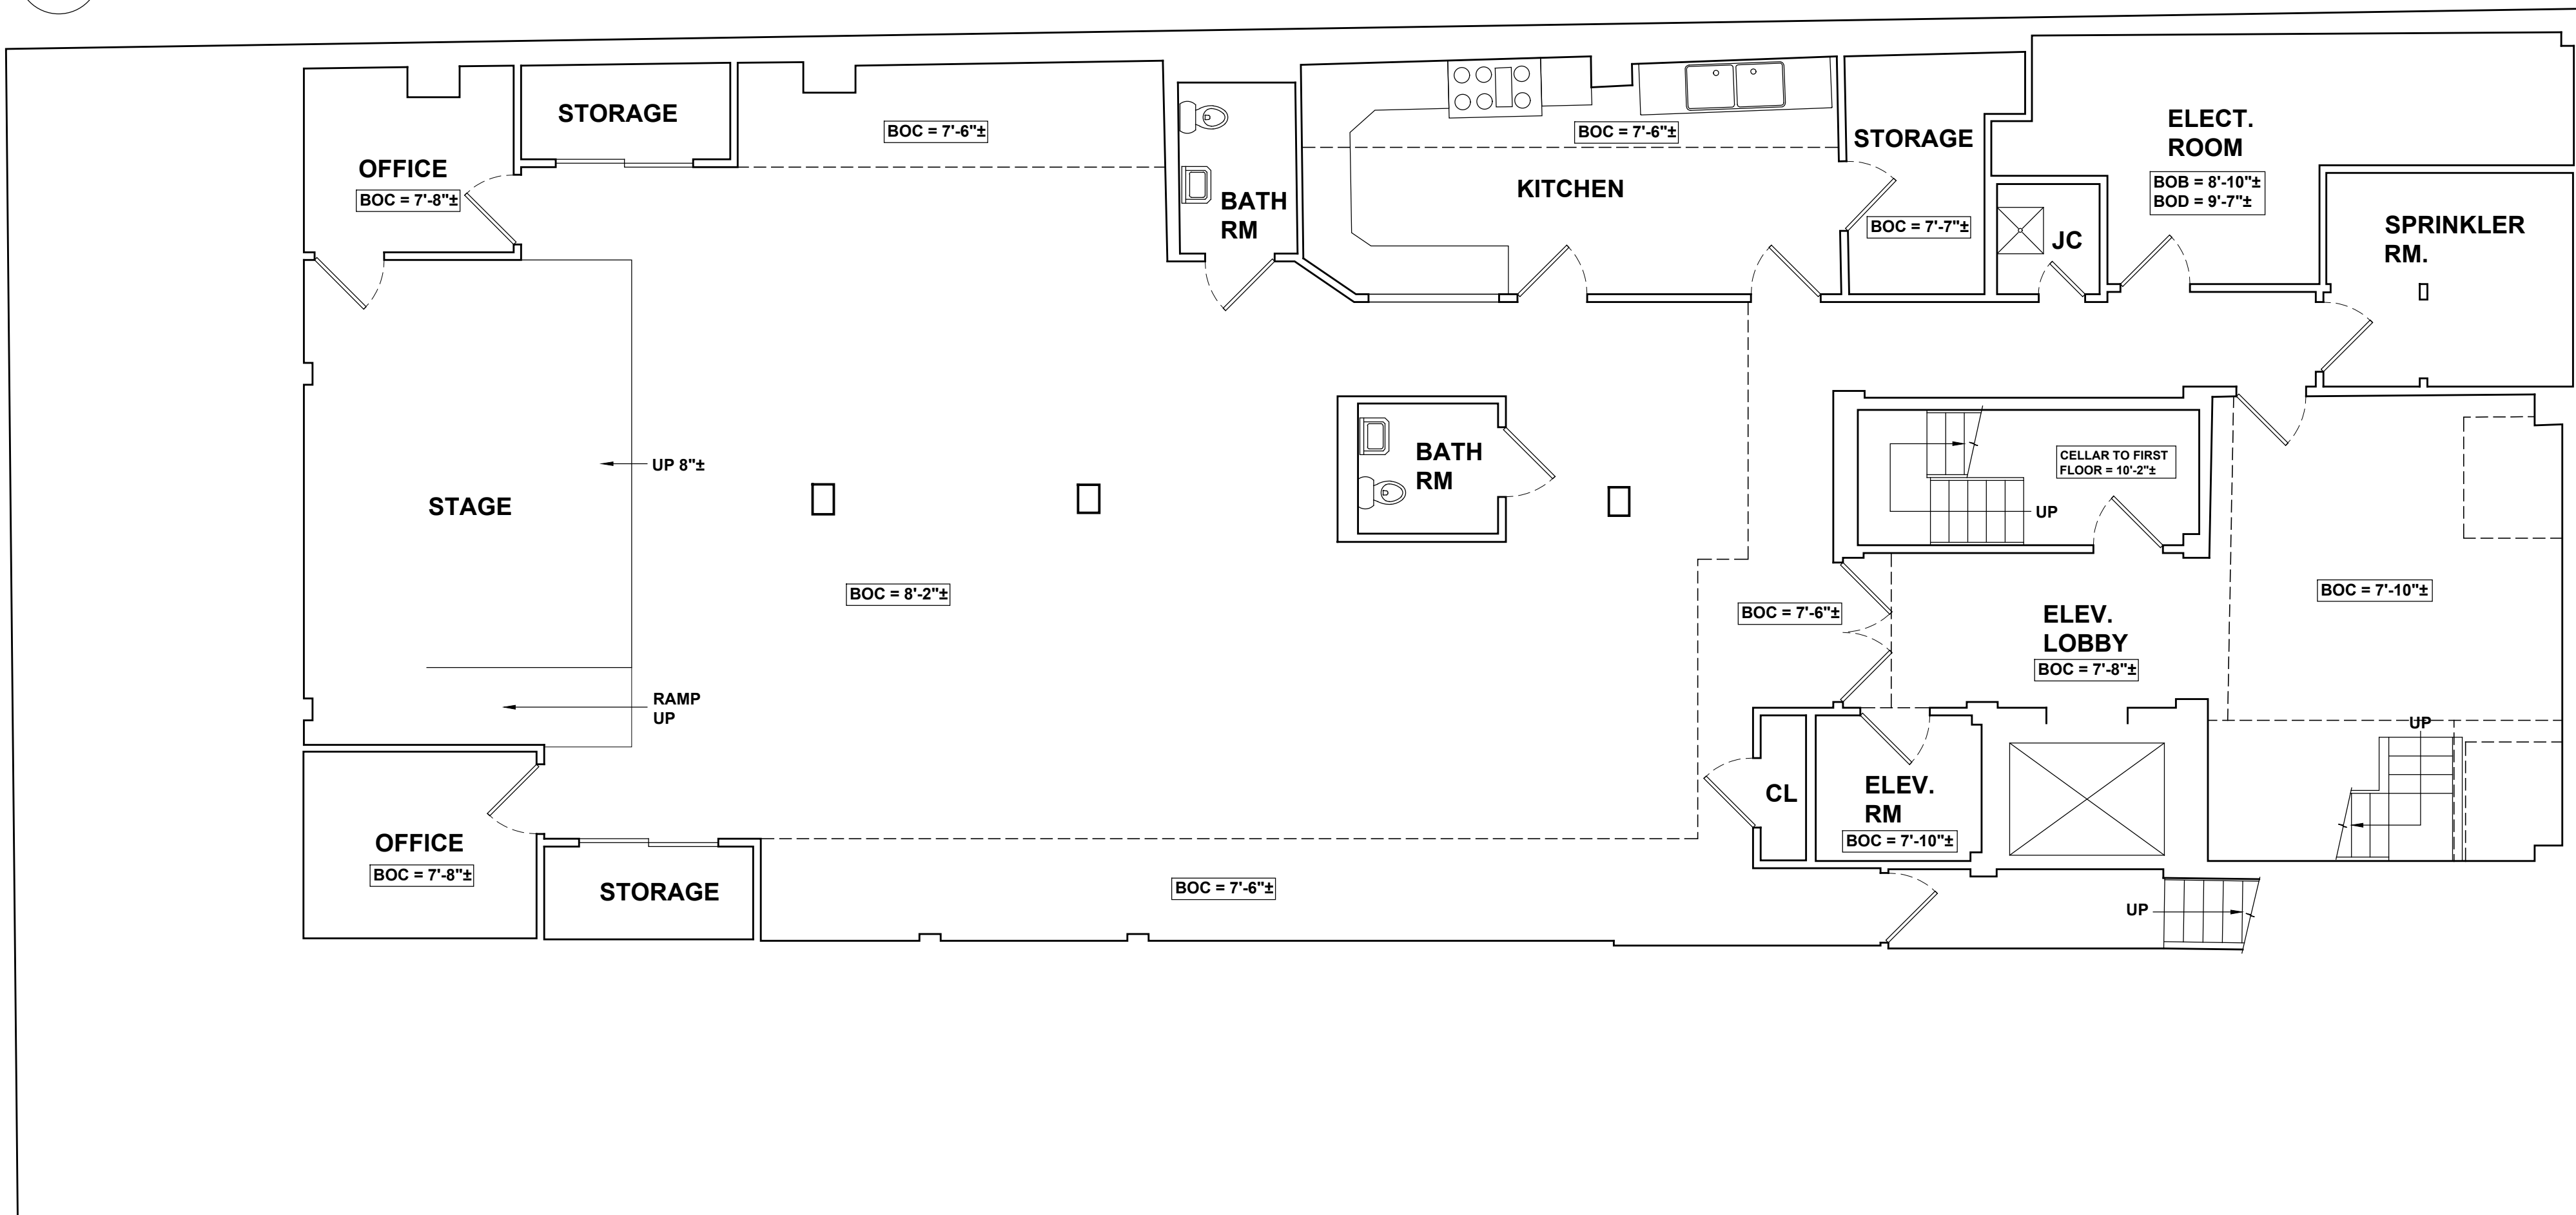

A CELLAR

PROJECT:

**COMMERCIAL
BUILDING**

8710 5TH AVENUE
BROOKLYN, NY

DRAWING TITLE:
EXISTING FLOOR PLANS


ISSUE DATE:
04/13/2022

SURVEY TEAM:
N.B./C.B.


SCALE:
3/16" = 1'-0"




EX-1

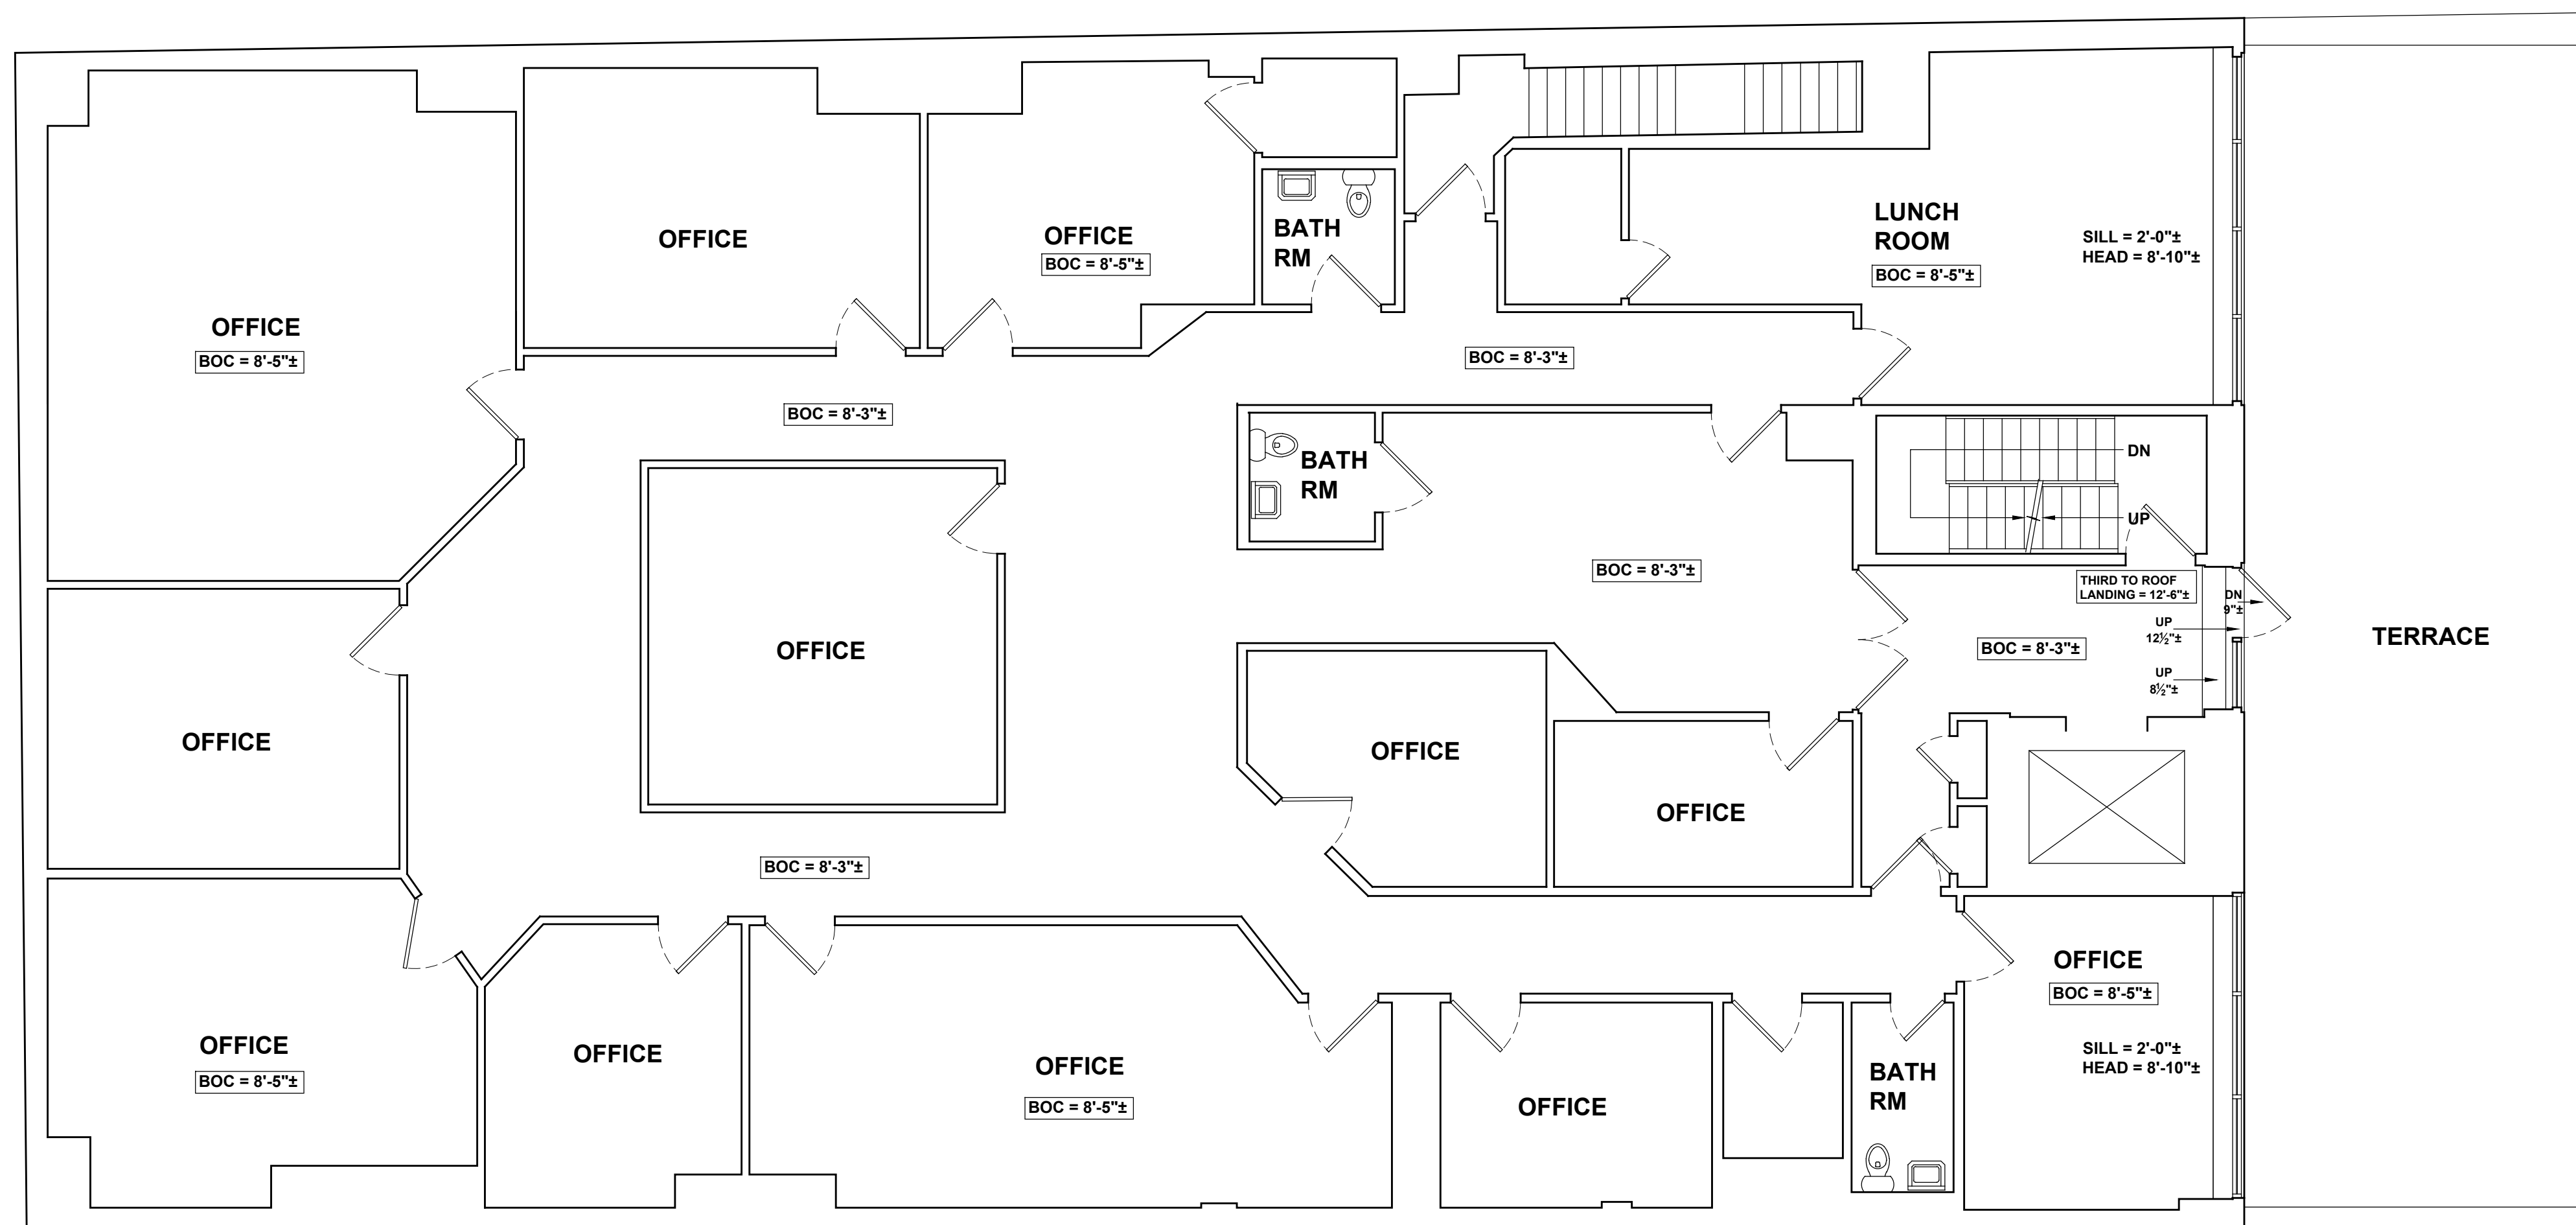

THIRD FLOOR

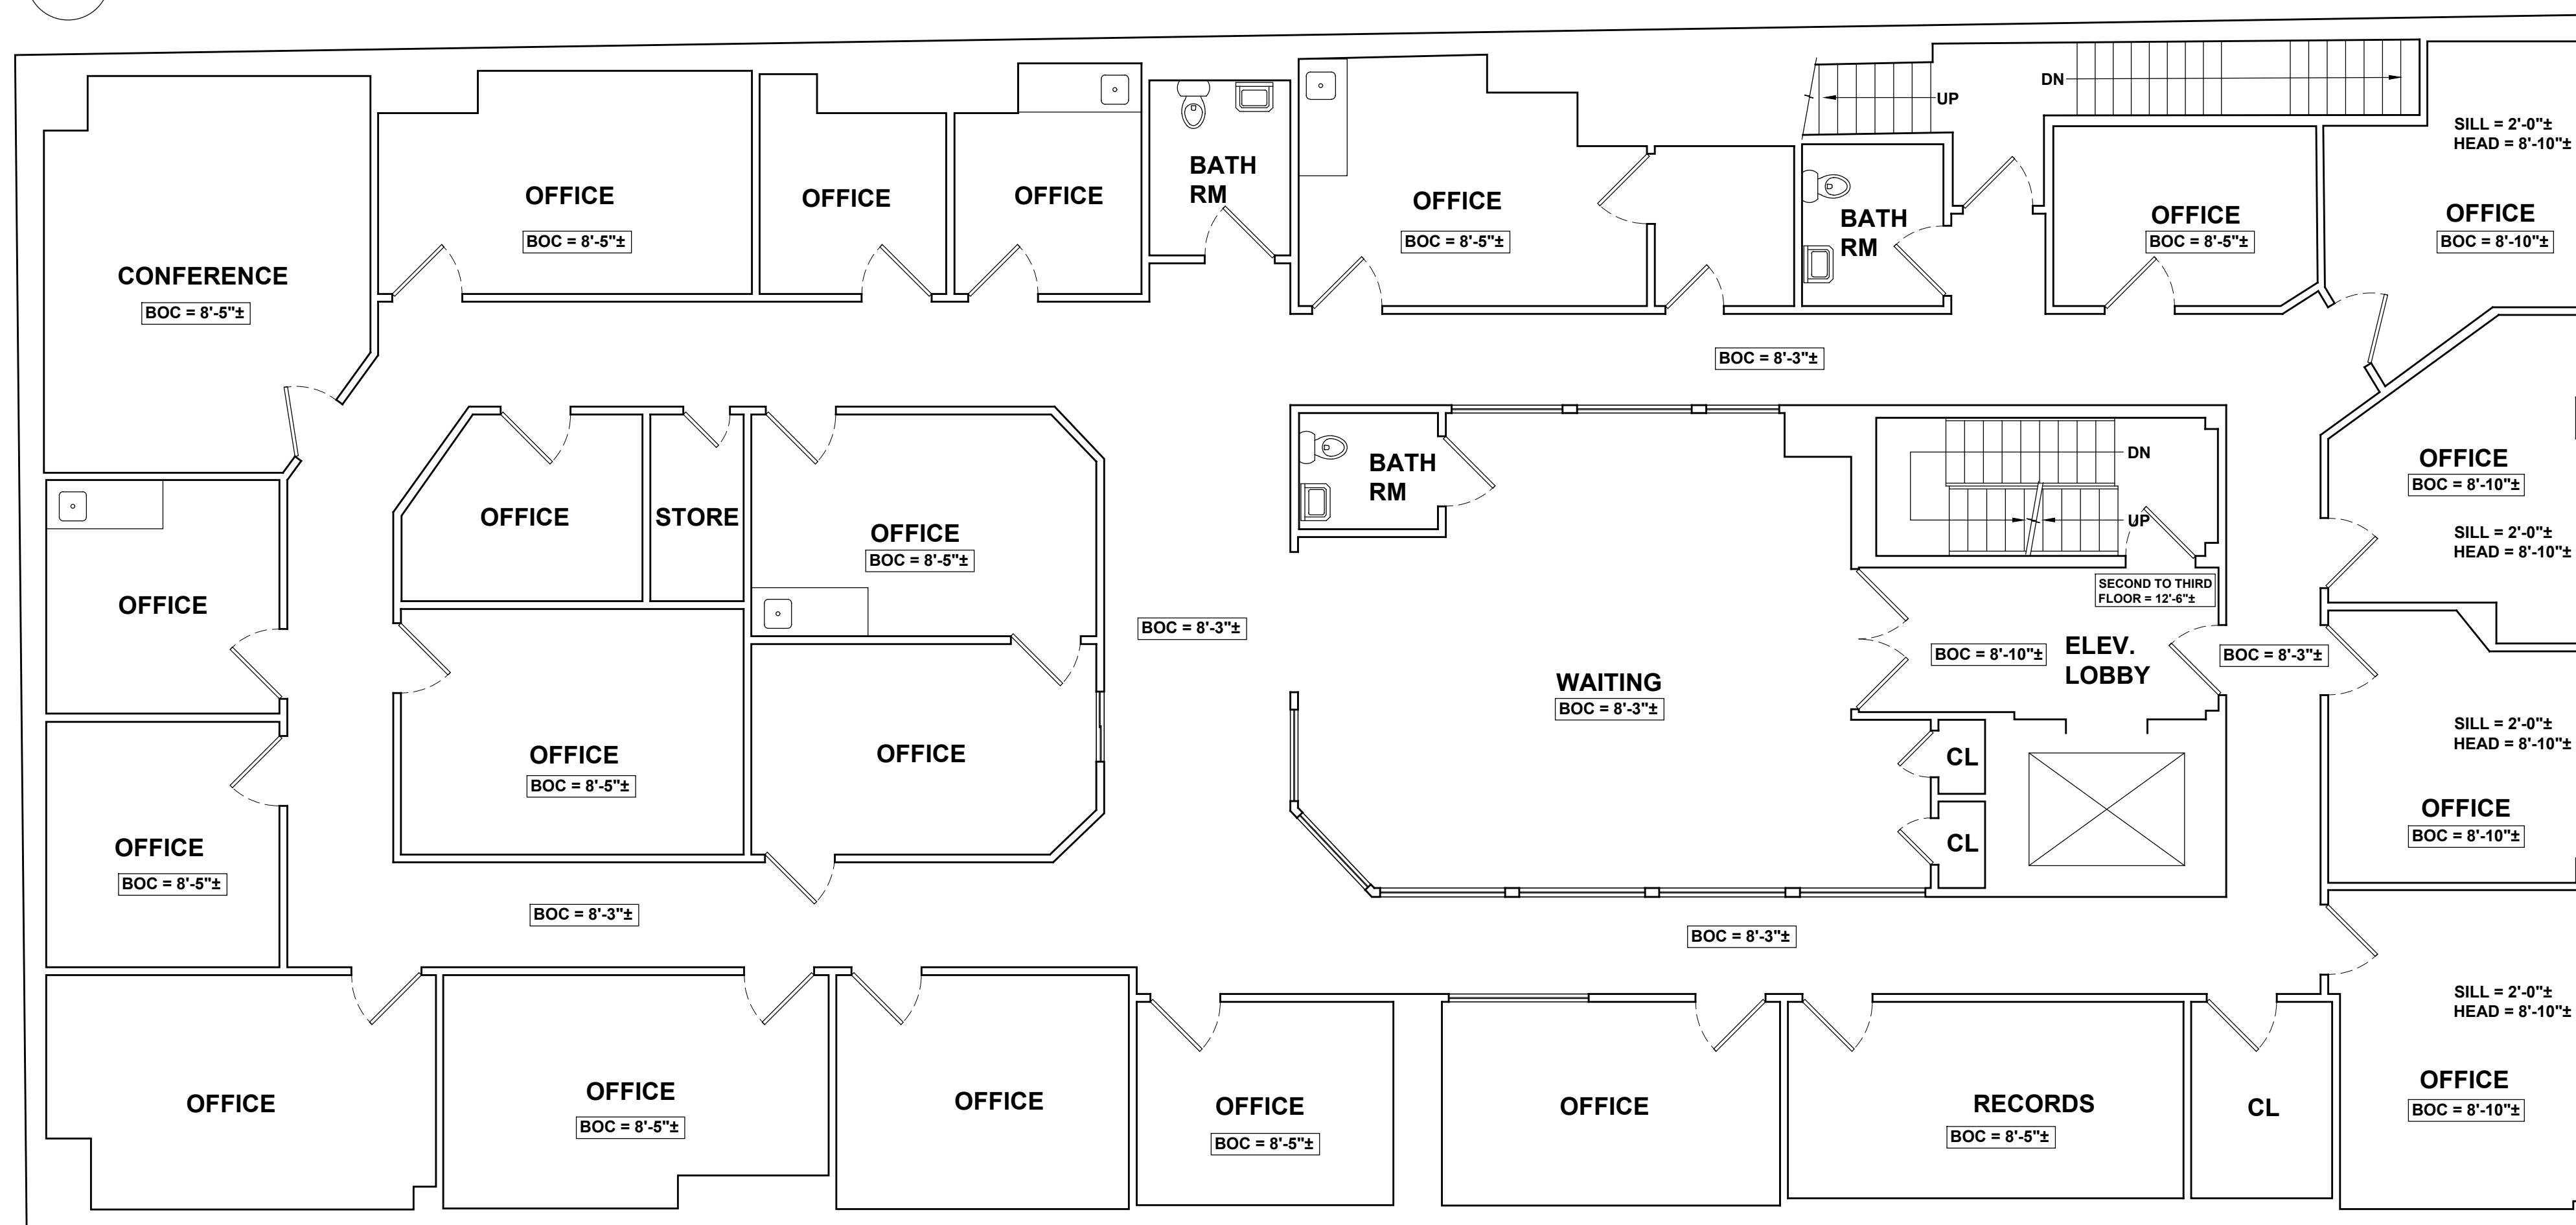


SECOND FLOOR

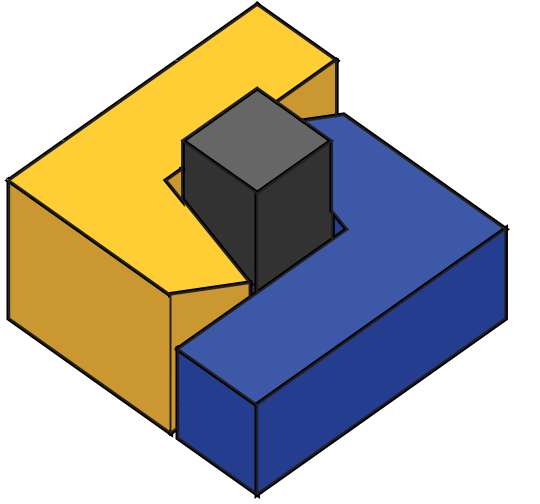

SURE MEASURE, LLC
244 Fifth Avenue, Suite N285
New York, NY 10001
646.937.9974
info@suremeasure.com

Building Documentation Specialists
Architectural as-built Documentation
2D CAD Drawings, 3D BIM Models
3D Laser Scanning, Point Cloud Model
Virtual Reality Walkthrough Tours

NOTE: THIS DRAWING IS PROVIDED FOR INFORMATIONAL PURPOSES ONLY. ALL DRAWINGS ARE PROVIDED TO OUR CLIENTS BASED UPON INFORMATION TAKEN AT EXISTING BUILDING AND DRAWN IN ACCORDANCE WITH COMMON BUILDING PRACTICES. ALL DIMENSIONS AND SPECIFICATIONS SHOULD BE VERIFIED BY CLIENT AND/OR CONTRACTOR. IF DIMENSIONS AND SPECIFICATIONS ARE NOT VERIFIED BY CLIENT AND/OR CONTRACTOR SURE MEASURE WILL BE HELD HARMLESS. SURE MEASURE ASSUMES NO LIABILITY FOR CHANGES AND/OR REVISIONS MADE TO PLANS BY CLIENT AND/OR CONTRACTOR.

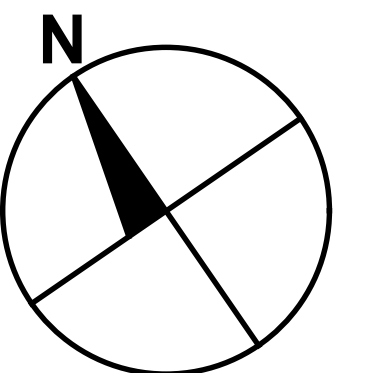

PROJECT:
**COMMERCIAL
BUILDING**

8710 5TH AVENUE
BROOKLYN, NY

DRAWING TITLE:
EXISTING FLOOR PLANS

ISSUE DATE:
04/13/2022

SURVEY TEAM:
N.B./ C.B.

SCALE:
 $\frac{3}{16}'' = 1'-0''$



EX-2