



**15704 N Pima Rd
Scottsdale, AZ 95260
Former Rubio's**



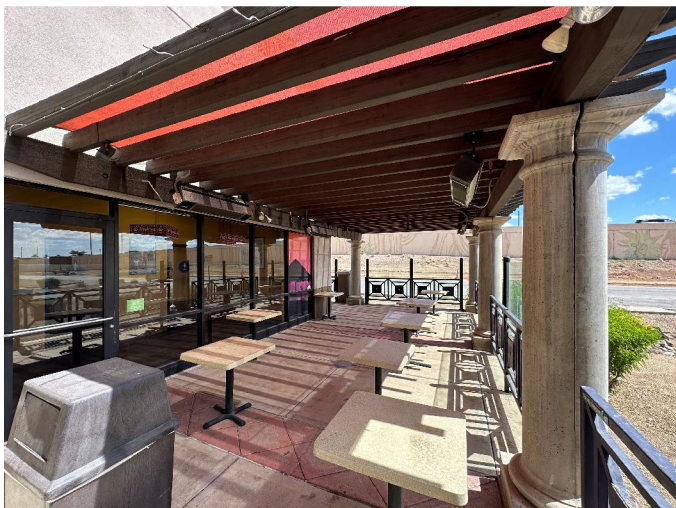

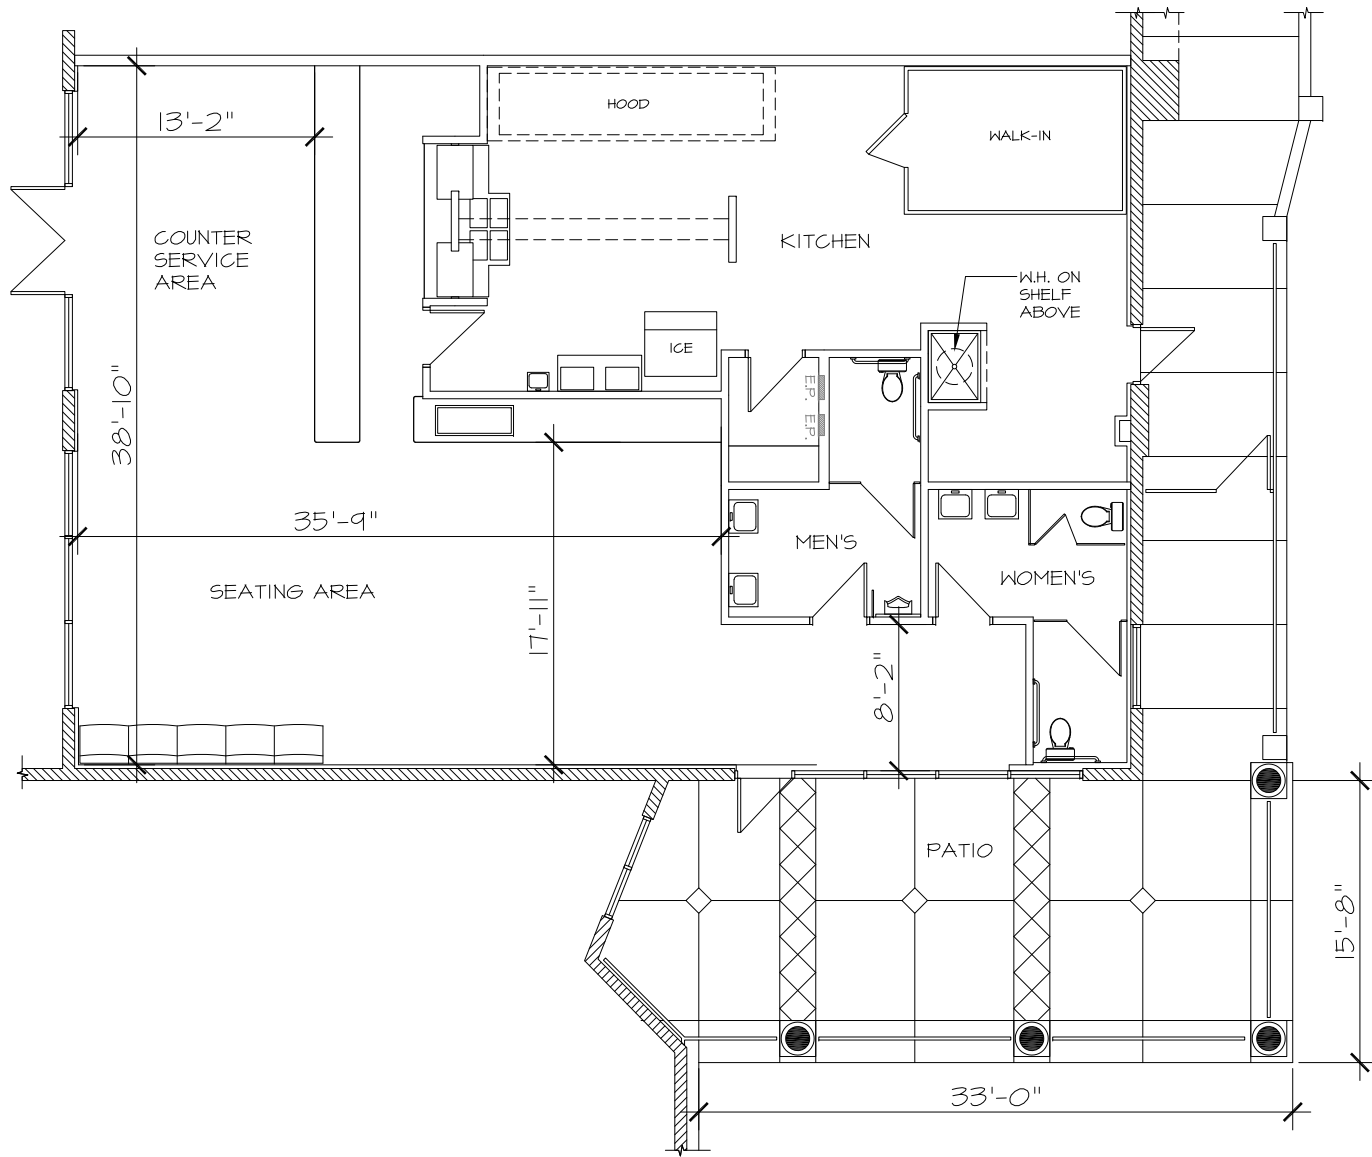

15705 N HAYDEN – SUITE L124

SCALE: 3/32"=1'-0"

SUITE AREA 2,400 SF



NORTH

Drawing name: M:\Tenant Improvement\1436 Sonora Village\Field Verify\Suite L-124 As-Built.dwg

BK	DRAWN
BK	CHECKED
9.20.24	DATE
3/32" = 1'0"	SCALE
1436.00	JOB NO.

AS-BUILT PLAN

AB1

SONORA VILLAGE
 15705 N. Hayden Road
 Scottsdale, Arizona
SUITE L124

M C C A R T H Y

Architectural Interiors
 2650 East Camelback Road
 Suite 250 85016
 Phone 602.955.4499
 Telephone 602.955.4499
 Facsimile 602.955.4599

N O R D B U R G

