


US Bank Center  
 Suite 500  
 8,269 RSF / 7,216 USF

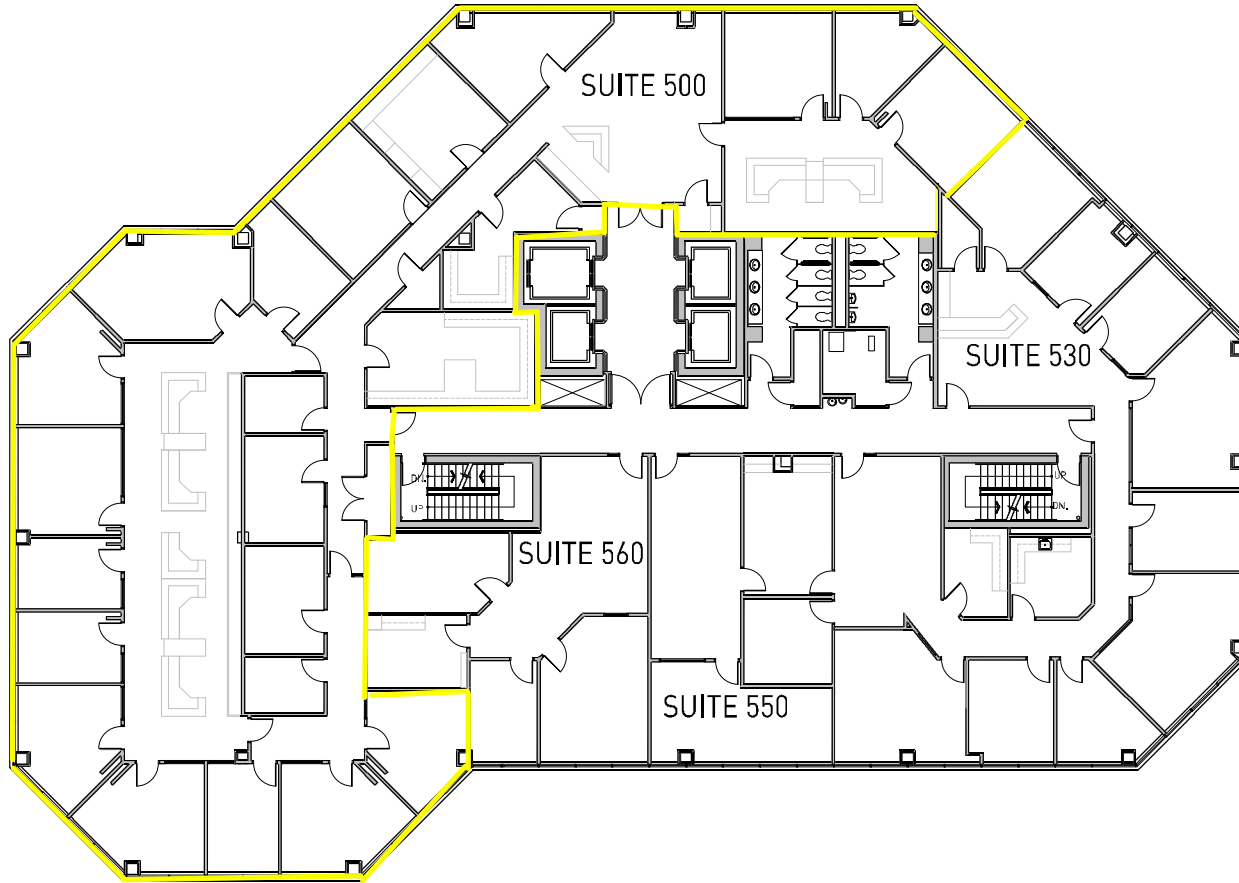

AS BUILT  
 5TH FLOOR

for  
 NEVADA FINANCIAL CENTER  
 2300 WEST SAHARA AVENUE  
 LAS VEGAS, NV 89102

REVISIONS		
NO.	DATE/COMMENTS	BY

DATE: 04/21/11  
 PROJECT NO.: 001

DRAWN BY: JAL  
 CHECKED BY: JLV

HEET NUMBER

**ID1.0**



AS BUILT - 5TH FLOOR

SCALE: 1/8" = 1'-0"