


PRINTED: 12/02/2022 1:04:48 PM


## 2 UPPER LEVEL FINISH FLOOR

SCALE: 3/32" = 1'-0"

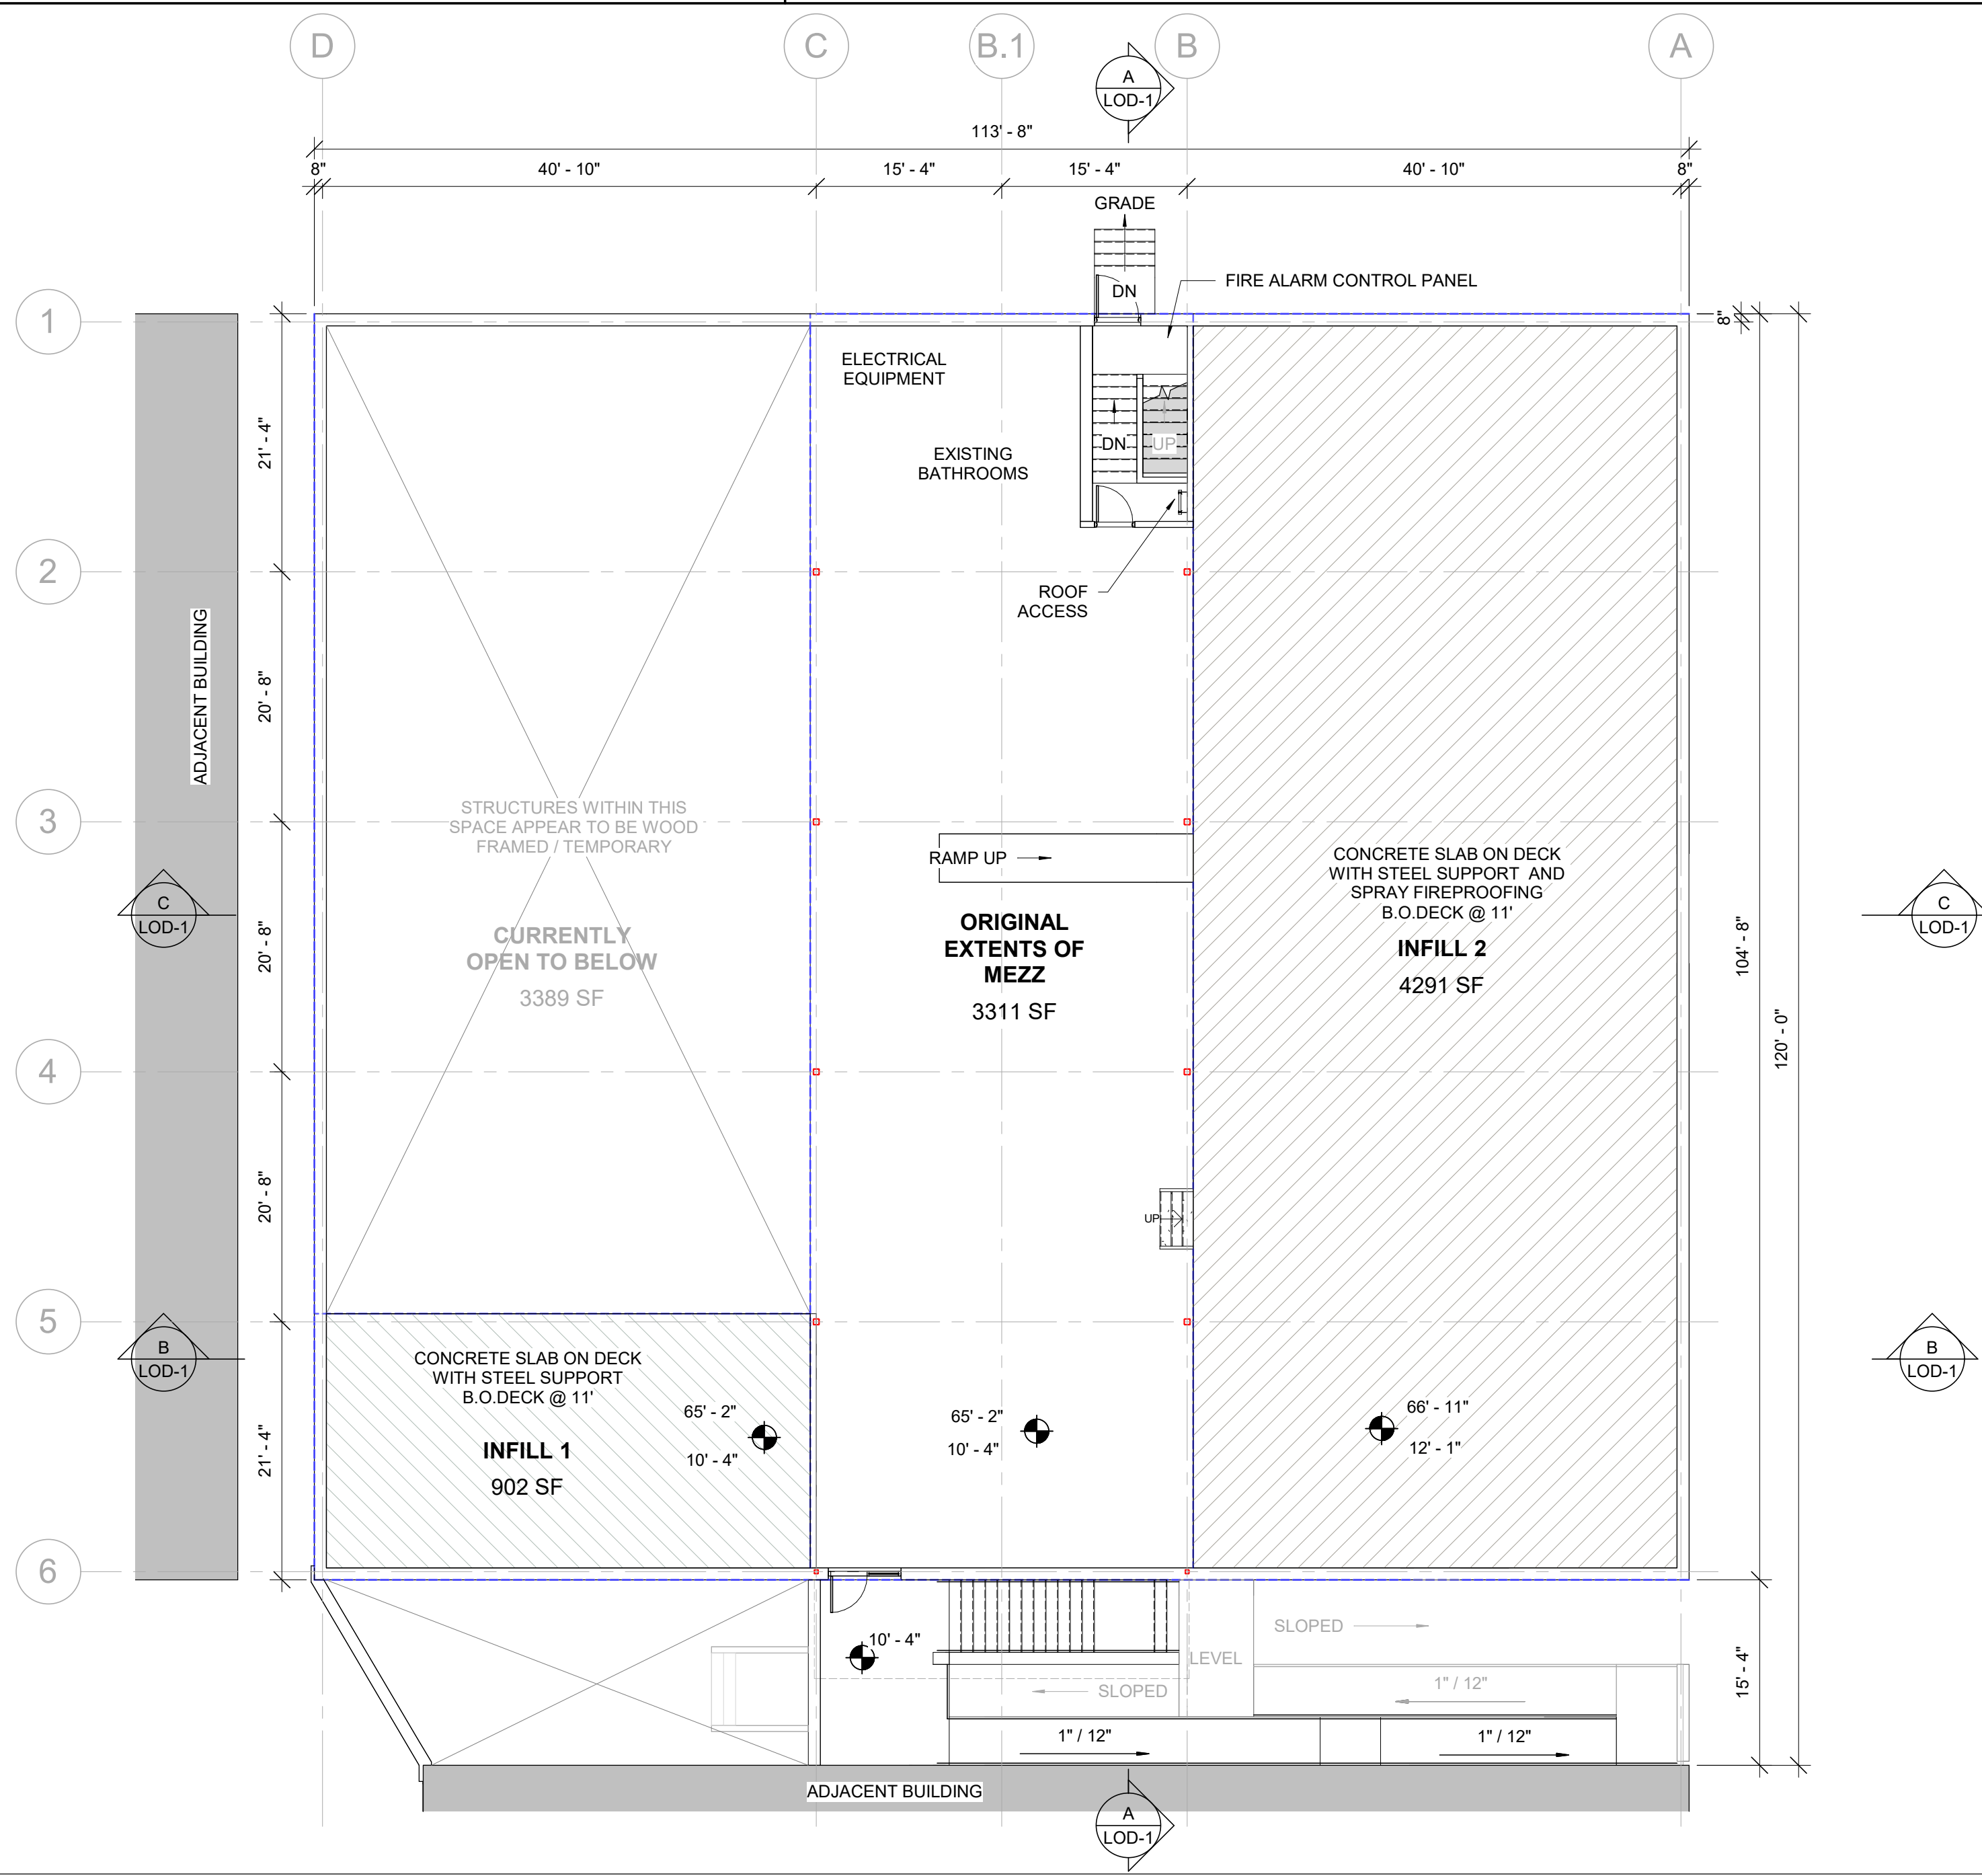


## C BUILDING SECTION

SCALE: 1/16" = 1'-0"

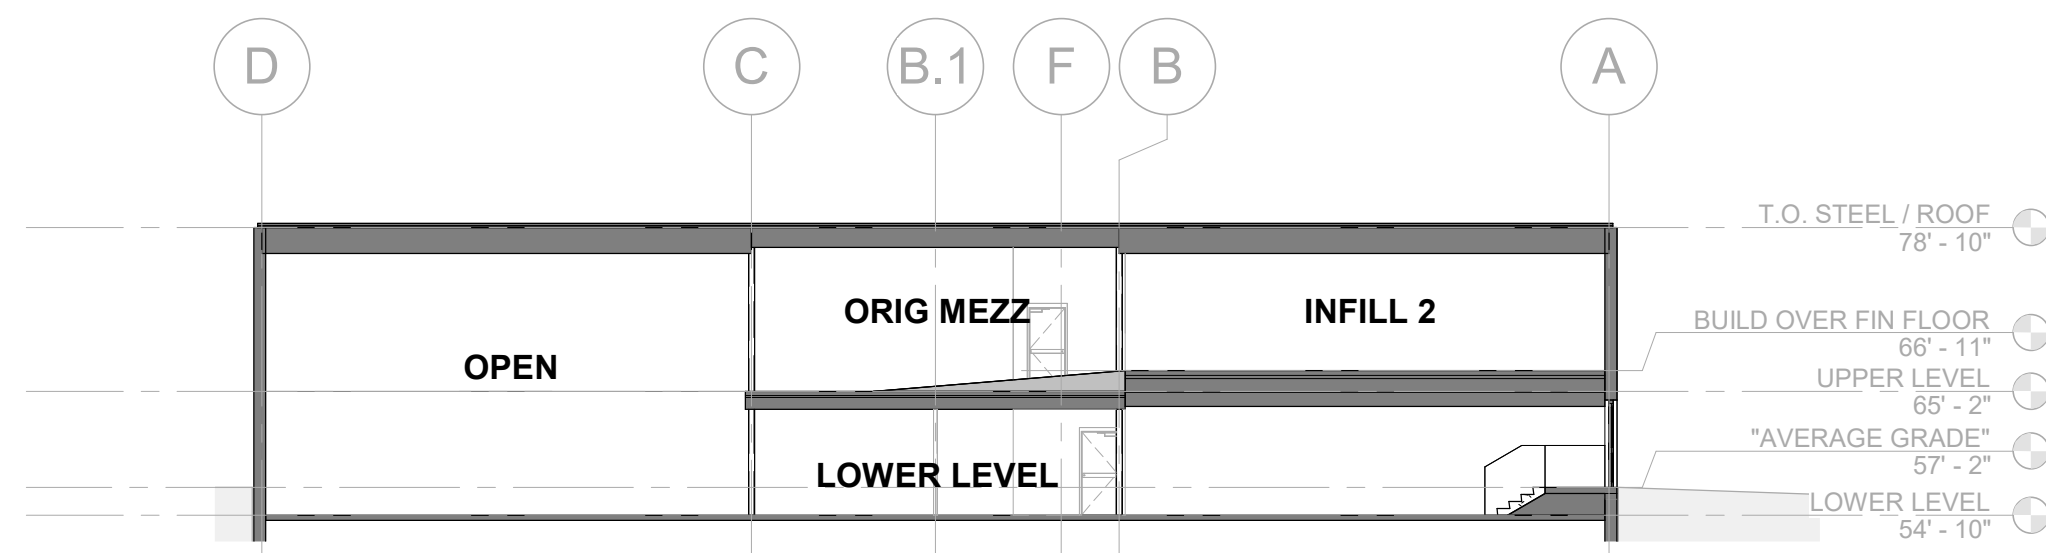


## B BUILDING SECTION

SCALE: 1/16" = 1'-0"

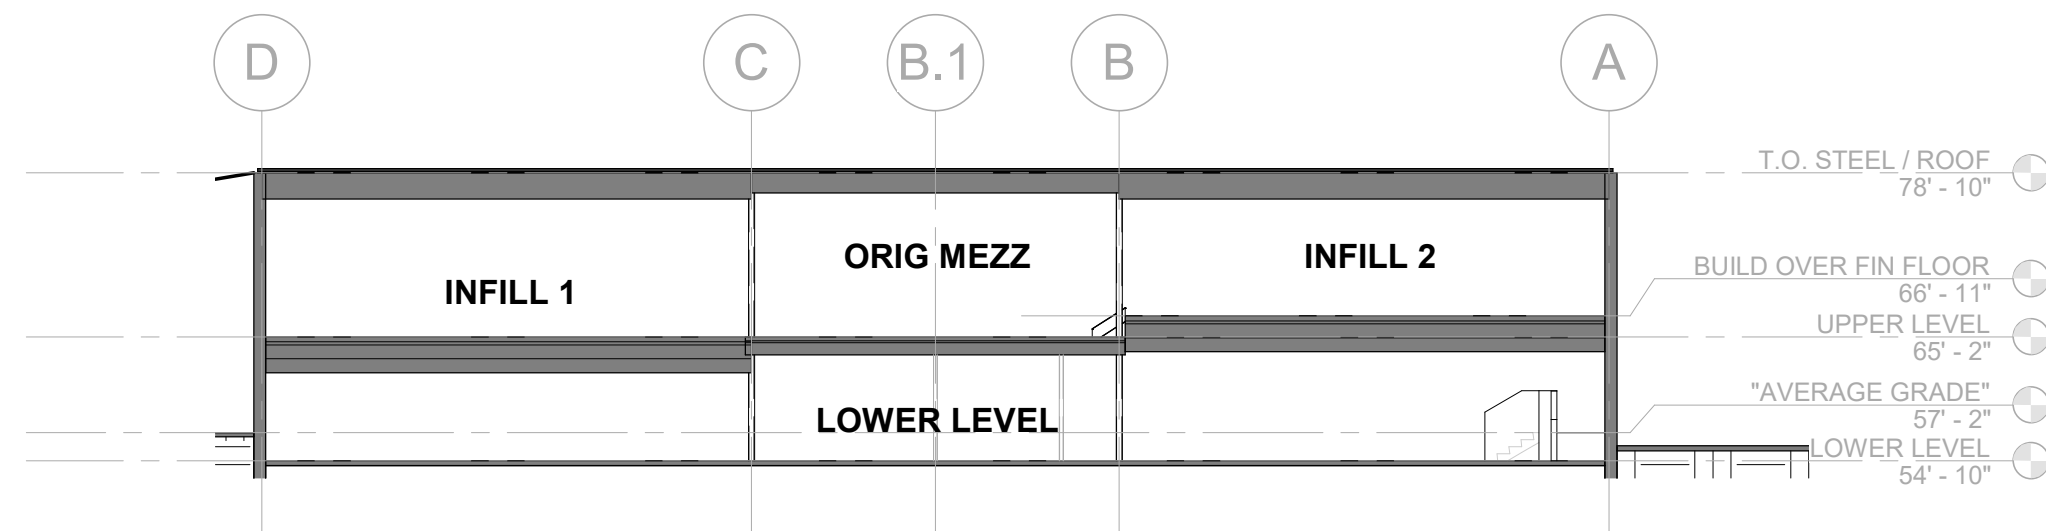

## A BUILDING SECTION

SCALE: 1/16" = 1'-0"

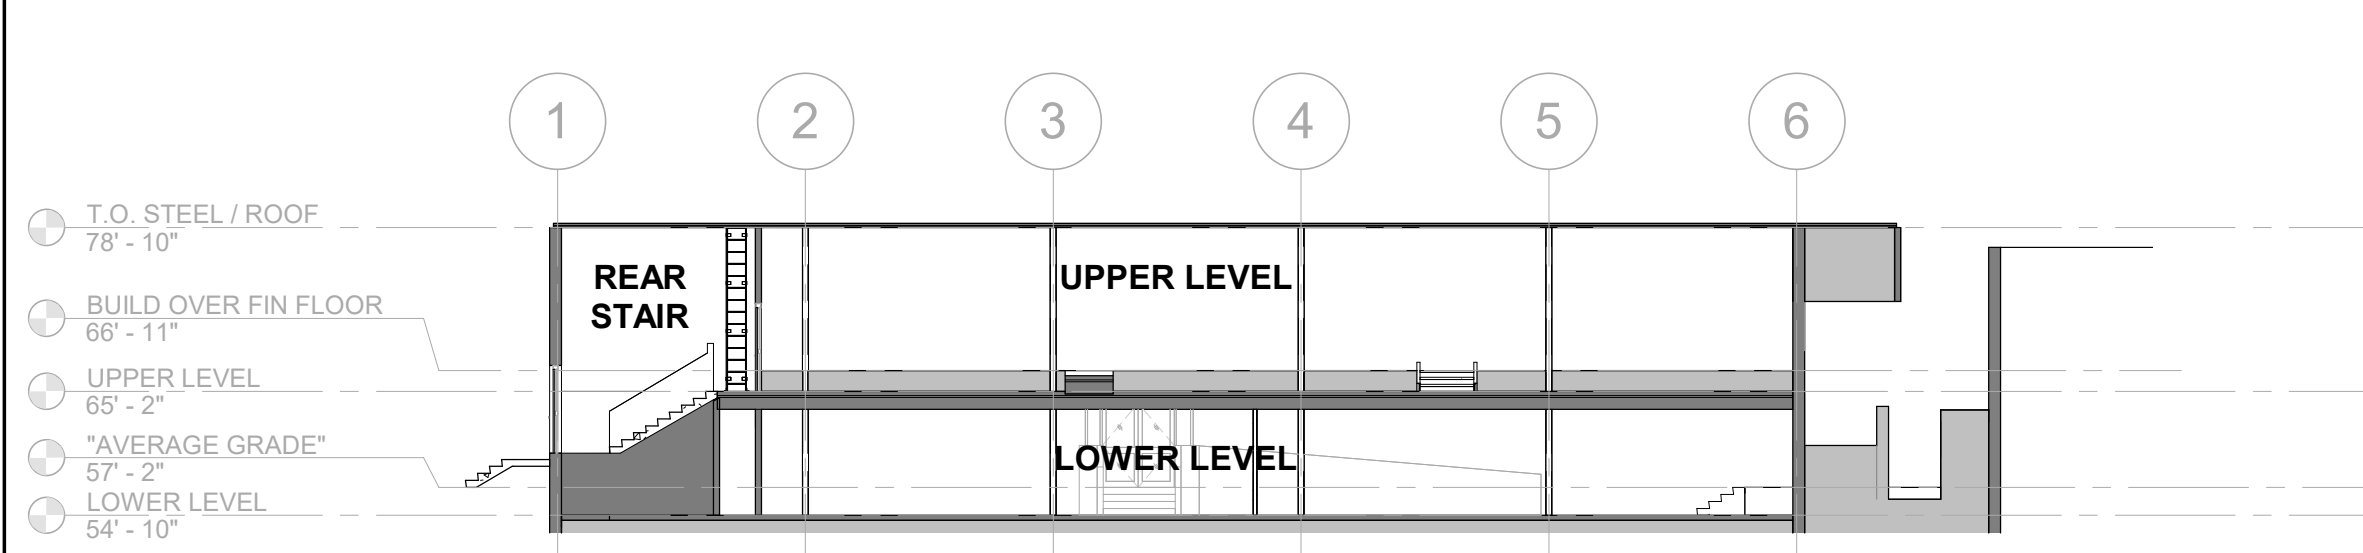

**DISCLAIMER:**  
THIS DOCUMENT HAS BEEN CREATED USING ARCHIVE / RECORD DRAWINGS PROVIDED BY THE BUILDING OWNER AS WELL AS A FIELD VISIT TO VERIFY THE GENERAL ACCURACY OF THE BUILDING / SPACES DESCRIBED HEREIN.

THE BUILDING DETAILED IN THE DRAWINGS WAS ORIGINALLY A SINGLE TENANT RECOUET BALL FACILITY WITH MEZZANINE OVERLOOKING THE COURTS. THESE DRAWINGS AIM TO DOCUMENT THE GENERAL STATE OF THE INTERIOR FLOOR PLATES FOR SPACE PLANNING AND GENERAL AREA VERIFICATION PURPOSES.

### DEFINITIONS:

**GLA = GROSS LEASEABLE AREA**

### GLA LINE LOCATION:

THE DEMISING LINE IS LOCATED AT THE EXTERIOR FACE OF EXTERIOR WALLS AND EDGES OF MAJOR FLOOR CONSTRUCTION.

### CORNER BUILDING GLA

Name	Level	Area	Comments
LOWER LEVEL	LOWER LEVEL	11897 SF	
UPPER LEVEL	UPPER LEVEL	3311 SF	
ORIGINAL EXTENTS OF MEZZ	UPPER LEVEL	902 SF	
INFILL 1	UPPER LEVEL	4291 SF	
INFILL 2	UPPER LEVEL	20402 SF	

## 1 LOWER LEVEL

SCALE: 3/32" = 1'-0"

