


entrance



offices

art studios

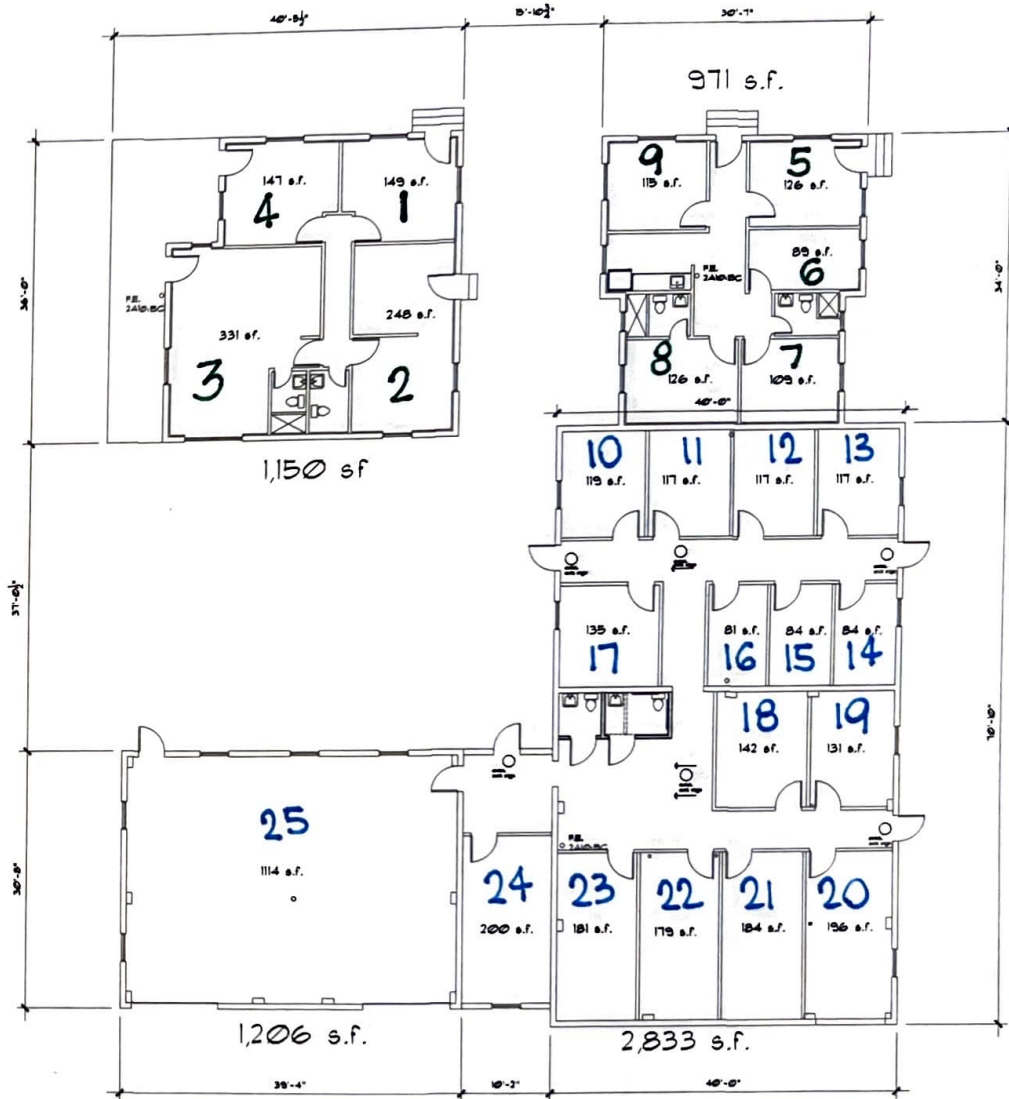

JOB NUMBER

ISSUE DATE

DRAWN BY

REVISIONS




JAMES E. JACKSON, JR.
ARCHITECT
LICENSE # A0002839



JAMES E. JACKSON, JR., AIA.
 SAINT PETERSBURG, FLORIDA
 LICENSE # A0002839

an independent member firm of the
 member American Institute of Architects

AS BUILT PLAN
 IMH 4 LLC
 321 14TH AVENUE SOUTH
 ST PETERSBURG, FLORIDA

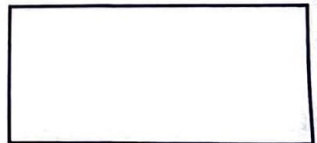

**EXISTING
 FLOOR PLAN**

SHEET NUMBER
A-1
 OF