


AS-BUILT PLAN SUITE 100

PLAN NORTH TRUE NORTH

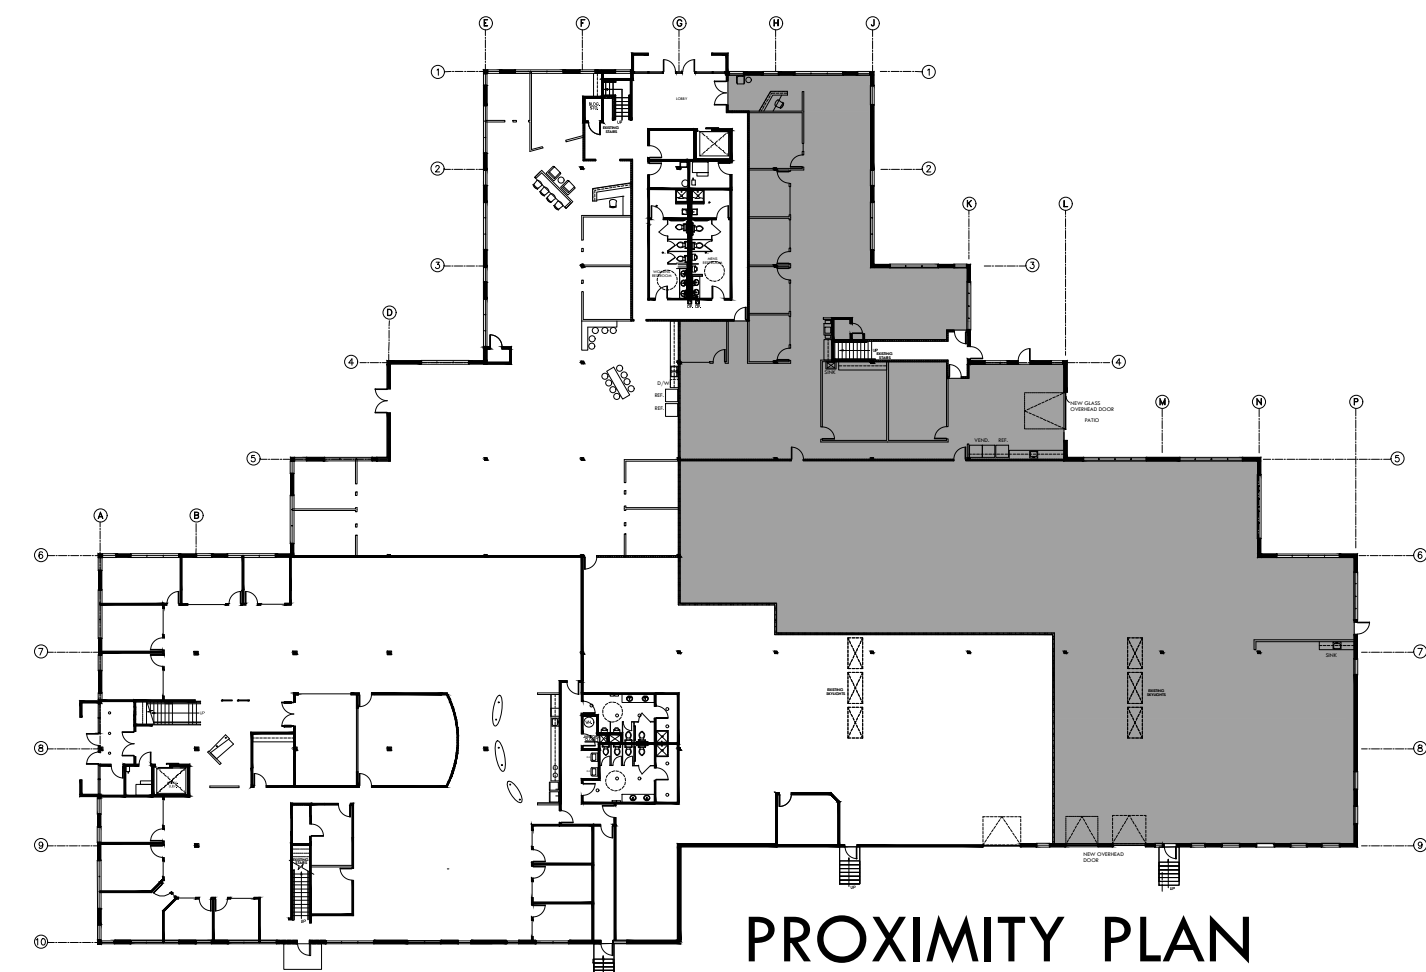


PROXIMITY PLAN

PLAN NORTH TRUE NORTH


HYPOTHETICAL PLAN OPTIONS

- TOTAL SQUARE FOOTAGE OF THIS SPACE IS 17,515 RSF
- AVERAGE OCCUPANCY - 100 OCCUPANTS ±
- WAREHOUSE SQUARE FOOTAGE IS 11,600 ±
- THIS PLAN INCLUDES MIX OF OPEN OFFICE AREAS, OFFICES, CONFERENCE ROOMS, AND A WAREHOUSE AREA

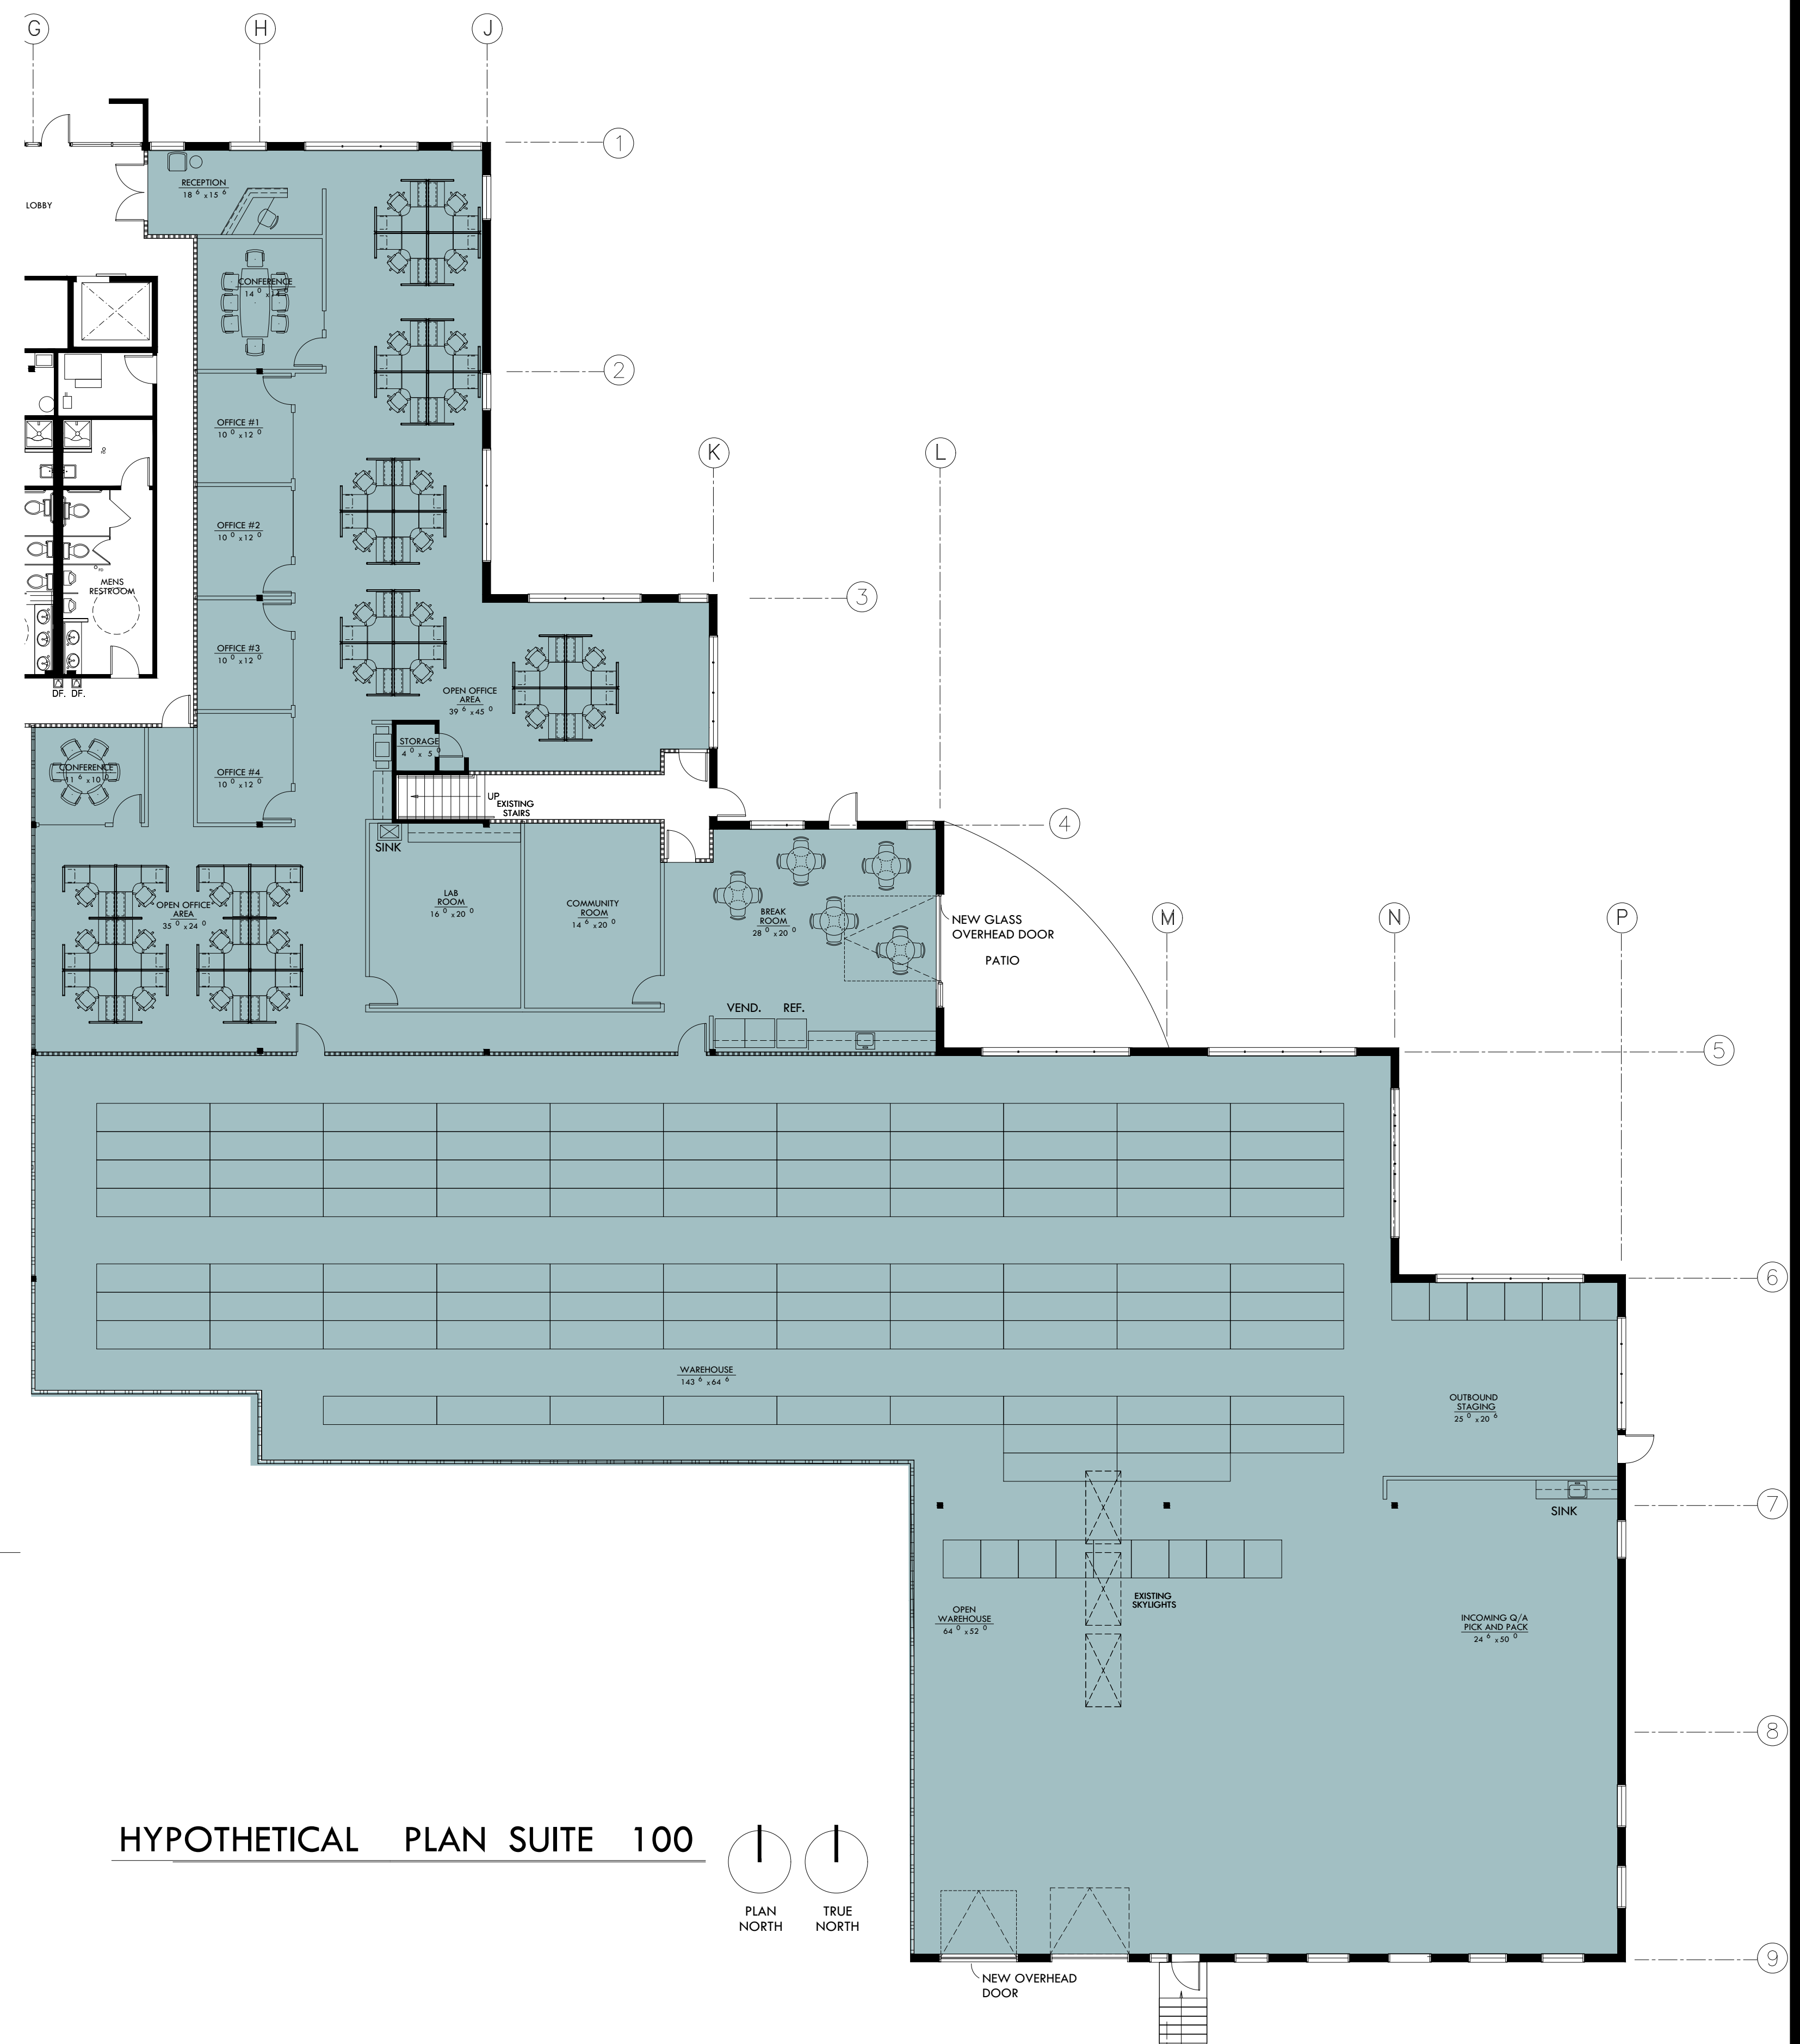

HYPOTHETICAL PLAN SUITE 100

PLAN NORTH TRUE NORTH

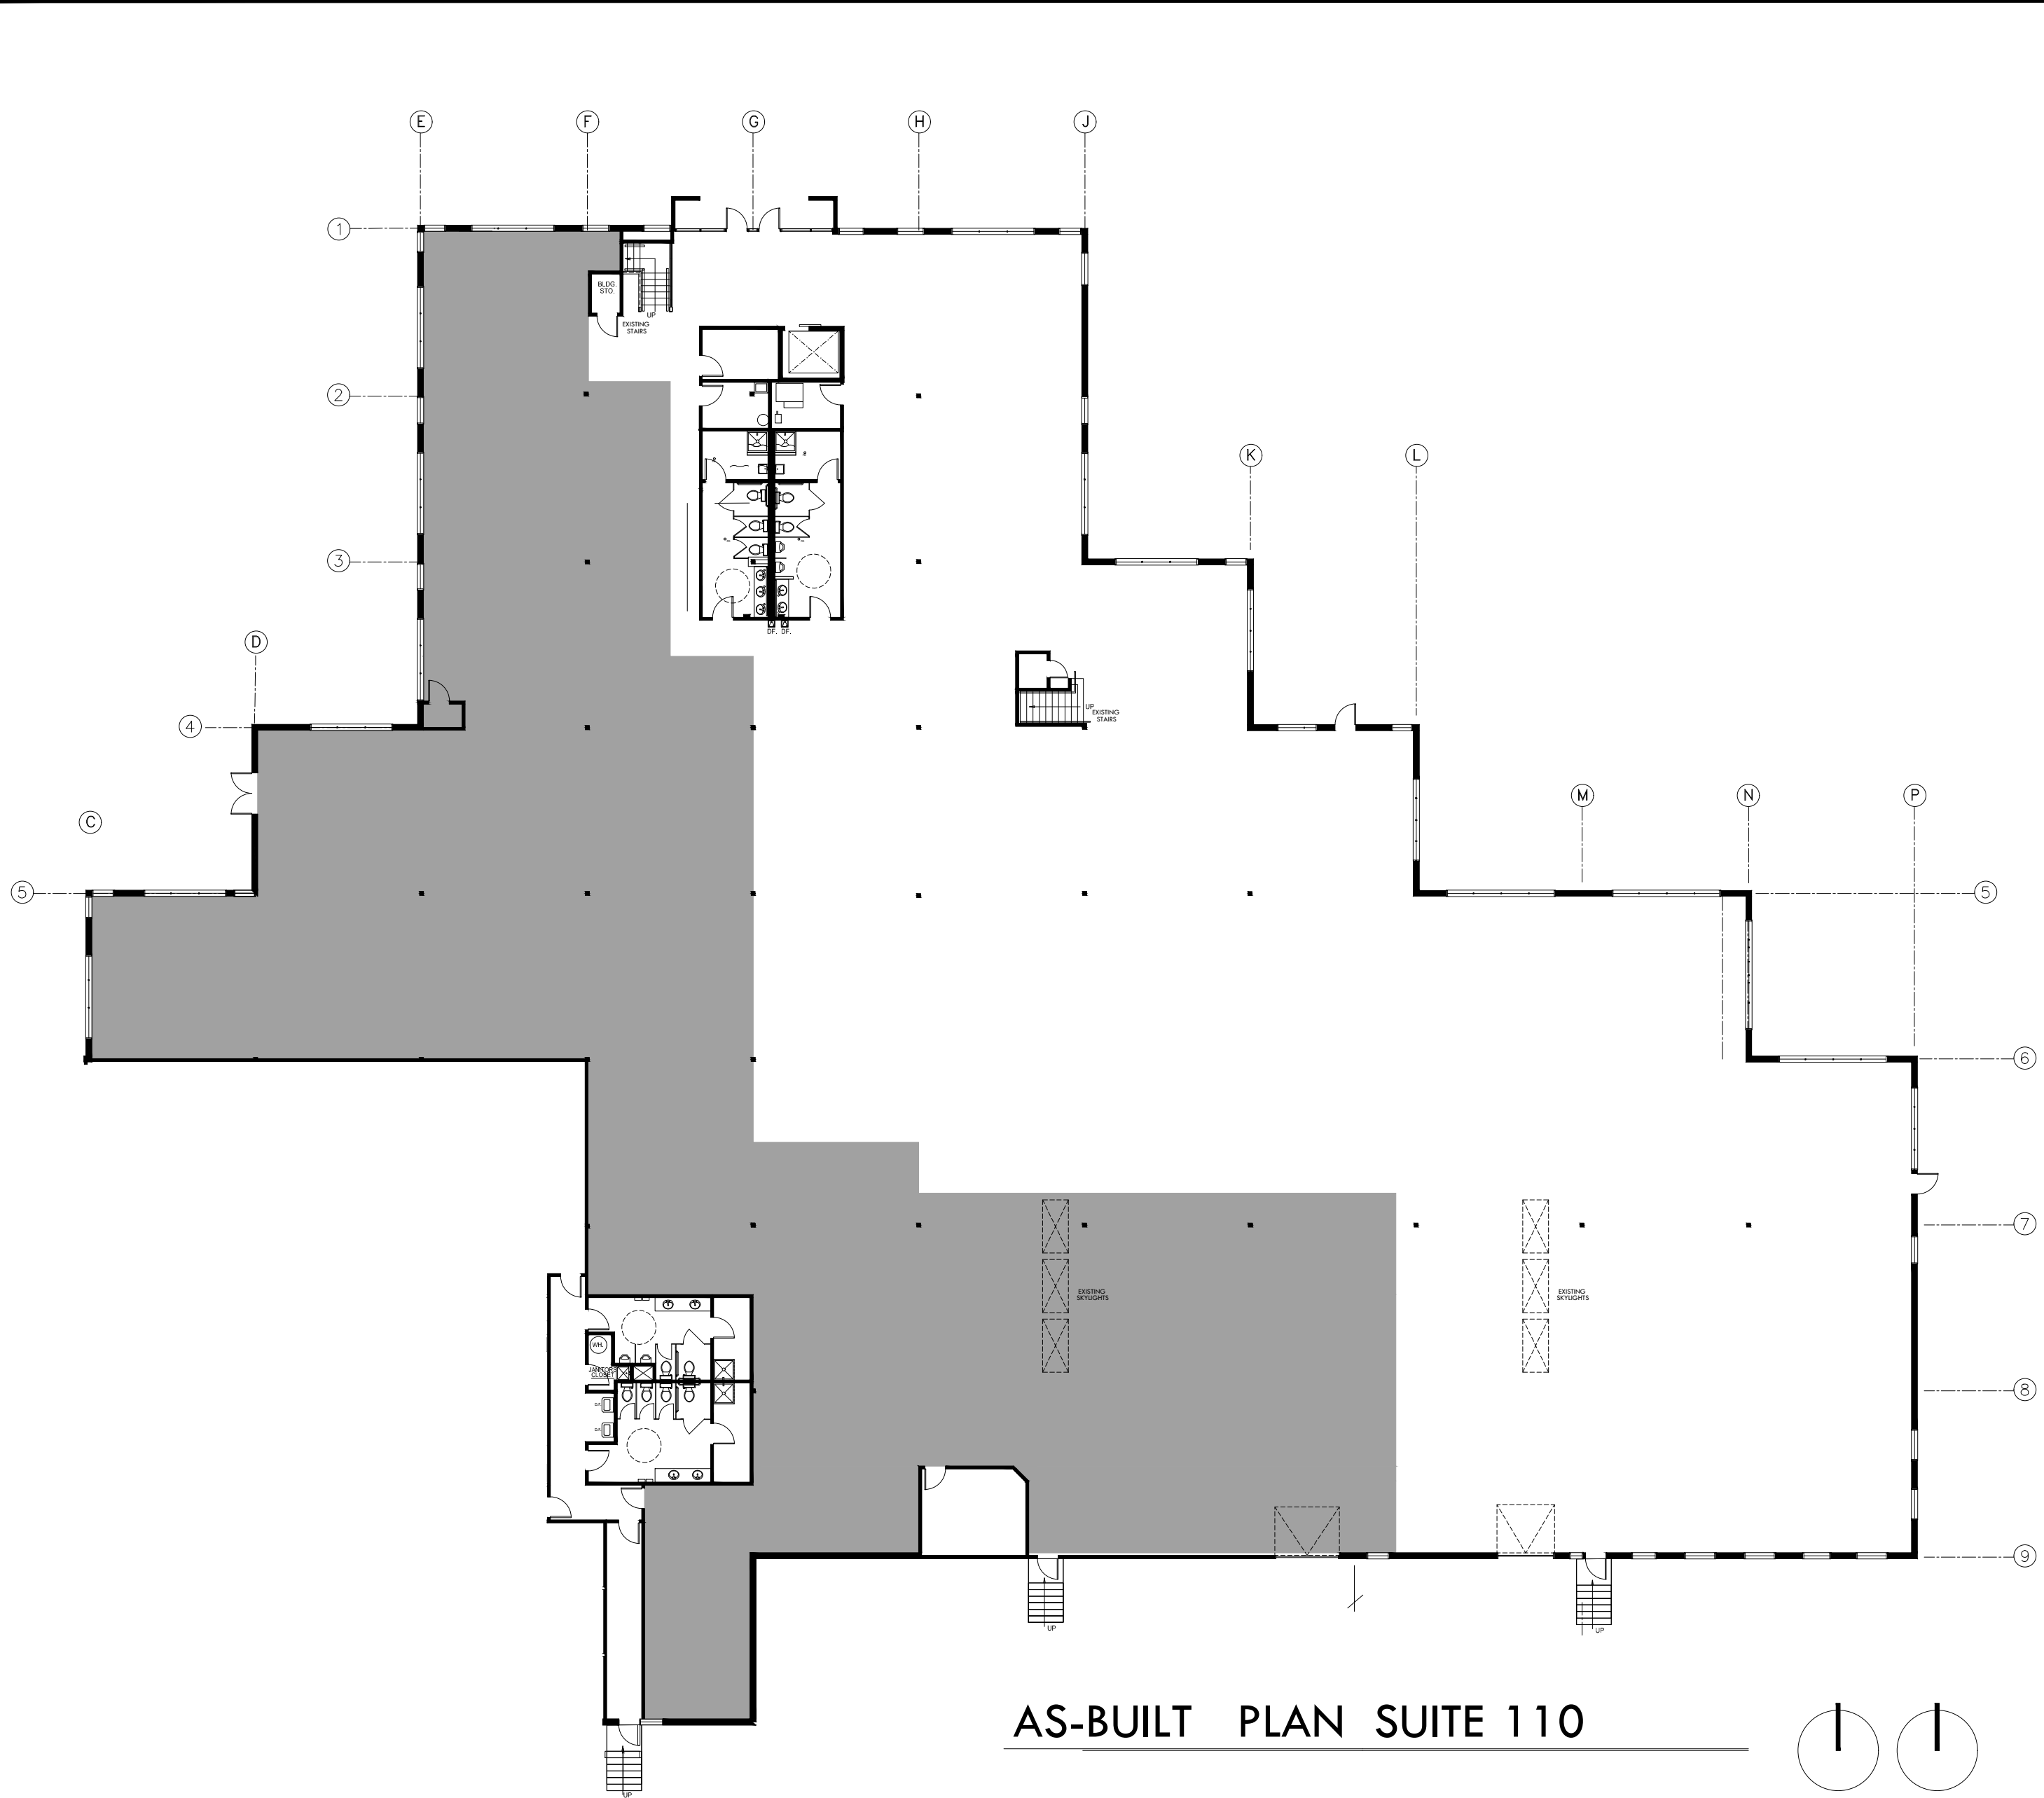


AS-BUILT PLAN SUITE 110

PLAN NORTH TRUE NORTH



HYPOTHETICAL PLAN SUITE 110

PLAN NORTH TRUE NORTH

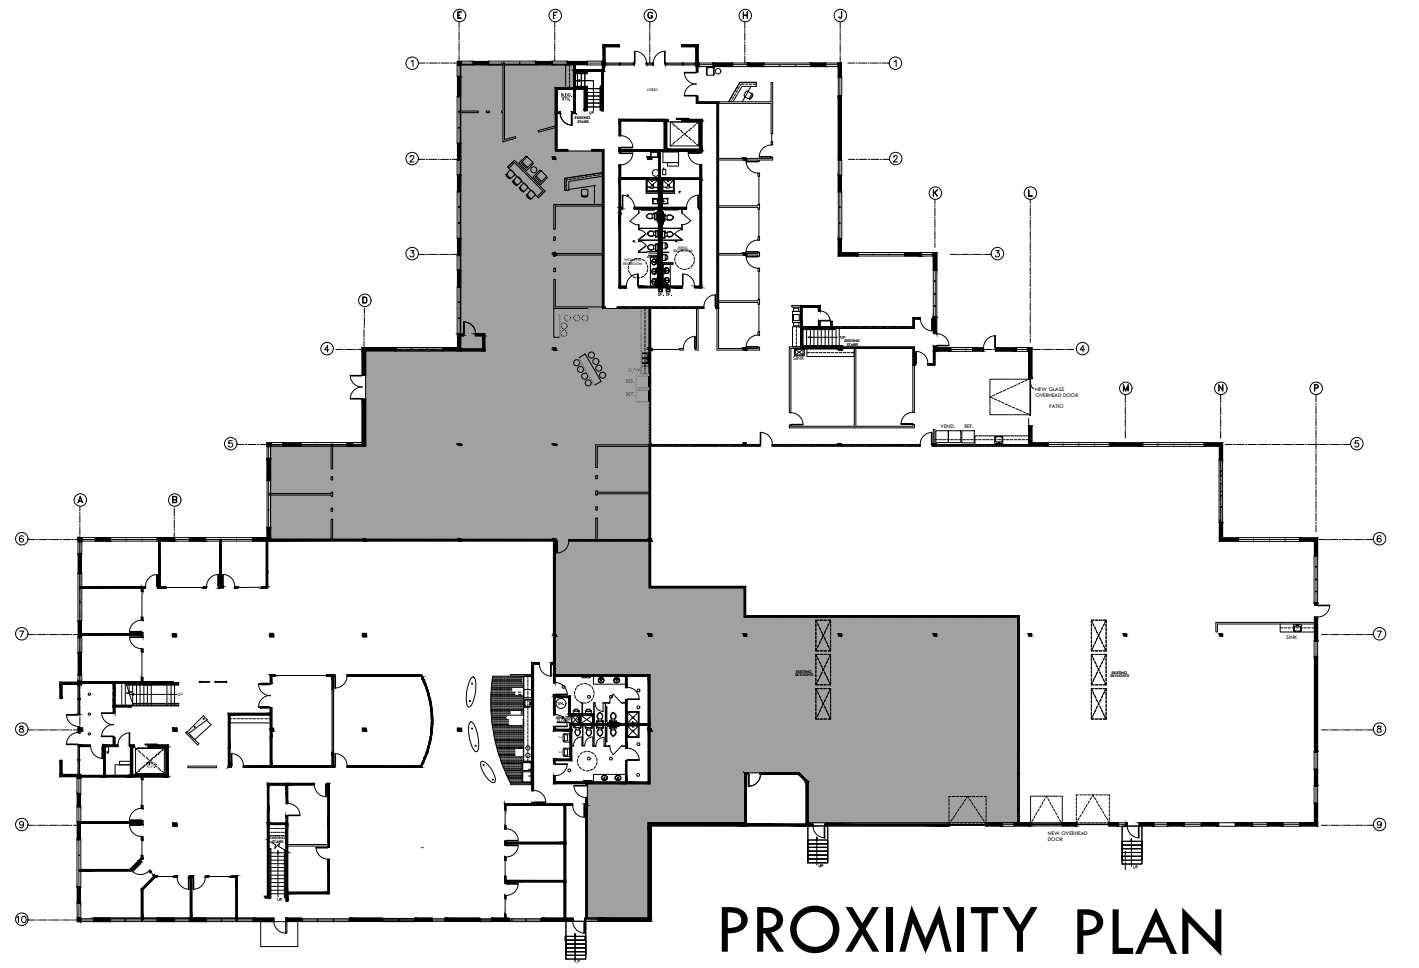

PROXIMITY PLAN

PLAN NORTH TRUE NORTH

- HYPOTHETICAL PLAN OPTIONS**
- TOTAL SQUARE FOOTAGE OF THIS SPACE IS 14,340 RSF
 - AVERAGE OCCUPANCY - 95 OCCUPANTS ±
 - WAREHOUSE SQUARE FOOTAGE IS 7,000 ±
 - THIS PLAN INCLUDES MIX OF OPEN OFFICE AREAS, OFFICES, CONFERENCE ROOMS, AND A WAREHOUSE AREA