


2.1.1 1/16"=1' FLOOR PLAN

TOTAL BUILDING 35,624 SF


ALL DIMENSIONS FOR THIS BUILDING HAVE BEEN TAKEN FROM ON SITE VISUAL INSPECTION OF AN OCCUPIED BUILDING. NO ORIGINAL CONSTRUCTION DOCUMENTS WERE FOUND. THIS ASBUILT DRAWINGS IS THE WAY THE BUILDING WAS BUILT AS OF THE DATE STAMPED ON THE PLANS. ANY USER OF THIS DRAWINGS MUST CONFIRM EXISTING CONDITIONS PRIOR TO USING THIS DRAWING FOR ANY PURPOSE.



BY: JCB
REP: PT
PROJ: 23
DATE: 19JUL2023

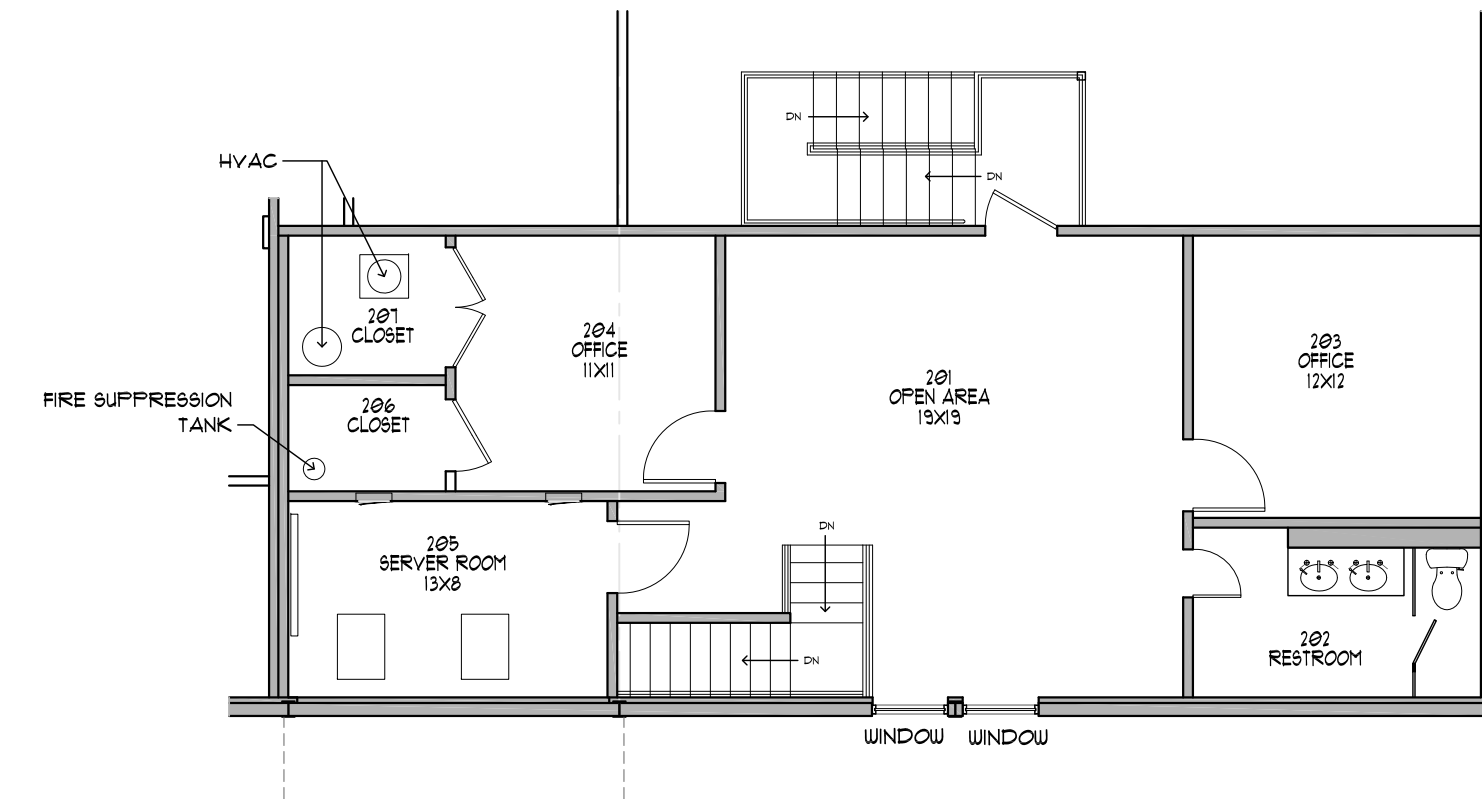

2.2.4 1/8"=1' UPPER LEVEL FLOOR PLAN
UPPER OFFICE 1,050 SF

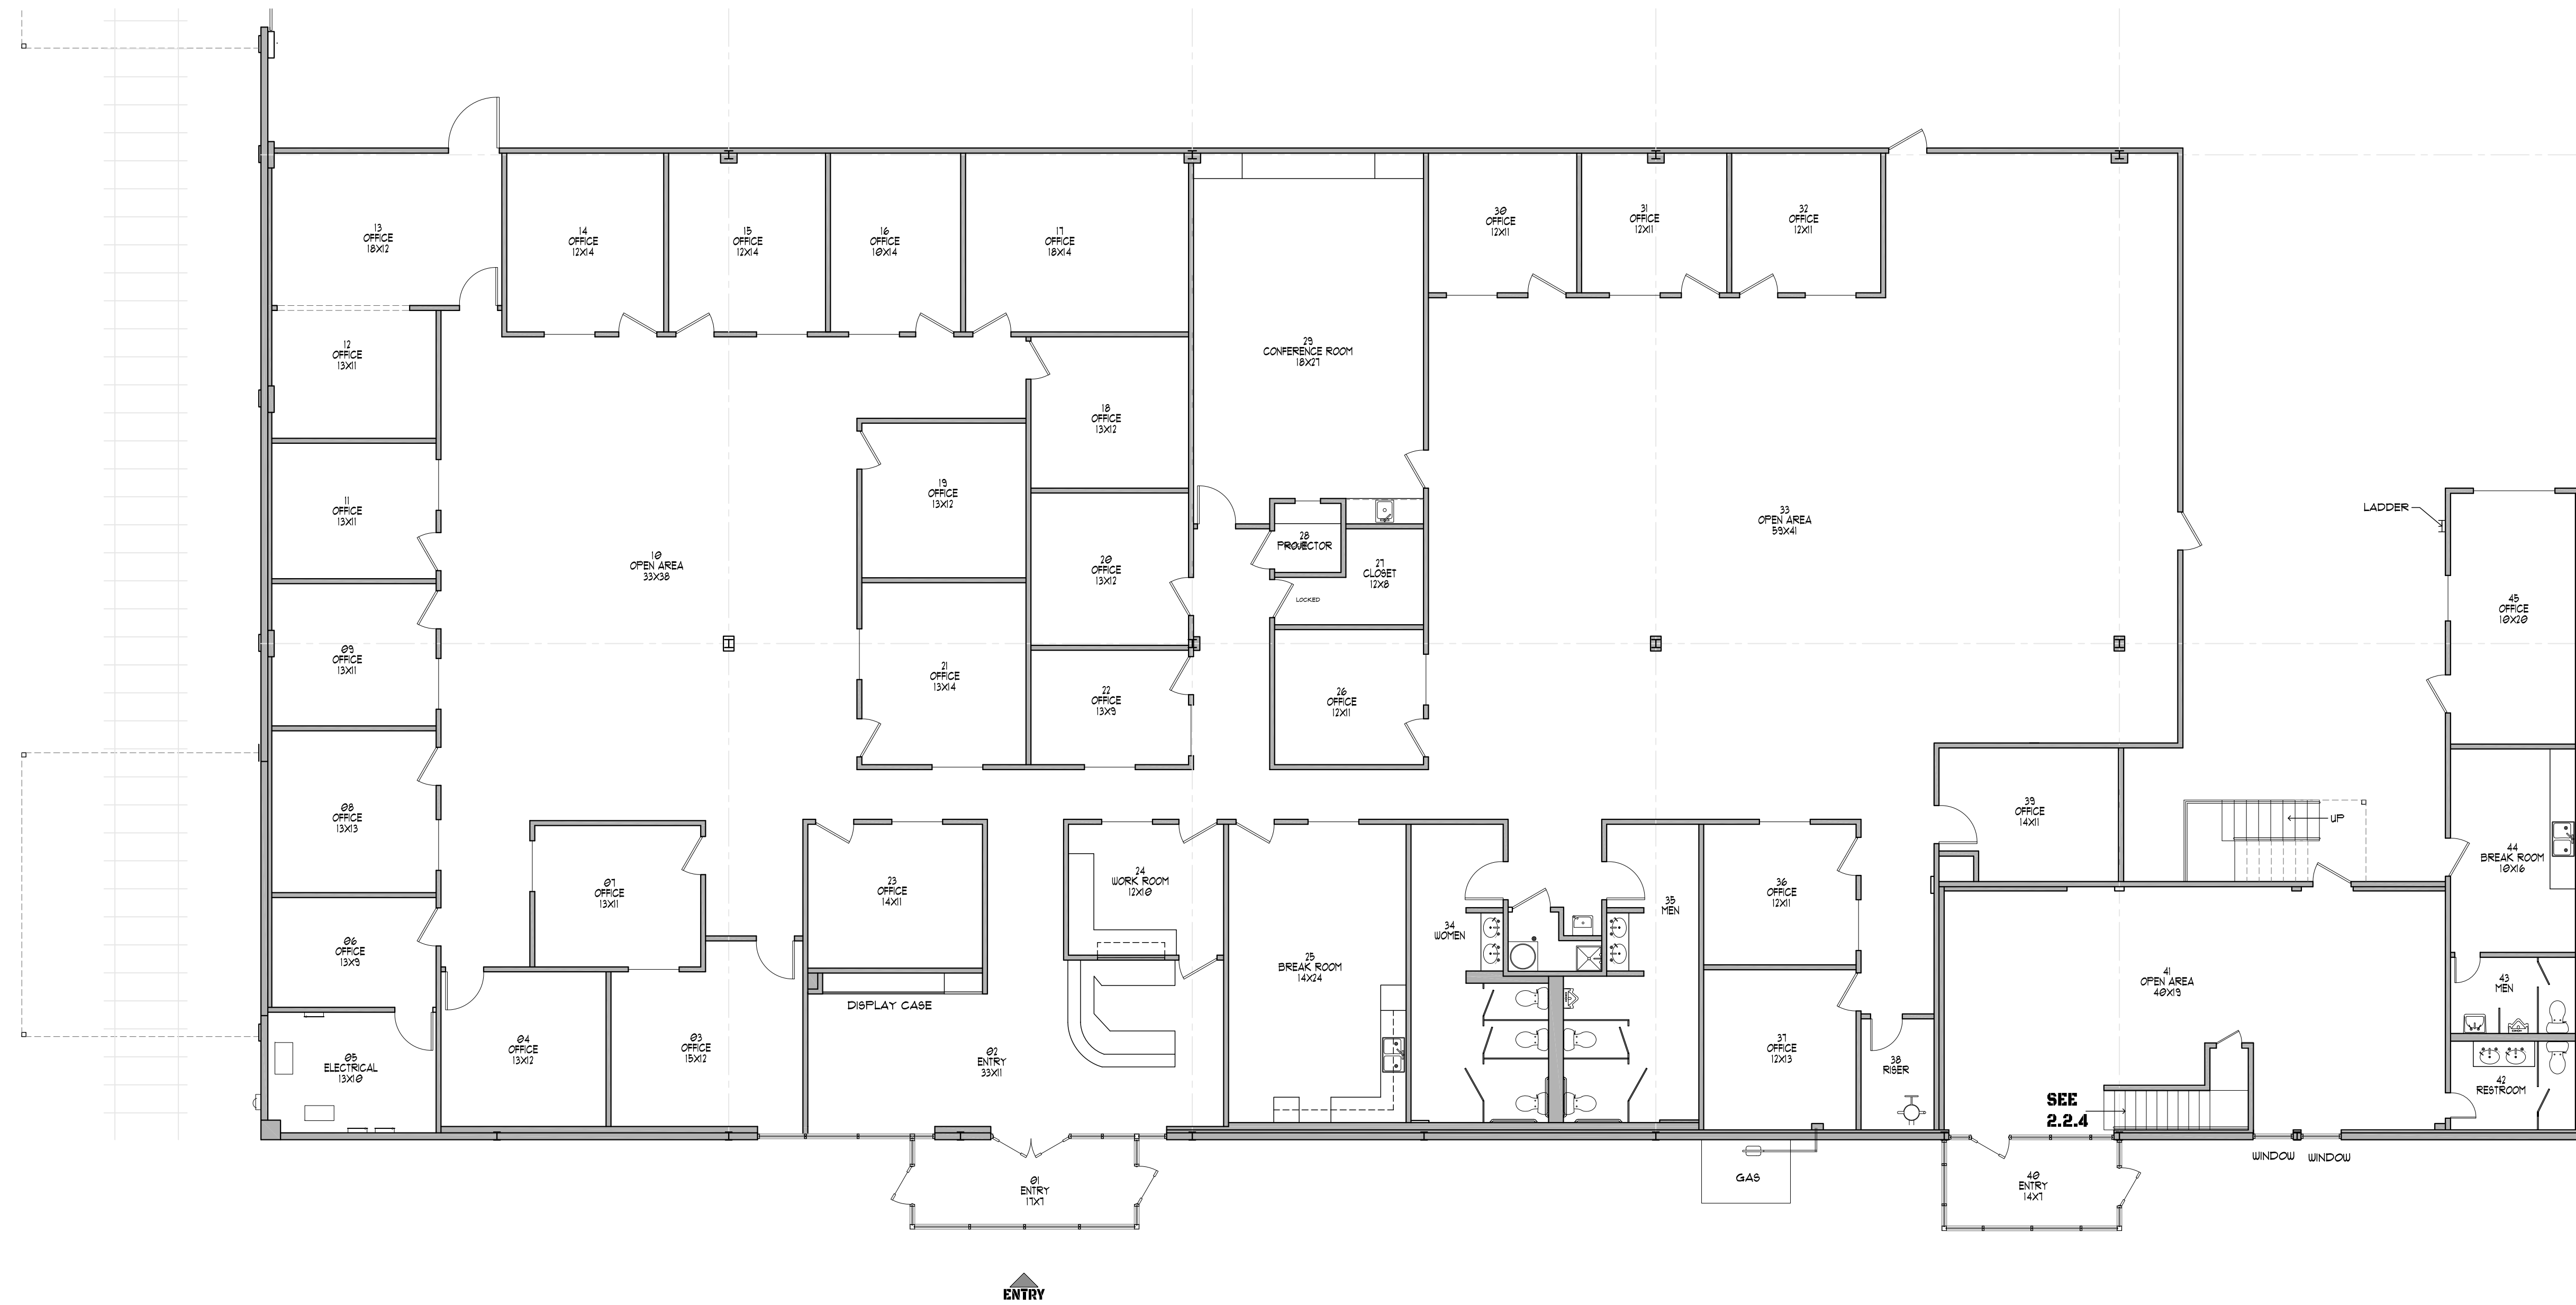

2.2.1 1/8"=1' FLOOR PLAN
TOTAL OFFICE 12,995 SF

ALL DIMENSIONS FOR THIS BUILDING HAVE BEEN TAKEN FROM ON SITE VISUAL INSPECTION OF AN OCCUPIED BUILDING. NO ORIGINAL CONSTRUCTION DOCUMENTS WERE FOUND. THIS ASBUILT DRAWINGS IS THE WAY THE BUILDING WAS BUILT AS OF THE DATE STAMPED ON THE PLANS. ANY USER OF THIS DRAWINGS MUST CONFIRM EXISTING CONDITIONS PRIOR TO USING THIS DRAWING FOR ANY PURPOSE

