


September 2019

PROVIDENCE BURGER
Douglas Avenue
Providence, Rhode Island

Proposed
Basement Plan

Scale: 1/8" = 1'-0"

A-3

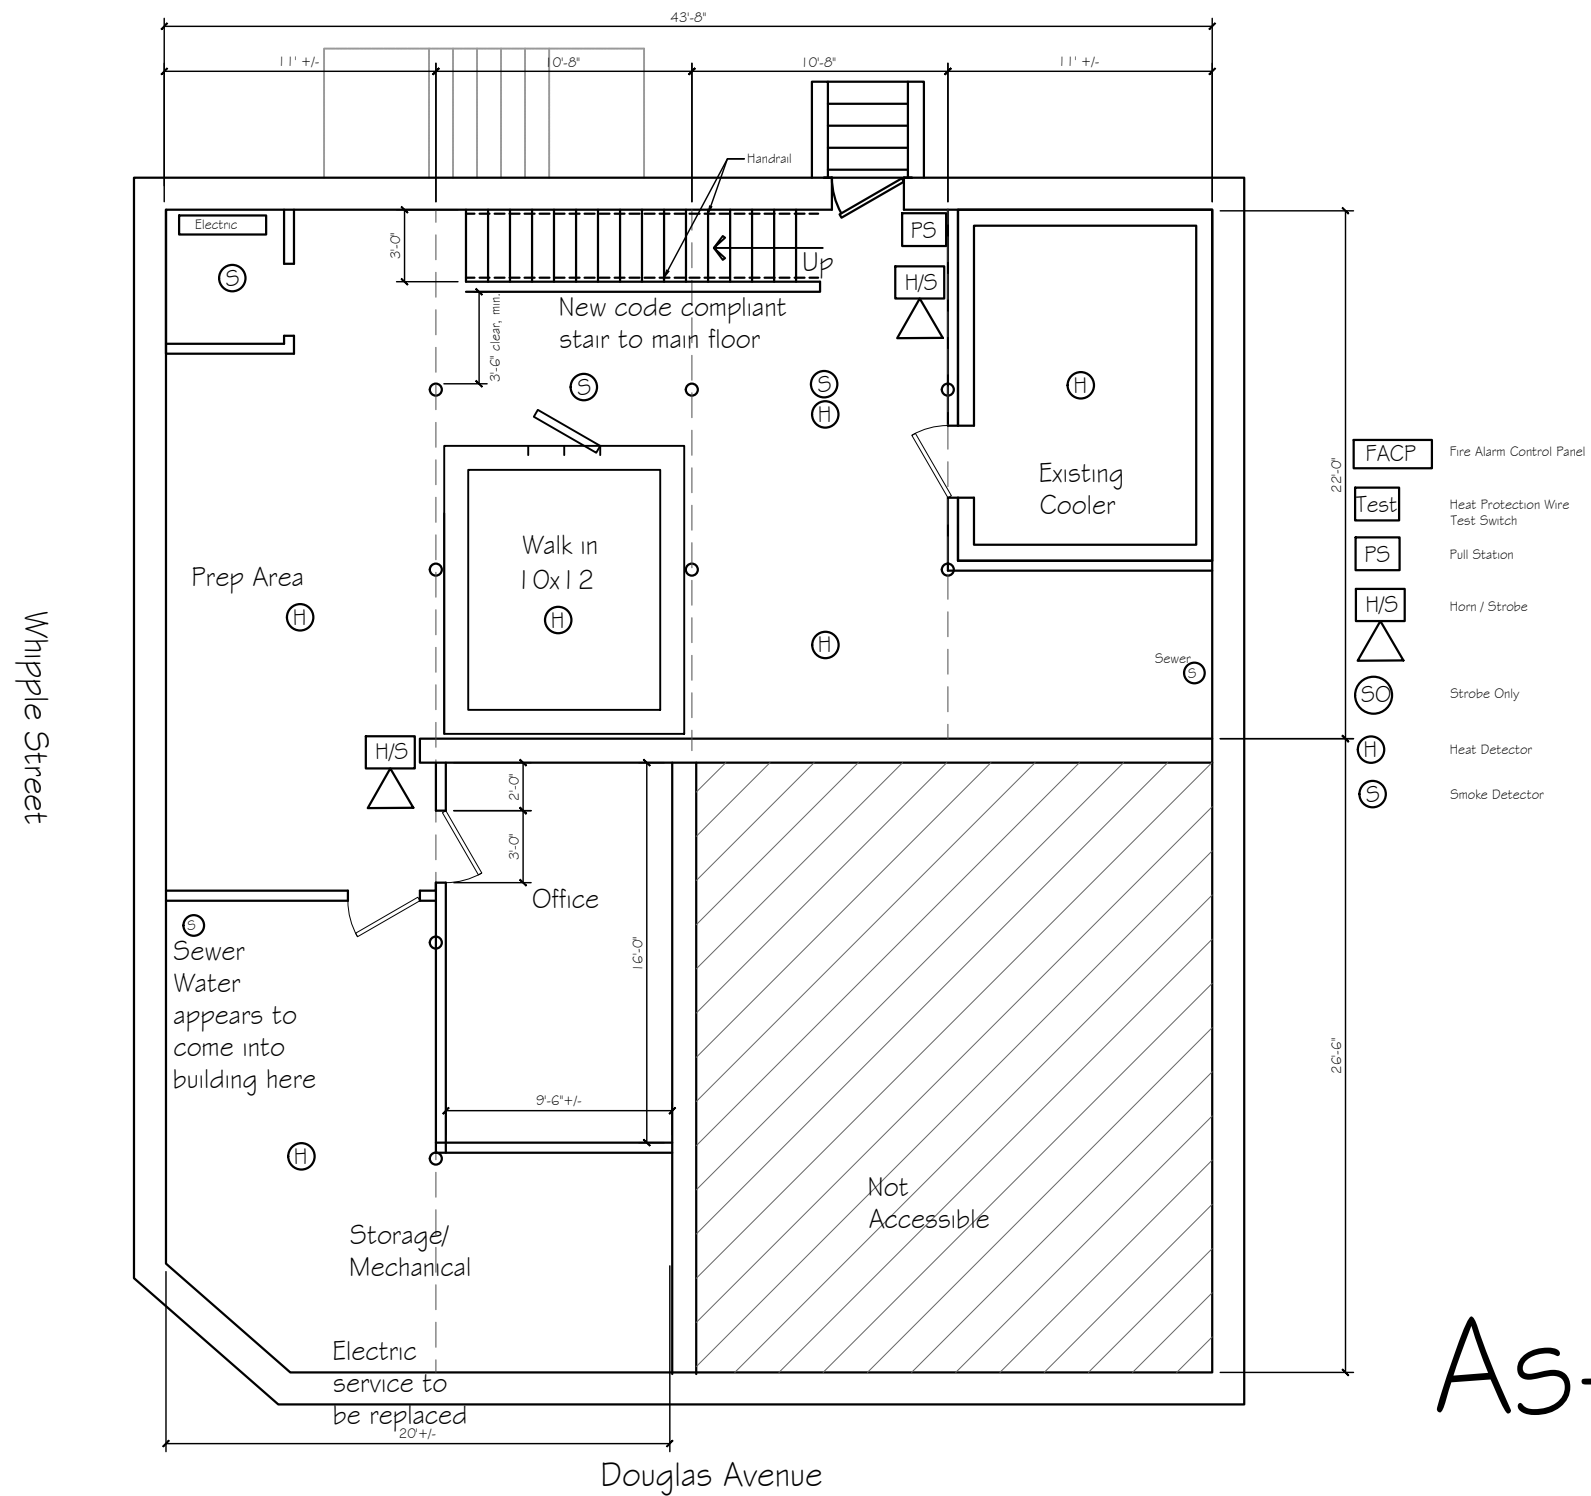

As-Built