
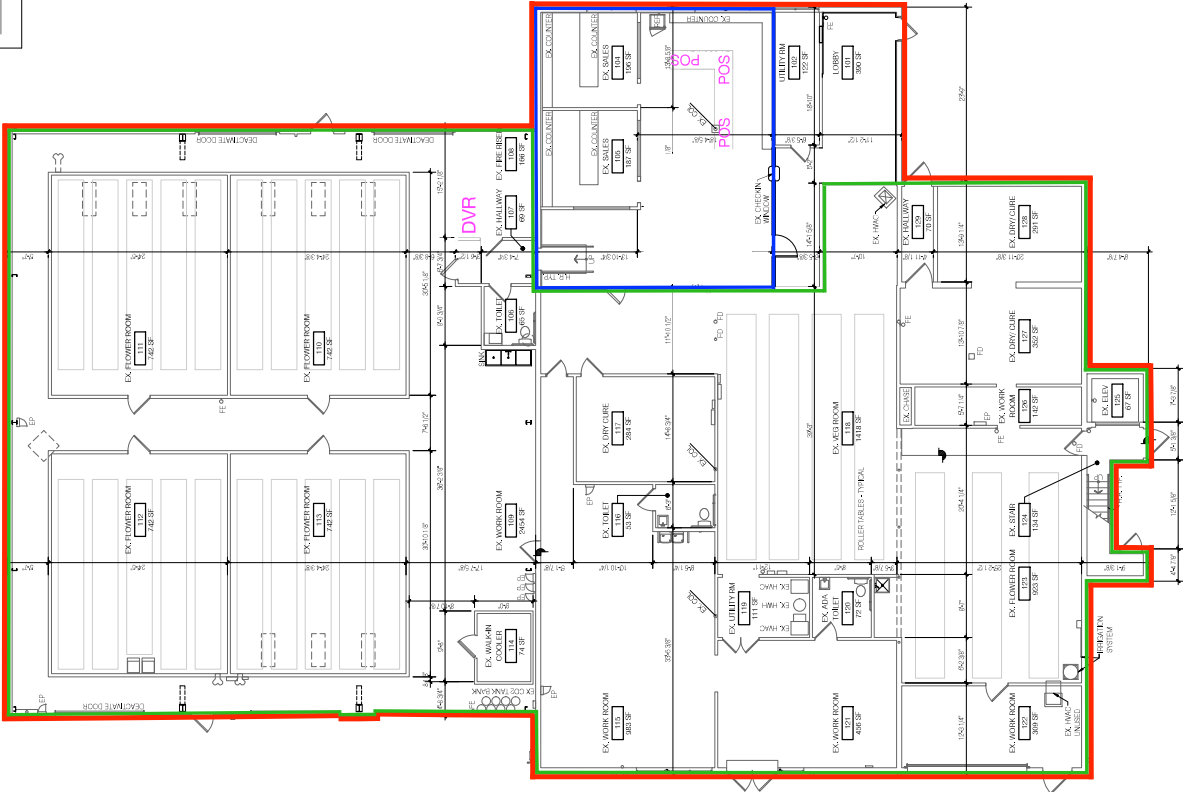


PROPOSED FLOOR PLAN

- Licensed Premise
- Limited Access Area
- Restricted Access Area

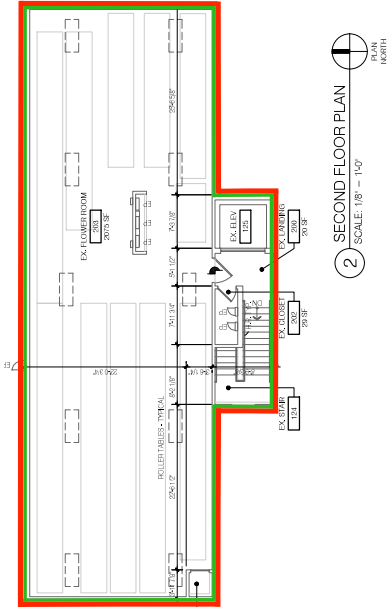

1 FIRST FLOOR PLAN
SCALE: 1/8" = 1'-0"
NORTH

2 SECOND FLOOR PLAN
SCALE: 1/8" = 1'-0"
NORTH

LEGEND

EXISTING DOOR

EXISTING WALL

SK2
ARCHITECTURE

Studio K2 Architecture
1525 Market St., Suite 200
Denver, CO 80202
Phone: 303.534.4480

This document is the property of Studio K2 Architecture and is to be used only for the project and location specified. It is not to be reproduced, copied, or distributed without the written consent of Studio K2 Architecture. The information contained herein is for informational purposes only and does not constitute a contract. The user of this document assumes all liability for its use.

10/20/2021 2:40pm/10/20/2021

CRICECANN, LLC dba CALLIES GARDEN
& CALLIES DENVER
**EXISTING MARIJUANA RETAIL DISPENSARY
& PLANT HUSBANDRY FACILITY**
RECORD DRAWINGS
777 N. CANOSA CT.
DENVER, CO 80204

NO. SHEETS	SUBSHEETS	DATE
USE PERMIT UPDATE	12.23.21	
PROJECT NUMBER	1006	
2019.021.003	12.23.21	
FLOOR PLANS		

DRAWING NUMBER

A100