


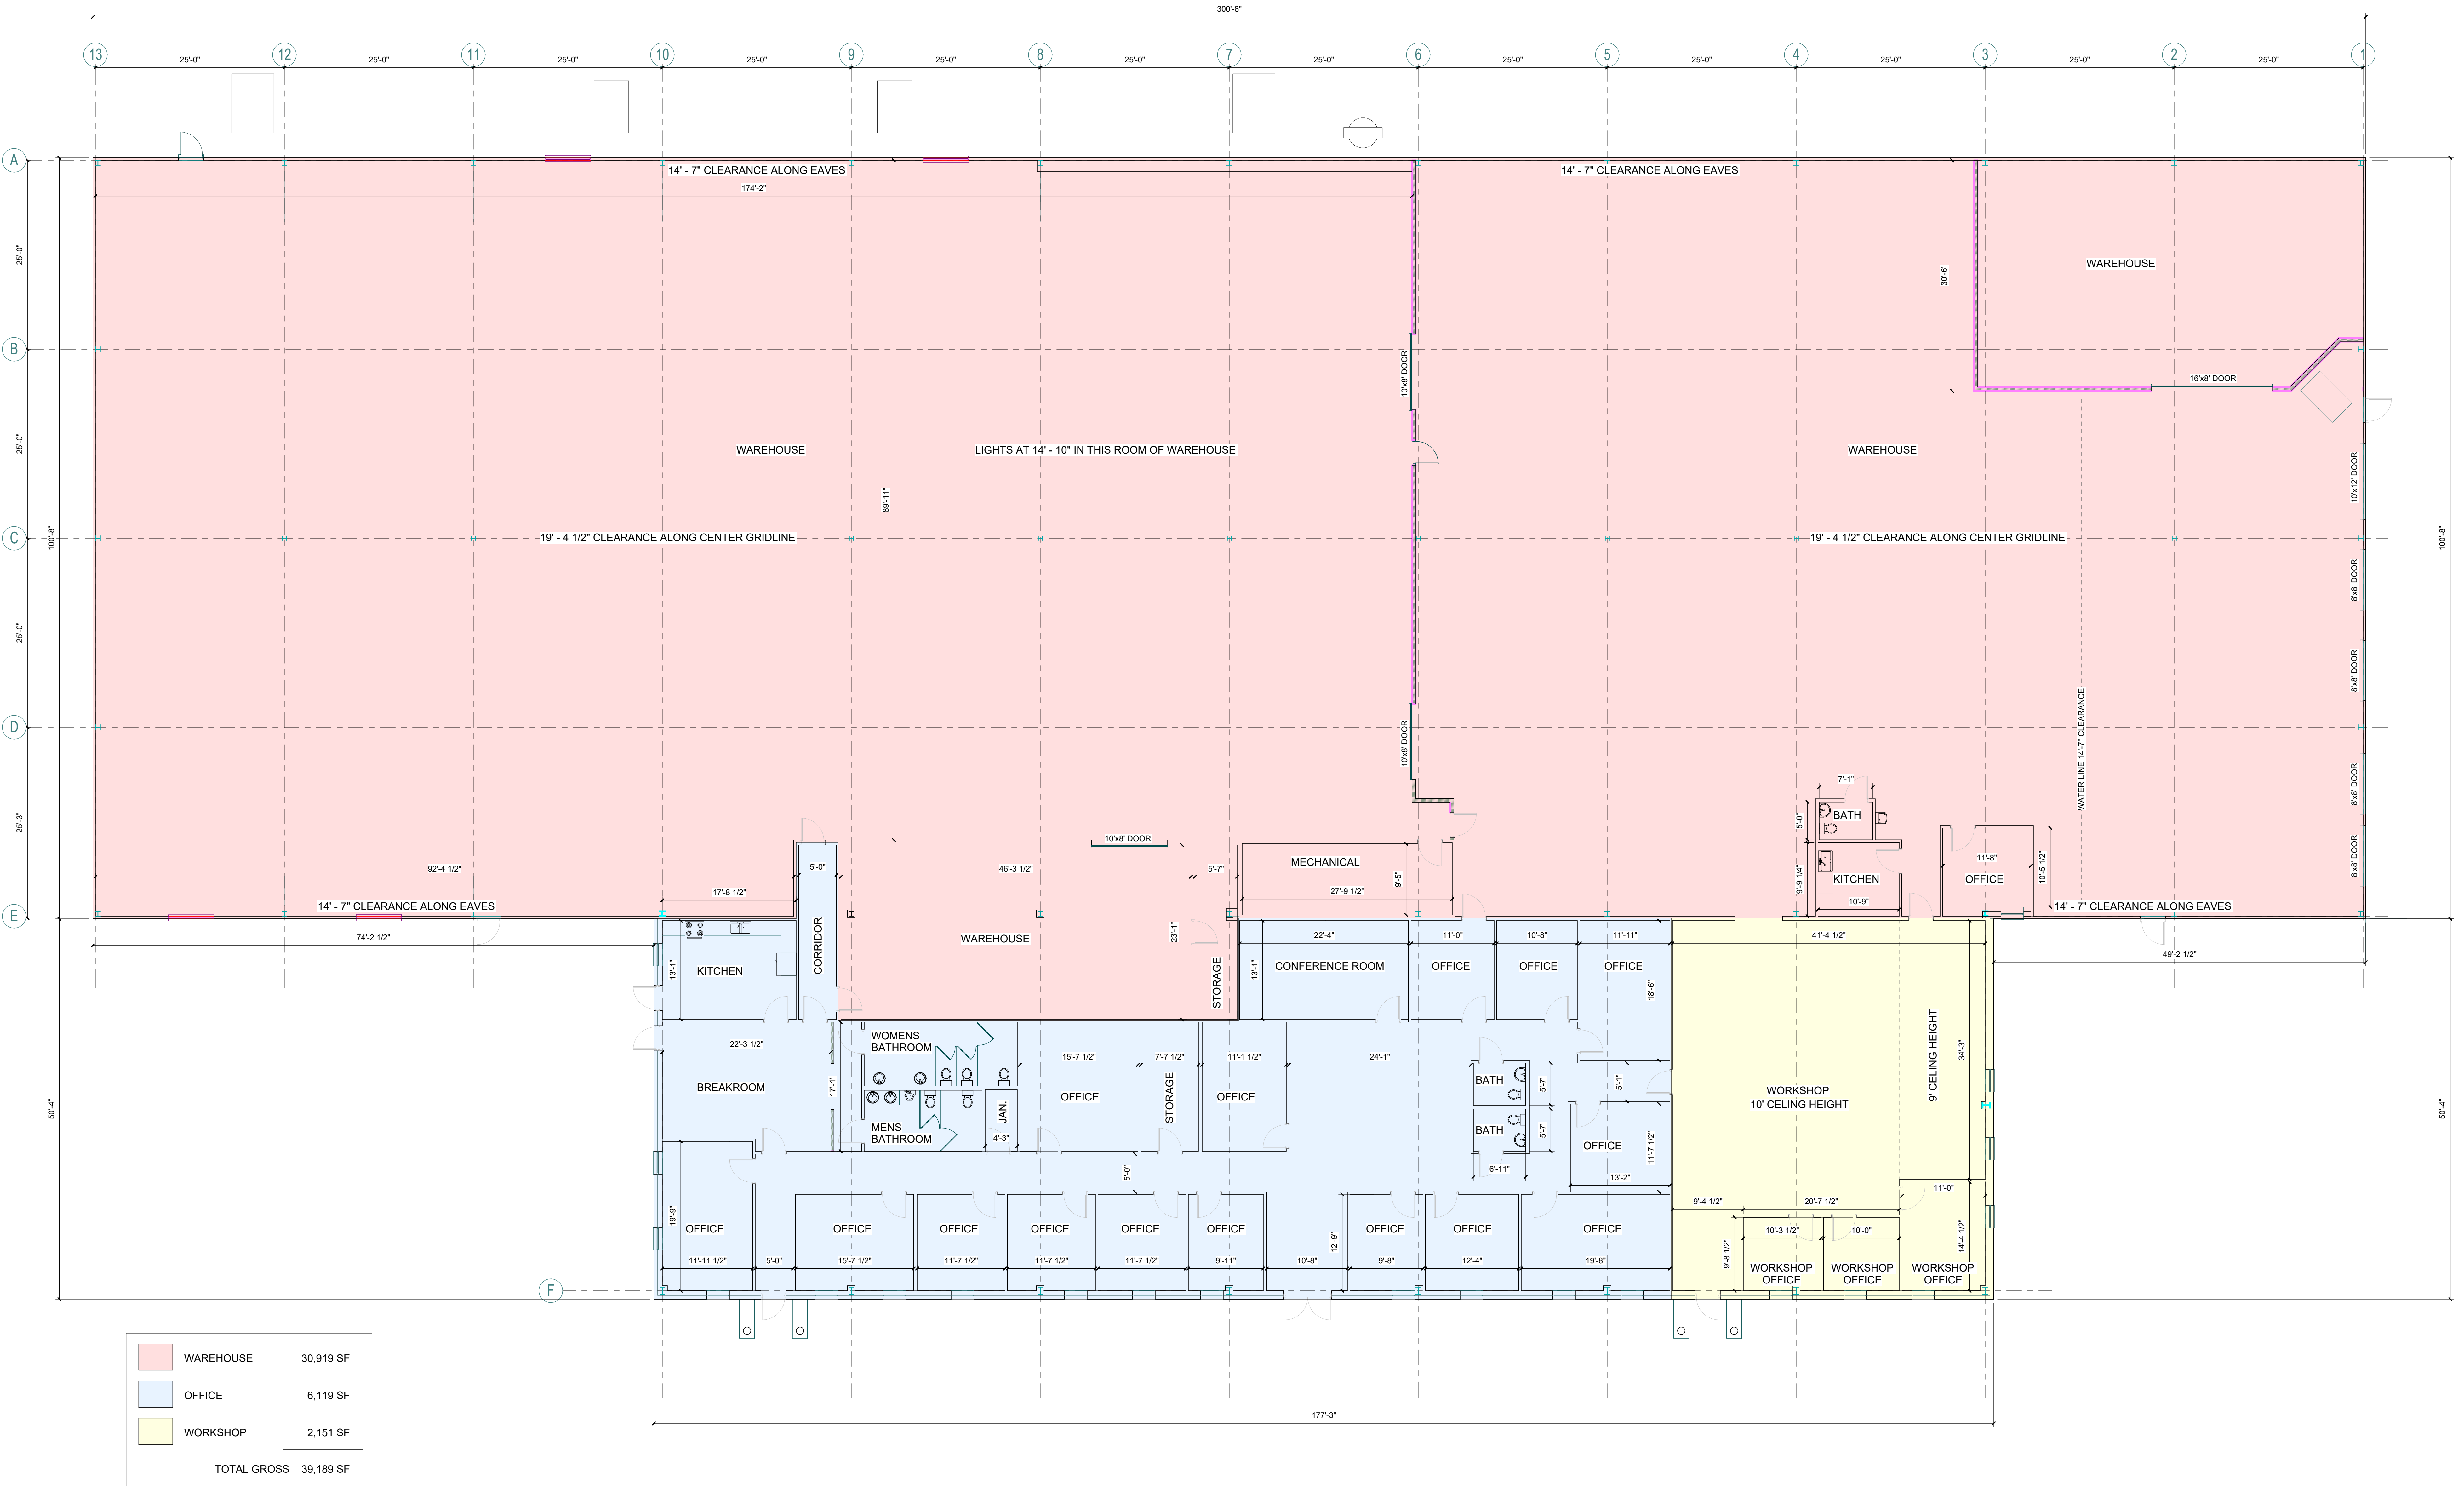

WEISBROOK OFFICE/WAREHOUSE

5900 WEISBROOK LN, KNOXVILLE, TN 37909

AS-BUILTS

1/28/2026 10:43:35 AM

NOT FOR
CONSTRUCTION