
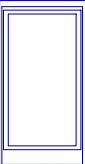


1ST FLOOR EXISTING PLAN

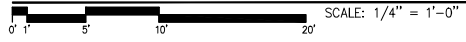

DRAWN BY: JACOB
 CHECKED BY: JACOB
 DATE: 06/04/20
 DRAWN BY: JACOB

886.0000
 285-289 HIGH ST,
 HOLYOKE, MA 01040


AS-BUILT
 DRAWINGS

PROJECT:
 1ST FLOOR
 EXISTING
 PLAN


REVISIONS:
 EX101

SCALE: AS SHOWN

WOMELDORF & ASSOCIATES LLC
 DEVELOPMENT | DESIGN | REAL ESTATE
 14 ELM ST. SUITE 40, WEST SPRINGFIELD, MA 01096

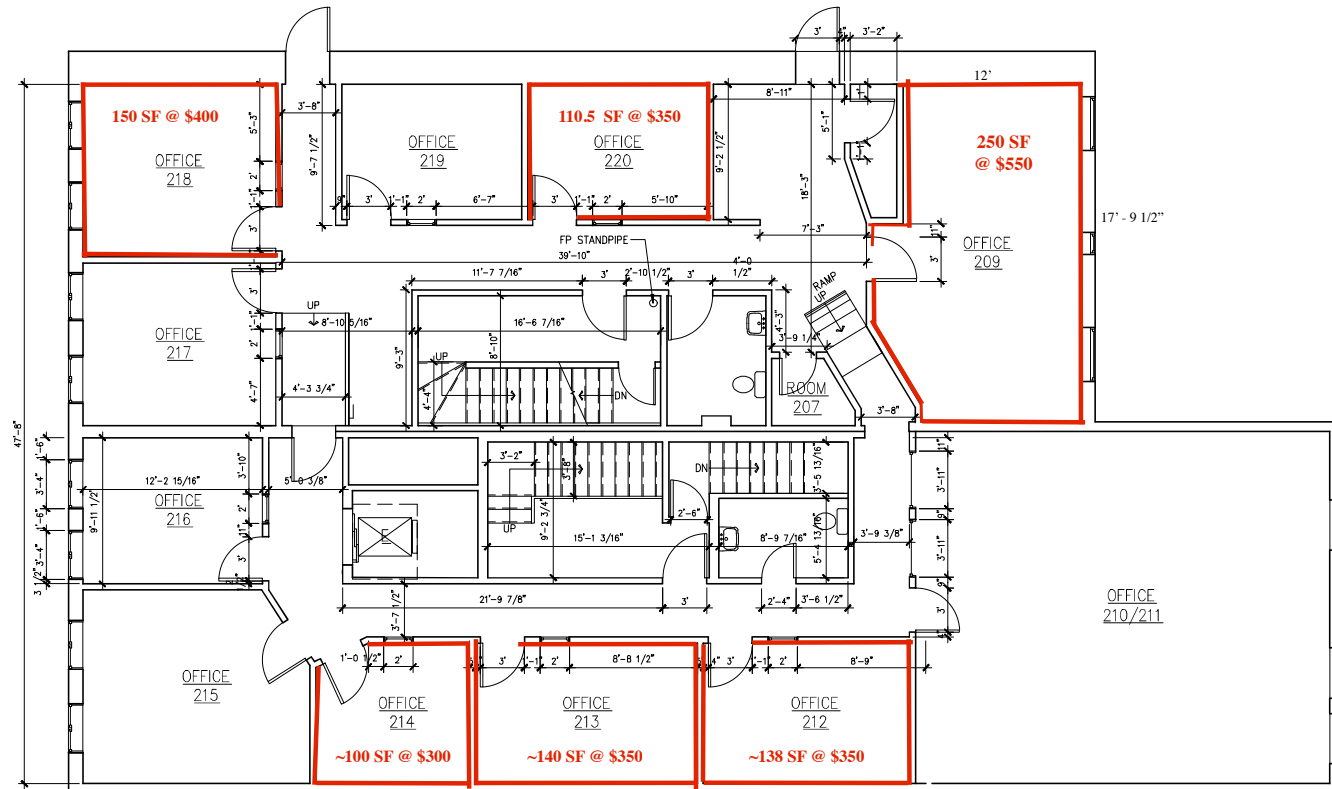

2ND FLOOR EXISTING PLAN

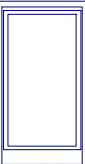

PROJECT NUMBER:
SHEETS:
DATE: 08/08/09
DRAWN BY: MEC

285-289 HIGH ST,
HOLYOKE, MA 01040


AS-BUILT
DRAWINGS

2ND FLOOR
EXISTING
PLAN

EX102


SCALE: AS SHOWN

WOMELDORF & ASSOCIATES LLC
DEVELOPMENT | DESIGN | REAL ESTATE
74 ELM ST. SUITE 60, WEST SPRINGFIELD, MA 01090

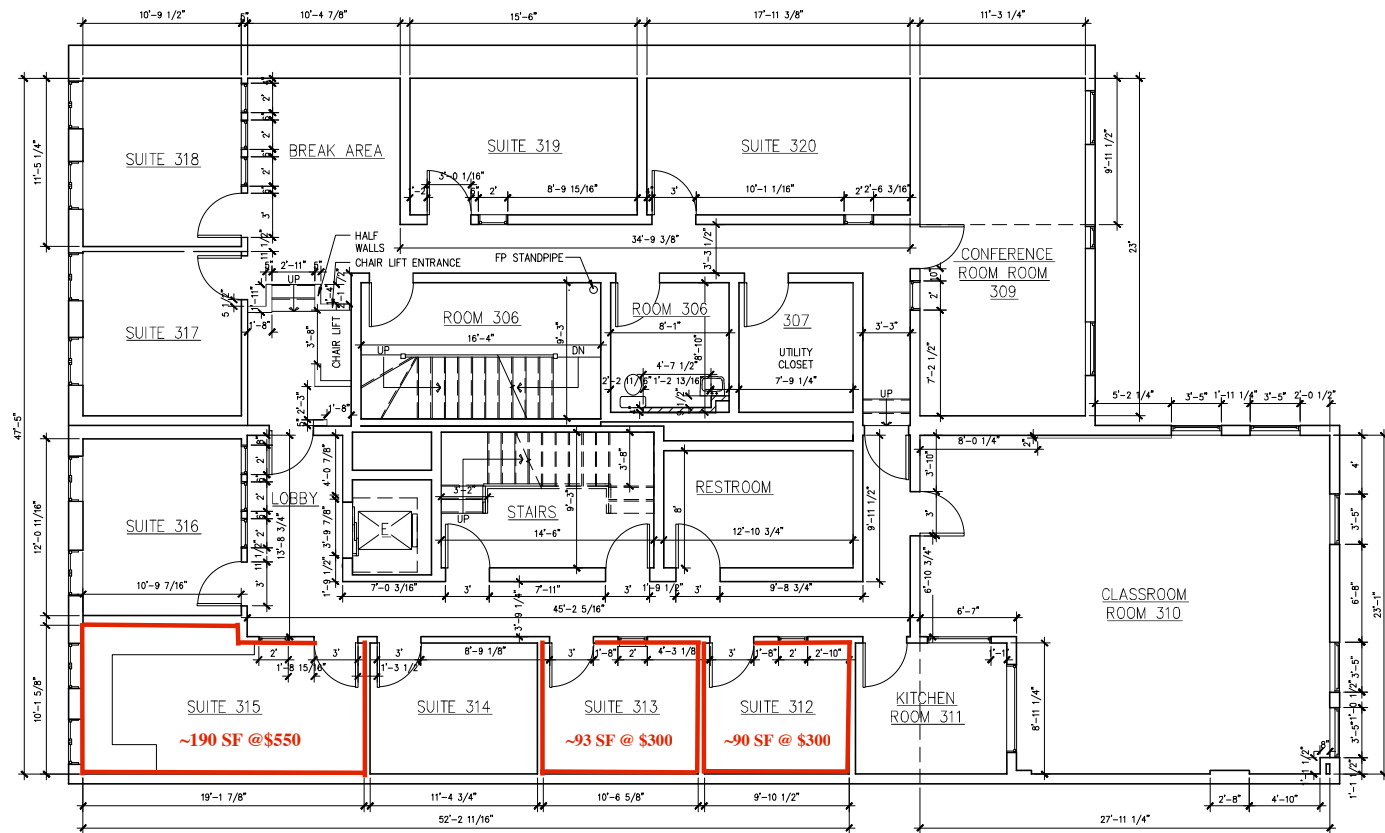

3RD FLOOR EXISTING PLAN

SCALE: 1/4" = 1'-0"

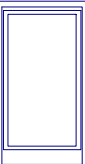

DATE: 08/09/09
DRAWN BY: MEC

PROJECT: 285-289 HIGH ST., HOLYOKE, MA 01040

AS-BUILT DRAWINGS


3RD FLOOR EXISTING PLAN

EX103

SCALE: AS SHOWN


WOMELDORF & ASSOCIATES LLC
DEVELOPMENT | DESIGN | REAL ESTATE
74 ELM ST. SUITE 60, WEST SPRINGFIELD, MA 01090



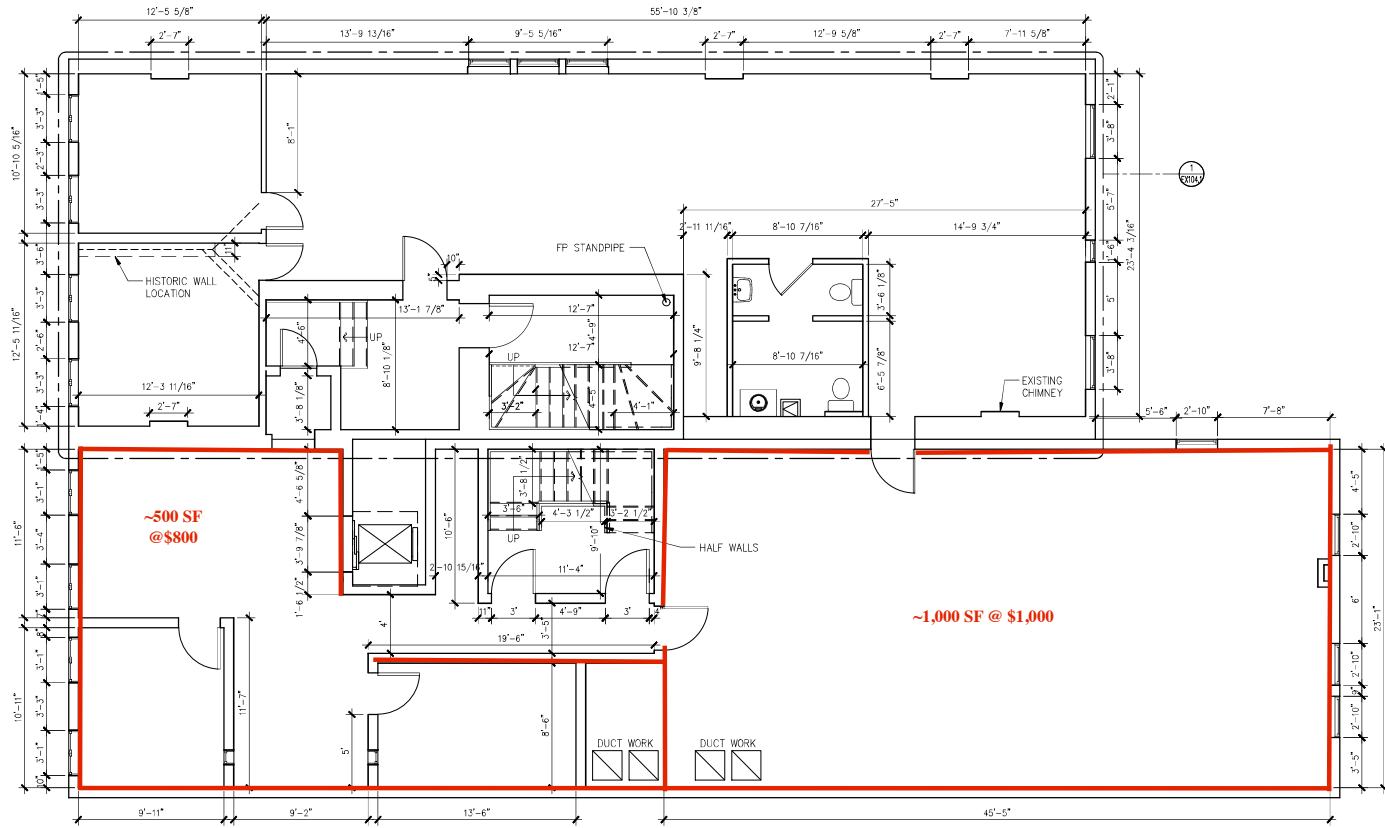

4TH FLOOR EXISTING PLAN

SCALE: 1/4" = 1'-0"

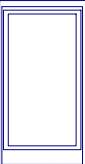

DRAWN BY:
 DATE: 06/04/2019
 DRAWN BY: MIC

285-289 HIGH ST,
 HOLYOKE, MA 01040

AS-BUILT
 DRAWINGS

4TH FLOOR
 EXISTING
 PLAN

EX104

SCALE: AS SHOWN

WOMELDORF & ASSOCIATES LLC
 DEVELOPMENT | DESIGN | REAL ESTATE
 14 ELM ST. SUITE 40, WEST SPRINGFIELD, MA 01096