


5

6

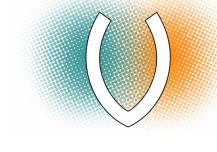

VEN STUDIO, LLC 5909 BERWYN ROAD BERWYN HEIGHTS, MD 20740 Tel: 301.799.2100 www.ven-studio.com

PROFESSIONAL CERTIFICATION
I CERTIFY THAT THESE DOCUMENTS WERE PREPARED OR APPROVED BY ME,
AND THAT I AM A DULY LICENSED ARCHITECT UNDER THE LAWS OF THE
STATE OF MARYLAND, LICENSE NUMBER 18979, EXPIRATION DATE



## WOODFIELD ROAD COMMERCIAL SPACE

18630 WOODFIELD ROAD GAITHERSBURG, MD 20879

# EXISTING OVERALL FLOOR PLAN


VS #2415


DISCLAIMER
THIS DRAWING AND ASSOCIATED DOCUMENTS ARE THE EXCLUSIVE PROPERTY OF VEN STUDIO, LLC, AND ARE NOT TO BE REPRODUCED OR COPIED IN WHOLE OR IN PART, EXCEPT AS REQUIRED FOR THE STATED PROJECT. THEY ARE ONLY TO BE USED FOR THIS PROJECT AND SITE SPECIFICALLY IDENTIFIED HEREIN AND ARE NOT TO BE USED ON ANY OTHER PROJECT WITHOUT WRITTEN CONSENT OF VEN STUDIO. SCALES AS NOTED ON THIS DRAWING ARE VALID ON THE ORIGINAL DRAWING ONLY, THE DIMENSIONS OF WHICH ARE 30 x 42 INCHES.

DATE REVISION

AR100

DOCUMENTATION 9/13/2024

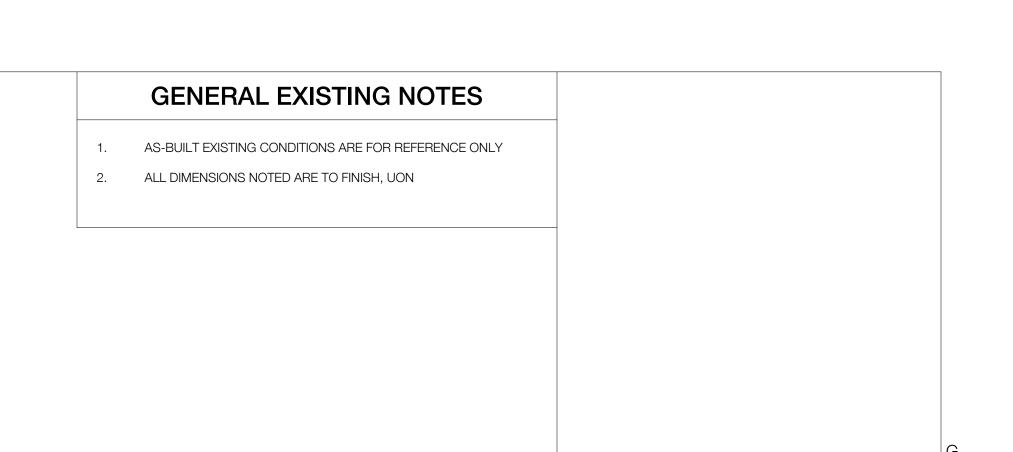

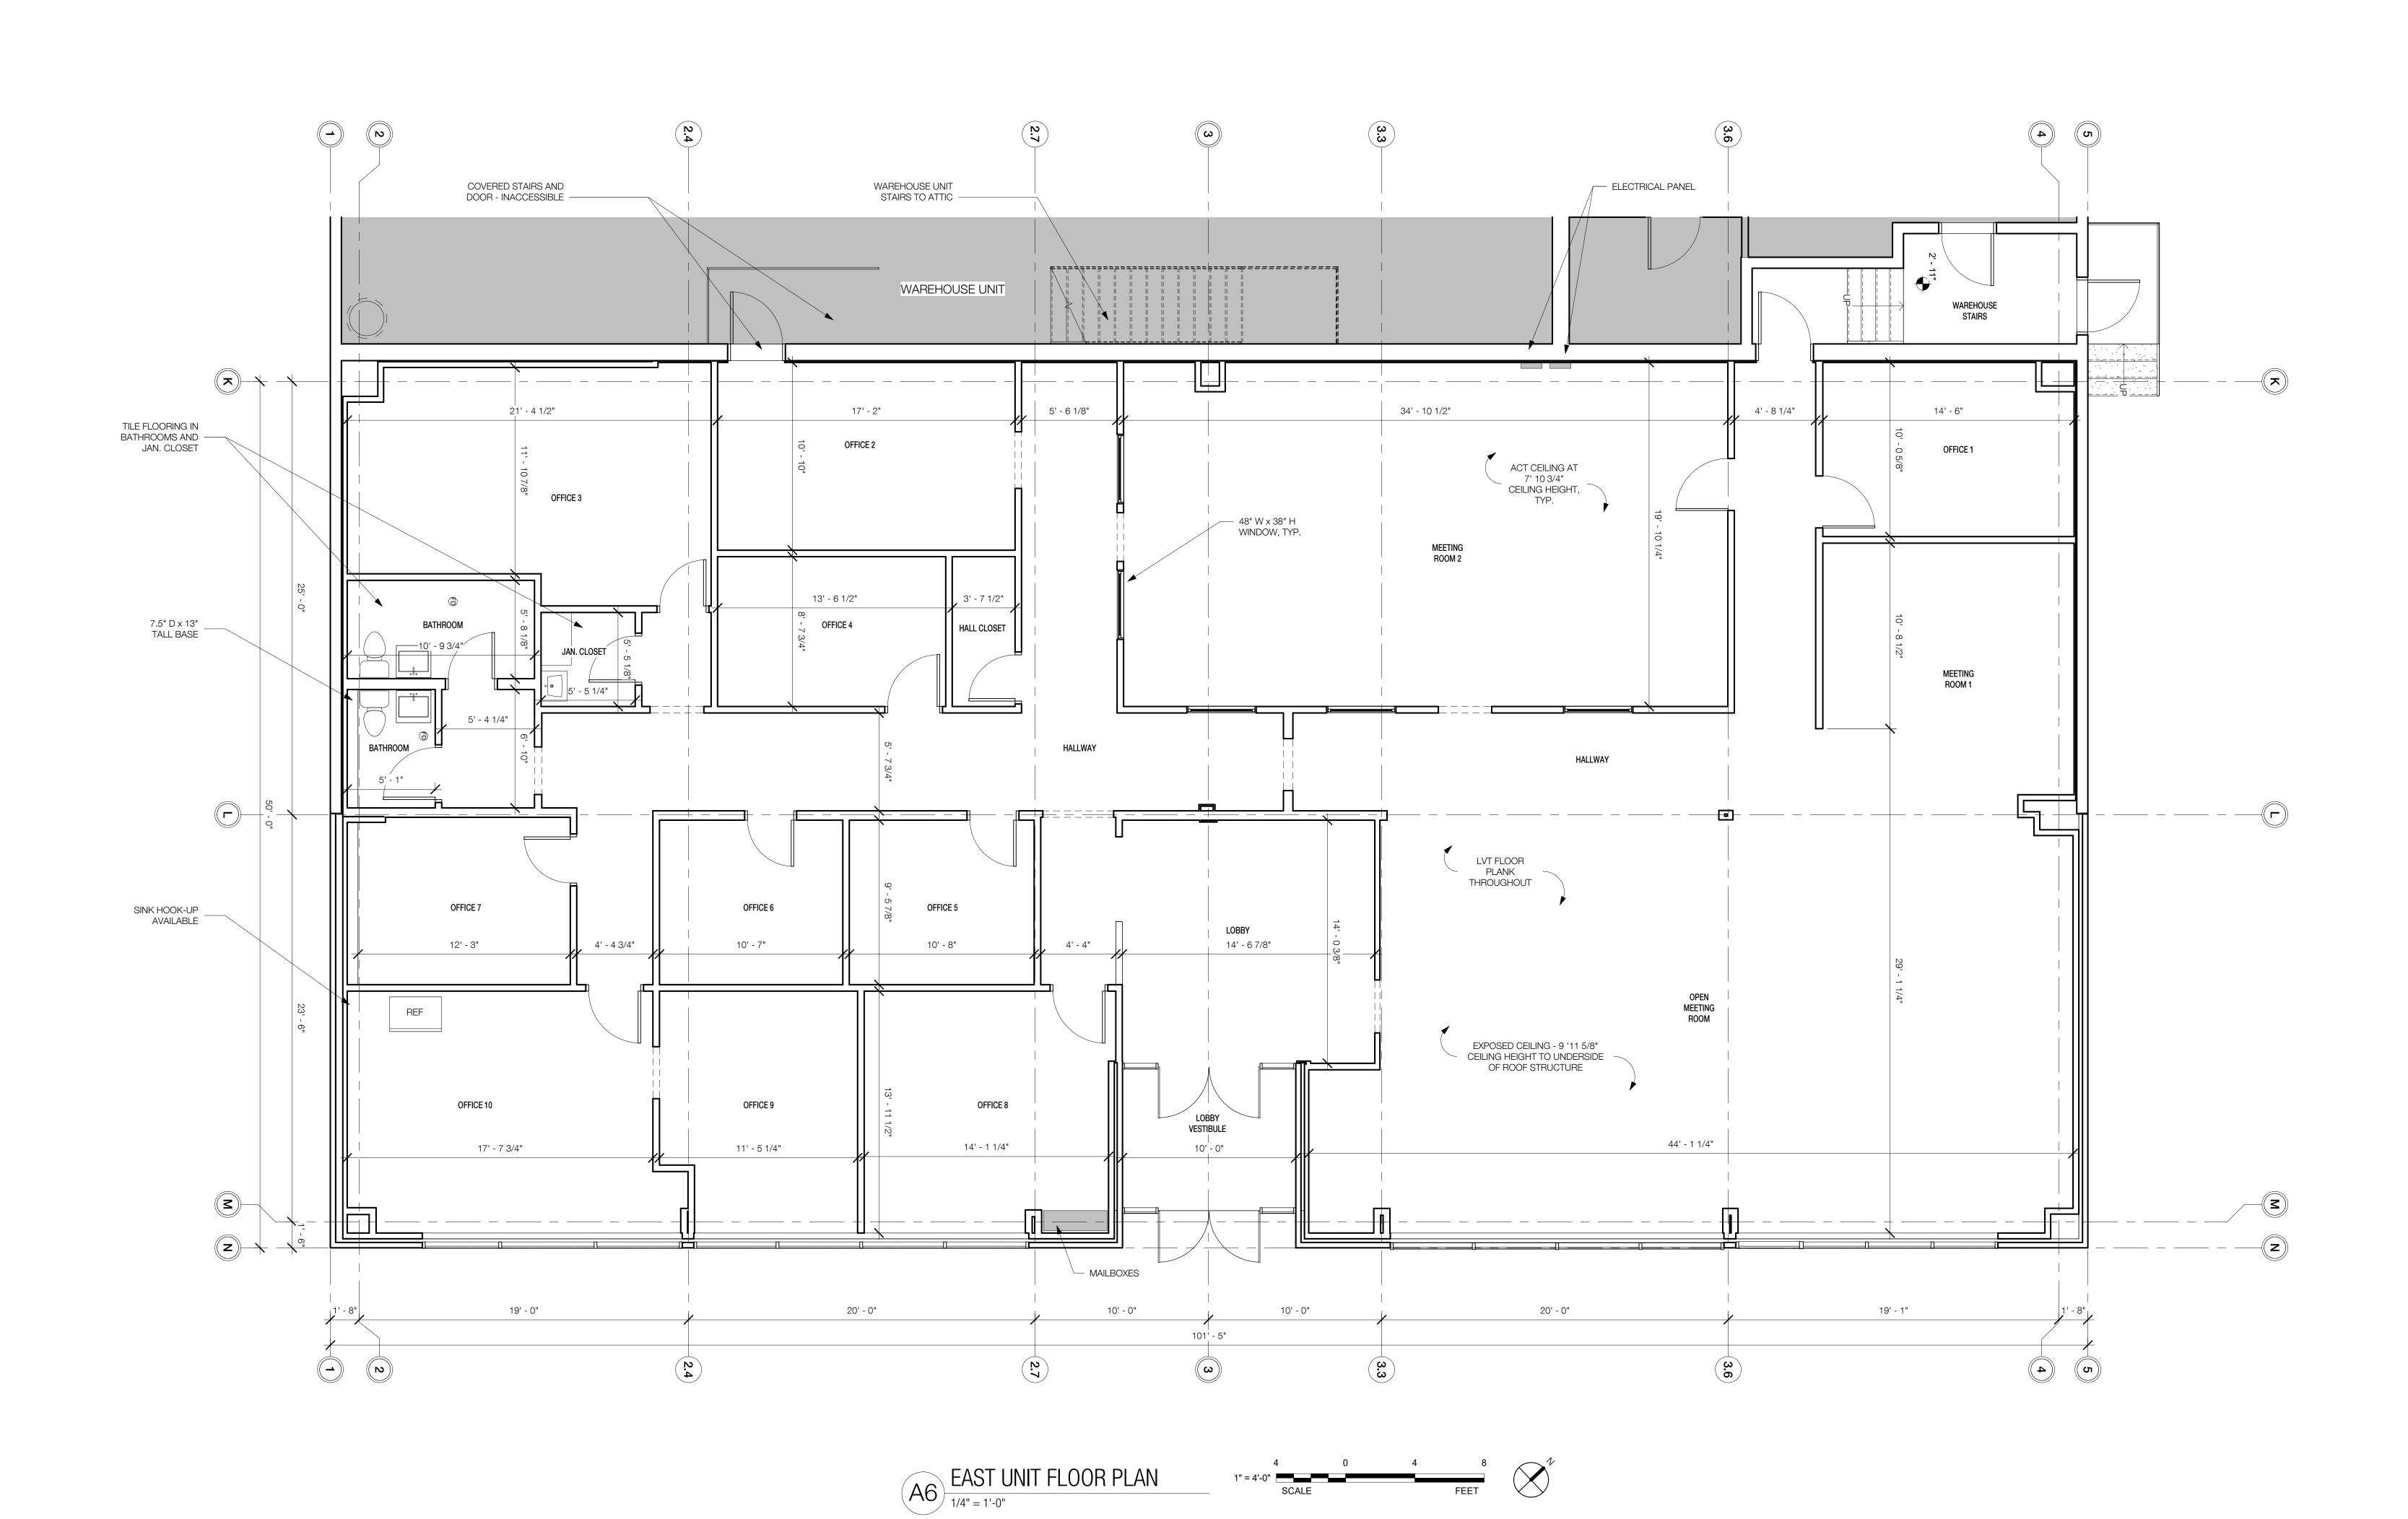

5

6



www.ven-studio.com

PROFESSIONAL CERTIFICATION

I CERTIFY THAT THESE DOCUMENTS WERE PREPARED OR APPROVED BY ME,
AND THAT I AM A DULY LICENSED ARCHITECT UNDER THE LAWS OF THE
STATE OF MARYLAND, LICENSE NUMBER 18979, EXPIRATION DATE

04/23/2025.



## WOODFIELD ROAD COMMERCIAL SPACE

18630 WOODFIELD ROAD GAITHERSBURG, MD 20879

### EAST UNIT - FLOOR PLAN

VS #2415


DISCLAIMER
THIS DRAWING AND ASSOCIATED DOCUMENTS ARE THE EXCLUSIVE PROPERTY OF VEN STUDIO, LLC, AND ARE NOT TO BE REPRODUCED OR COPIED IN WHOLE OR IN PART, EXCEPT AS REQUIRED FOR THE STATED PROJECT. THEY ARE ONLY TO BE USED FOR THIS PROJECT AND SITE SPECIFICALLY IDENTIFIED HEREIN AND ARE NOT TO BE USED ON ANY OTHER PROJECT WITHOUT WRITTEN CONSENT OF VEN STUDIO. SCALES AS NOTED ON THIS DRAWING ARE VALID ON THE ORIGINAL DRAWING ONLY, THE DIMENSIONS OF WHICH ARE 30 x 42 INCHES.

DATE REVISION

AR101

DOCUMENTATION 9/13/2024

Occupant Load Calculations - East Unit									
AREA NAME	AREA (SF)	AREA PER OCCUPANT (SF)	GROSS OR NET	OCCUPANCY LOAD	Occupancy Type	EGRESS WIDTH REQ'D (*0.2")			
ASSEMBLY (HUDDLE	E/TEAM ROOM	)							
MEETING ROOM 1	246 SF	50 SF	NET	5	ASSEMBLY (HUDDLE/TEAM ROOM)	1.1			
MEETING ROOM 2	727 SF	50 SF	NET	15	ASSEMBLY (HUDDLE/TEAM ROOM)	3.0			
ASSEMBLY (UN-CON	JCENTRATED)								
LOBBY	263 SF	15 SF	NET	18	ASSEMBLY (UN-CONCENTRATED)	3.6			
OPEN MEETING AREA	1069 SF	15 SF	NET	72	ASSEMBLY (UN-CONCENTRATED)	14.4			
BUSINESS AREAS									
OFFICE 1	168 SF	150 SF	GROSS	2	BUSINESS AREAS	0.3			
OFFICE 2	204 SF	150 SF	GROSS	2	BUSINESS AREAS	0.4			
OFFICE 3	306 SF	150 SF	GROSS	3	BUSINESS AREAS	0.5			
OFFICE 4	122 SF	150 SF	GROSS	1	BUSINESS AREAS	0.3			
OFFICE 5	110 SF	150 SF	GROSS	1	BUSINESS AREAS	0.2			
OFFICE 6	109 SF	150 SF	GROSS	1	BUSINESS AREAS	0.2			
OFFICE 7	142 SF	150 SF	GROSS	1	BUSINESS AREAS	0.3			
OFFICE 8	224 SF	150 SF	GROSS	2	BUSINESS AREAS	0.4			
OFFICE 9	168 SF	150 SF	GROSS	2	BUSINESS AREAS	0.3			
OFFICE 10	291 SF	150 SF	GROSS	2	BUSINESS AREAS	0.5			
CIRCULATION									
HALLWAY	792 SF	0 SF			CIRCULATION				
LOBBY VESTIBULE	90 SF	0 SF			CIRCULATION				
		1 7 2.			1	1			
STORAGE / MECH U	T .	200 05	00000		OTODAGE /AMEGUA	0.1			
HALL CLOSET	36 SF	300 SF	GROSS	1	STORAGE / MECH UNOCCUPIED	0.1			
JAN. CLOSET	34 SF	300 SF	GROSS	1	STORAGE / MECH	0.1			

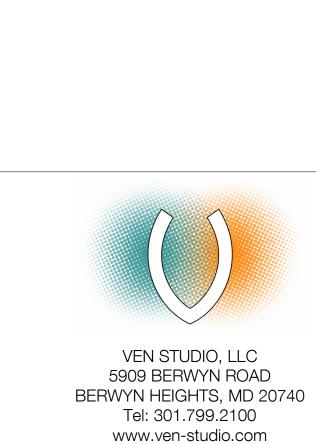

PROFESSIONAL CERTIFICATION
I CERTIFY THAT THESE DOCUMENTS WERE PREPARED OR APPROVED BY ME,
AND THAT I AM A DULY LICENSED ARCHITECT UNDER THE LAWS OF THE
STATE OF MARYLAND, LICENSE NUMBER 18979, EXPIRATION DATE
04/23/2025



# WOODFIELD ROAD COMMERCIAL SPACE

18630 WOODFIELD ROAD GAITHERSBURG, MD 20879

# EAST UNIT -OCCUPANCY PLAN

VS #2415

DISCLAIMER
THIS DRAWING AND ASSOCIATED DOCUMENTS ARE THE EXCLUSIVE PROPERTY OF VEN STUDIO, LLC, AND ARE NOT TO BE REPRODUCED OR COPIED IN WHOLE OR IN PART, EXCEPT AS REQUIRED FOR THE STATED PROJECT. THEY ARE ONLY TO BE USED FOR THIS PROJECT AND SITE SPECIFICALLY IDENTIFIED HEREIN AND ARE NOT TO BE USED ON ANY OTHER PROJECT WITHOUT WRITTEN CONSENT OF VEN STUDIO. SCALES AS NOTED ON THIS DRAWING ARE VALID ON THE ORIGINAL DRAWING ONLY, THE DIMENSIONS OF WHICH ARE 30 x 42 INCHES.

DATE REVISION

AR102


DOCUMENTATION 9/13/2024

© VEN STUDIO, LLC.





6

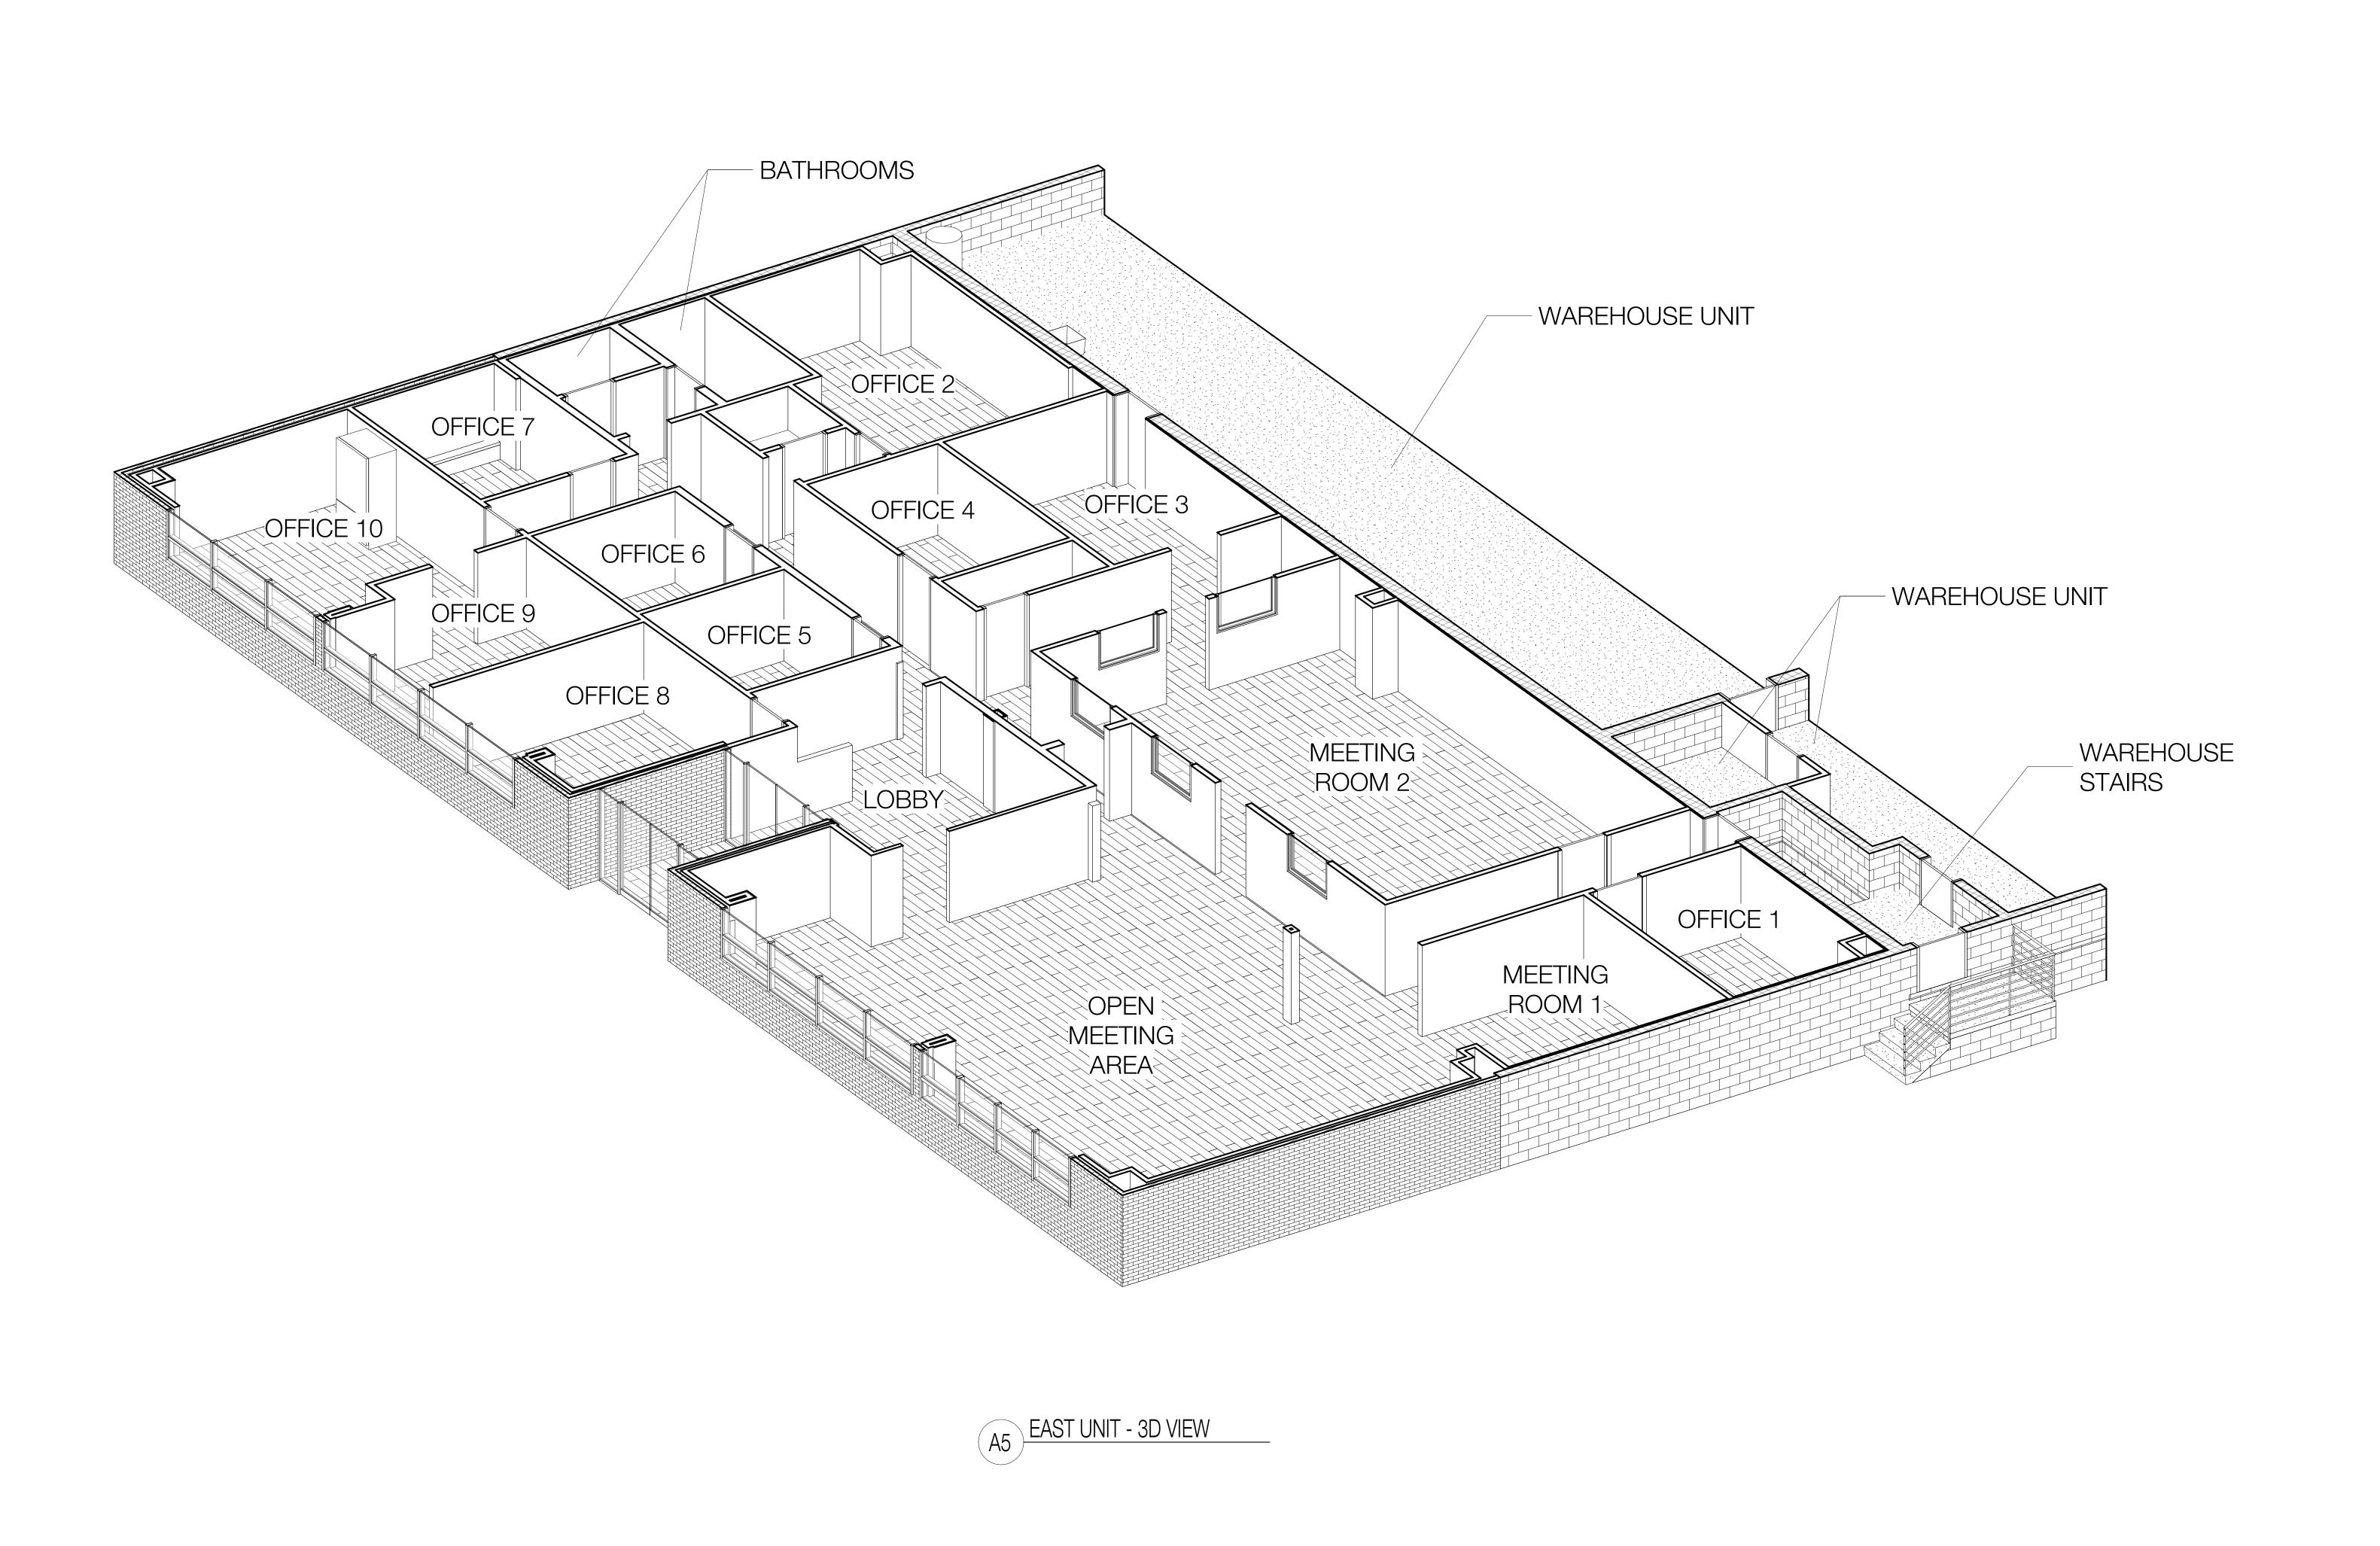



PROFESSIONAL CERTIFICATION
I CERTIFY THAT THESE DOCUMENTS WERE PREPARED OR APPROVED BY ME,
AND THAT I AM A DULY LICENSED ARCHITECT UNDER THE LAWS OF THE
STATE OF MARYLAND, LICENSE NUMBER 18979, EXPIRATION DATE



## WOODFIELD ROAD COMMERCIAL SPACE

18630 WOODFIELD ROAD GAITHERSBURG, MD 20879

EAST UNIT - 3D VIEW

VS #2415

DISCLAIMER
THIS DRAWING AND ASSOCIATED DOCUMENTS ARE THE EXCLUSIVE PROPERTY OF VEN STUDIO, LLC, AND ARE NOT TO BE REPRODUCED OR COPIED IN WHOLE OR IN PART, EXCEPT AS REQUIRED FOR THE STATED PROJECT. THEY ARE ONLY TO BE USED FOR THIS PROJECT AND SITE SPECIFICALLY IDENTIFIED HEREIN AND ARE NOT TO BE USED ON ANY OTHER PROJECT WITHOUT WRITTEN CONSENT OF VEN STUDIO. SCALES AS NOTED ON THIS DRAWING ARE VALID ON THE ORIGINAL DRAWING ONLY, THE DIMENSIONS OF WHICH ARE 30 x 42 INCHES.


DATE REVISION

AR103

DOCUMENTATION 9/13/2024



- AS-BUILT EXISTING CONDITIONS ARE FOR REFERENCE ONLY
- 2. ALL DIMENSIONS NOTED ARE TO FINISH, UON

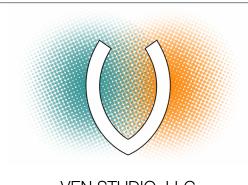

PROFESSIONAL CERTIFICATION
I CERTIFY THAT THESE DOCUMENTS WERE PREPARED OR APPROVED BY ME,
AND THAT I AM A DULY LICENSED ARCHITECT UNDER THE LAWS OF THE
STATE OF MARYLAND, LICENSE NUMBER 18979, EXPIRATION DATE
04/23/2025.



## WOODFIELD ROAD COMMERCIAL SPACE

18630 WOODFIELD ROAD GAITHERSBURG, MD 20879

## WEST UNIT FLOOR PLAN


VS #2415

DISCLAIMER
THIS DRAWING AND ASSOCIATED DOCUMENTS ARE THE EXCLUSIVE PROPERTY OF VEN STUDIO, LLC, AND ARE NOT TO BE REPRODUCED OR COPIED IN WHOLE OR IN PART, EXCEPT AS REQUIRED FOR THE STATED PROJECT. THEY ARE ONLY TO BE USED FOR THIS PROJECT AND SITE SPECIFICALLY IDENTIFIED HEREIN AND ARE NOT TO BE USED ON ANY OTHER PROJECT WITHOUT WRITTEN CONSENT OF VEN STUDIO. SCALES AS NOTED ON THIS DRAWING ARE VALID ON THE ORIGINAL DRAWING ONLY, THE DIMENSIONS OF WHICH ARE 30 x 42 INCHES.


DATE REVISION

AR104

DOCUMENTATION 9/13/2024

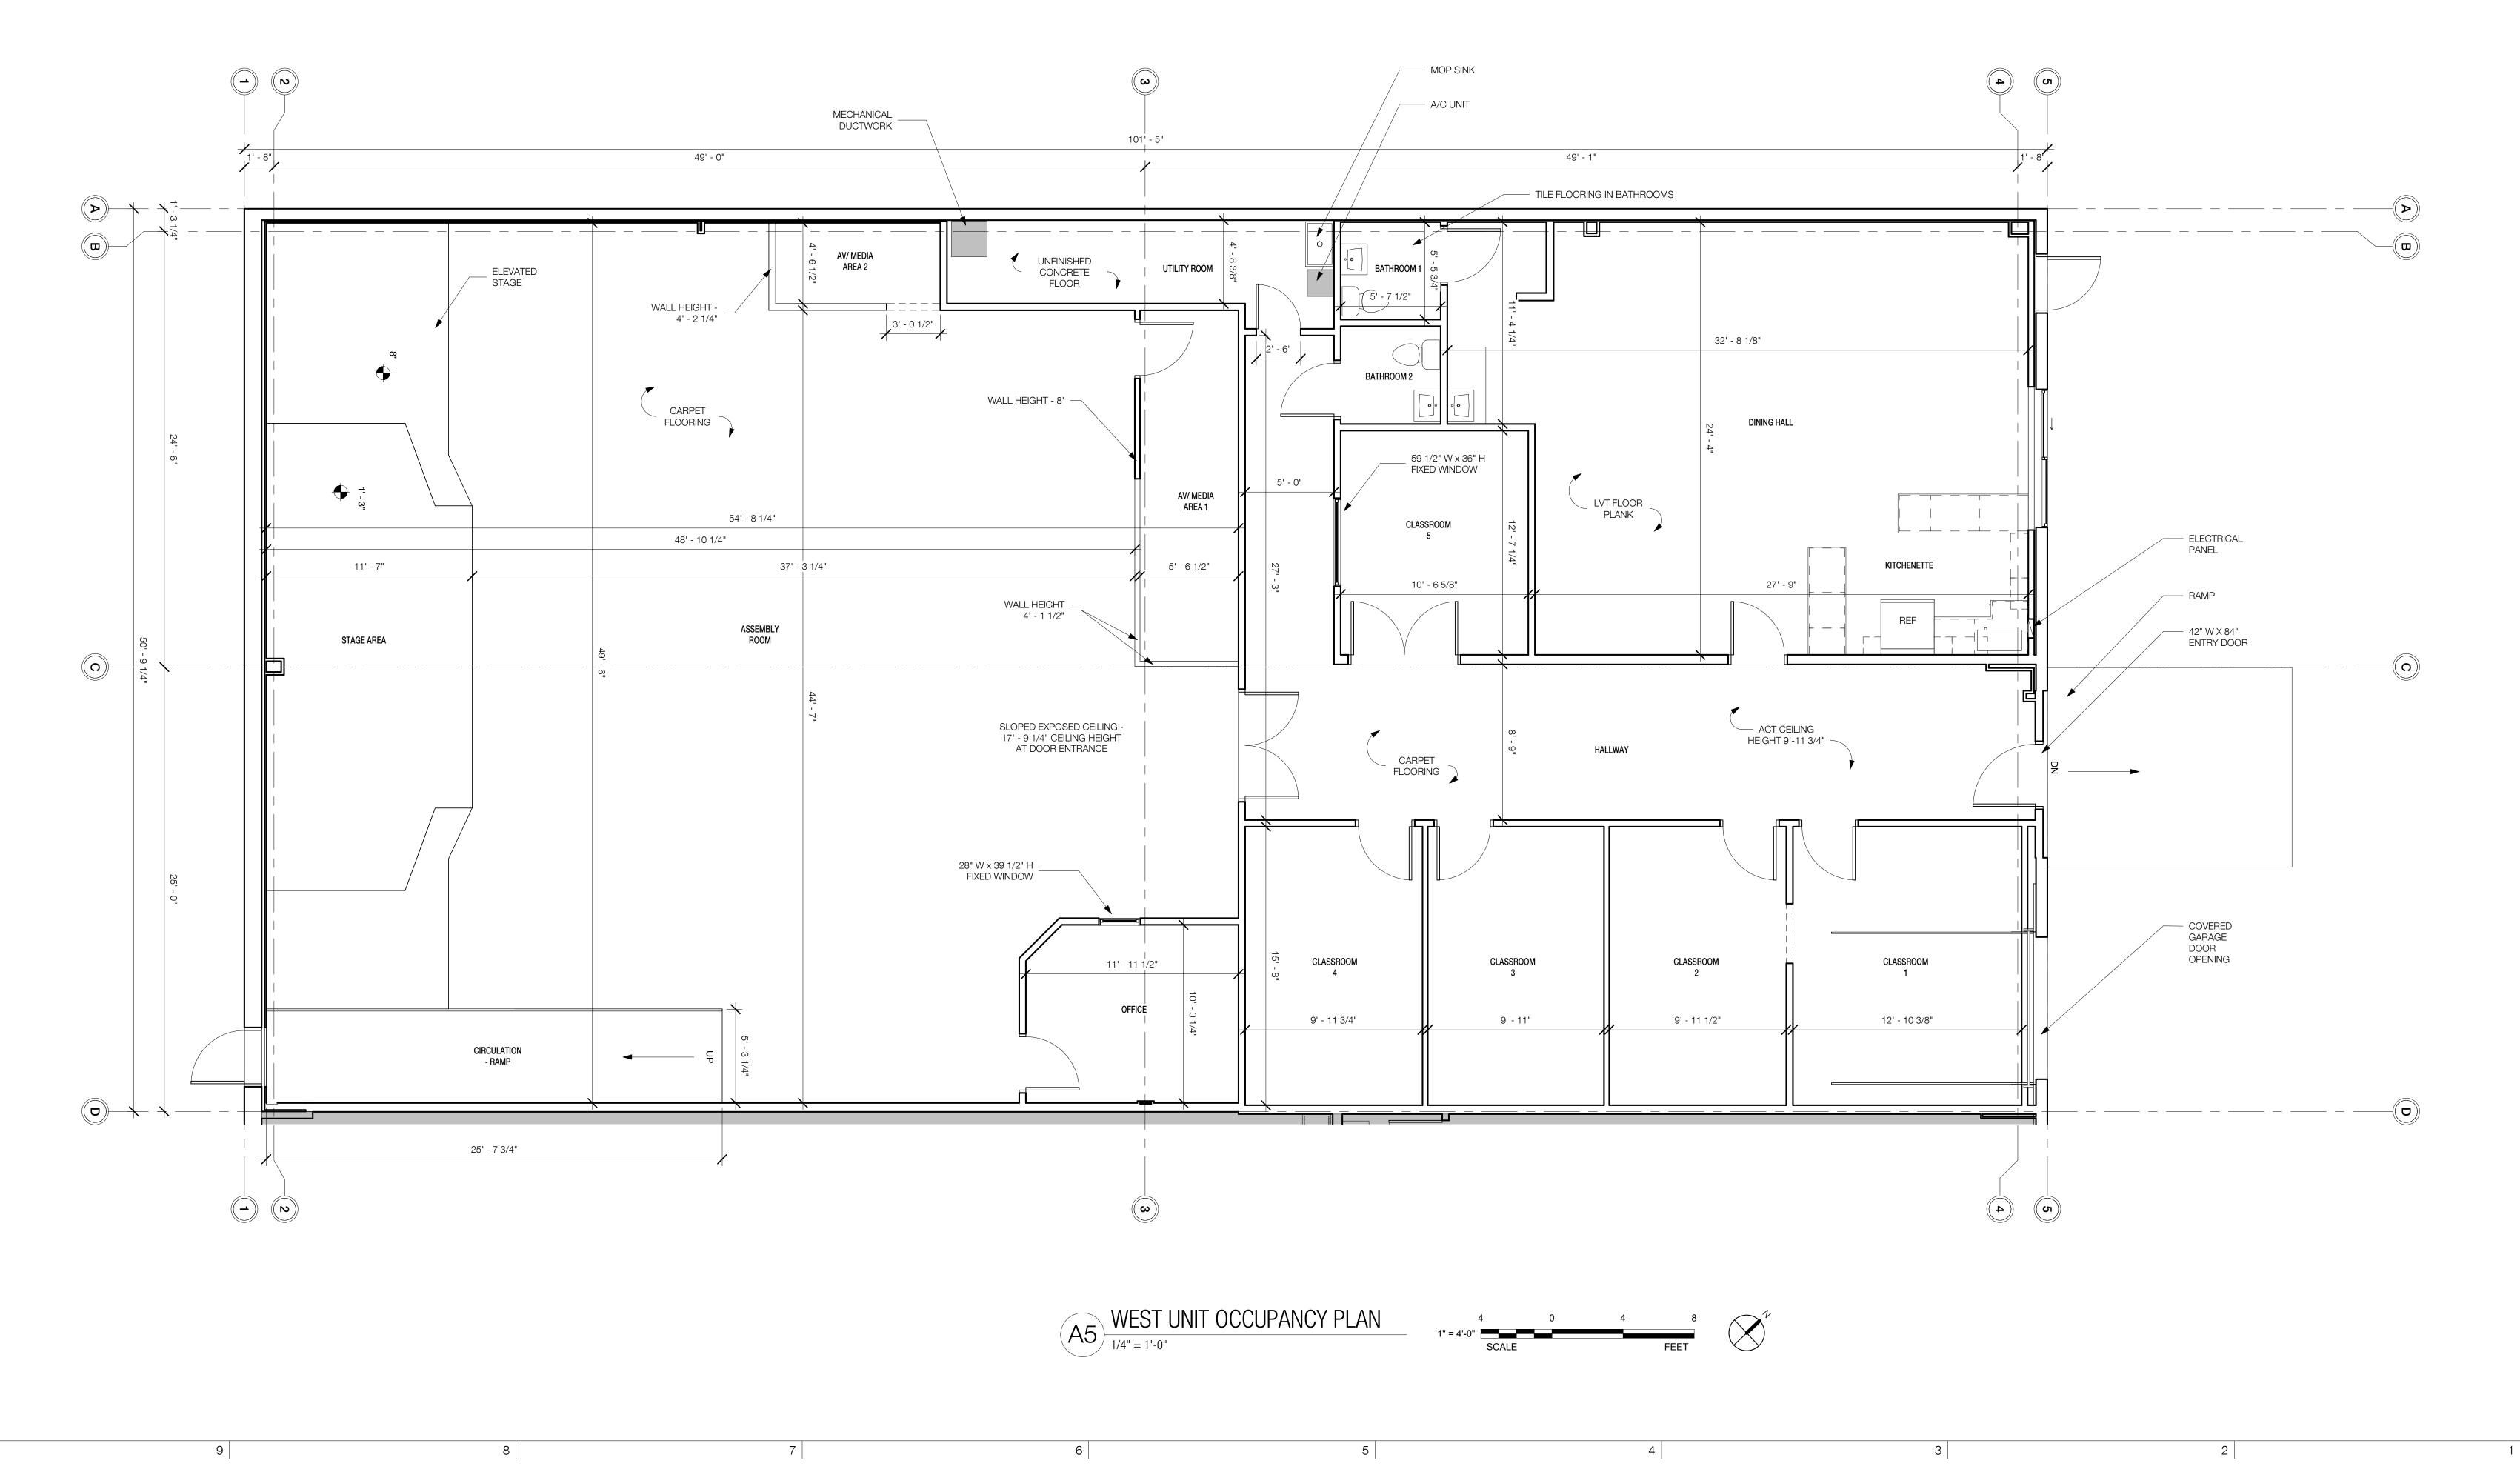


AREA NAME	AREA (SF)	AREA PER OCCUPANT (SF)	GROSS OR NET	OCCUPANCY LOAD	EGRESS WIDTH REQ'D (*0.2")
ACCESSORY STORAGE / I	MECHANICAL EOL	IIPMENIT			
AV/MEDIA AREA 1	118 SF	300 SF	GROSS	1	0.2
AV/MEDIA AREA 2	53 SF	300 SF	GROSS	<u>·</u> 1	0.1
ASSEMBLY (CONCENTRA	TED)				
ASSEMBLY ROOM	1753 SF	7 SF	NET	251	50.2
ASSEMBLY (UN-CONCENT	TRATEN)				
DINING HALL	671 SF	15 SF	NET	45	9.0
BUSINESS AREAS					
OFFICE	127 SF	150 SF	GROSS	1	0.3
CIRCULATION					
CIRCULATION - RAMP	149 SF	0 SF			
HALLWAY	516 SF	0 SF			
EDUCATION (CLASSROOM	MS)				
CLASSROOM 1	234 SF	20 SF	NET	12	2.4
CLASSROOM 2	166 SF	20 SF	NET	9	1.8
CLASSROOM 3	164 SF	20 SF	NET	9	1.7
CLASSROOM 4	166 SF	20 SF	NET	9	1.8
CLASSROOM 5	143 SF	20 SF	NET	8	1.5
KITCHEN	1.5-5-		1 05		
KITCHENETTE	125 SF	100 SF	GROSS	2	0.4
STAGES AND PLATFORMS	3				
STAGE AREA	543 SF	15 SF	NET	37	7.3
STORAGE / MECH UNOCO	CUPIFD				
UTILITY ROOM	130 SF	300 SF	GROSS	1	0.2
Grand total	5058 SF	1	1	385	76.9

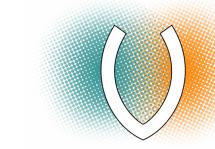

PROFESSIONAL CERTIFICATION
I CERTIFY THAT THESE DOCUMENTS WERE PREPARED OR APPROVED BY ME,
AND THAT I AM A DULY LICENSED ARCHITECT UNDER THE LAWS OF THE
STATE OF MARYLAND, LICENSE NUMBER 18979, EXPIRATION DATE



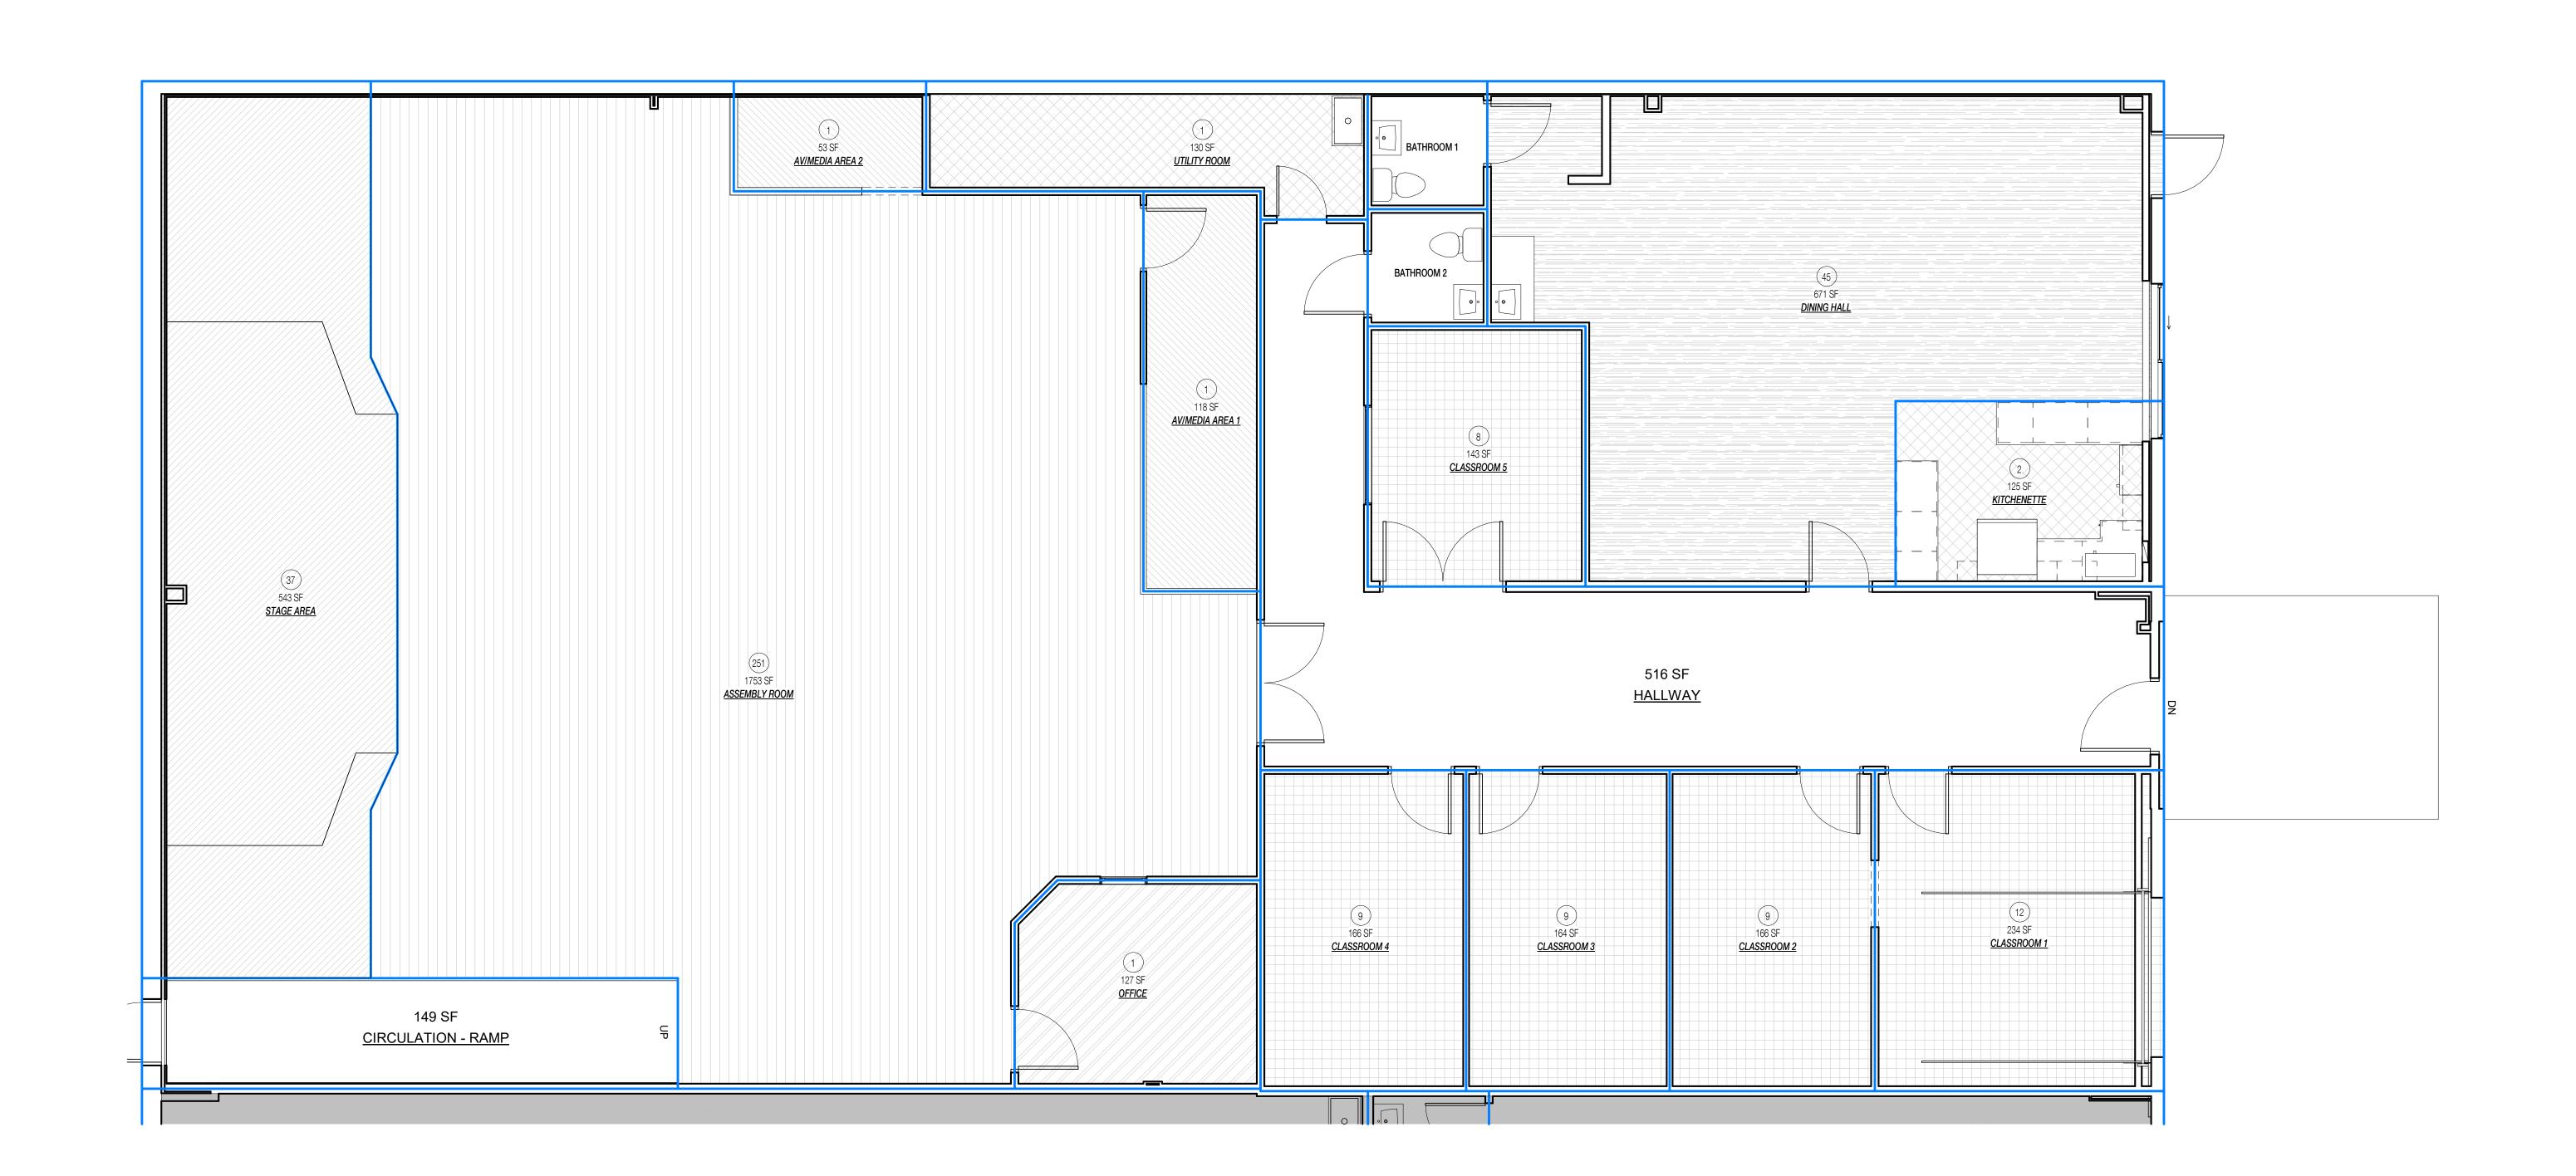

# WOODFIELD ROAD COMMERCIAL SPACE

18630 WOODFIELD ROAD GAITHERSBURG, MD 20879

## WEST UNIT OCCUPANCY PLAN

VS #2415

DISCLAIMER
THIS DRAWING AND ASSOCIATED DOCUMENTS ARE THE EXCLUSIVE PROPERTY OF VEN STUDIO, LLC, AND ARE NOT TO BE REPRODUCED OR COPIED IN WHOLE OR IN PART, EXCEPT AS REQUIRED FOR THE STATED PROJECT. THEY ARE ONLY TO BE USED FOR THIS PROJECT AND SITE SPECIFICALLY IDENTIFIED HEREIN AND ARE NOT TO BE USED ON ANY OTHER PROJECT WITHOUT WRITTEN CONSENT OF VEN STUDIO. SCALES AS NOTED ON THIS DRAWING ARE VALID ON THE ORIGINAL DRAWING ONLY, THE DIMENSIONS OF WHICH ARE 30 x 42 INCHES.

DATE REVISION

AR105


DOCUMENTATION 9/13/2024


© VEN STUDIO, LLC.

WEST UNIT OCCUPANCY PLAN

1/4" = 1'-0"

8 7 5 2

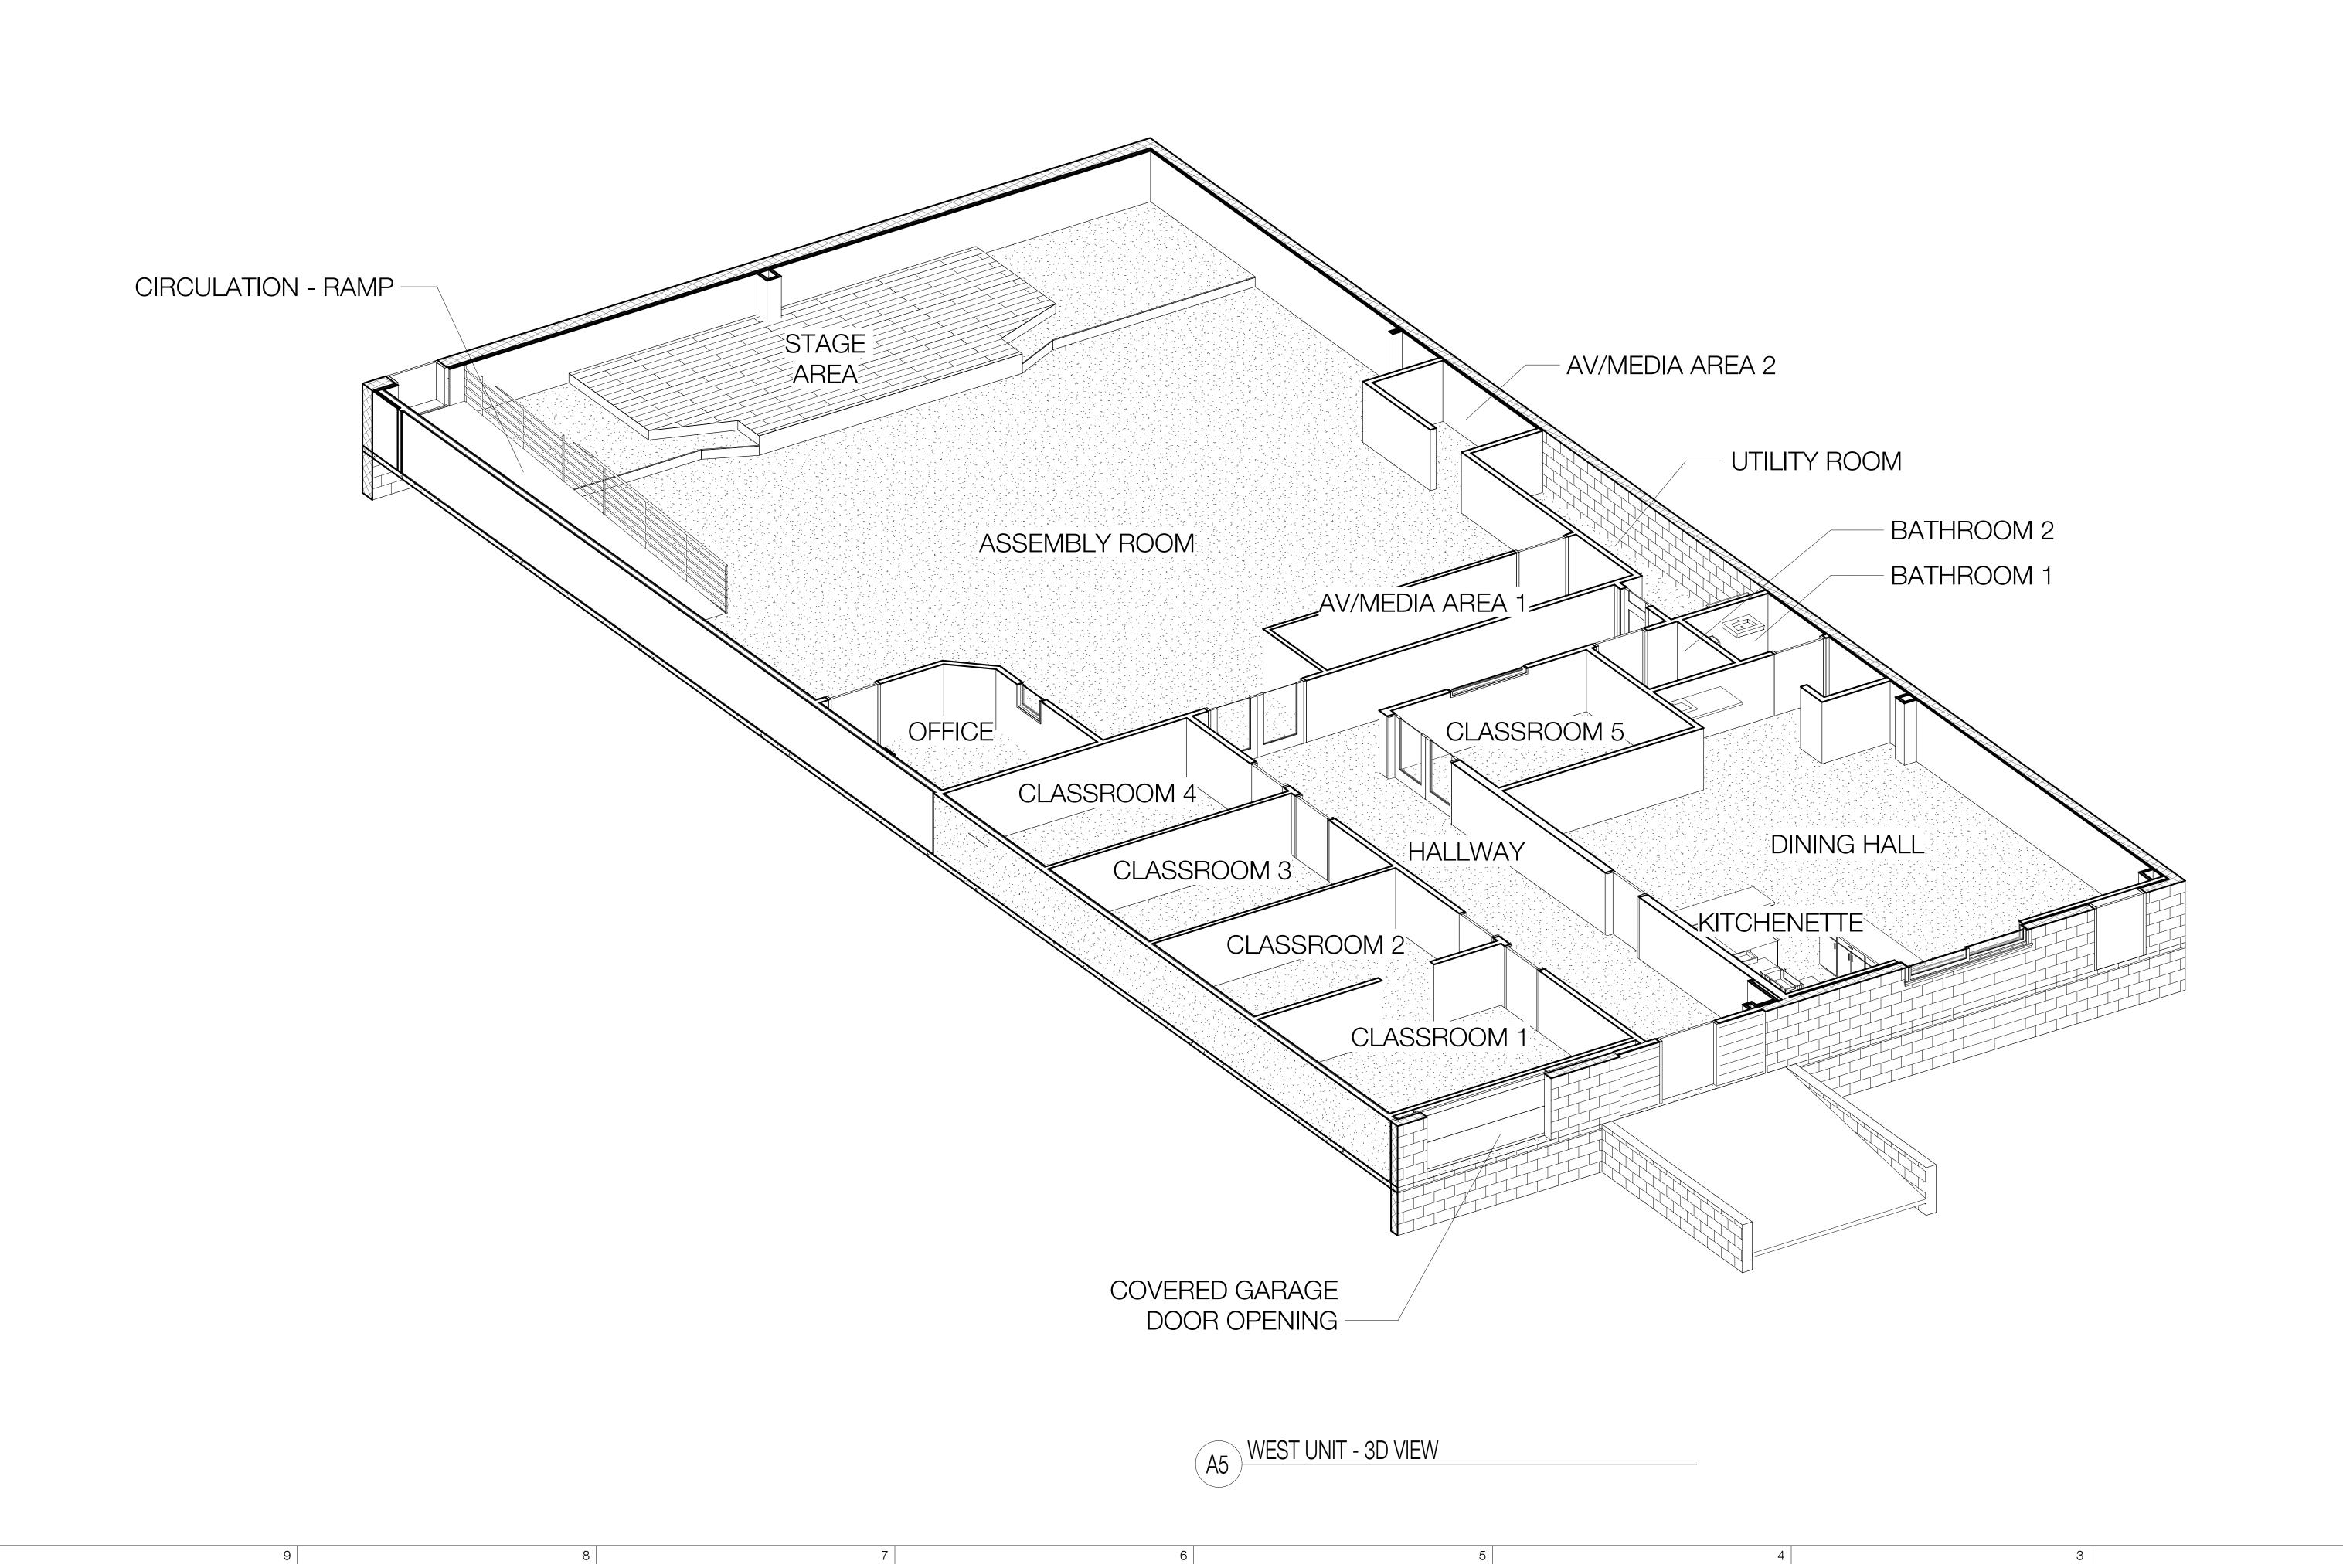

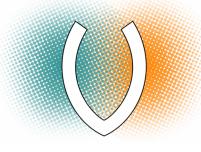

PROFESSIONAL CERTIFICATION

I CERTIFY THAT THESE DOCUMENTS WERE PREPARED OR APPROVED BY ME,
AND THAT I AM A DULY LICENSED ARCHITECT UNDER THE LAWS OF THE
STATE OF MARYLAND, LICENSE NUMBER 18979, EXPIRATION DATE



## WOODFIELD ROAD COMMERCIAL SPACE

18630 WOODFIELD ROAD GAITHERSBURG, MD 20879

WEST UNIT - 3D VIEW

VS #2415

DISCLAIMER
THIS DRAWING AND ASSOCIATED DOCUMENTS ARE THE
EXCLUSIVE PROPERTY OF VEN STUDIO, LLC, AND ARE NOT
TO BE REPRODUCED OR COPIED IN WHOLE OR IN PART,
EXCEPT AS REQUIRED FOR THE STATED PROJECT. THEY
ARE ONLY TO BE USED FOR THIS PROJECT AND SITE
SPECIFICALLY IDENTIFIED HEREIN AND ARE NOT TO BE
USED ON ANY OTHER PROJECT WITHOUT WRITTEN
CONSENT OF VEN STUDIO. SCALES AS NOTED ON THIS
DRAWING ARE VALID ON THE ORIGINAL DRAWING ONLY,
THE DIMENSIONS OF WHICH ARE 30 x 42 INCHES.

DATE REVISION

**AR106** 

DOCUMENTATION 9/13/2024



- AS-BUILT EXISTING CONDITIONS ARE FOR REFERENCE ONLY
- 2. ALL DIMENSIONS NOTED ARE TO FINISH, UON



PROFESSIONAL CERTIFICATION

I CERTIFY THAT THESE DOCUMENTS WERE PREPARED OR APPROVED BY ME,
AND THAT I AM A DULY LICENSED ARCHITECT UNDER THE LAWS OF THE
STATE OF MARYLAND, LICENSE NUMBER 18979, EXPIRATION DATE

04/23/2025.

BERWYN HEIGHTS, MD 20740 Tel: 301.799.2100 www.ven-studio.com



## WOODFIELD ROAD COMMERCIAL SPACE

18630 WOODFIELD ROAD GAITHERSBURG, MD 20879

## WAREHOUSE UNIT FLOOR PLAN


VS #2415

DISCLAIMER
THIS DRAWING AND ASSOCIATED DOCUMENTS ARE THE EXCLUSIVE PROPERTY OF VEN STUDIO, LLC, AND ARE NOT TO BE REPRODUCED OR COPIED IN WHOLE OR IN PART, EXCEPT AS REQUIRED FOR THE STATED PROJECT. THEY ARE ONLY TO BE USED FOR THIS PROJECT AND SITE SPECIFICALLY IDENTIFIED HEREIN AND ARE NOT TO BE USED ON ANY OTHER PROJECT WITHOUT WRITTEN CONSENT OF VEN STUDIO. SCALES AS NOTED ON THIS DRAWING ARE VALID ON THE ORIGINAL DRAWING ONLY, THE DIMENSIONS OF WHICH ARE 30 x 42 INCHES.

DATE REVISION

**AR107** 

DOCUMENTATION 9/13/2024

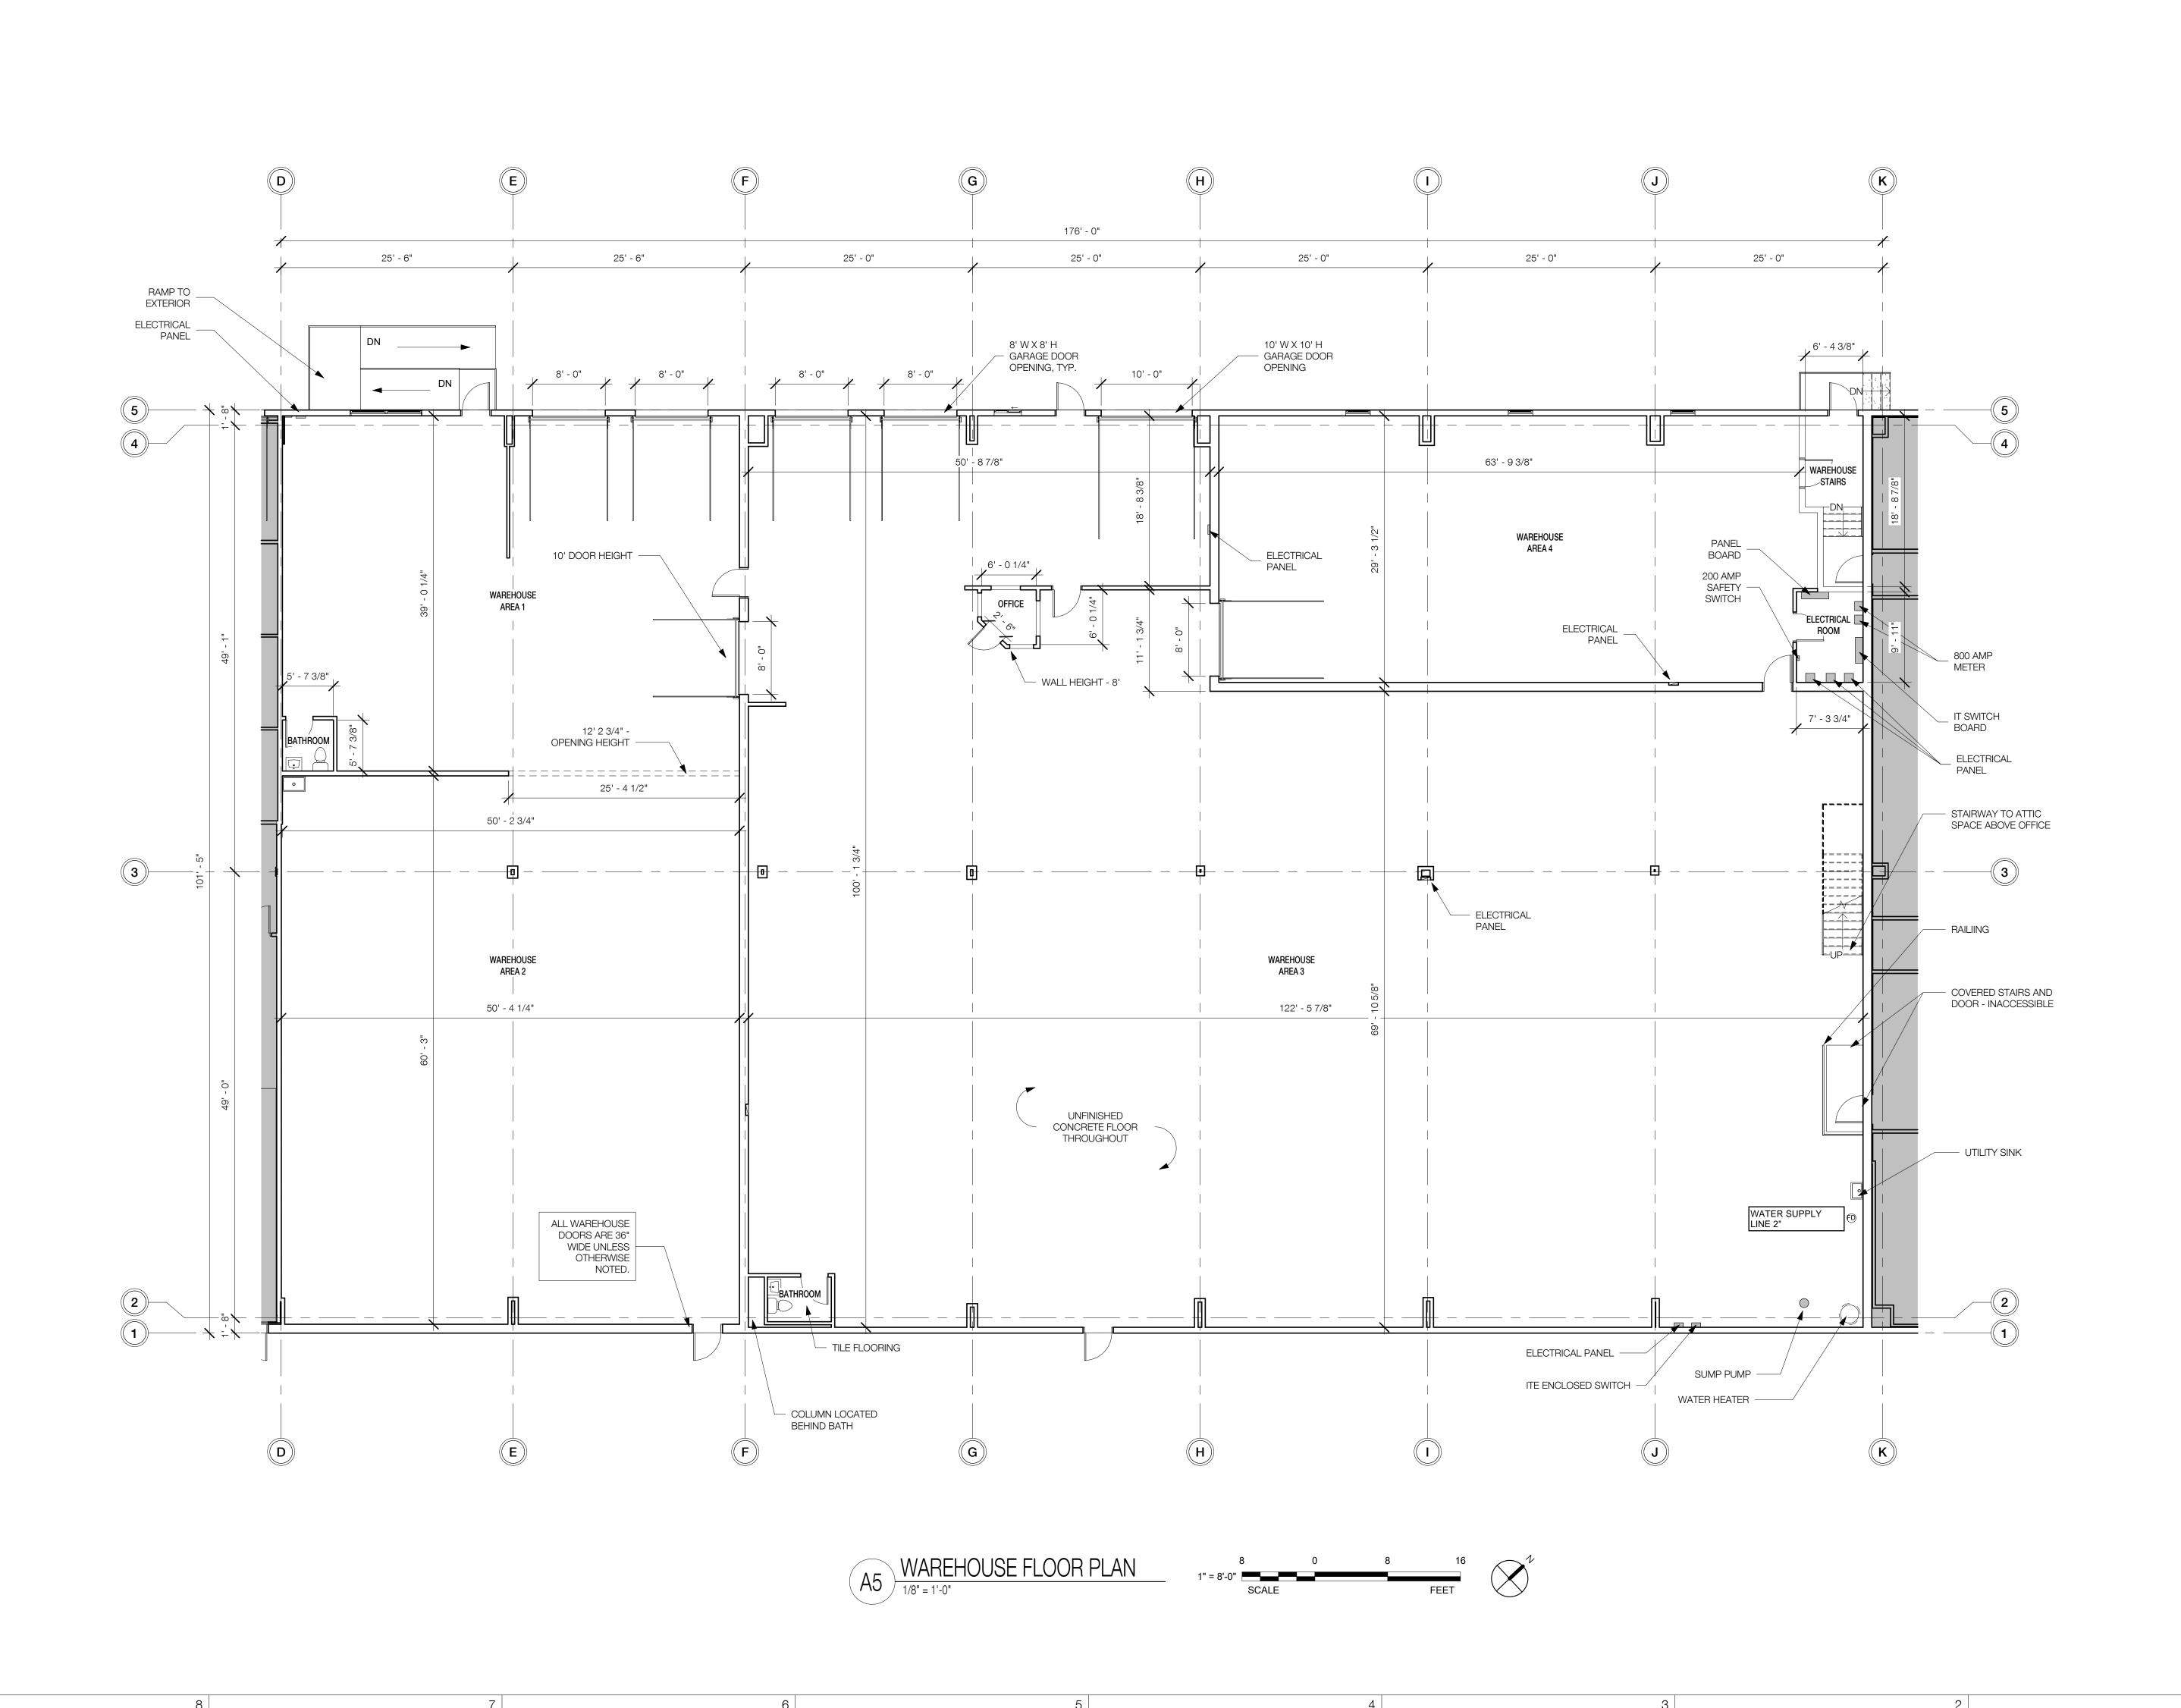

Occupant Load Calculations - Warehouse									
AREA NAME	AREA (SF)	AREA PER OCCUPANT (SF)	GROSS OR NET	OCCUPANCY LOAD	EGRESS WIDTI REQ'D (*0.2")				
ACCESSORY STORAGE / N	MECHANICAL EQU	JIPMENT							
ELECTRICAL ROOM	85 SF	300 SF	GROSS	1	0.2				
BUSINESS AREAS									
WAREHOUSE OFFICE	37 SF	150 SF	GROSS	1	0.1				
CIRCULATION									
WAREHOUSE STAIRS	124 SF	0 SF							
STORAGE / MECH UNOCC									
WAREHOUSE AREA 1	1998 SF	300 SF	GROSS	7	1.4				
WAREHOUSE AREA 2	3141 SF	300 SF	GROSS	11	2.2				
WAREHOUSE AREA 3	10262 SF	300 SF	GROSS	35	6.9				
WAREHOUSE AREA 4	1973 SF	300 SF	GROSS	7	1.4				
Grand total	17621 SF			61	12.3				



PROFESSIONAL CERTIFICATION
I CERTIFY THAT THESE DOCUMENTS WERE PREPARED OR APPROVED BY ME,
AND THAT I AM A DULY LICENSED ARCHITECT UNDER THE LAWS OF THE
STATE OF MARYLAND, LICENSE NUMBER 18979, EXPIRATION DATE



## WOODFIELD ROAD COMMERCIAL SPACE

18630 WOODFIELD ROAD GAITHERSBURG, MD 20879

# WAREHOUSE UNIT OCCUPANCY PLAN

VS #2415


DISCLAIMER
THIS DRAWING AND ASSOCIATED DOCUMENTS ARE THE EXCLUSIVE PROPERTY OF VEN STUDIO, LLC, AND ARE NOT TO BE REPRODUCED OR COPIED IN WHOLE OR IN PART, EXCEPT AS REQUIRED FOR THE STATED PROJECT. THEY ARE ONLY TO BE USED FOR THIS PROJECT AND SITE SPECIFICALLY IDENTIFIED HEREIN AND ARE NOT TO BE USED ON ANY OTHER PROJECT WITHOUT WRITTEN CONSENT OF VEN STUDIO. SCALES AS NOTED ON THIS DRAWING ARE VALID ON THE ORIGINAL DRAWING ONLY, THE DIMENSIONS OF WHICH ARE 30 x 42 INCHES.

DATE REVISION

AR108


DOCUMENTATION 9/13/2024


© VEN STUDIO, LLC.

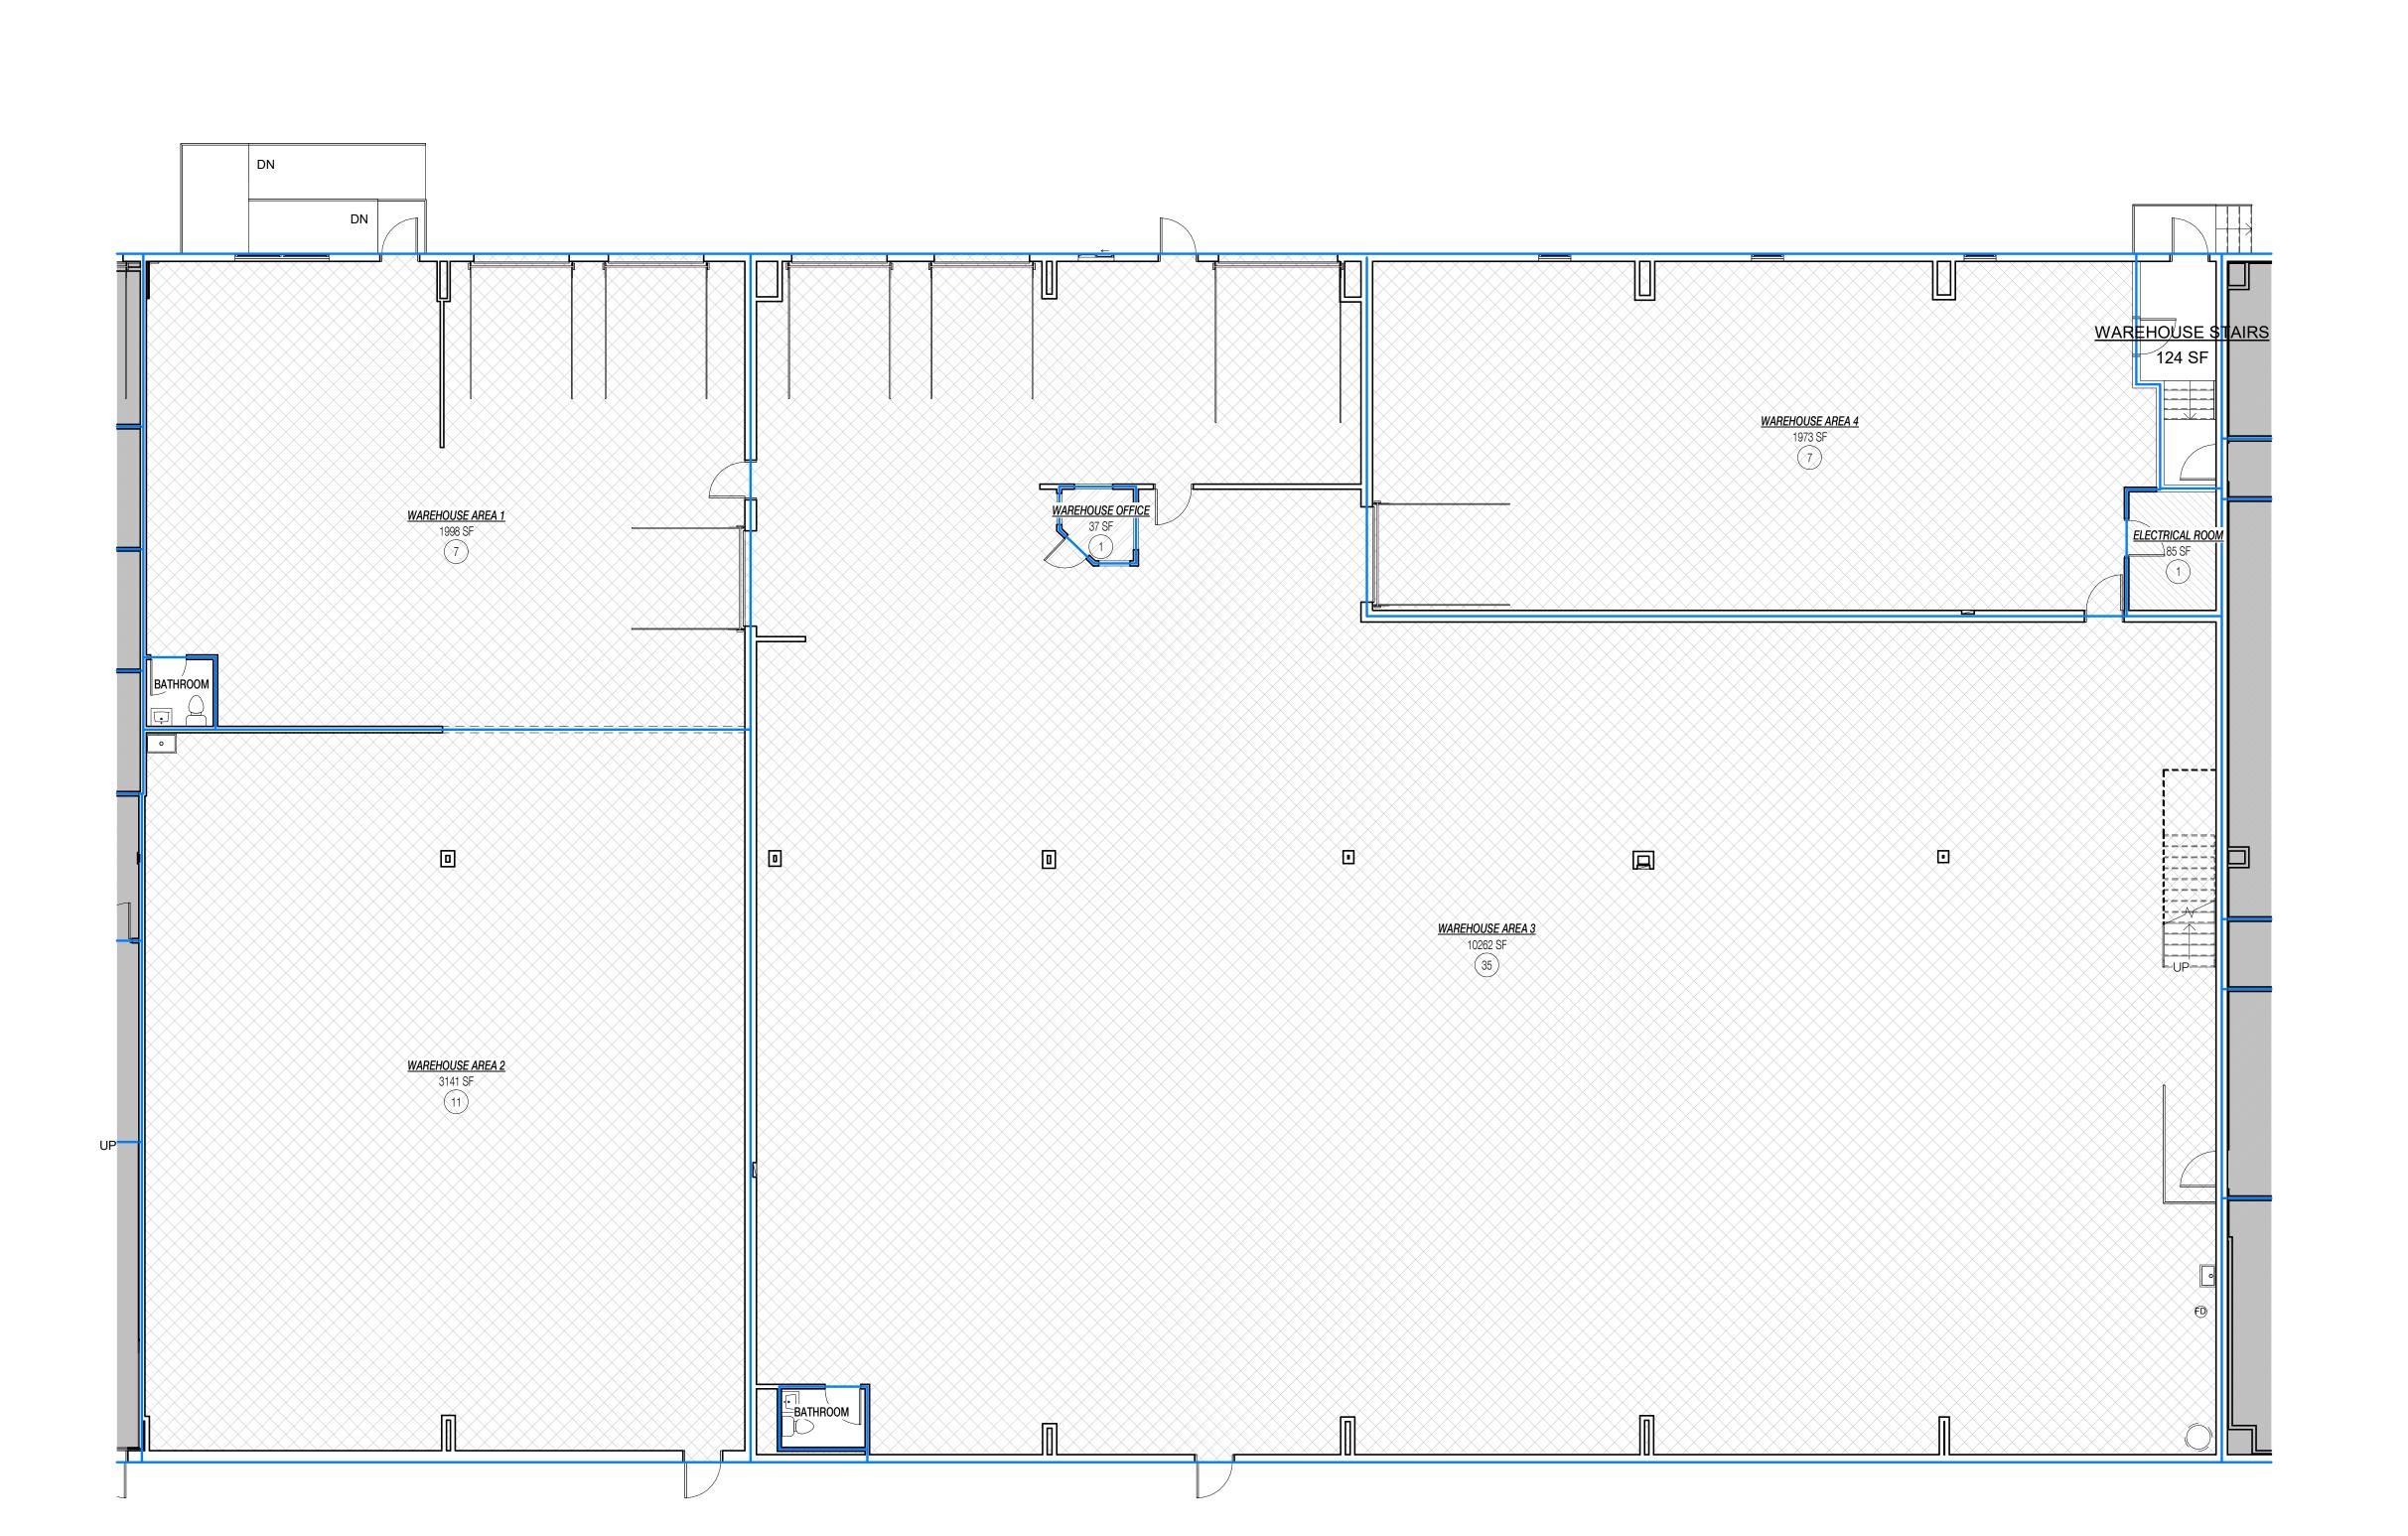



6

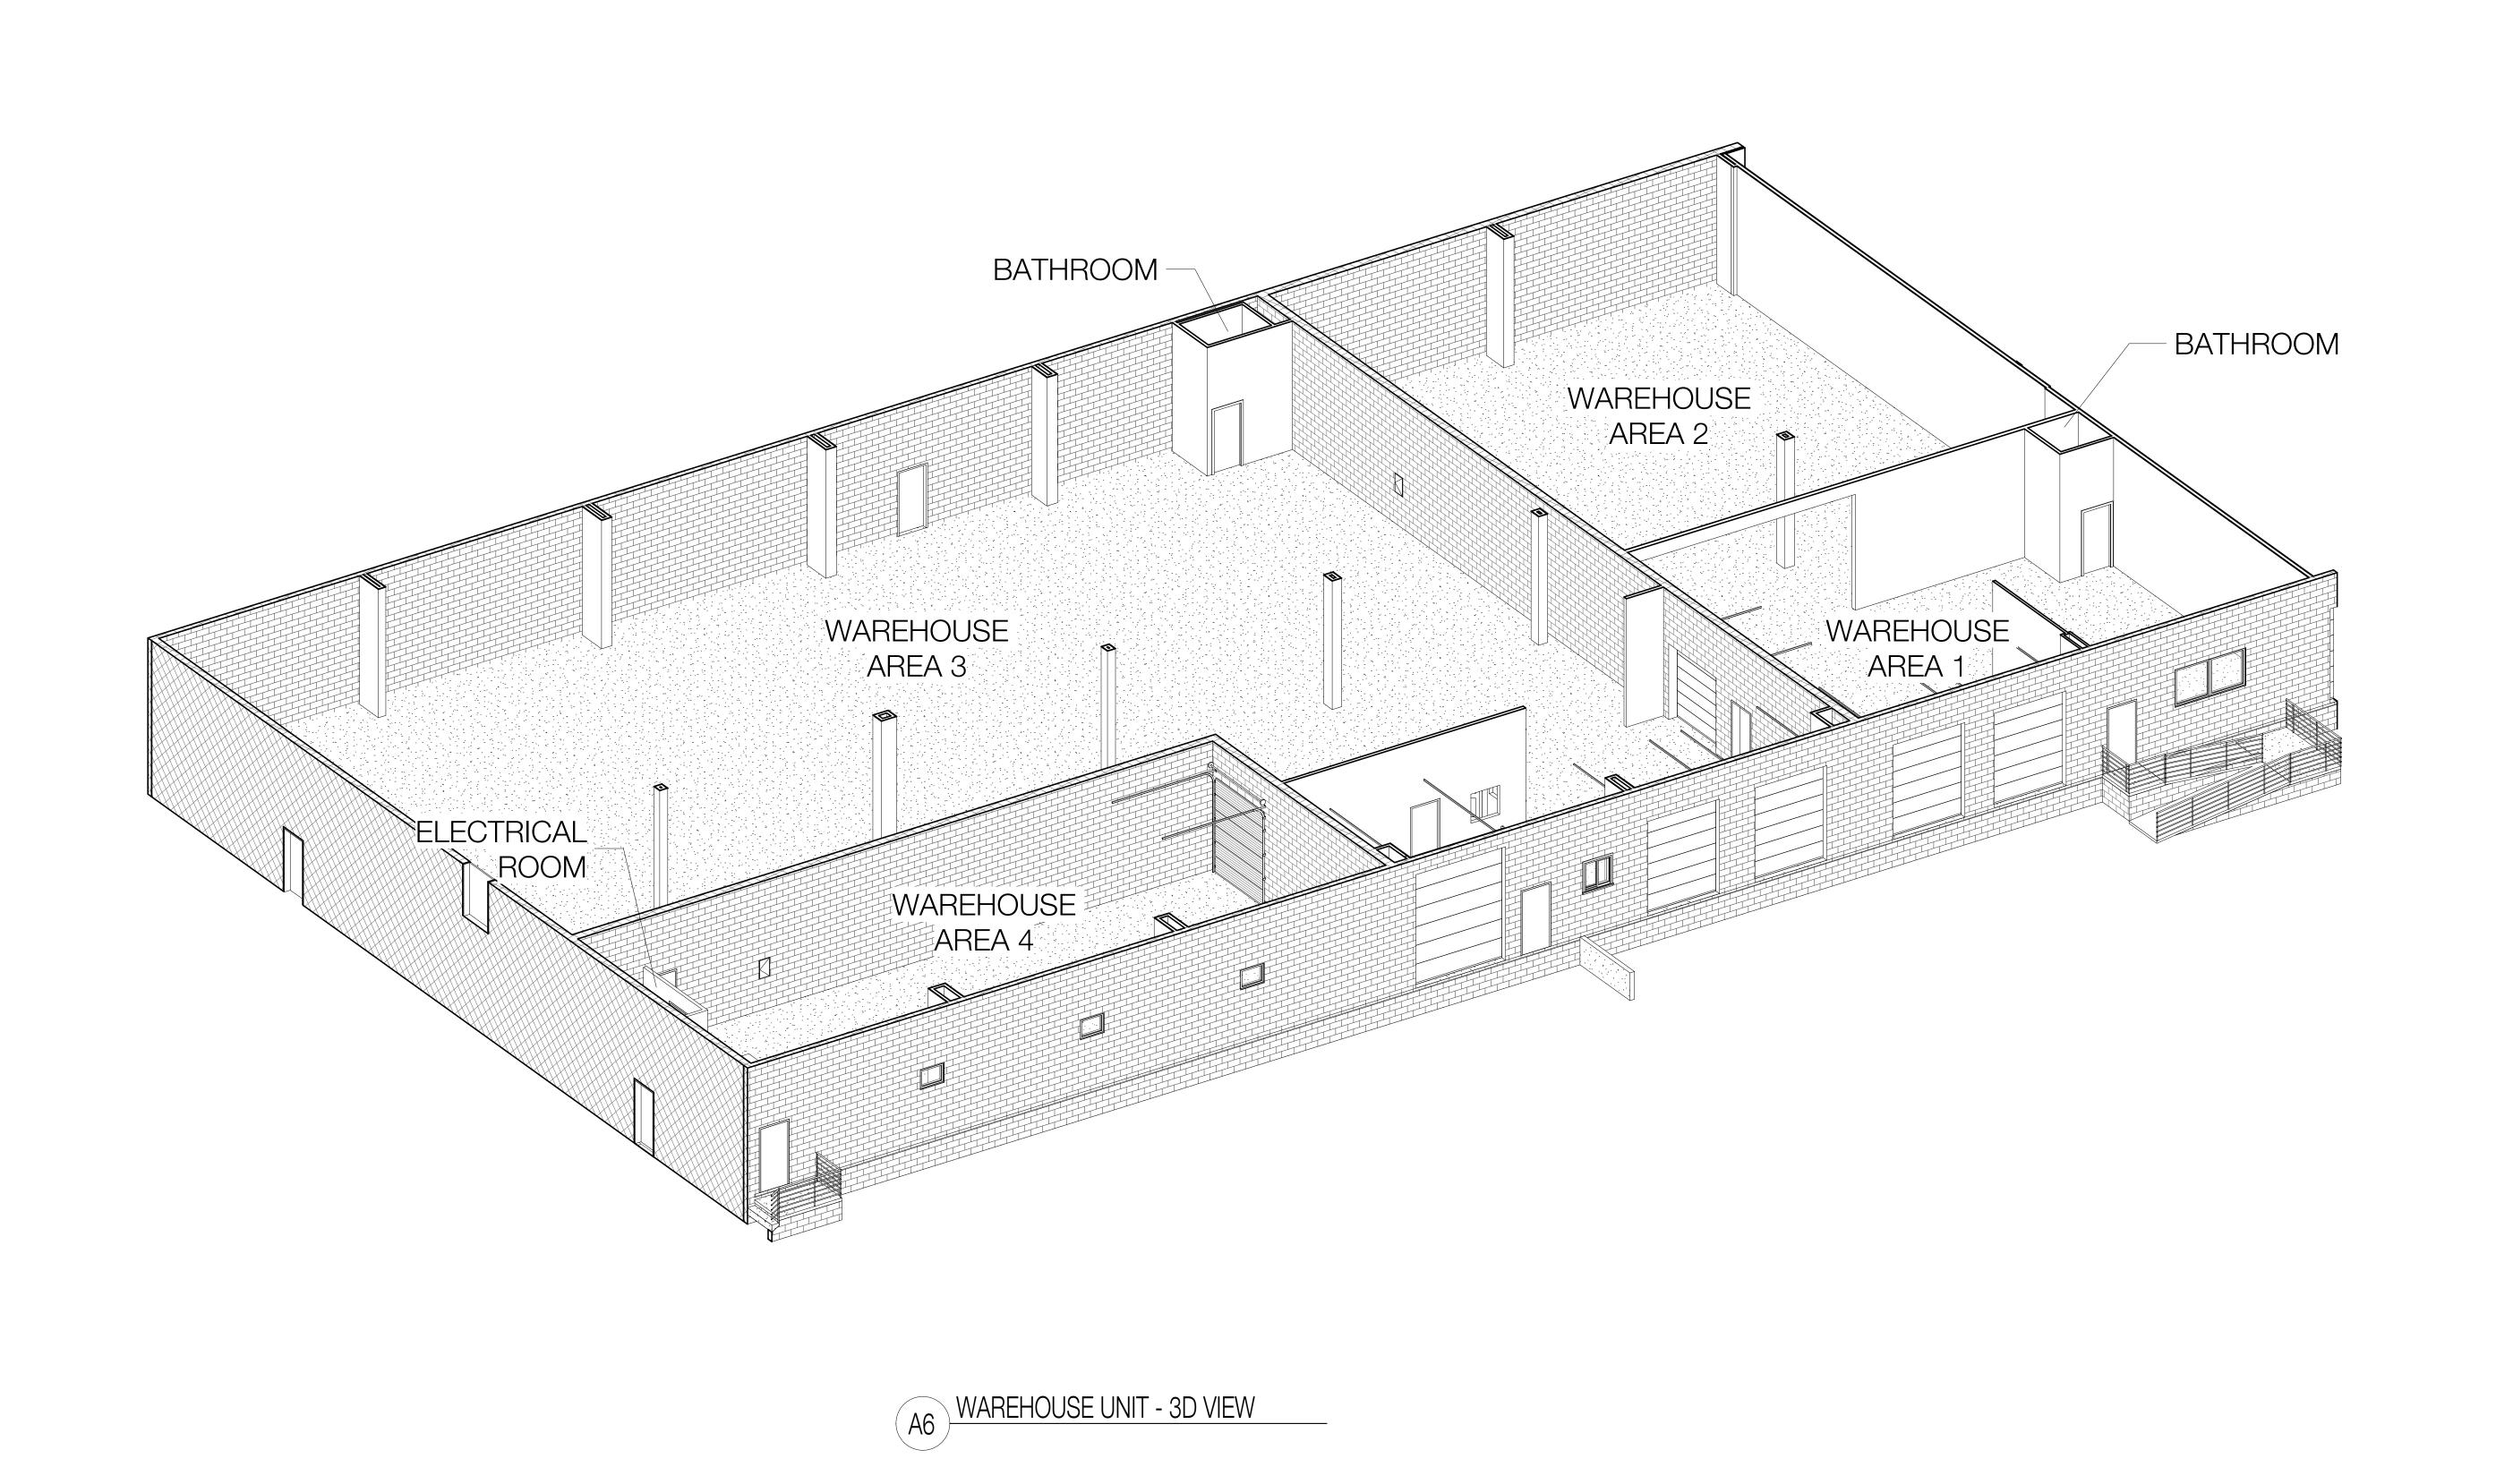

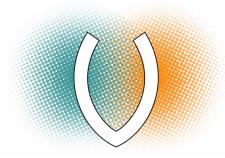

PROFESSIONAL CERTIFICATION
I CERTIFY THAT THESE DOCUMENTS WERE PREPARED OR APPROVED BY ME,
AND THAT I AM A DULY LICENSED ARCHITECT UNDER THE LAWS OF THE
STATE OF MARYLAND, LICENSE NUMBER 18979, EXPIRATION DATE



## WOODFIELD ROAD COMMERCIAL SPACE

18630 WOODFIELD ROAD GAITHERSBURG, MD 20879

## WAREHOUSE UNIT -3D VIEW

VS #2415

DISCLAIMER
THIS DRAWING AND ASSOCIATED DOCUMENTS ARE THE EXCLUSIVE PROPERTY OF VEN STUDIO, LLC, AND ARE NOT TO BE REPRODUCED OR COPIED IN WHOLE OR IN PART, EXCEPT AS REQUIRED FOR THE STATED PROJECT. THEY ARE ONLY TO BE USED FOR THIS PROJECT AND SITE SPECIFICALLY IDENTIFIED HEREIN AND ARE NOT TO BE USED ON ANY OTHER PROJECT WITHOUT WRITTEN CONSENT OF VEN STUDIO. SCALES AS NOTED ON THIS DRAWING ARE VALID ON THE ORIGINAL DRAWING ONLY, THE DIMENSIONS OF WHICH ARE 30 x 42 INCHES.

DATE REVISION

AR109

DOCUMENTATION 9/13/2024

© VEN STUDIO, LLC.

9 5 5 2