

SCOPE OF WORK:

- BUILDING AND FIRE ALARM SYSTEM ARE EXISTING. BUILDING HAS FOUR STORIES AND DO NOT HAVE SPRINKLER SYSTEM.
- THE EXISTING FIRE ALARM SYSTEM HAS AN ADDRESSABLE PANEL MS-9600, SUPPORTS UP TO 318 ADDRESSABLE DEVICES (159 DETECTORS AND 159 MODULES PER LOOP) AND 4 NOTIFICATION CIRCUITS. AN ADDITIONAL 318 ADDRESSABLE DEVICES CAN BE ADDED IN A SECOND LOOP.
- PURPOSE OF THIS PERMIT IS TO ADD NEW INITIATING DEVICES INSIDE UNITS SHOWN AT 2nd, 3rd & 4th FLOORS; BECAUSE INTERIOR RENOVATION OR MISSING FROM SEVERAL AREAS.
- ALL VOLTAGE DROPS, FACP AND POWER SUPPLIES BATTERY CALCULATIONS WERE UPDATED.
- PLEASE FOLLOW FLOOR PLAN AND RISER DIAGRAM FOR DEVICES/EQUIPMENT LOCATIONS AND INTERCONNECTION.
- THE FIRE ALARM SYSTEM IS MONITORED BY AN EXISTING "LISTED CENTRAL STATION".
- SYSTEM IS A CERTIFICATED OR PLACARDED CENTRAL STATION SERVICE (NFPA 72:26.3.8.3)
- DESIGN SHALL CONFORM REQUIREMENTS OF NFPA-72, 2016 EDITION (NATIONAL FIRE ALARM CODE), FPFC 7th EDITION (FLORIDA FIRE PREVENTION CODE), NFPA 1, 2018 EDITION (FIRE CODE), NFPA 101, 2018 EDITION (LIFE SAFETY CODE), NFPA 70, 2017 EDITION (NATIONAL ELECTRICAL CODE) AND FBC 2020 EDITION (FLORIDA BUILDING CODE).
- VOLTAGE DROP AND BATTERY BACK-UP CALCULATIONS PROVIDED FOR 24 HOURS STANDBY PLUS 5 MINUTES IN ALARM CONDITION.
- THE FACP AND POWER SUPPLY ARE LOCATED INSIDE MECHANICALLY VENTILATED ROOM.
- OCCUPANCY TYPE PER FPFC 7th EDITION IS BUSINESS.

FIRE ALARM SPECIFICATIONS AND NOTES:

- INSTALLATION SHALL BE IN ACCORDANCE WITH THE 2017 EDITION OF NEC-780, NFPA & ALL LOCAL AND FBC 2020 Edition. BUILDING AND FIRE ALARM SYSTEM ARE EXISTING. THE EXISTING FIRE ALARM SYSTEM IS POWER LIMITED.
- ALL MATERIALS SHALL BE UL LISTED AND COMPATIBLE FOR THE PURPOSE INTENDED.
- CONTRACTOR SHALL PROVIDE ALL REQUIRED PERMITS.
- MINIMUM CONDUIT SIZE WILL BE 1/2". MAX CONDUIT FILL SHALL BE 40%.
- CONTRACTOR SHALL WARRANTEE ALL WORKMANSHIP AND MATERIALS FOR ONE YEAR FROM FINAL INSPECTION.
- CONTRACTOR SHALL REPORT ANY DISCREPANCIES TO THE ENGINEER FOR CLARIFICATION.
- CONTRACTOR SHALL INVESTIGATE THE PROJECT SITE AND ALL EXISTING SYSTEMS PRIOR TO CONSTRUCTION.
- SUBMIT SHOP DRAWINGS TO FIRE MARSHALL FOR APPROVAL PRIOR TO ROUGH-IN.
- VERIFY LOCATION OF ALL DEVICES WITH FIRE MARSHALL AND OWNER REPRESENTATIVE AT ROUGH-IN.
- A BREAK IN ANY FIELD WIRING OR GROUNDING OF ANY CONDUCTOR WILL RESULT IN THE ACTIVATION OF THE FIRE ALARM PANEL TROUBLE BUZZER WHICH CAN BE SILENCED BY THE "TROUBLE SILENCE" BUTTON ON THE FACP.
- FIRE ALARM INSPECTOR HAS ULTIMATE JURISDICTION AS TO LOCATION AND NUMBER OF DEVICES.
- BUILDING DO NOT HAVE SPRINKLER SYSTEM.
- SYSTEM IS GOING MONITORED BY AN EXISTING "LISTED CENTRAL STATION".
- BATTERY BACK-UP IS GOING TO BE PROVIDED FOR 24 HOURS STANDBY AND 5 MINUTES IN ALARM.
- FIRE ALARM CONTROL PANEL SHALL BE CROSS LISTED WITH OTHER COMPONENTS USED.
- ALL INITIATING AND INDICATION CIRCUITS MUST BE SUPERVISED.
- INITIATING DEVICES ARE CLASS "B", LEVEL "0". NOTIFICATION CIRCUITS ARE CLASS "B", LEVEL "0".
- EVACUATIONS SIGNALS SHALL BE TEMPORAL IN ACCORDANCE WITH NFPA 72 18.4.2.1, 2016 Edition.
- CIRCUIT BREAKER SUPPLYING POWER TO THE FIRE ALARM PANEL, COMPONENTS NEED TO BE CLEARLY MARKED WITH RED PAINT, AND MECHANICALLY PROTECTED TO AVOID ACCIDENTAL CIRCUIT BREAKER DISCONNECT.
- MAXIMUM MOUNTING HEIGHT FOR FACP AND POWER SUPPLIES IS 6' TO TOP OF ENCLOSURE.
- POWER UP AND DOWN POWER DOWN OF THE FIRE ALARM PANEL MUST BE DONE IN THE PROPER SEQUENCE: POWER DOWN, DISCONNECT BATTERY AND THEN TURN OFF THE AC POWER AT THE DISCONNECT BREAKER. POWER UP: TURN ON THE AC POWER AT THE BREAKER AND THEN CONNECT THE BATTERY. NOTE: DO NOT DISCONNECT THE AC POWER FEED FROM THE TERMINAL BLOCK TO DISCONNECT POWER.
- THE SOUND LEVEL WILL BE AT LEAST 15dba ABOVE THE EQUIVALENT SOUND LEVEL OR 5 DBA ABOVE THE MAXIMUM SOUND LEVEL HAVING A DURATION OF AT LEAST 60 SECONDS, MEASURED 5 FT. ABOVE THE FLOOR IN THE OCCUPIED AREA.
- CONTRACTOR SHALL HAVE A CERTIFICATE OF COMPLETION FOR EACH FIRE ALARM SYSTEM. INSTALLED AND SHALL PROVIDE A COPY TO THE OWNER AND THE FIRE RESCUE DEPARTMENT.
- FIRE ALARM PANEL ROOM IS MECHANICALLY VENTILATED.
- VISUAL NOTIFICATION APPLIANCES SHALL FLASH IN SYNCHRONIZATION PER NFPA-72 18.5.5.4.2(2) & (3) 2016 Edition.
- IN CORRIDORS WHERE MORE THAN TWO VISIBLE NOTIFICATION APPLIANCES ARE IN ANY FIELD OF VIEW, THEY SHALL FLASH IN SYNCHRONIZATION PER NFPA-72 18.5.5.5.7, 2016 Edition.

FIRE ALARM SYSTEM SEQUENCE OF OPERATION.

- THE ACTIVATION OF THE FIRE ALARM INITIATING DEVICES SHALL AUTOMATICALLY INITIATE THE FOLLOWING FUNCTIONS THROUGHOUT THE BUILDING.
- SYSTEMS IS NEW AND IS "GENERAL ALARM".
- FOR ANY INCIDENCE, ANNUNCIATE THE "ALARM, TROUBLE OR SUPERVISORY" SIGNAL AT FACP.
- FOR ANY INCIDENCE, TRANSMIT THE "ALARM, TROUBLE OR SUPERVISORY" SIGNAL TO THE LISTED CENTRAL STATION BY A "WIRELESS COMMUNICATOR" AND/OR ONE PHONE LINE ALSO AVAILABLE TO SEND SIGNALS TO THE CENTRAL STATION.
- A. MANUAL FIRE ALARM PULL STATION:**
- ACTIVATION OF THE MANUAL PULL STATION SHALL INITIATE THE FOLLOWING FUNCTIONS:
- GENERATE AN AUDIBLE ALARM SIGNAL AT THE FIRE ALARM CONTROL PANEL AND THE REMOTE ANNUNCIATOR.
 - GENERATE AN AUDIO VISUAL SIGNAL SIMULTANEOUSLY THROUGHOUT THE BUILDING BY THE USE OF STROBES AND/OR COMBINATION OF HORNSTROBES APPLIANCES.
 - INDICATE THE LOCATION OF THE PULL STATION BY DISPLAYING THE ALARMED DEVICE ON THE FACP LCD DISPLAY, AND THE REMOTE ANNUNCIATOR.
- B. SMOKE AND HEAT DETECTORS:**
- ACTIVATION OF ANY DETECTORS SHALL INITIATE THE FOLLOWING FUNCTIONS:
- GENERATE AN AUDIBLE ALARM SIGNAL AT THE FIRE ALARM CONTROL PANEL AND THE REMOTE ANNUNCIATOR.
 - GENERATE AN AUDIO VISUAL SIGNAL SIMULTANEOUSLY THROUGHOUT THE BUILDING BY THE USE OF STROBES AND/OR COMBINATION OF HORNSTROBES APPLIANCES.
 - INDICATE THE LOCATION OF THE DETECTOR BY DISPLAYING THE ALARMED DEVICE ON THE FACP LCD DISPLAY, AND THE REMOTE ANNUNCIATOR.
- C. DUCT DETECTORS:**
- ACTIVATION OF DUCT DETECTORS SHALL INITIATE THE FOLLOWING FUNCTIONS:
- GENERATE AN AUDIBLE "SUPERVISORY" SIGNAL AT THE FIRE ALARM CONTROL PANEL AND THE REMOTE ANNUNCIATOR.
 - INDICATE THE LOCATION OF THE DUCT DETECTOR BY DISPLAYING THE ADDRESS ON THE FACP LCD DISPLAY.
 - SHUT OFF THE AIR HANDLING UNIT AND A/C EQUIPMENT ASSOCIATED WITH THE DUCT DETECTOR.
- D. ELEVATOR LOBBY SMOKE DETECTOR:**
- ACTIVATION OF ANY SINGLE ELEVATOR LOBBY DETECTOR SHALL INITIATE THE FOLLOWING FUNCTIONS:
 - GENERATE AN AUDIBLE ALARM SIGNAL AT THE FIRE ALARM CONTROL PANEL AND THE REMOTE ANNUNCIATOR.
 - GENERATE AN AUDIO VISUAL ALARM SIGNAL SIMULTANEOUSLY THROUGHOUT THE BUILDING BY THE USE OF STROBES AND/OR COMBINATION OF HORNSTROBES APPLIANCES.
 - INDICATE THE LOCATION OF THE DETECTOR BY DISPLAYING THE ALARMED DEVICE AND ITS LOCATION ON THE FACP ALPHANUMERIC DISPLAY AND THE REMOTE ANNUNCIATOR.
 - INITIATE THE AUTOMATIC ELEVATOR RECALL FUNCTION AS FOLLO:
 - a) IF THE FIRST FLOOR ELEVATOR LOBBY DETECTOR GOES OFF IN ALARM, RECALL IS GOING TO SEND ELEVATOR CAB TO THE ALTERNATE OR SECOND FLOOR.
 - b) IF ANY FLOOR ELEVATOR LOBBY DETECTOR OTHER THAN THE FIRST FLOOR, GOES OFF IN ALARM, RECALL IS GOING TO SEND ELEVATOR CAB TO THE FIRST FLOOR.
- E. ELEVATOR MACHINERY ROOM SMOKE DETECTOR:**
- ACTIVATION OF ELEVATOR MACHINERY ROOM SMOKE DETECTOR IS GOING TO PERFORM ALL STEPS DESCRIBED ON "D1.2.3 & 4" ABOVE AND:
- 1-a) ACTIVATION OF ELEVATOR MECHANICAL ROOM SMOKE DETECTOR IS GOING TO ACTIVATE THE ELEVATOR WARNING LIGHT RELAY AND THE ELEVATOR WARNING LIGHT IS GOING TO FLASH INDICATING NOT TO USE ELEVATORS.
- F. "TROUBLE" CONDITION:**
- GENERATE AN AUDIBLE TROUBLE SIGNAL AT THE FIRE ALARM CONTROL PANEL. IF ANY OPEN, SHORT OR GROUND CIRCUIT OCCUR IN WIRING.
- THE MAXIMUM TIME PERIOD FROM ACTIVATION OF THE INITIATING DEVICE UNTIL INITIATION OF ALL RELATED FUNCTIONS AS LISTED ABOVE SHALL BE TEN (10) SECONDS. NFPA-72 10.10.1 (2016 Edition).
- THE MAXIMUM TIME PERIOD TO REPORT A TROUBLE CONDITION IS 200 SECONDS. NFPA-72 10.15.1 (2016 Edition).

MANDATORY ADDITIONAL SMOKE DETECTION IN THE BUILDING NOTE:

The reason for the mandatory additional smoke detection in the building. Because the building does not comply with the Life Safety Code requirements for existing business occupancies in regards to remoteness of exits and common paths of travel, the smoke detectors are required as an alternative level of safety. The smoke detection is not required by prescriptive code but they are being installed as an alternative/equivalency to provide an equivalent level of safety and are therefore mandatory.

Per NFPA 1 – Sections 14.5, 112.3, 1.14, 4.5.5.1, 4.5.8, 5.1.4, and 72 – Sections 7.3.2, 7.3.5.2, and 17.7.1.1.

The documentation serves as evidence that they are required and cannot be removed at some future date without prior approval by BSO (the AHJ).

SYMBOL	DESCRIPTION	MODEL NUMBER	MOUNTING HEIGHTS	MANUFACTURER
FACP	EXISTING FIRE ALARM CONTROL PANEL	MS-9600	72" A.F.F. TO TOP OF ENCLOSURE.	FIRELITE
PS	EXISTING POWER SUPPLY	FCPS-24FS8	72" A.F.F. TO TOP OF ENCLOSURE.	FIRELITE
SD	SMOKE DETECTOR	SD365		FIRELITE
HORN	HORN-STROBE INDOOR	P2RL	80" A.F.F. TO BOTTOM OF DEVICE.	SYSTEM SENSOR
SRL	STROBE INDOOR	SRL	80" A.F.F. TO BOTTOM OF DEVICE.	SYSTEM SENSOR
IM	ISOLATOR MODULE	I300		FIRELITE
HORN	HORN-STROBE INDOOR	P2C2RL	CEILING MOUNTED	SYSTEM SENSOR
SRL	STROBE INDOOR	SCRL	CEILING MOUNTED	SYSTEM SENSOR
H	HEAT DETECTOR	H365		FIRELITE
FAC	FIRE ALARM COMMUNICATOR	HW-AV-LTE-M	5.5' A.F.F. TO TOP OF ENCLOSURE	HONEYWELL
M	MONITOR MODULE	FM-101		FIRELITE
R	ADDRESSABLE RELAY	CRF-300		FIRELITE
VS	120V SURGE SUPPRESSOR	DTK-120WH		DTK OR EQUIVALENT
PLSS	PHONE LINE SUPPRESSOR	DTK-MRJ31XSCPW		DTK OR EQUIVALENT
FAAP	FIRE ALARM ANNUNCIATOR PANEL	LCD-80F	56"~64" AFF TO CENTER	FIRELITE
SD	DUCT DETECTOR	SD35PL		FIRELITE
PS	PULL STATION	NBQ-12LX	48" A.F.F. TO CENTER	FIRELITE

FCPS-24FS8		STANDBY		TOTAL STANDBY		ALARM		TOTAL ALARM			
P.S.-"1"		CURRENT PER		CURRENT PER		CURRENT PER		CURRENT PER			
ITEM	DESCRIPTION	UNIT (AMPS)	QTY	UNIT (AMPS)	QTY	UNIT (AMPS)	QTY	UNIT (AMPS)	QTY		
1	Monitor Board	0.0650	X	1	=	0.0650	0.1450	X	1	=	0.1450
2	NAC-1	0.0000	X	1	=	0.0000	0.8890	X	1	=	0.8890
3	NAC-2	0.0000	X	1	=	0.0000	1.0510	X	1	=	1.0510
4	NAC-3	0.0000	X	1	=	0.0000	2.3060	X	1	=	2.3060
5	NAC-4	0.0000	X	1	=	0.0000	1.9290	X	1	=	1.9290
TOTAL STANDBY CURRENT				0.0650	TOTAL ALARM CURRENT				6.3180		

STANDBY:		24	HOURS		ALARM:		5	MINUTES x 1/60 =		0.0833	
REQUIRED STANDBY TIME (HOURS)		24	X	0.0650	=	1.5600	0.0833	X	6.3180	=	0.5265
REQUIRED STANDBY CAPACITY (AMP HOURS)		1.5600	+	0.5265	=	2.0865	1.2000	=	2.5038	7.0 AH	

FCPS-24FS8		STANDBY				TOTAL STANDBY		ALARM				TOTAL ALARM		
P.S.-77"		CURRENT PER				CURRENT PER		CURRENT PER				CURRENT PER		
ITEM	DESCRIPTION	UNIT (AMPS)	QTY			UNIT (AMPS)		UNIT (AMPS)		QTY		UNIT (AMPS)		
1	Monitor Board	0.0650	X	1	=	0.0650		0.1450	X	1	=	0.1450		
2	NAC-1	0.0000	X	1	=	0.0000		1.9490	X	1	=	1.9490		
3	NAC-2	0.0000	X	1	=	0.0000		1.9200	X	1	=	1.9200		
4	NAC-3	0.0000	X	1	=	0.0000		1.7270	X	1	=	1.7270		
5	NAC-4	0.0000	X	1	=	0.0000		1.1890	X	1	=	1.1890		
TOTAL STANDBY CURRENT						0.0650	TOTAL ALARM CURRENT						6.9390	

STANDBY:		24	HOURS		ALARM:		5	MINUTES x 1/60 =		0.0833
REQUIRED STANDBY TIME (HOURS)	24	X	0.0650	=	1.5600	0.0833	X	6.9390	=	0.5782
						</				

REQUIRED STANDBY CAPACITY (AMP HOURS)	1.5600	+	0.5782	=	2.1382	1.2000	=	2.5659	7.0 AH
REQUIRED ALARM CAPACITY (AMP HOURS)	0.5782	+	0.5782	=	1.1564	1.2000	=	2.3564	7.0 AH
TOTAL REQUIRED CAPACITY (AMP HOURS)	2.1382	+	1.1564	=	3.2946	1.2000	=	4.4946	7.0 AH

FCPS-24FS8		STANDBY				TOTAL STANDBY	ALARM				TOTAL ALARM
P.S. "3"		CURRENT PER				CURRENT PER	CURRENT PER				CURRENT PER
ITEM	DESCRIPTION	UNIT (AMPS)	QTY			UNIT (AMPS)	UNIT (AMPS)	QTY			UNIT (AMPS)
	Monitor Board	0.0650	X	1	=	0.0650	0.1450	X	1	=	0.1450
1	NAC-1	0.0000	X	1	=	0.0000	0.9600	X	1	=	0.9600
2	NAC-2	0.0000	X	1	=	0.0000	0.9090	X	1	=	0.9090
4	NAC-3	0.0000	X	0	=	0.0000	0.0000	X	0	=	0.0000
5	NAC-4	0.0000	X	0	=	0.0000	0.0000	X	0	=	0.0000
TOTAL STANDBY CURRENT						0.0650	TOTAL ALARM CURRENT		2.9440		

STANDBY:		24		HOURS		ALARM:		5		MINUTES x 160 =		0.0833									
REQUIRED STANDBY TIME (HOURS)		24		X		0.0650		=		1.5600		0.0833		X		2.9440		=		0.1703	
REQUIRED STANDBY CAPACITY (AMP HOURS)		1.5600		+		0.1703		=		1.7303		1.2000		=		2.0764		7.0 AH			



NAC #	Model	SYSTEM SENSOR	Starting Voltage, V	20.4
P1-10	Loop Length, ft	185	Circuit amps	Separation
	Number of Apps	8	current draw	in between
	Appliance type	Candelas	Amperage	(Amps) (Feet) #14 AWG
P1-10.1	L-Str W/M	75	0.136	0.136 32.5 20.36
P1-10.2	L-HornStr W/M	75	0.156	0.252 62.9 20.34
P1-10.3	L-Str W/M	75	0.142	0.434 97.5 20.27
P1-10.4	L-Str W/M	75	0.142	0.576 130.0 20.17
P1-10.5	L-HornStr W/M	75	0.156	0.732 162.5 20.03
P1-10.6	L-HornStr W/M	75	0.156	0.880 195.0 19.87

NAC #	Model	SYSTEM SENSOR	Starting Voltage, V	20.4
P1-40	Loop Length, ft	260	Circuit amps	Separation
	Number of Apps	10	current draw	in between
	Appliance type	Candelas	Amperage	(Amps) (Feet) #14 AWG
P1-40.1	L-HornStr W/M	75	0.156	0.156 22.0 20.36
P1-40.2	L-Str W/M	75	0.136	0.136 44.0 20.34
P1-40.3	L-HornStr W/M	75	0.156	0.440 66.0 20.31
P1-40.4	L-Str W/M	75	0.136	0.748 111.0 20.15
P1-40.5	L-Str W/M	75	0.136	0.880 133.0 20.03
P1-40.6	L-Str W/M	75	0.136	1.032 156.2 19.91
P1-40.7	L-Str W/M	75	0.136	1.168 176.5 19.76
P1-40.8	L-HornStr W/M	75	0.156	1.312 200.8 19.58
P1-40.9	L-HornStr W/M	75	0.156	1.480 224.1 19.39
P1-40.10	L-HornStr W/M	75	0.156	1.628 250.0 19.22
P1-40.11	L-HornStr W/M	75	0.156	1.772 267.7 19.84
P1-40.12	L-HornStr W/M	75	0.156	1.628 250.0 19.88


NAC #	Model	SYSTEM SENSOR	Starting Voltage, V	20.4
P1-20	Loop Length, ft	145	Circuit amps	Separation
	Number of Apps	5	current draw	in between
	Appliance type	Candelas	Amperage	(Amps) (Feet) #14 AWG
P1-20.1	L-HornStr W/M	75	0.156	0.156 20.36
P1-20.2	L-HornStr W/M	75	0.156	0.291 41.4 20.32
P1-20.3	L-HornStr W/M	75	0.156	0.447 62.1 20.31
P1-20.4	L-HornStr W/M	75	0.156	0.603 82.8 20.20
P1-20.5	L-HornStr W/M	75	0.156	0.756 103.6 20.16
P1-20.6	L-Str W/M	75	0.156	0.915 124.3 20.05
P1-20.7	L-Str W/M	75	0.156	1.061 145.1 19.94

NAC #	Model	SYSTEM SENSOR	Starting Voltage, V	20.4		
P1-30	Loop Length, ft	440	Circuit amps	Separation		
	Appliance	Number of Apps	current draw	in between		
	Number	Appliance type	Candelas	Amperage (Amps)	(Feet)	#14 AWG
P1-30.1	L-Str W/M	75	0.136	0.136	24.4	20.36
P1-30.2	L-HornStr W/M	75	0.156	0.252	62.9	20.34
P1-30.3	L-HornStr W/M	30	0.167	0.370	89.3	20.34
P1-30.4	L-HornStr W/M	75	0.156	0.526	145.0	20.28
P1-30.5	L-HornStr W/M	30	0.167	0.683	111.8	20.16
P1-30.6	L-Str W/M	75	0.136	0.089	17.3	20.36
P1-30.7	L-Str W/M	75	0.136	0.136	24.4	20.36
P1-30.8	L-Str W/M	75	0.136	0.880	146.7	20.04
P1-30.9	L-HornStr W/M	75	0.156	0.869	171.0	19.93
P1-30.10	L-HornStr W/M	75	0.156	0.945	196.9	19.83
P1-30.9	L-Str W/M	75	0.136	0.082	20.0	19.85
P1-30.10	L-HornStr W/M	75	0.156	0.238	62.4	20.47
P1-30.11	L-HornStr W/M	75	0.156	0.324	82.9	20.37
P1-30.12	L-Str W/M	75	0.136	0.530	263.3	19.02
P1-30.13	L-HornStr W/M	75	0.156	0.822	169.3	19.85
P1-30.14	L-HornStr W/M	75	0.156	1.020	203.2	19.50
P1-30.15	L-HornStr W/M	30	0.167	0.683	111.8	20.16
P1-30.16	L-Str W/M	30	0.089	0.264	69.1	20.37
P1-30.17	L-Str W/M	30	0.089	0.210	41.6	20.37
	L-Str W/M	75	0.136	0.136	24.4	20.36
	L-HornStr W/M	75	0.156	0.252	62.9	20.34
	L-HornStr W/M	30	0.167	0.370	89.3	20.34
	L-HornStr W/M	75	0.156	0.526	145.0	20.28
	L-HornStr W/M	30	0.167	0.683	111.8	20.16
	L-Str W/M	75	0.136	0.089	17.3	20.36
	L-Str W/M	75	0.136	0.136	24.4	20.36
	L-Str W/M	75	0.136	0.880	146.7	20.04
	L-HornStr W/M	75	0.156	0.869	171.0	19.93
	L-HornStr W/M	75	0.156	0.945	196.9	19.83
	L-Str W/M	75	0.136	0.082	20.0	19.85
	L-HornStr W/M	75	0.156	0.238	62.4	20.47
	L-HornStr W/M	75	0.156	0.324	82.9	20.37
	L-Str W/M	75	0.136	0.530	263.3	19.02
	L-HornStr W/M	75	0.156	0.822	169.3	19.85
	L-HornStr W/M	75	0.156	1.020	203.2	19.50
	L-HornStr W/M	30	0.167	0.683	111.8	20.16
	L-Str W/M	30	0.089	0.264	69.1	20.37
	L-Str W/M	30	0.089	0.210	41.6	20.37
	L-Str W/M	75	0.136	0.136	24.4	20.36
	L-HornStr W/M	75	0.156	0.252	62.9	20.34
	L-HornStr W/M	30	0.167	0.370	89.3	20.34
	L-HornStr W/M	75	0.156	0.526	145.0	20.28
	L-HornStr W/M	30	0.167	0.683	111.8	20.16
	L-Str W/M	75	0.136	0.089	17.3	20.36
	L-Str W/M	75	0.136	0.136	24.4	20.36
	L-Str W/M	75	0.136	0.880	146.7	20.04
	L-HornStr W/M	75	0.156	0.869	171.0	19.93
	L-HornStr W/M	75	0.156	0.945	196.9	19.83
	L-Str W/M	75	0.136	0.082	20.0	19.85
	L-HornStr W/M	75	0.156	0.238	62.4	20.47
	L-HornStr W/M	75	0.156	0.324	82.9	20.37
	L-Str W/M	75	0.136	0.530	263.3	19.02
	L-HornStr W/M	75	0.156	0.822	169.3	19.85
	L-HornStr W/M	75	0.156	1.020	203.2	19.50
	L-HornStr W/M	30	0.167	0.683	111.8	20.16
	L-Str W/M					


NAC #	Model	SYSTEM SENSOR		Starting Voltage, V		20.4
P3-20	Loop Length, ft	130		Circuit amps	Separation	Voltage
Appliance	Number of App	8		current draw	in between	drop Volts
Number	Appliance type	Candelas	Amperacy	(Amps)	(Feet)	#14 AWG
P3-20.1	L-HornStr W/M	75	0.156	0.156	18.3	20.39
P3-20.2	L-HornStr W/M	75	0.156	0.252	27.2	20.37
P3-20.3	L-HornStr W/M	75	0.157	0.370	46.8	20.34
P3-20.4	L-Str W/M	75	0.090	0.430	65.0	20.31
P3-20.5	L-Str W/M	75	0.090	0.490	81.3	20.28
P3-20.6	L-HornStr W/M	75	0.156	0.646	97.5	20.21
P3-20.7	L-HornStr W/M	75	0.156	0.753	113.8	20.18
P3-20.8	L-HornStr W/M	75	0.156	0.868	130.0	20.04

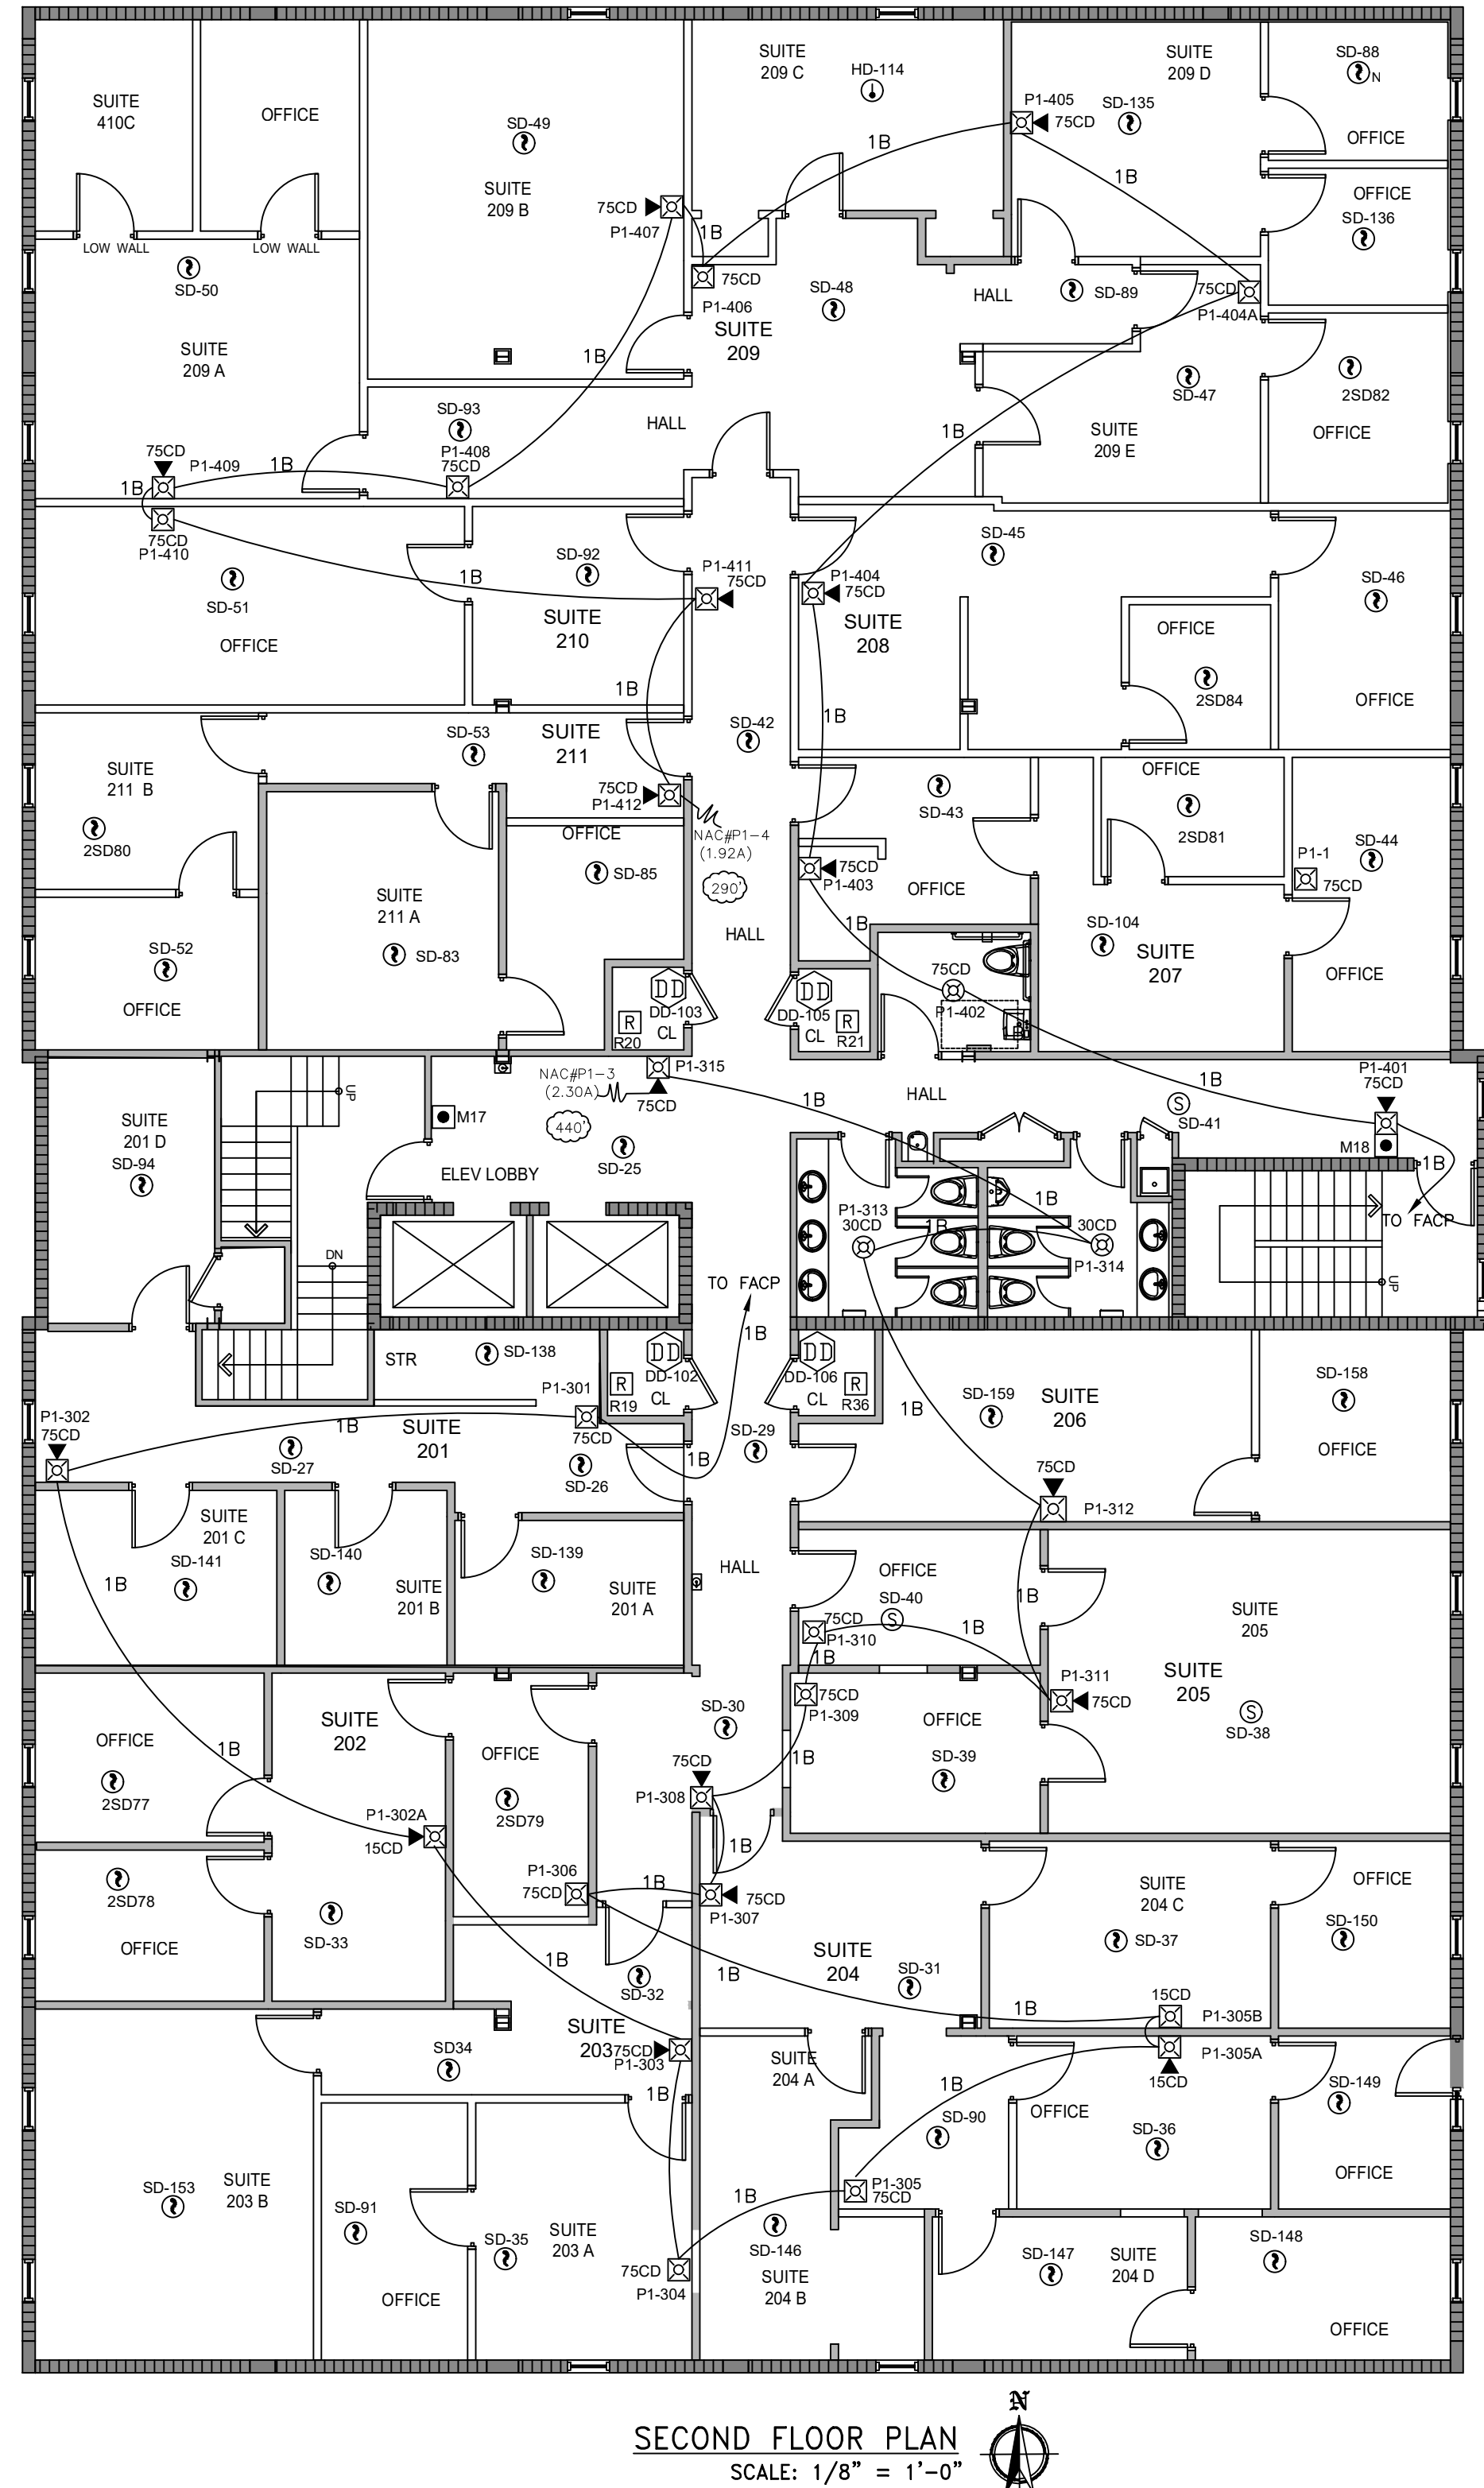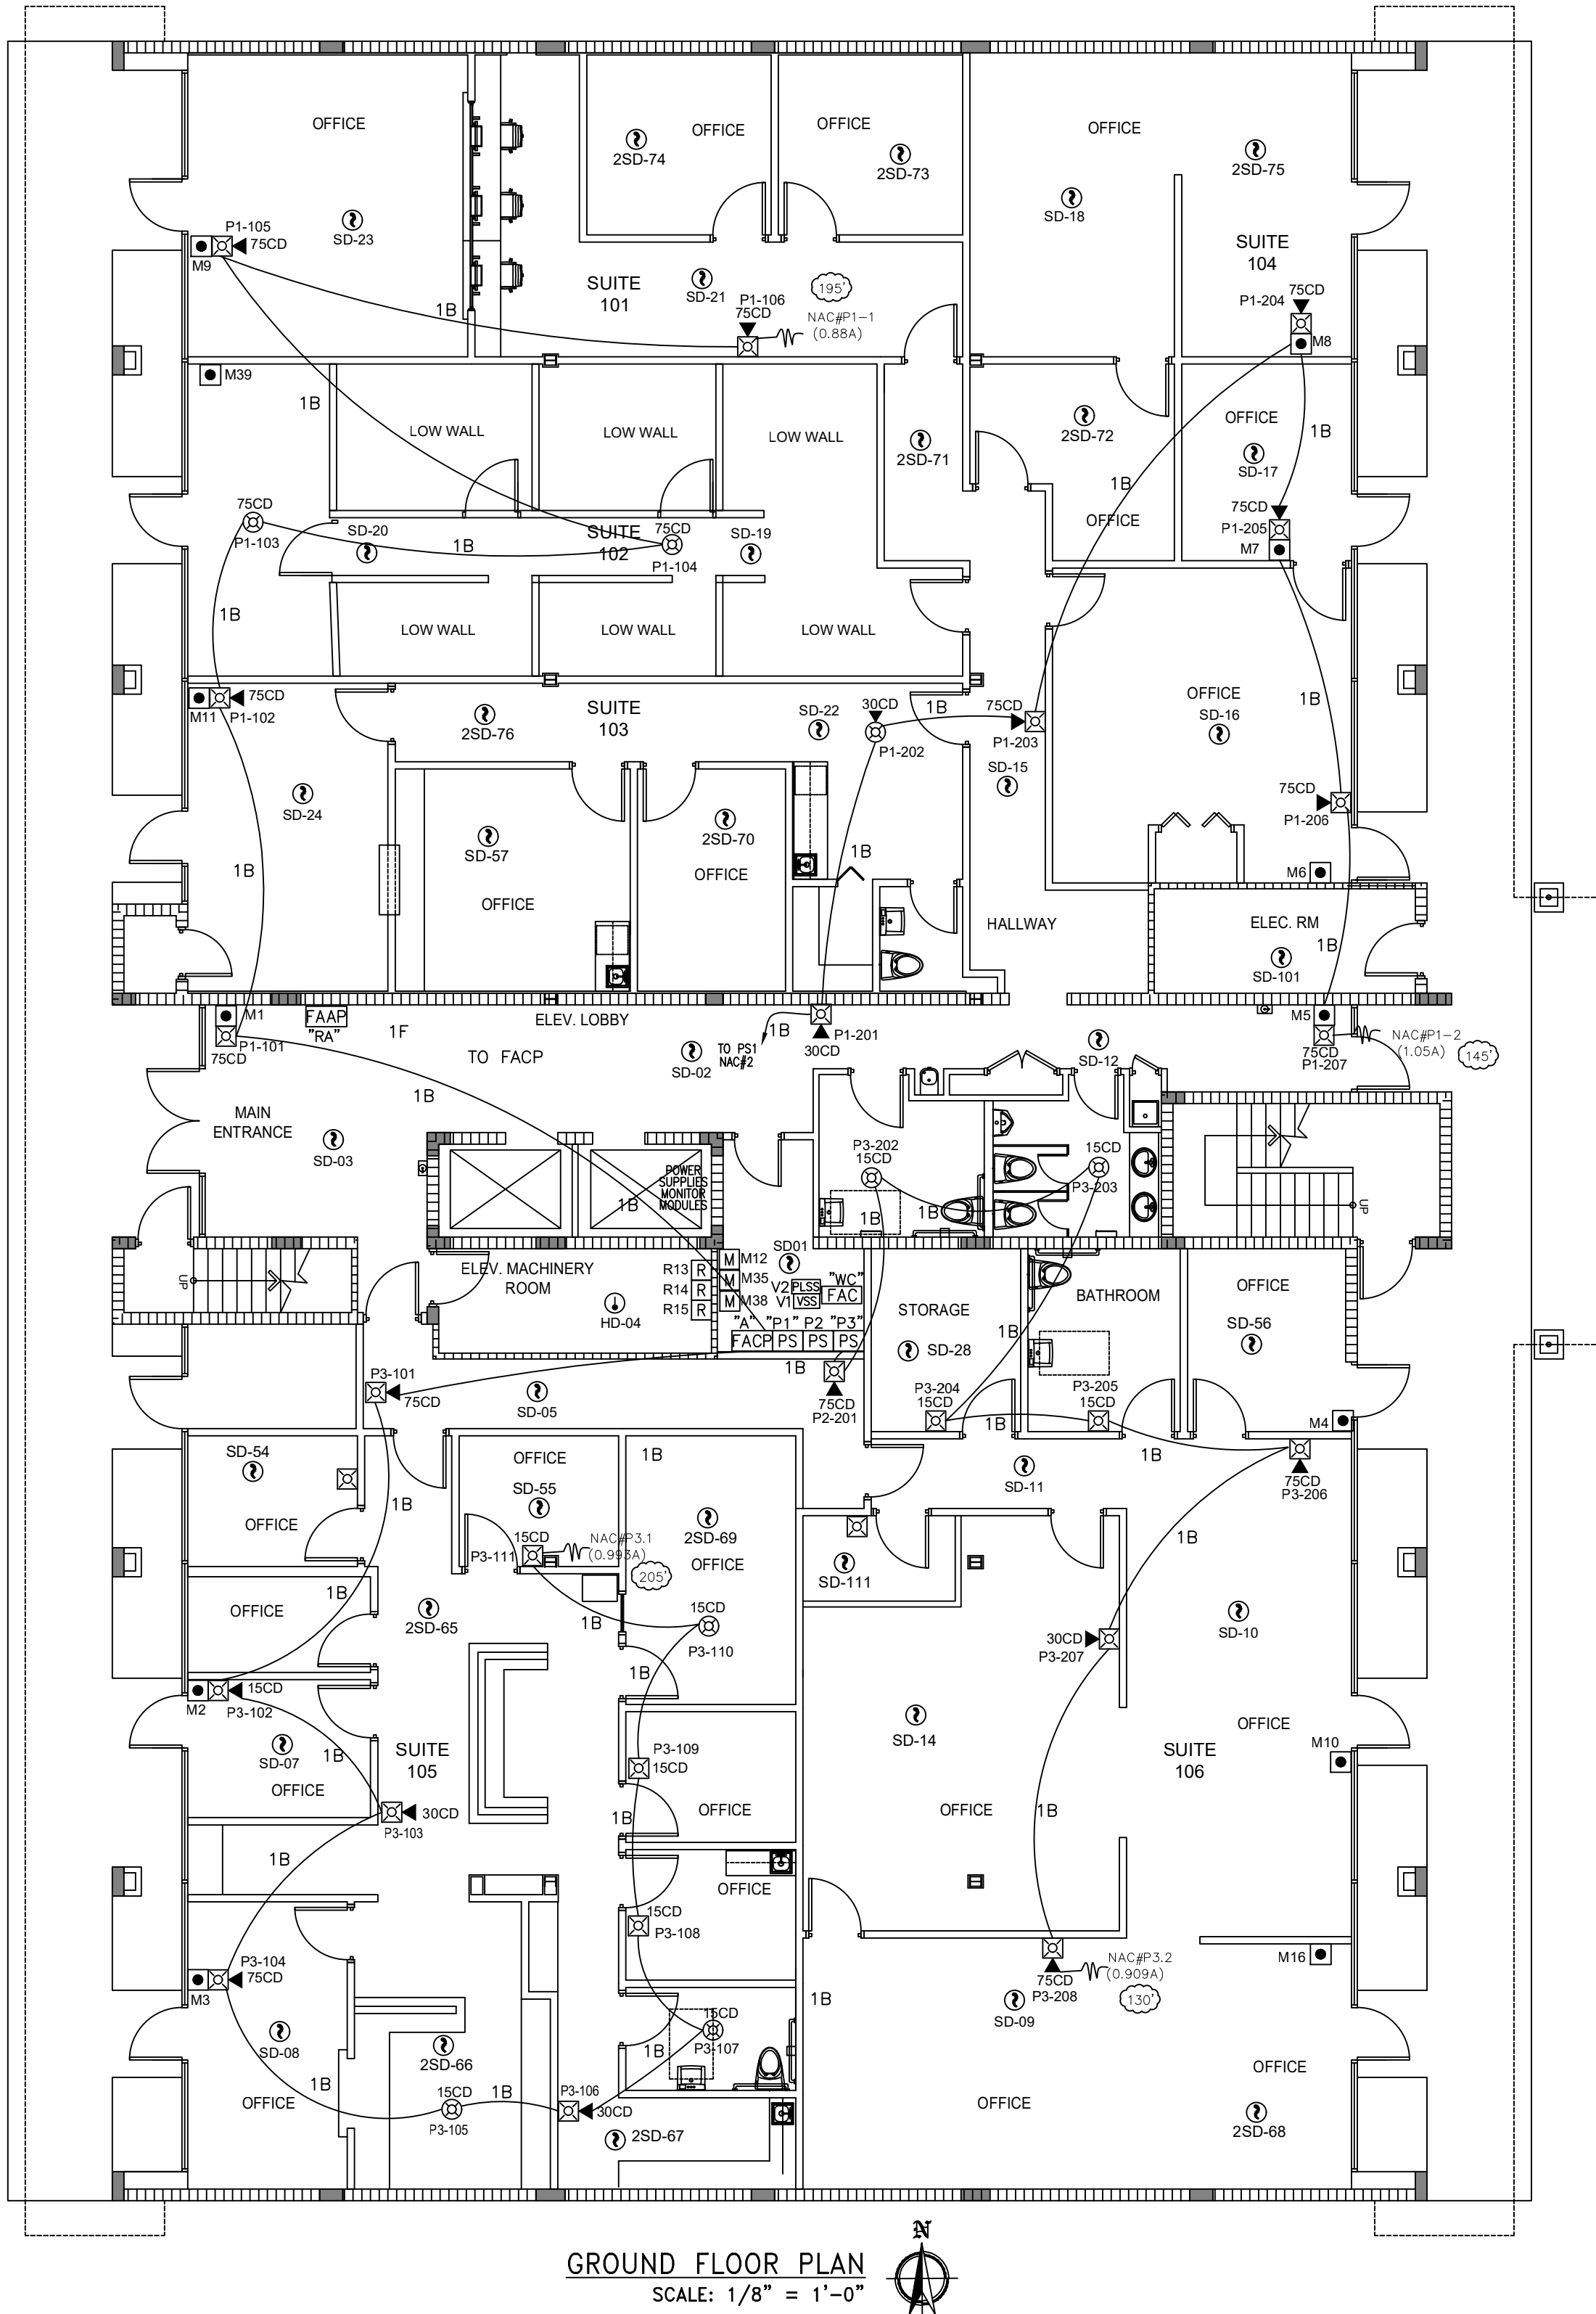

REVISION NO.	DATE	COMMENTS
1	2-10-23	AS BUILT
2		
3		
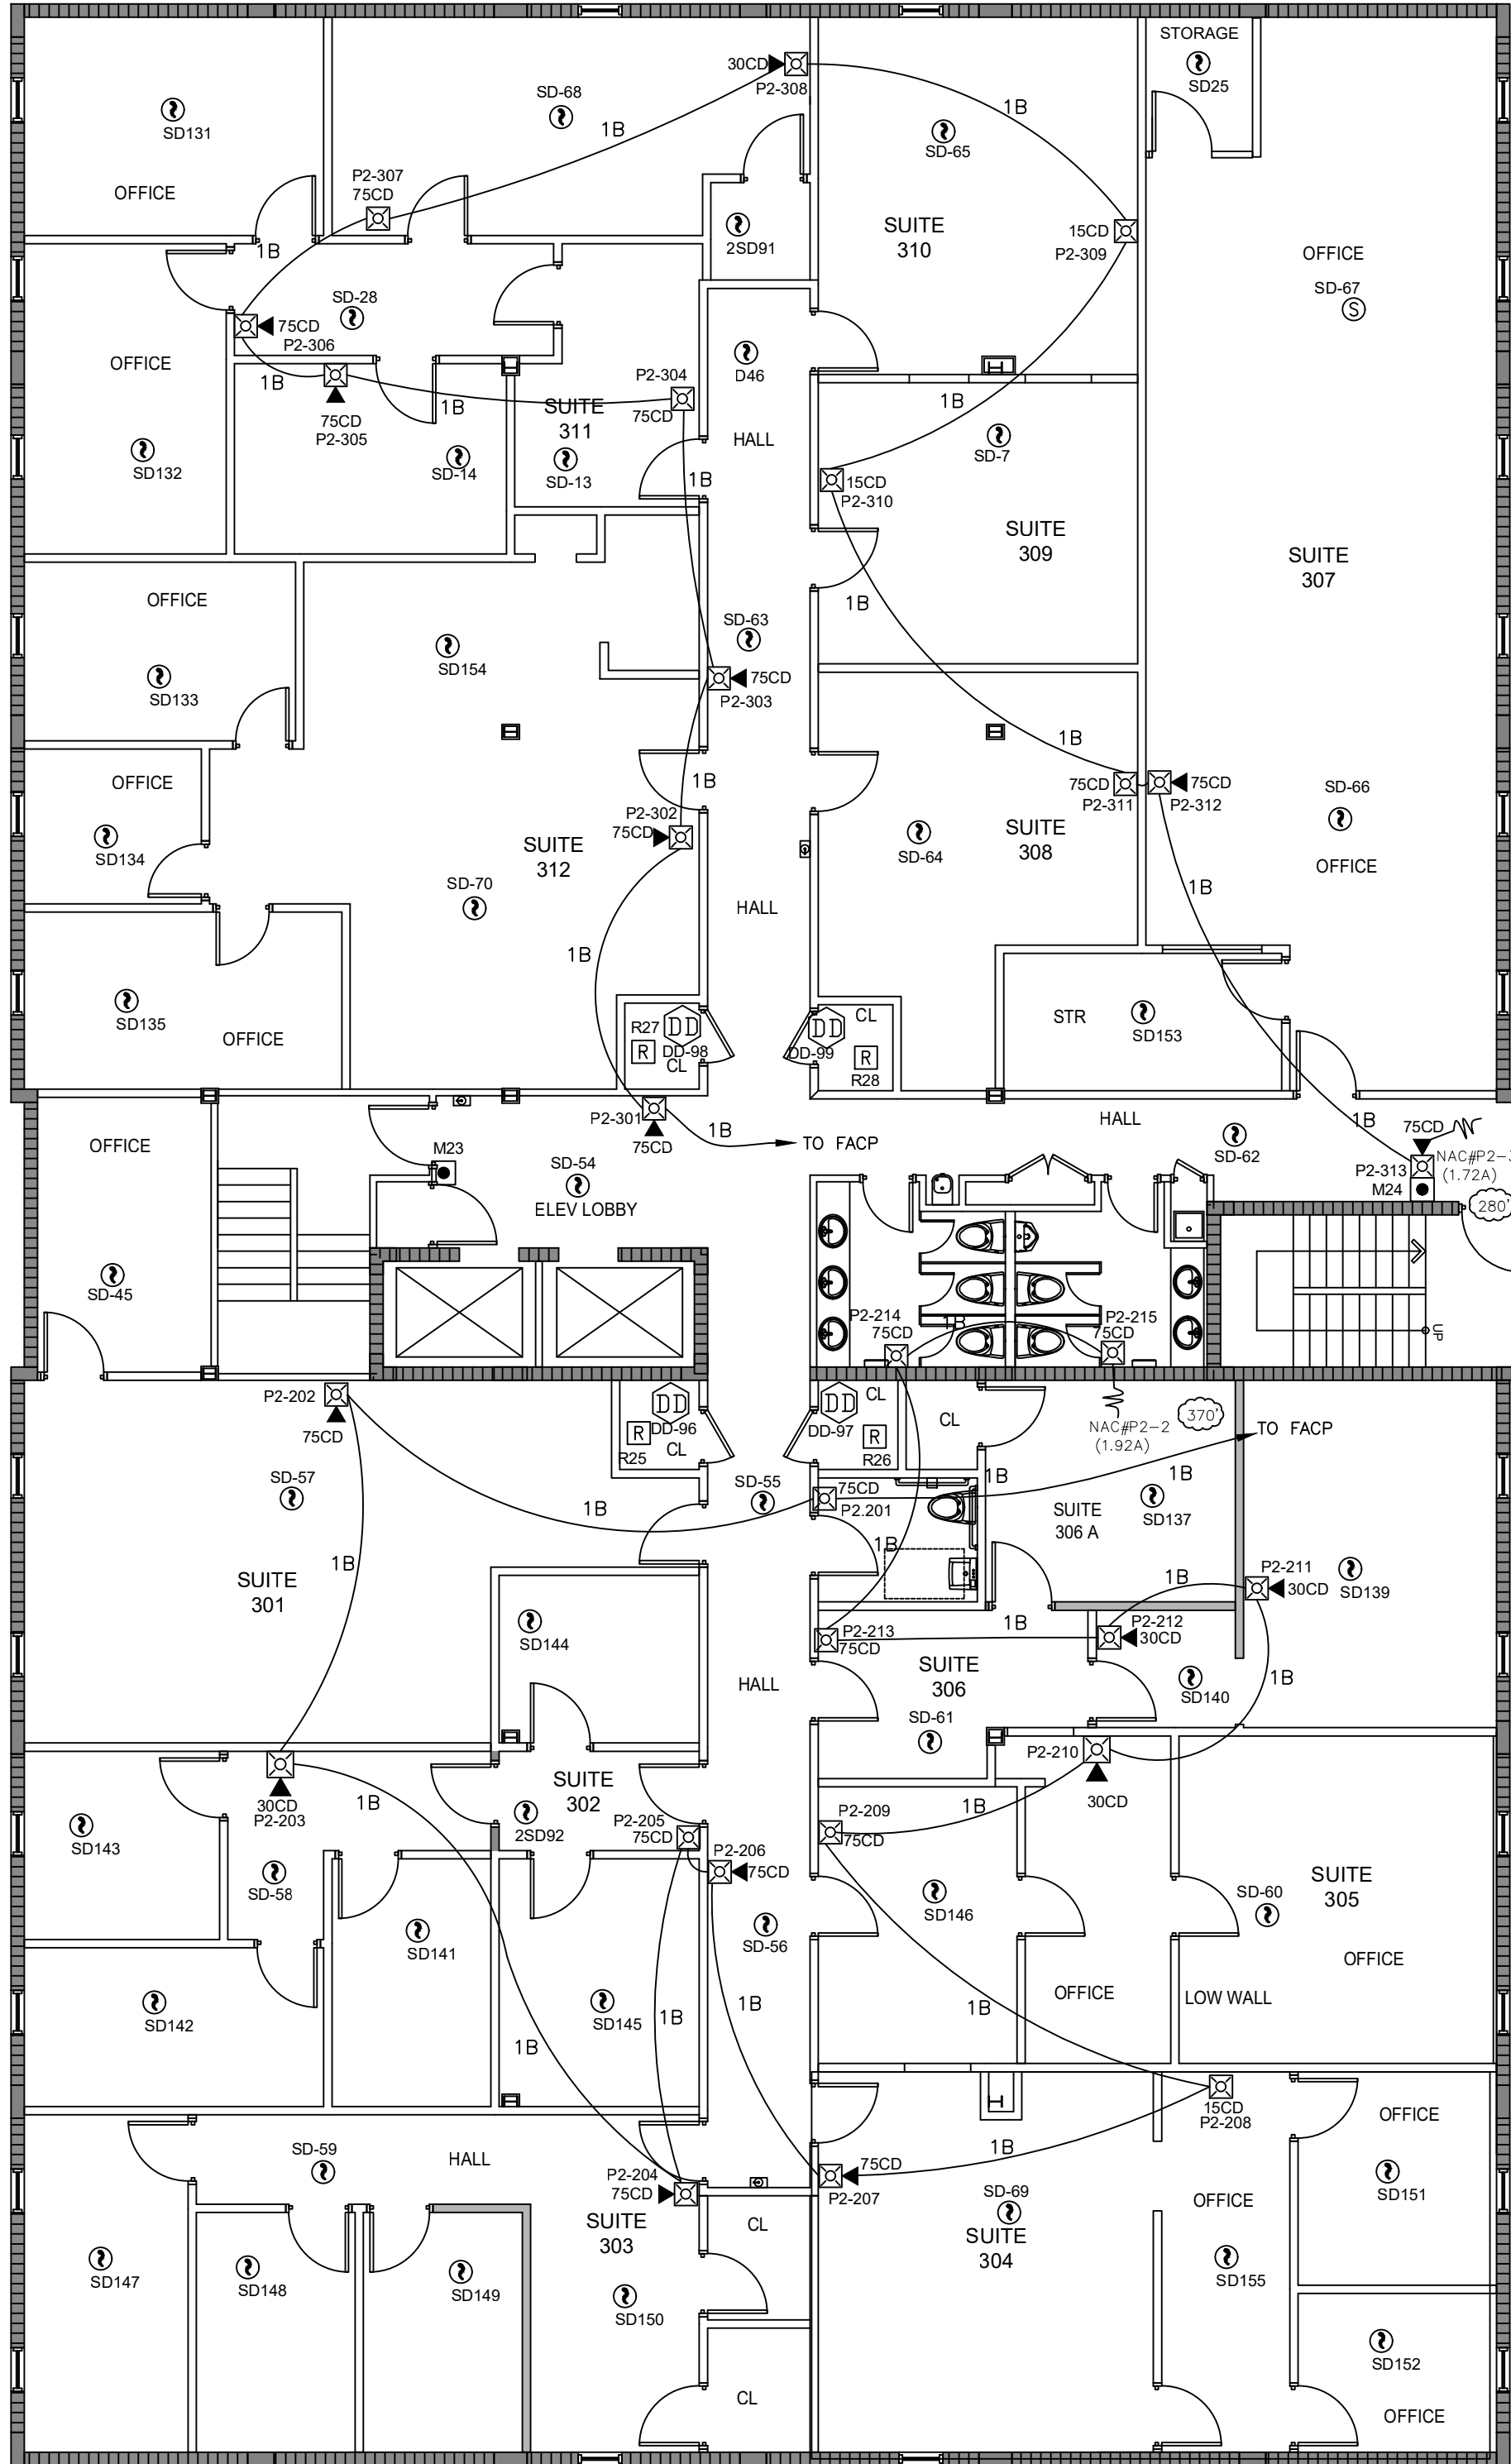

THIRD FLOOR PLAN
SCALE: 1/8" = 1'-0"

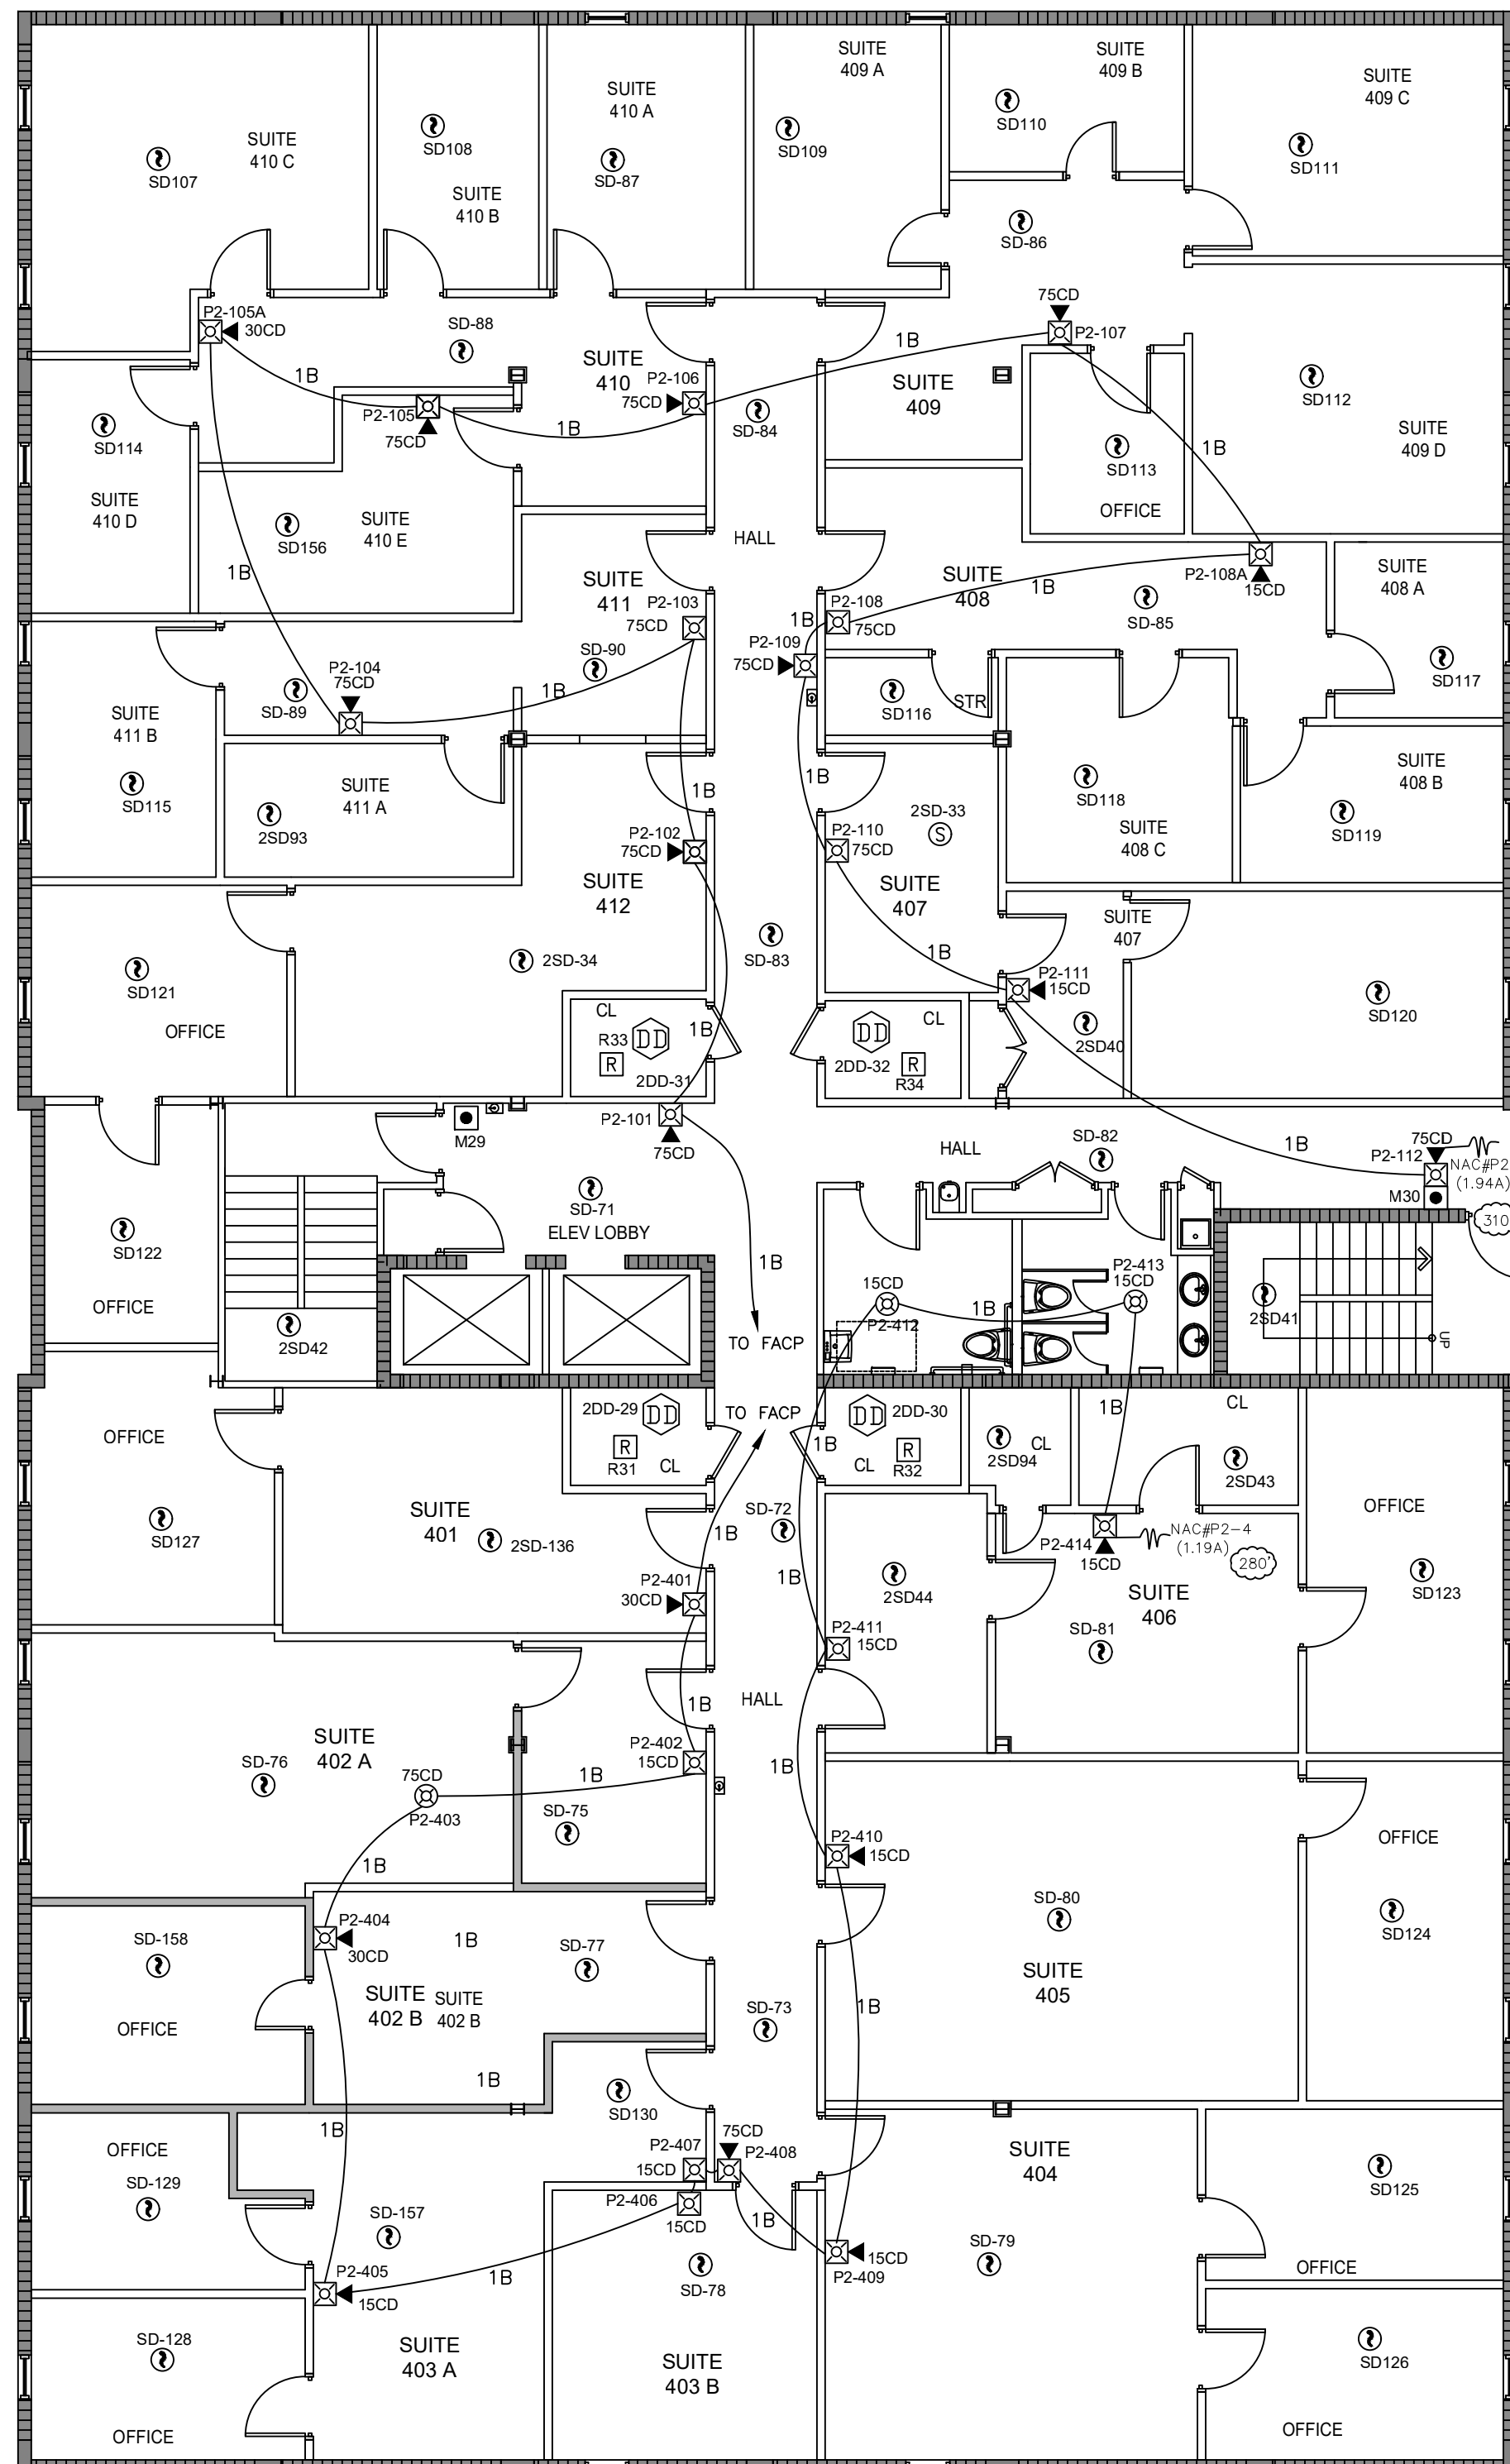

FOURTH FLOOR PLAN
SCALE: 1/8" = 1'-0"



REVISION NO.	DATE	COMMENTS
1	2-10-23	AS BUILT

COMPREHENSIVE FIRE ALARMS & SECURITY SYSTEMS, Inc.
20160 NW 13th Avenue,
Miami Gardens, Florida, 33169.
Phone: (305) 652-4138
Fax: (305) 652-9160
QUALIFIER: Anthony Clarke,
LICENSE: EF 001176

T.E.S.
TUCHMAN ENGINEERING
SERVICES, INC.
MECHANICAL, ELECTRICAL, PLUMBING,
FIRE ALARM AND SYSTEM INTEGRATORS
3209 McKINLEY Street
Hollywood, FL 33021
TEL: (786) 423-3511
Email: TuchmanEngineering@gmail.com
CA#27250

PROJECT NAME AND ADDRESS:
**Supplier Center,
Second, Third & 4th Floors,
Fire Alarm System.**
4000 N. State Road 7
Lauderdale Lakes, Florida, 33319.

DRAWN BY: TUCHMAN	DATE: 3-12-2021
SCALE: AS NOTED	REVISED BY: TUCHMAN

PROJECT NUMBER:
20210312-6

PAGE TITLE:
3rd & 4th
FLOOR PLANS

ALL DRAWINGS AND WRITTEN MATERIAL APPEARING
HEREIN CONSTITUTE THE ORIGINAL AND UNPUBLISHED
WORK, AND CAN NOT BE DUPLICATED, USED OR
DISCLOSED WITHOUT THE EXPRESS WRITTEN CONSENT
OF JAVIER TUCHMAN P.E.
ENGINEER IS NOT RESPONSIBLE IF ANY CHANGES
ARE MADE WITHOUT HIS APPROVAL.

JAVIER TUCHMAN
LICENSE
NO. 60285
STATE OF
FLORIDA
PROFESSIONAL ENGINEER

PAGE NUMBER:
FA-3 OF 4

