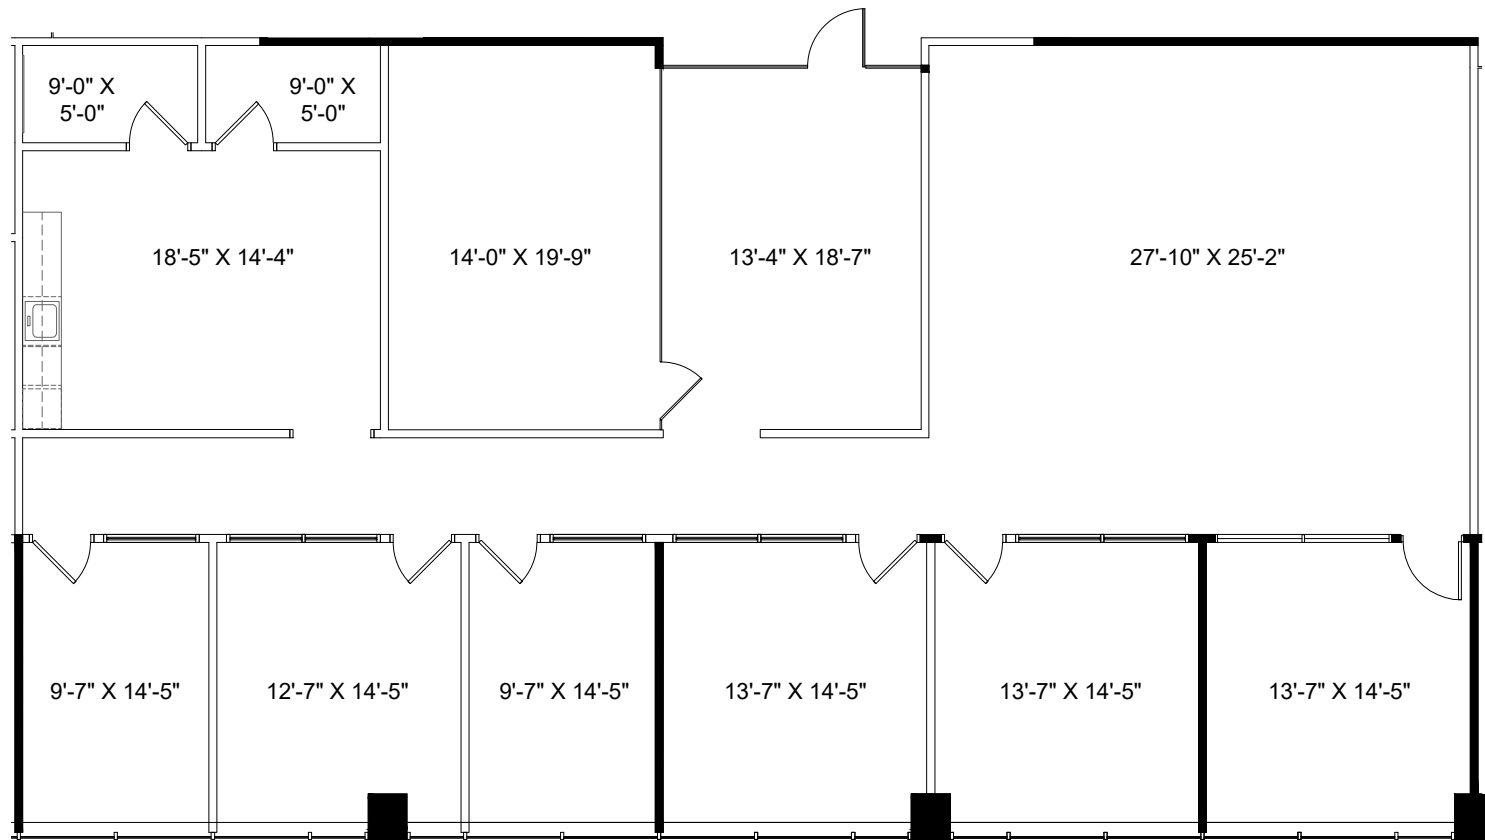


ALL DIMENSIONS ARE APPROXIMATE AND SUBJECT TO NOMINAL VARIANCE.

WESTERN SECURITIES
ESTABLISHED · 1932

Uptown Center

2626 HOWELL STREET
DALLAS, TEXAS 75204

AS-BUILT PLAN SUITE 900

rsf: 3,585

scale: N.T.S.

date: 12.23.2025



1201 main street
suite 1370
dallas, texas 75202
214.420.4646