
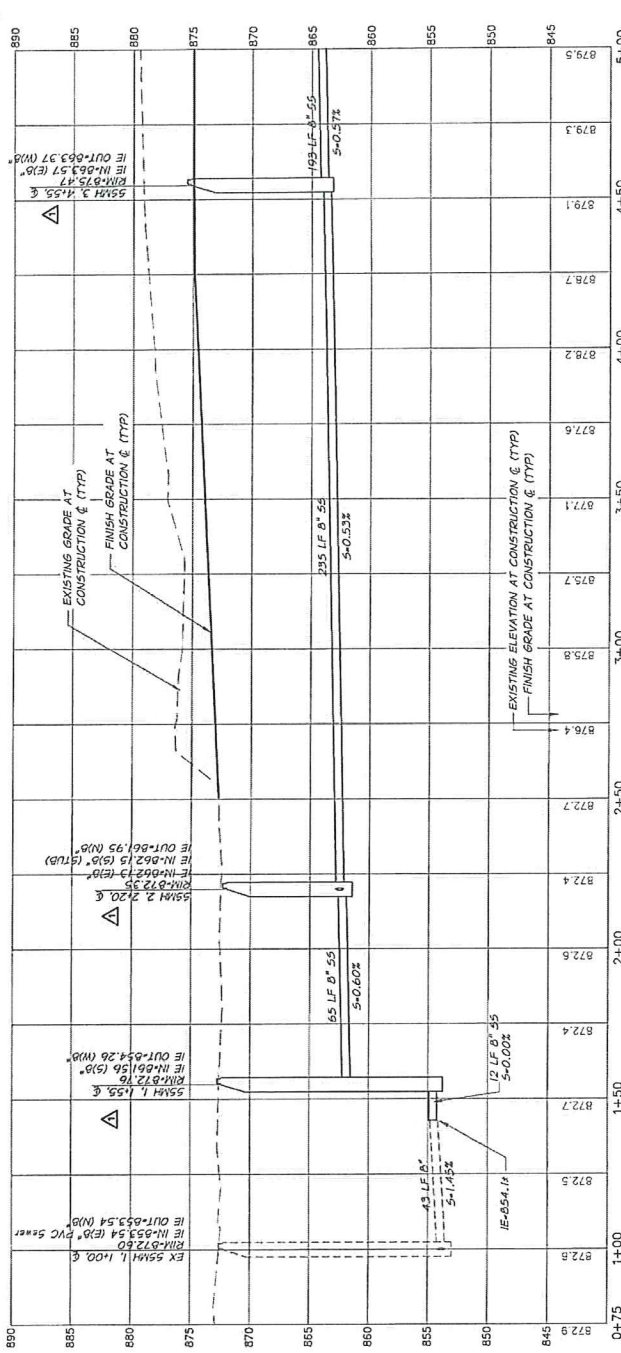


CONSTRUCTION NOTES

1. EVERY SPREAD EARTHEN BERM INTO PERMANENT CONSTRUCTION EASEMENTS PRIOR TO CONSTRUCTION. DISTURBED AREAS FOLLOWING CONSTRUCTION.
2. PROTECT EXISTING CATCH BASIN AND INFILTRATION TRENCH. SEE DETAIL OF EXISTING INFILTRATION TRENCH, SHEET C-501.
3. PROTECT EXISTING TREES, LANDSCAPING AND IRRIGATION.
4. PROTECT AND/OR REPLACE EXISTING LANDSCAPING AND IRRIGATION. RESTORE EXISTING LAWN WITH SOD. RECONSTRUCT BERM TO MATCH EXISTING.
5. CONNECT TO EXISTING SEWER MAIN UTILIZING FACTORY BELL OR SOLID SLIP COUPLING.
6. ABANDON SANITARY SEWER LIFT STATION PER DETAIL SHEET C-501.
7. ABANDON EXISTING ELECTRICAL SERVICE PANEL. COORDINATE WITH PACIFIC POWER.
8. SANITARY SEWER MANHOLE. 48" DIA PER CITY STD PLAN 3-1.
9. SANITARY SEWER INTERIOR DROP MANHOLE. 48" DIA PER CITY STD PLAN 3-5.
10. SOLID WALL PVC SANITARY SEWER PIPE, 8" DIA.
11. INSTALL 5' LONG SOLID WALL PVC SANITARY SEWER PIPE, 8" DIAMETER STUD. CAP WITH WATER TIGHT CAP.
12. PROTECT EXISTING TREES.
13. ABANDON EXISTING SEWER MAIN BY GROUTING PIPE AND FLOW CHANNEL.
14. CORE AND RECHANNELED EXISTING MANHOLE.
15. ASPHALT RESTORATION 1" HMA/10" CSTC.

*Note: 1.4 m/s trench facilities
NO DISBURSEMENT
of 1.4 m/s construction
dune*

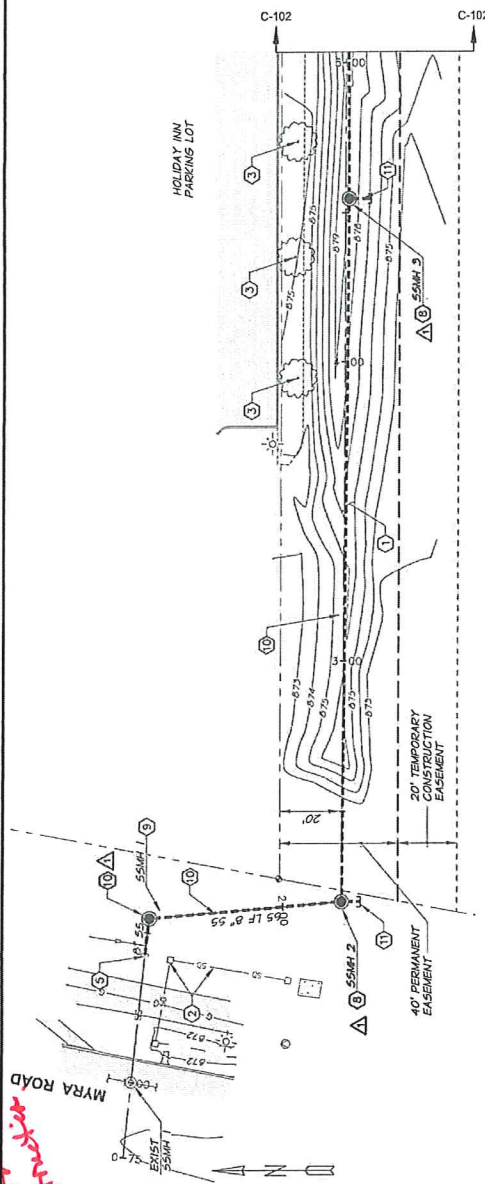

RECORD DRAWINGS

These record drawings have been prepared, checked, and approved by the engineer and are limited by their scope. They may contain errors and omissions. The engineer does not accept responsibility for their accuracy.

RECORD DRAWING MODIFICATIONS	
DATE	BY
12/13	
DESIGNED BY A. SCHMIDTTELL	
DRAWN BY P. SAILER	
CHECKED BY P. D. VIXIE	





THIS DRAWING HAS BEEN REDUCED APPROXIMATELY 50%. ADJUST SCALE ACCORDINGLY. BAR SCALE SHOWN IS ACCURATE.

Anderson Perry & Associates, Inc.
ENGINEERS
WALLA WALLA, WA, LA GRANDE, OR

CITY OF WALLA WALLA
HOLIDAY INN LIFT STATION REMOVAL PROJECT
2013
PLAN AND PROFILE
1+00 TO STA 5+00

- 1 EVENLY SPREAD PARTICULATE ASHES INTO BEDDING MATERIAL AND TEMPORARY EXISTING MANHOLE PRIOR TO INSTALLATION OF SEWER MAIN. HYDROSEED DISTURBED AREAS FOLLOWING CONSTRUCTION.
- 2 PROTECT EXISTING EXISTING CATCH BASIN AND INFILTRATION TRENCH. SEE DETAIL OF EXISTING INFILTRATION TRENCH, SHEET C-501.
- 3 PROTECT EXISTING TREES, LANDSCAPING AND IRRIGATION.
- 4 PROTECT AND/OR REPLACE EXISTING LANDSCAPING AND IRRIGATION. RESTORE TO MATCH WITH SOD. RECONSTRUCT BERM TO MATCH EXISTING.
- 5 CONNECT TO EXISTING SEWER MAIN UTILIZING FACTORY BELL OR SOLID SLD COUPLINGS.
- 6 ABANDON SANITARY SEWER LIFT STATION PER DETAIL, SHEET C-501.
- 7 ABANDON EXISTING ELECTRICAL SERVICE PANEL. COORDINATE WITH PACIFIC POWER.
- 8 SANITARY SEWER MANHOLE, 48" DIA PER CITY STD PLAN 3-1.
- 9 SANITARY SEWER INTERIOR DROP MANHOLE, 48" DIA PER CITY STD PLAN 3-3.
- 10 SOLID WALL PVC SANITARY SEWER PIPE, 8" DIA.
- 11 INSTALL 5' LONG SOLID WALL PVC SANITARY SEWER PIPE, 8" DIAMETER STUD. CAP WITH WATER TIGHT CAP.
- 12 PROTECT EXISTING TREES.
- 13 ABANDON EXISTING SEWER MAIN BY GROUTING PIPE AND FLOW CHANNEL.
- 14 CORE AND RECHAMMEL EXISTING MANHOLE,
- 15 ASPHALT RESTORATION 1" HMA/10" CSTOL.

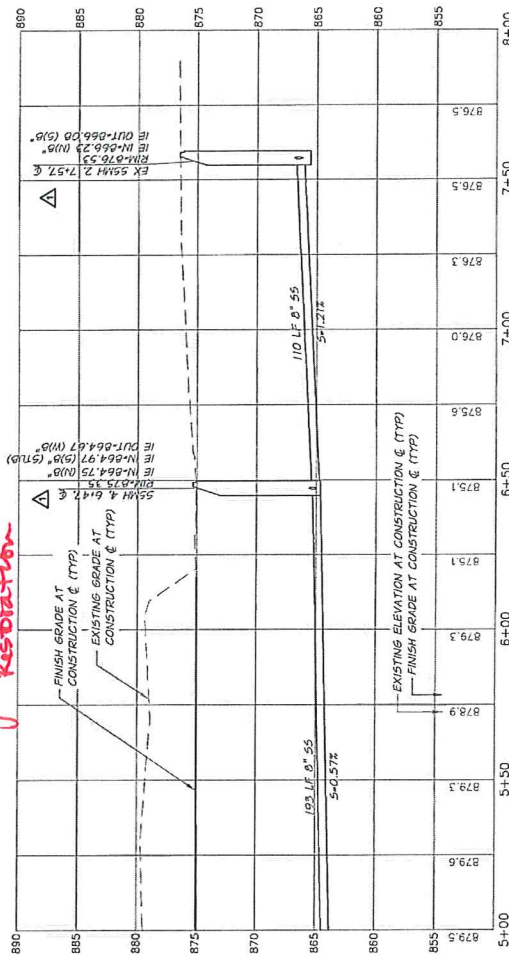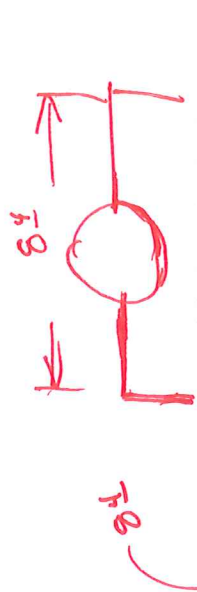

These record drawings have been prepared, in part, on the basis of information compiled and furnished by others. They may contain some discrepancies and omissions, and do not necessarily represent "exact" field conditions. The Owner and the Engineer accept no responsibility for their accuracy.

[illegible]

APPROVED BY A. SCHMIDTGALL	BY	DATE
----------------------------	----	------

WRITTEN BY	B. SAILER
REVIEWED BY	B. VIXIE

THIS DRAWING HAS BEEN
REDUCED APPROXIMATELY 50%.
ADJUST SCALE ACCORDINGLY.
BAR SCALE SHOWN IS ACCURATE

THIS DRAWING HAS BEEN
REDUCED APPROXIMATELY 50%.
ADJUST SCALE ACCORDINGLY.
BAR SCALE SHOWN IS ACCURATE

**Anderson
perry**
& associates, inc.
engineering surveying natural resources
WALLA WALLA, WA LA GRANDE, OR

CITY OF WALLA WALLA
HOLIDAY INN LIFT STATION REMOVAL PROJECT

C-102
4 OF 7