


REVISION

PROJECT  
--

AS-BUILT FLOOR PLAN  
THIRD FLOOR  
FIRST CAMPBELL SQUARE  
210 FIRST STREET SW, ROANOKE, VIRGINIA

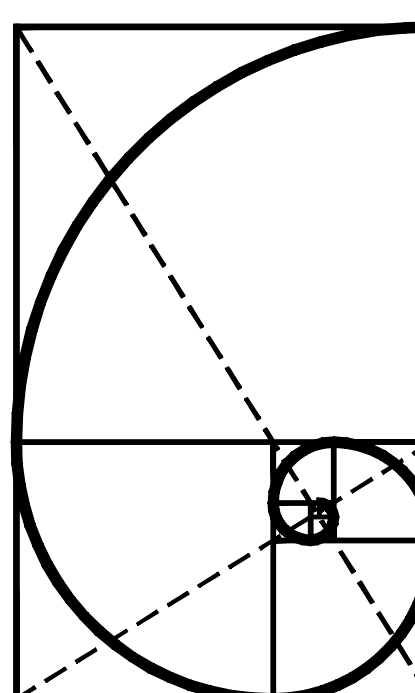

**Degen**  
Architects

Post Office Box 20183  
Roanoke VA 24018-0019  
Telephone 540/772.0800  
degenarchitects@aol.com

DRAWING  
AS-BUILT PLAN


DATE  
05 SEPTEMBER 2011

SHEET NUMBER:  
**A103**

FIRST STREET

KIRK AVENUE

CAMPBELL AVENUE

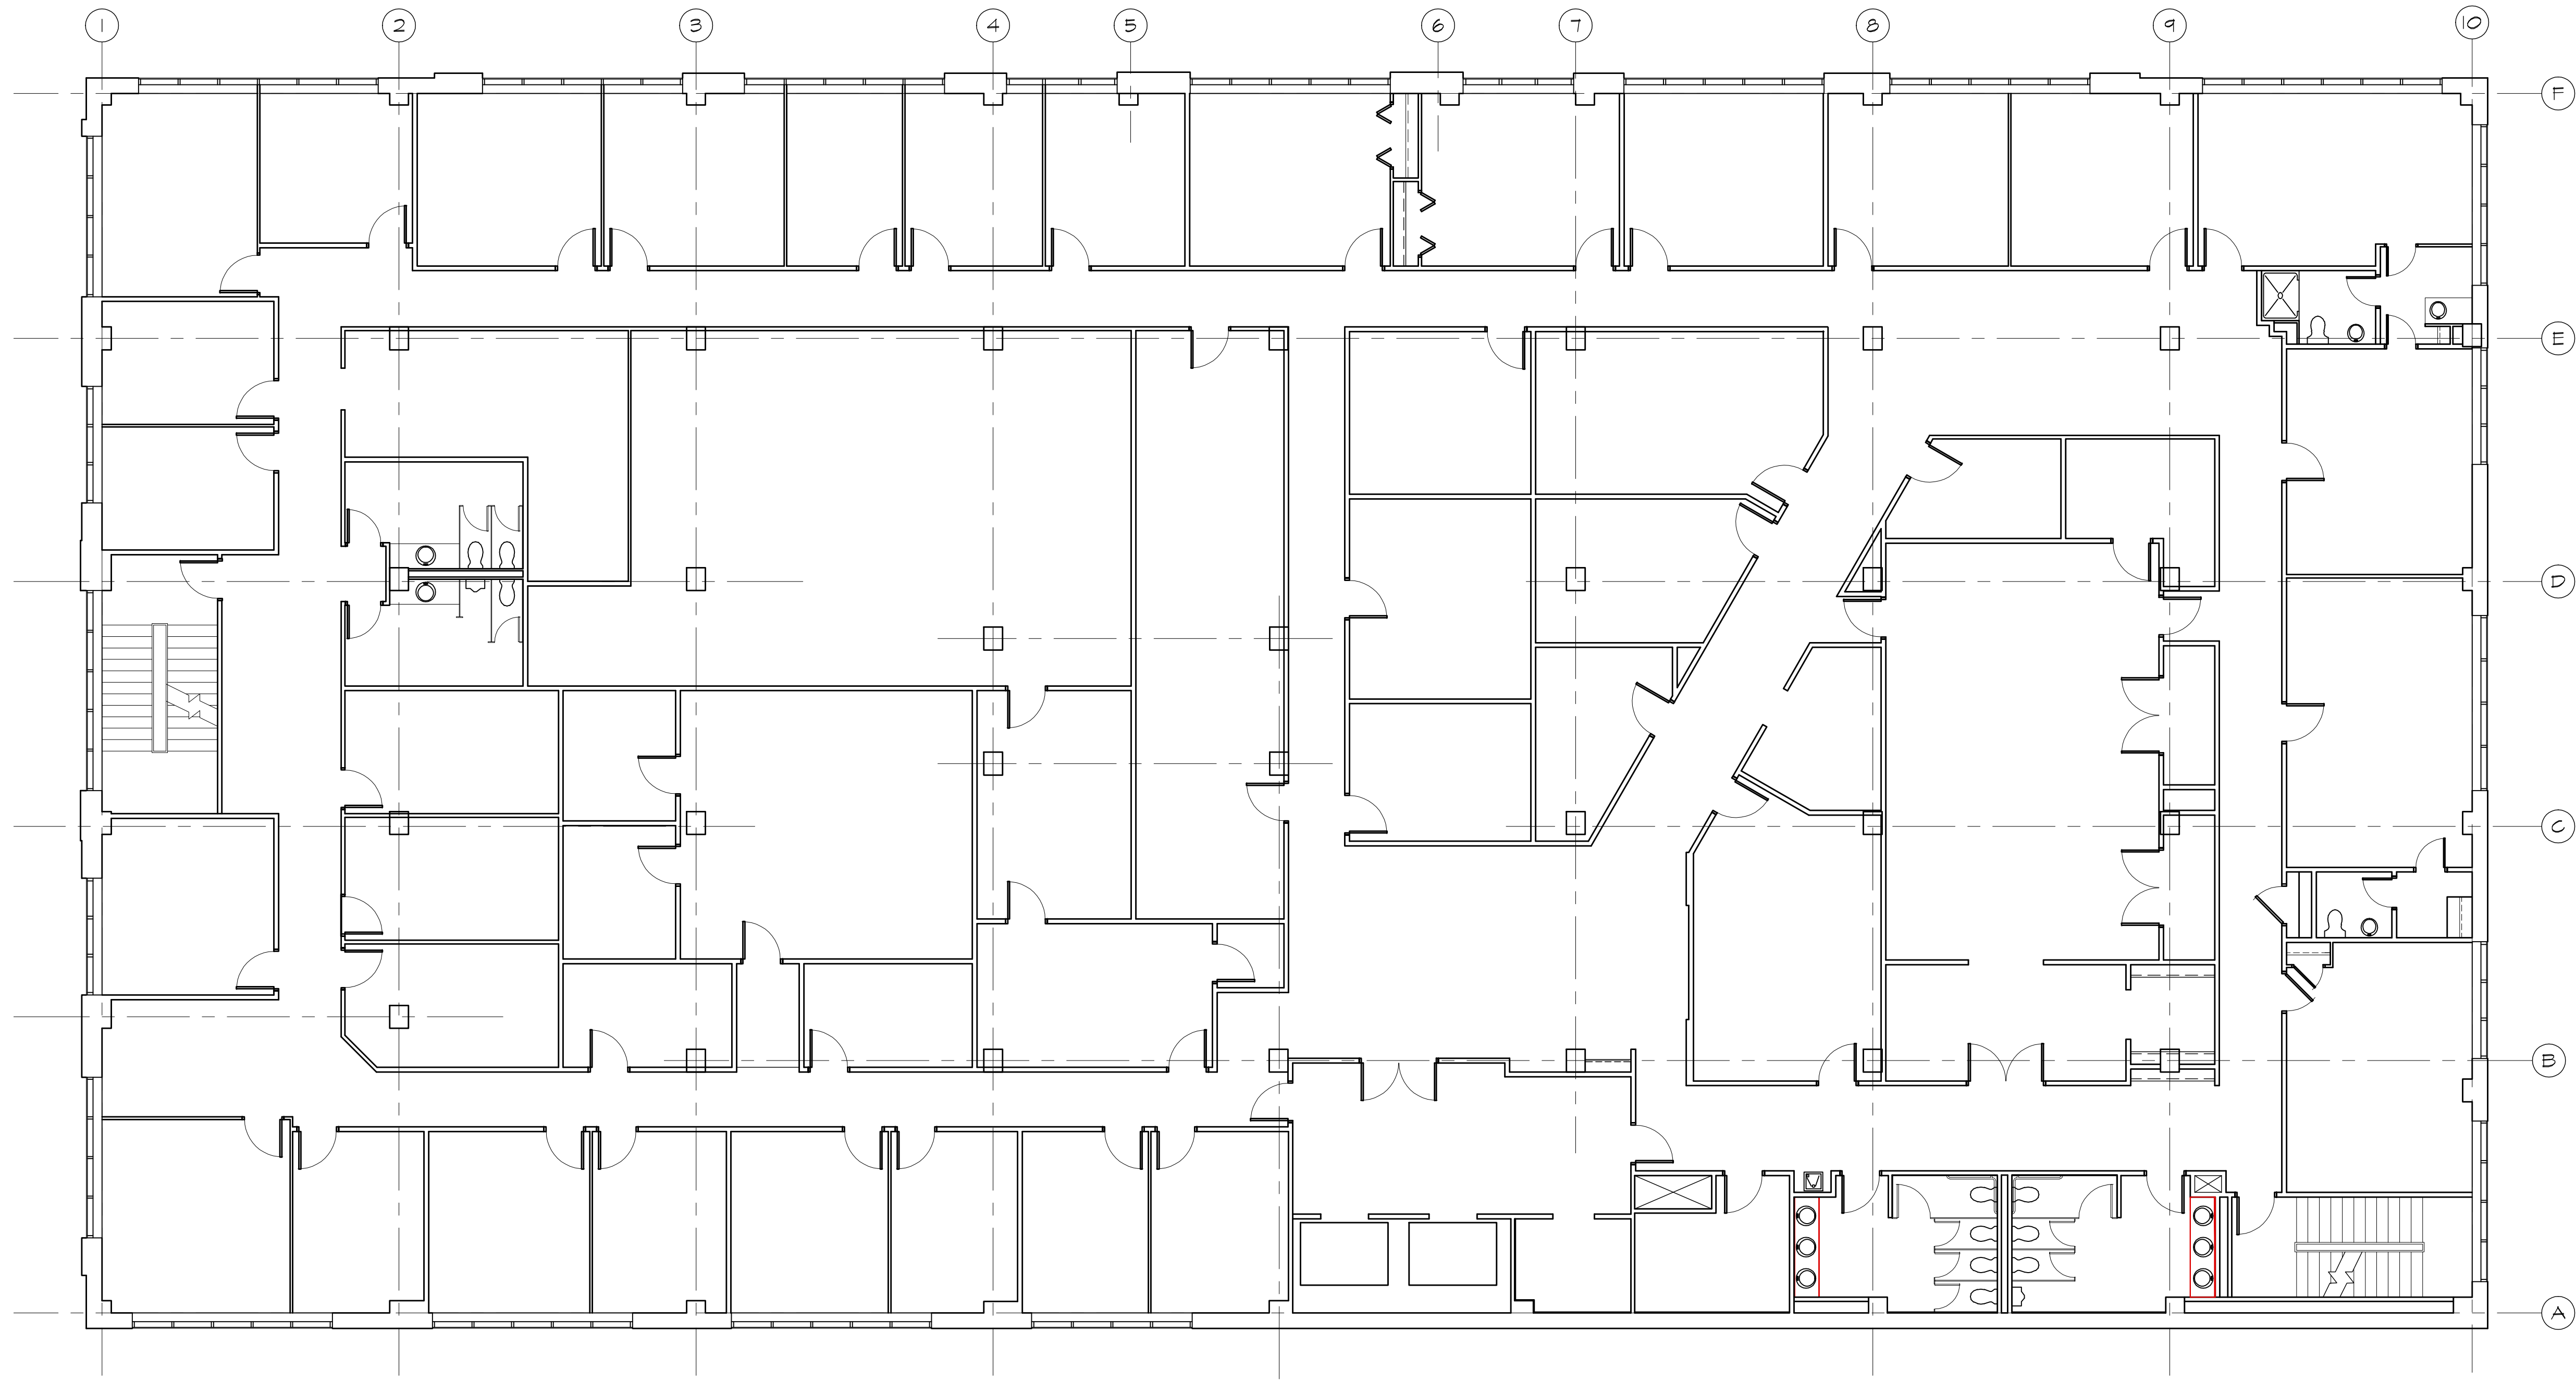

**THIRD FLOOR PLAN**  
SCALE: 1/8" = 1'-0"