
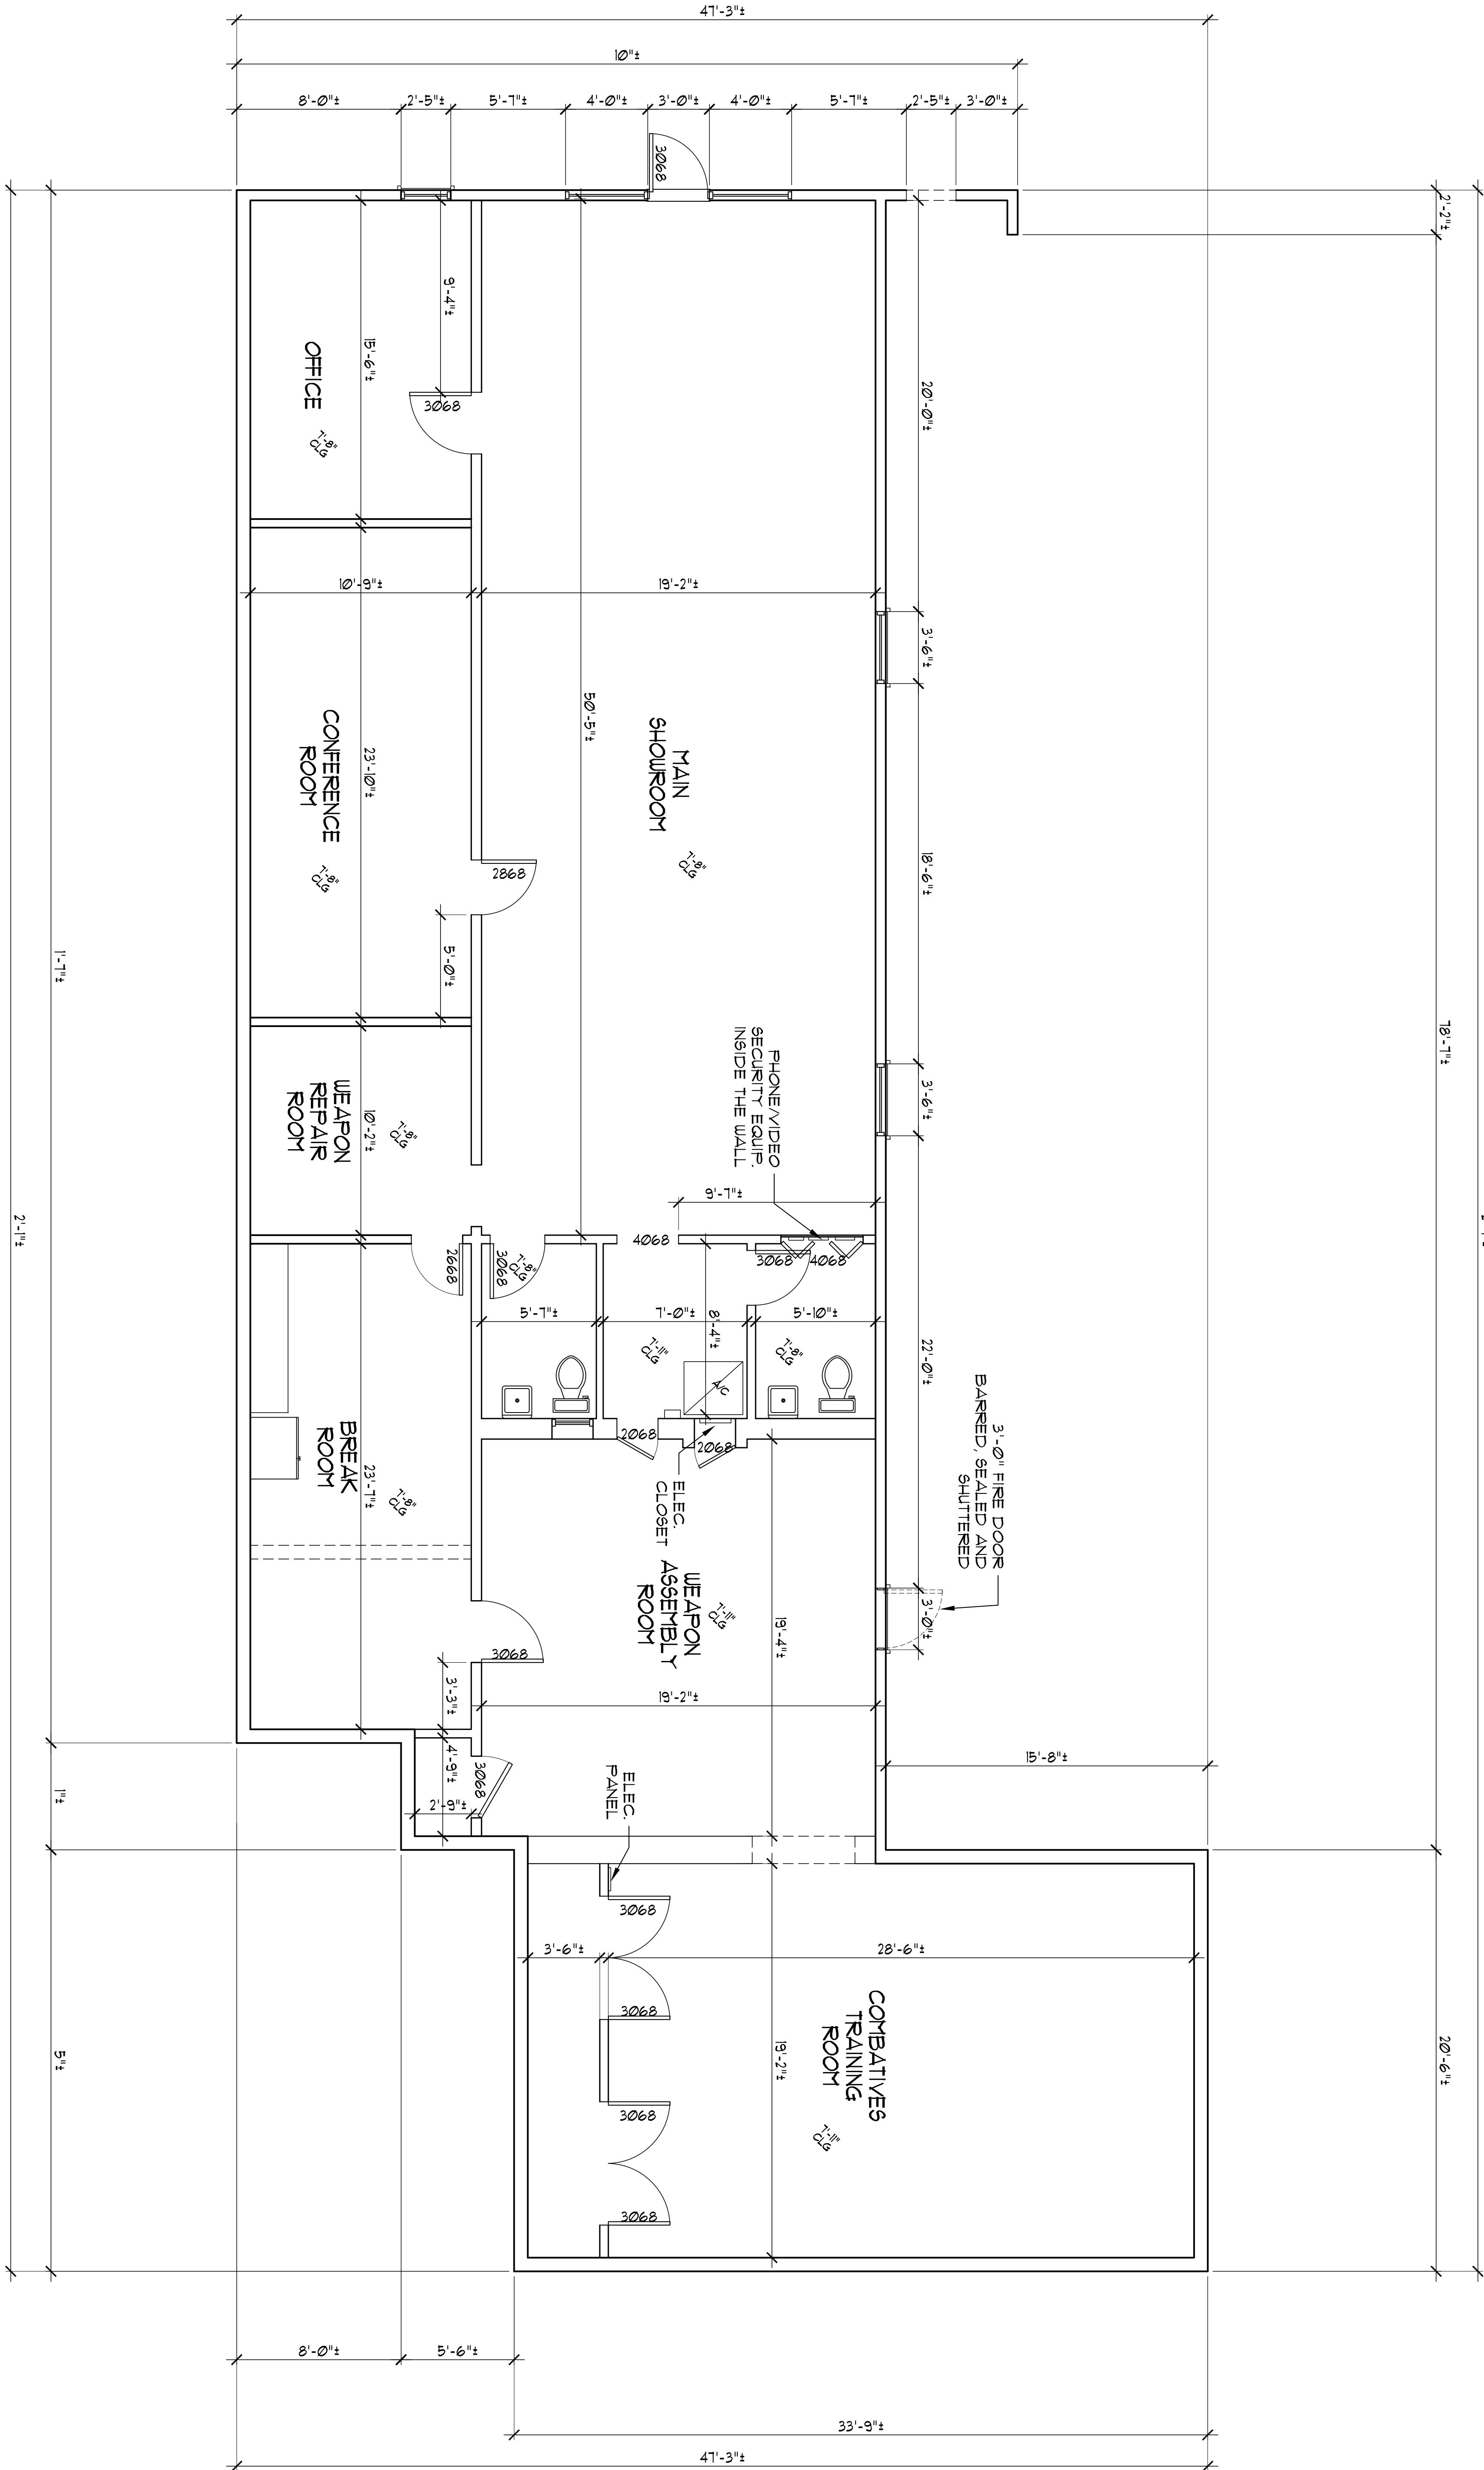


14th STREET (US-41) NORTHBOUND.

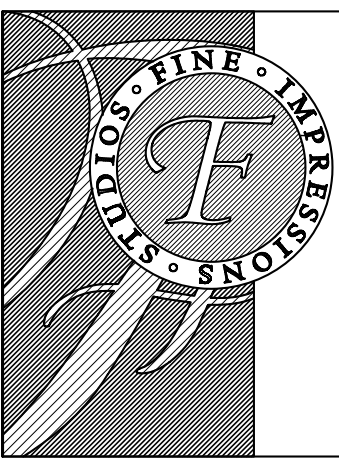

NOTE: ALL DIMENSIONS ARE APPROXIMATE BASED ON THE SKETCH PROVIDED AND THE AS-BUILT CONDITIONS MEASURED IN PLACE. EXACT MEASUREMENTS MUST BE FIELD VERIFIED.

TOTAL UNIT SQUARE FEET = 32004

SHEET # 1 OF 1	 FINE IMPRESSIONS STUDIOS DRAFTING & DESIGN <i>Jeffrey M. Wilson</i> 920 59th Street West Bradenton, FL 34209 941.526.6508	TITLE: 5107 14th Street West Bradenton, Florida 34205	TO THE BEST OF THE DESIGNER'S KNOWLEDGE, THE DESIGN REPRESENTED BY THESE DRAWINGS CONTAINS ALL PERTINENT INFORMATION AS REQUESTED BY THE CLIENT AND FOUND EXISTING ON SITE. ALL RIGHTS RESERVED. REPRODUCTION OR ANY PORTION OF THESE PLANS IS PROHIBITED. THESE DRAWINGS WERE PREPARED AND SOLD FOR USE IN CONSTRUCTION OF ONE BUILDING. NO OTHER USE IS PERMITTED WITHOUT THE WRITTEN APPROVAL OF THE DESIGNER. THESE DRAWINGS REMAIN THE PROPERTY OF THE DESIGNER.	CLIENT: 	AS-BUILT DATE: 11/01/'20	FINAL DRAFT:	SCALE:
		REVISIONS:		REVISIONS:	DRAFTED BY: J.M.W.	DESIGNED BY:	