


280 MERRIMACK STREET 1ST FLOOR, SUITE 135

AS BUILT PLAN

2,832 SF

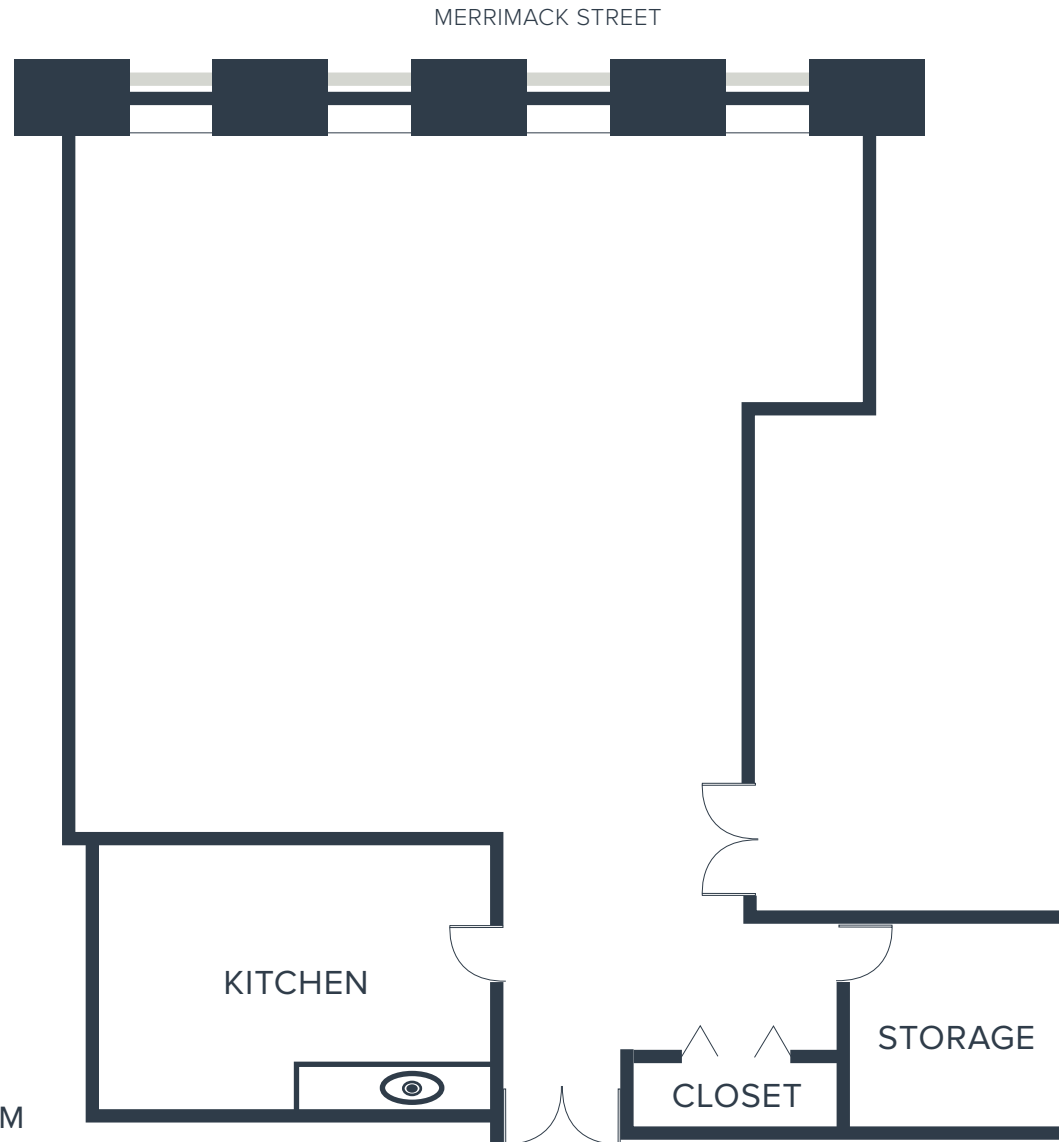

RIVERWALKINNOVATION.COM
978.681.7777

Not to scale. For marketing purposes only.